


WATER RIGHTS APPLICATION MAP

S-87389

THIS MAP WAS PREPARED FOR
ASSESSMENT PURPOSE ONLY

NE1/4 NE1/4 SEC. 5 T.25S. R.11W. W.M.
COOS COUNTY

23

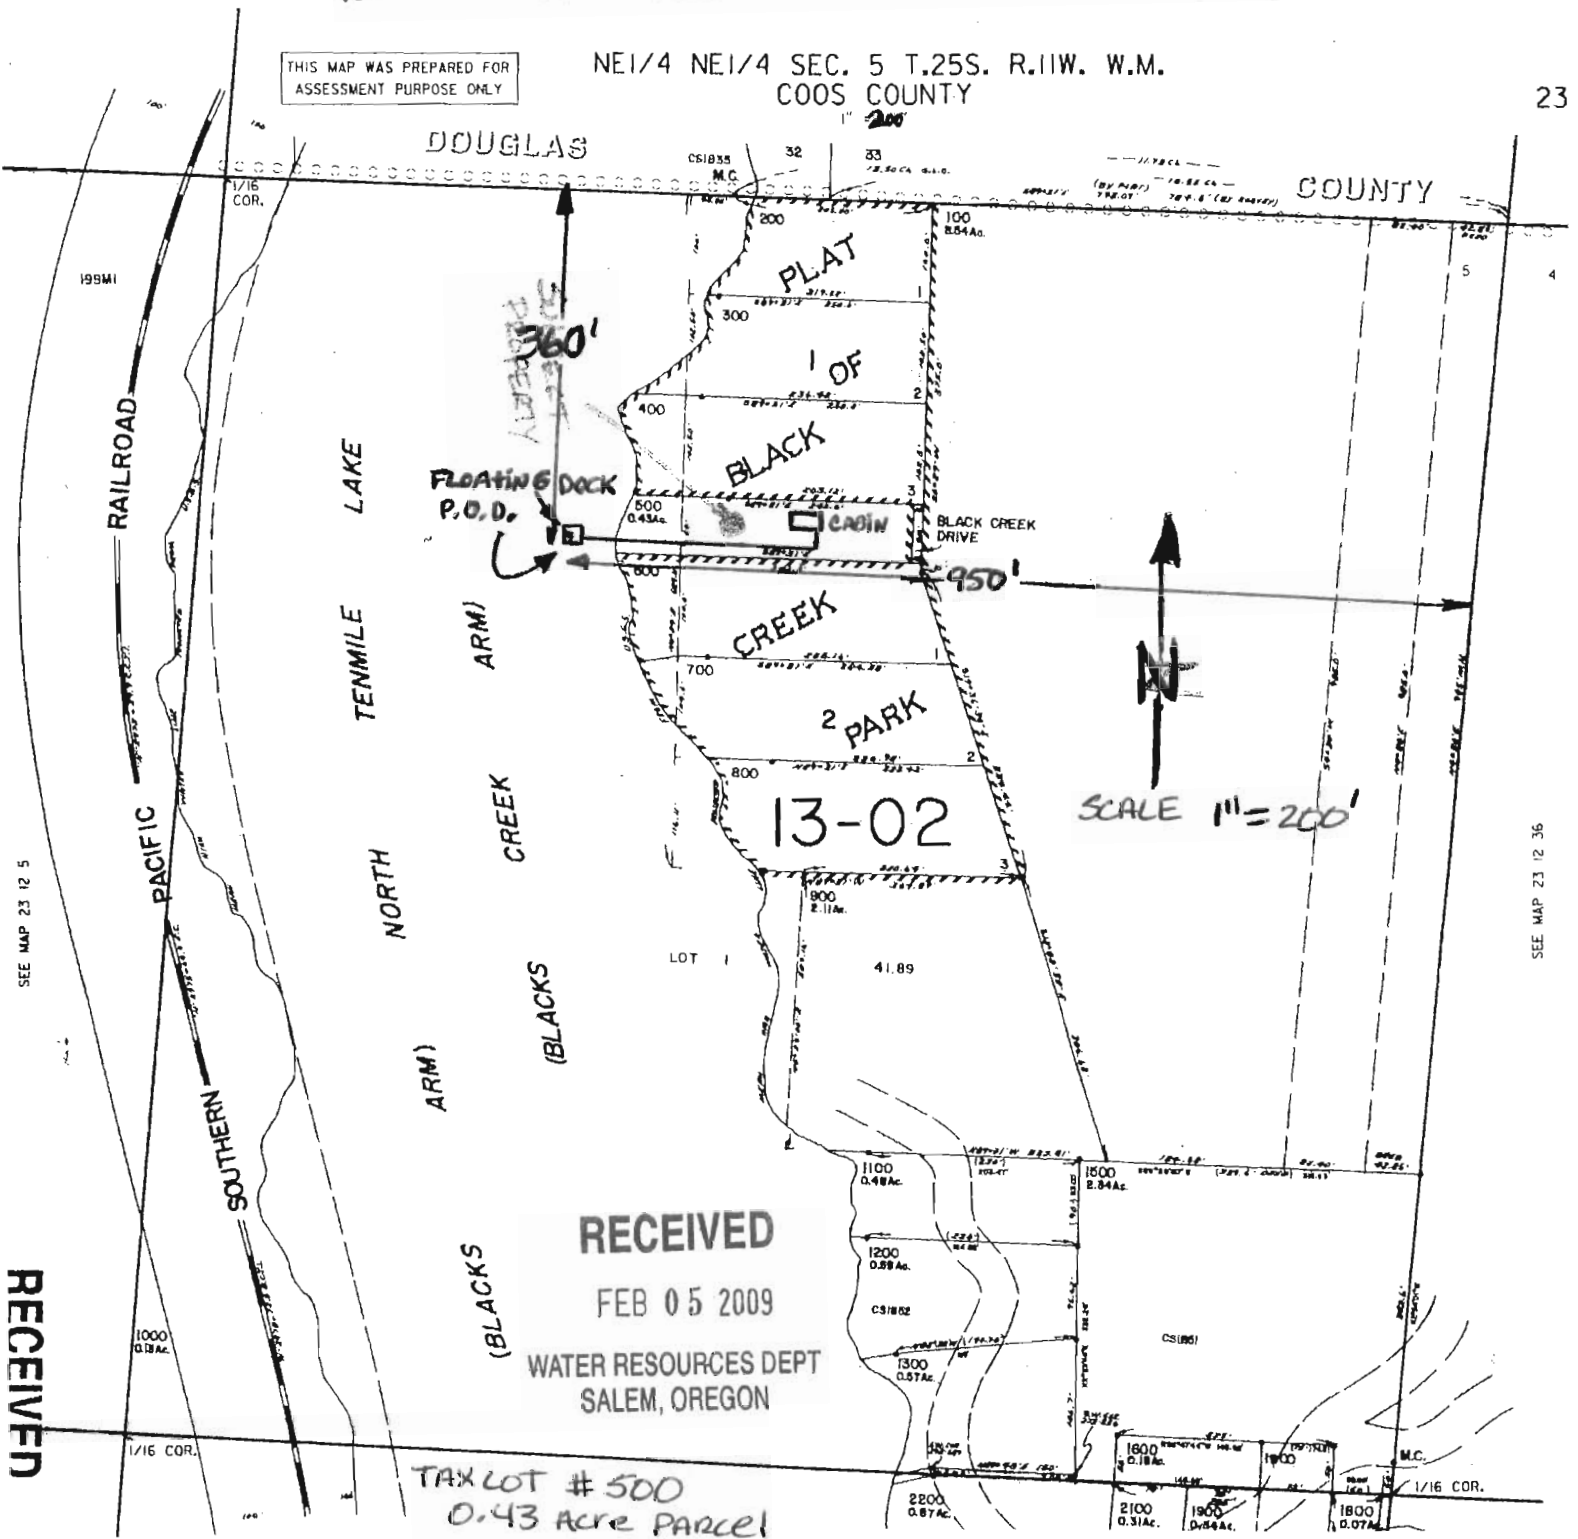

NOTE: THE P.O.D. IS A SUBMERSIBLE PUMP
LOCATED ON A FLOATING DOCK (PERMIT FROM)
360 FEET SOUTH
950 FEET WEST

OF THE N.E. CORNER OF SECTION 5
T.25S, R.11W., WM $43^{\circ}36'37''$ N
 $124^{\circ}08'41''$ W
THE WATERLINE WILL BE SUSPENDED
ON THE 100' OF STEEL RAMP, IT THEN
WILL BE BURIED FOR 125' UPON THE
LAND OWNED BY THE APPLICANT.

CORRECTED ADJUSTED
APPROX. SCALE
1" = 200 FEET

PREPARED FOR: TODD & SUSAN TRIPP
PREPARED BY: TODD TRIPP
DATE: FEBRUARY 3, 2009

JAN 18, 2009

SEPTIC SYSTEM

PLAN/WITH WATERLINE


TODD & SUSAN TRIPP

1631 N TEN MILE LAKE

LAKESIDE, OR 97449

T23-R12W-S05AA TL 500

ZONING RR-2

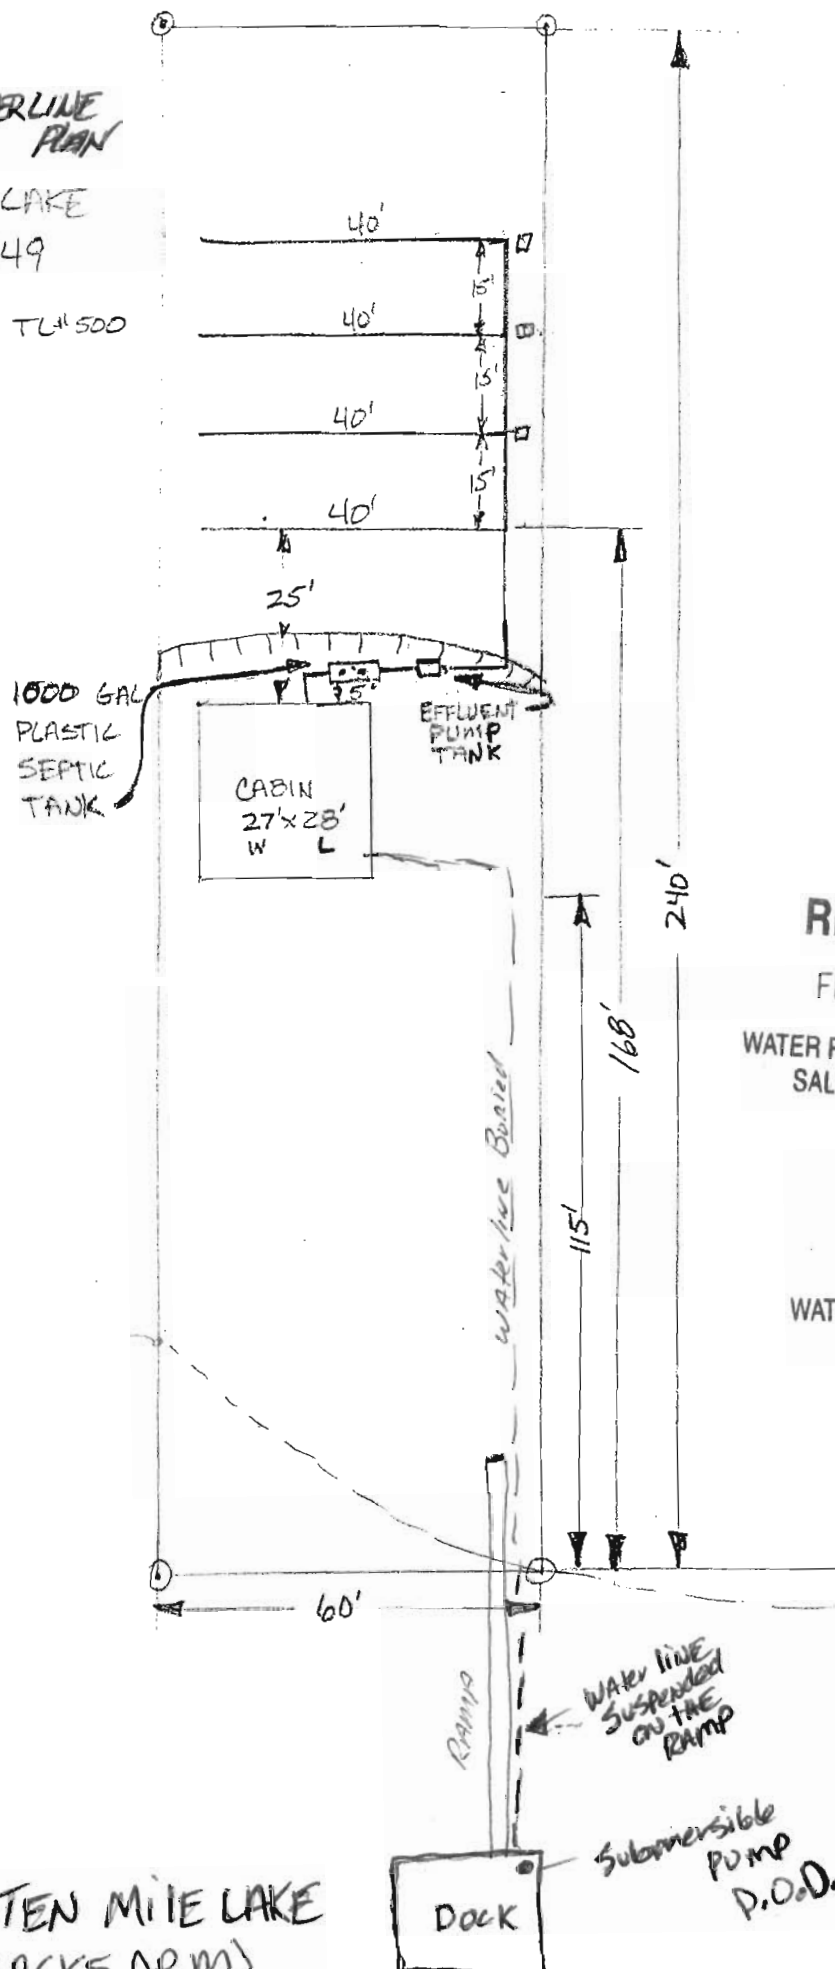

RECEIVED


FEB 05 2009

WATER RESOURCES DEPT
SALEM, OREGON

RECEIVED

JAN 22 2009

WATER RESOURCES DEPT
SALEM, OREGONN. TEN MILE LAKE
BLACK CREEK ARM (BLACKS ARM)

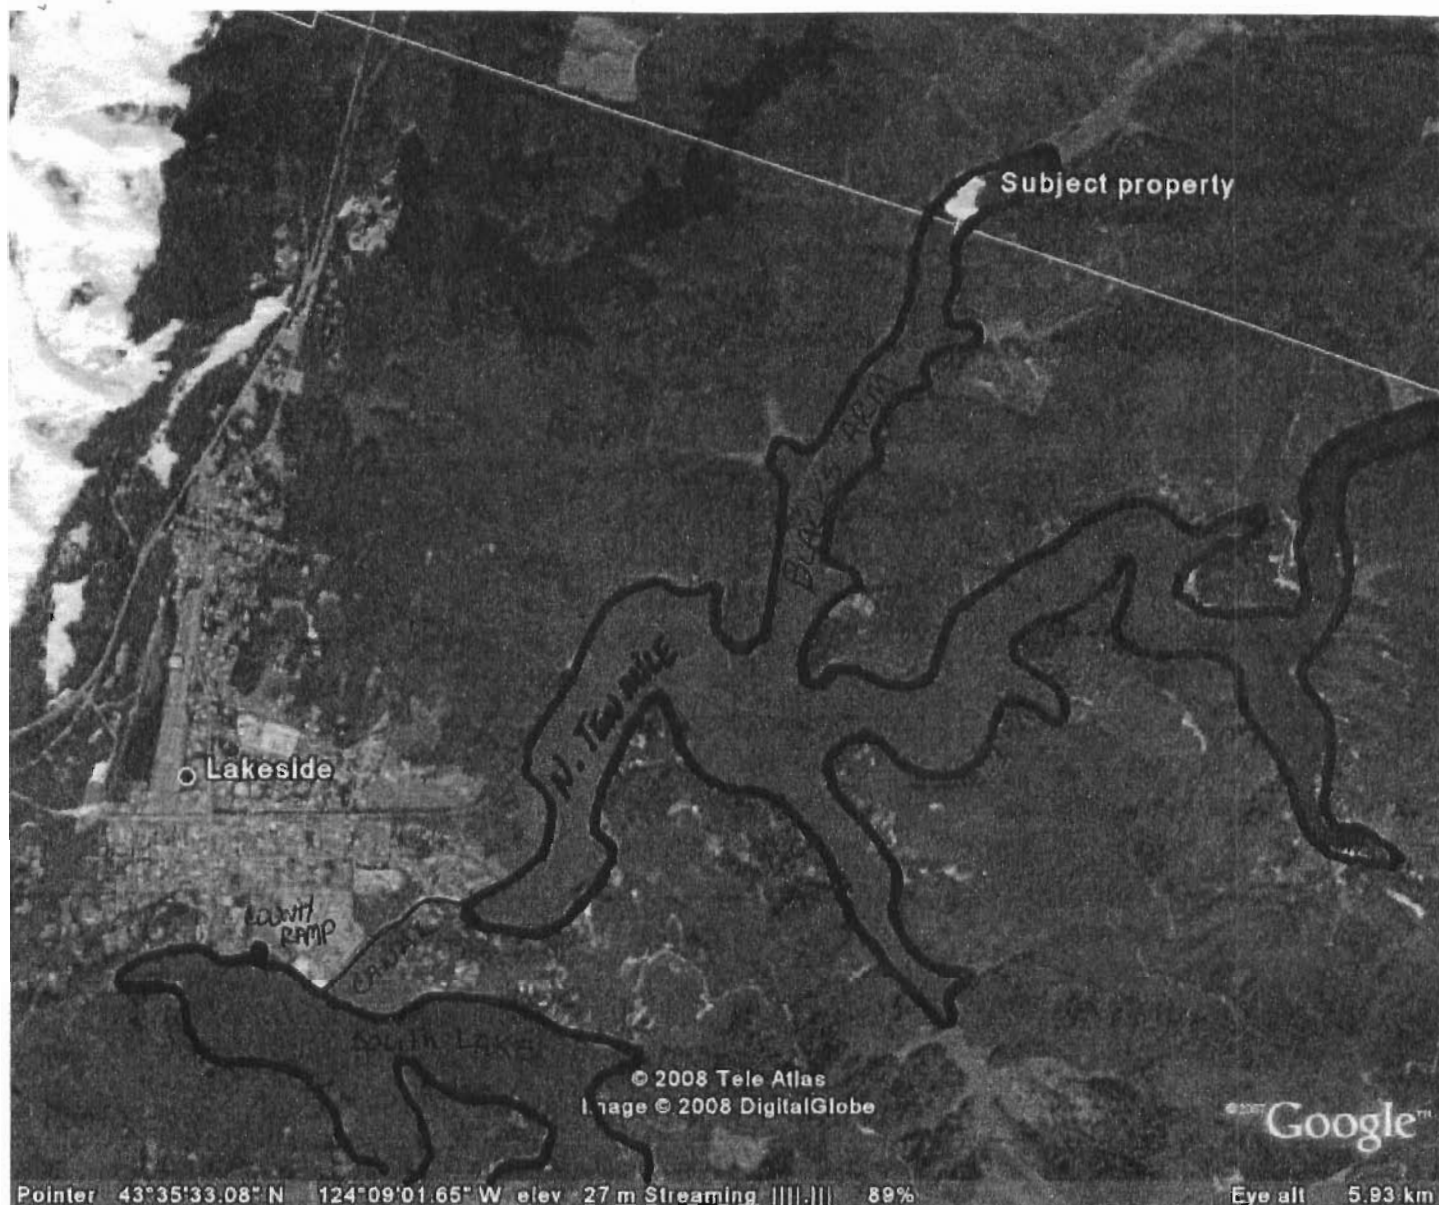

ATTACHMENT E.

RECEIVED

FEB 05 2009

WATER RESOURCES DEPT
SALEM, OREGON**RECEIVED**

JAN 22 2009

WATER RESOURCES DEPT
SALEM, OREGON**PROPERTY DIRECTIONS:**

- 1) GO TO COOS COUNTY RAMP/DOLK AT SOUTH TEN MILE LAKE, LAKESIDE OREGON
- 2) LAUNCH BOAT
- 3) TRAVEL BY BOAT 1/4 MILE EAST TO THE ENTRANCE TO THE CANAL, TRAVEL THROUGH CANAL TO NORTH LAKE
- 4) GO THROUGH MAIN NORTH LAKE CHANNEL - THE FIRST ARM ON THE LEFT IS BLACKS ARM BOAT NEARLY TO THE END,

OUR PROPERTY IS THE 3RD PROPERTY FROM THE END
WE ARE THE ONLY DOLK & RAMP SYSTEM ANCHORED WITH STEEL PILING