

# REQUEST FOR ASSIGNMENT

I, Douglas J. & Elsie D. Newman  
 (Name of Applicant / Permit / Transfer Holder)  
17034 131g muddy creek Ln  
Route 1, Box 59A Haines OR 97833 (541) 856-3746  
 (mailing address) (City) (State) (Zip) (Phone #)

## CHECK ONE

- ...hereby assign **all my interest** in and to application/permit/transfer;
- ...hereby assign **all my interest** in and to a **portion** of application/permit/transfer;  
 (You must include a map showing the portion of the application/permit to be assigned.)
- ...hereby assign **a portion of my interest** in and to the **entire** application/permit/transfer;

Application # G-13804, Permit # G-13738, Transfer # \_\_\_\_\_

-OR-

GR Statement # \_\_\_\_\_, GR Certificate of Registration # \_\_\_\_\_

as filed in the office of the Water Resources Director, to:

Eugene W. Gramzow  
 (Name of New Owner)

678 Rendezvous Ct. Pagosa Springs CO 81147 (970) 731-9518  
 (mailing address) (City) (State) (Zip) (Phone #)

**NOTE:** If there are other owners of the property described in this Application, Permit, Transfer or Certificate of Ground Water Registration, you must provide a list of all other owners' names and mailing addresses and attach it to this form.

I hereby certify that I have notified all other owners of the property described in this Application, Permit or Certificate of Registration of this request for assignment.

Witness my hand this 3<sup>rd</sup> day of Feb, 2004.

Applicant/Permit holder Douglas J. Newman

Applicant/Permit holder Elsie D. Newman

*OK 2/28/04 by JOURNAL  
 3/19/04*

## DO NOT WRITE IN THIS BOX

- This certifies assignment and record change at Oregon Water Resources Department effective 8:00a.m. on date of receipt at Salem, Oregon.  
 - Fee receipt # 65785  
 - For Director by Jerry Sauter, Program Analyst in Water Rights Division *J.S.*

The completed "Request for Assignment" form must be submitted to the Department along with the appropriate recording fees:

- ◆ \$25 for the first page, and
- ◆ \$5 for each additional page.  
 [as required by ORS 536.050(1)(d)]

**WATER RESOURCES DEPARTMENT**  
**725 SUMMER STREET NE, SUITE A**  
**SALEM, OREGON 97301-1271**

**RECEIVED**

MAR 03 2004

WATER RESOURCES DEPT

# DOUGLAS NEWMAN


**RECEIVED**

SEP 30 1996

## WELL FOR SUPPLEMENTAL IRRIGATION

WATER RESOURCES DEPT.  
SALEM, OREGON

### T7S, R38EWM

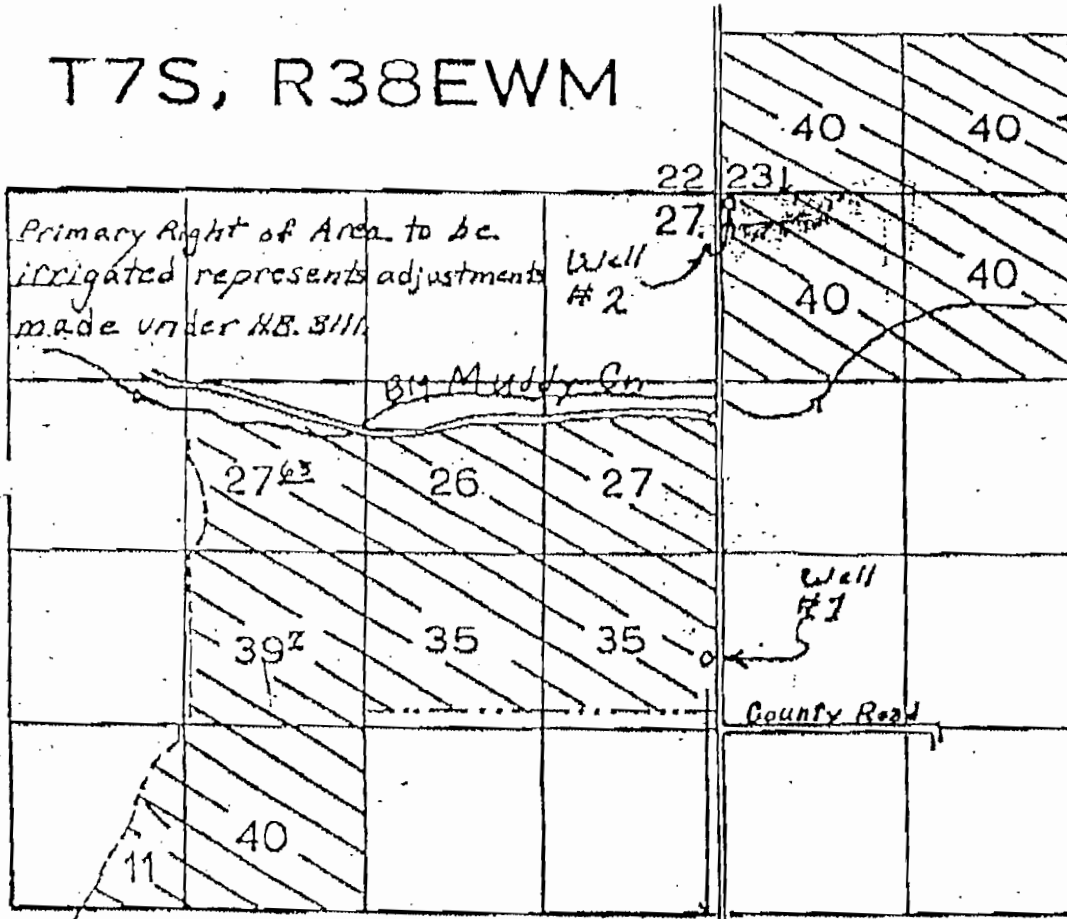

Area to be Irrigated

Lands in Sec. 23 + 26 To Remain in original applicants Name


\* Note:  
Lands in Sec. 27 Requesting Assignment

Scale 1"=1320'

Well number 1 is located 2055 ft south and 50 ft west of the corner common to sections 25, 26 & 27 T. 8 S., R. 38 E., W.M.

Well number 2 is located 10 ft south and 50 ft east of the corner common to sections 25, 26 & 27 T. 8 S., R. 38 E., W.M.

Drawn by *JOM* Date 8-26-94  
Revised by *TMK* Date 9-23-96

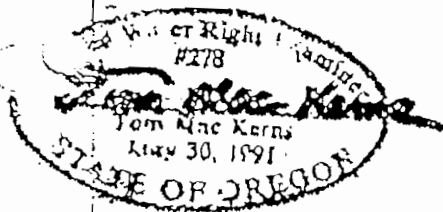

**RECEIVED**

MAR 03 2004

WATER RESOURCES DEPT.  
SALEM, OREGON

SHEET 1 of 2

A. G-13804  
P. G-13738