


R-87391

RECEIVED Monmouth

JUL 8 1996 3.6 mi
WATER RESOURCES DEPT.
SALEM, OREGON

R. 5 W.

Bruce E. and Wendy S. Robbins
14975 Fishback Road
Monmouth OR 97361

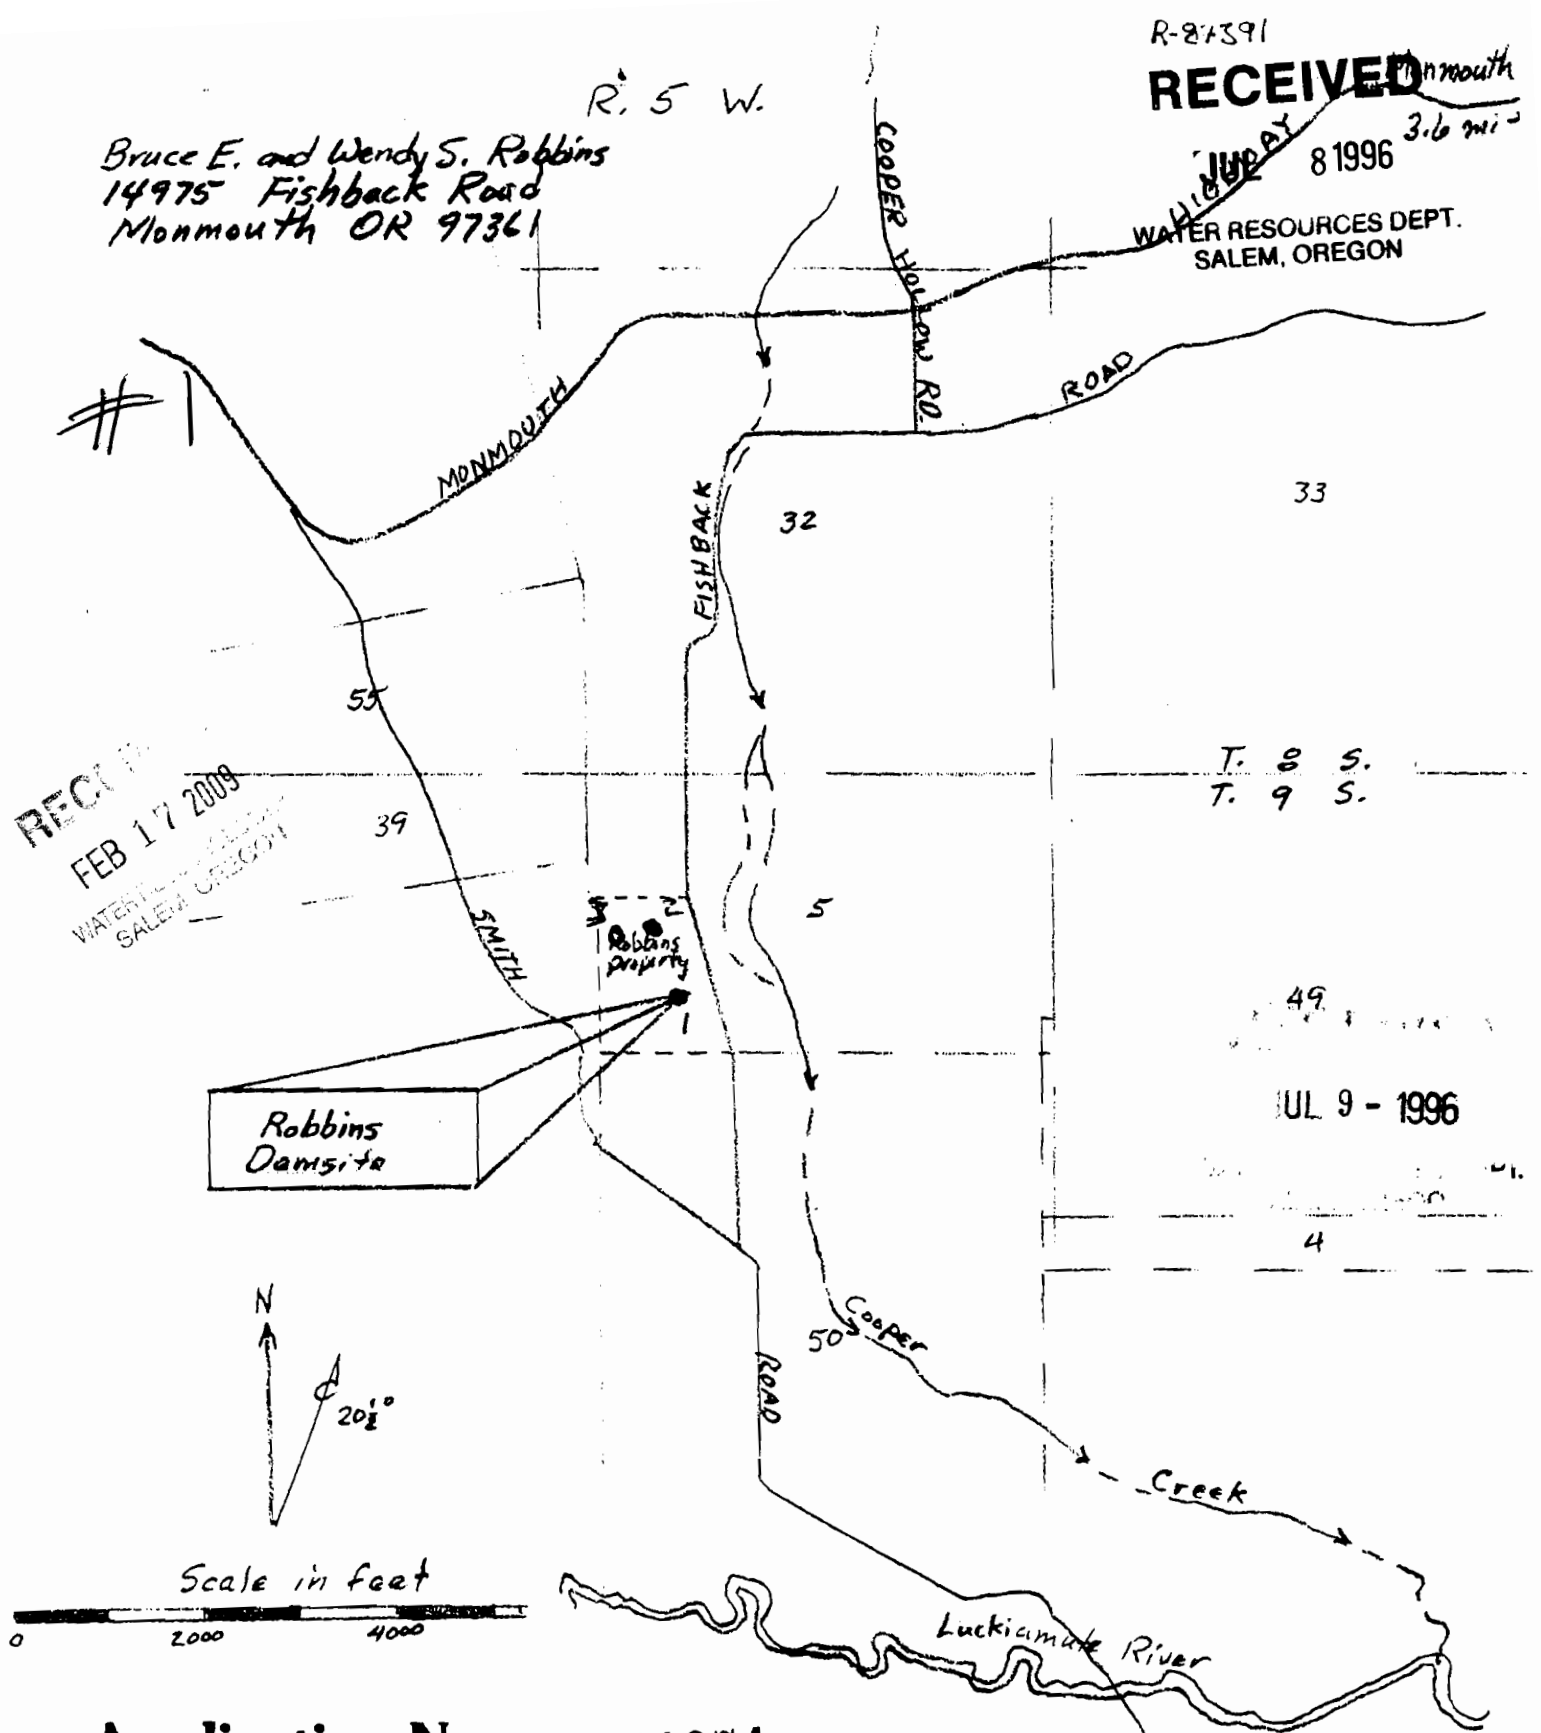

Application No. R - 81274
Permit No. R12149

The Robbins damsite is located approximately 2500 feet south 21°00' East of the Northwest corner of Section 5, Township 9 South, Range 5 West of the W.M.

IMPORTANT
 This Map for Assessment
 and Taxation Purposes
 ONLY

RECEIVED

FEB 17 2009

WATER RESOURCES DEPT
 SALEM, OREGON


SEC.5 T9S R5W WM
 POLK COUNTY

Scale 1" = 600'

R-87391

See Map 8.5.32

WESTVIEW
 LANE

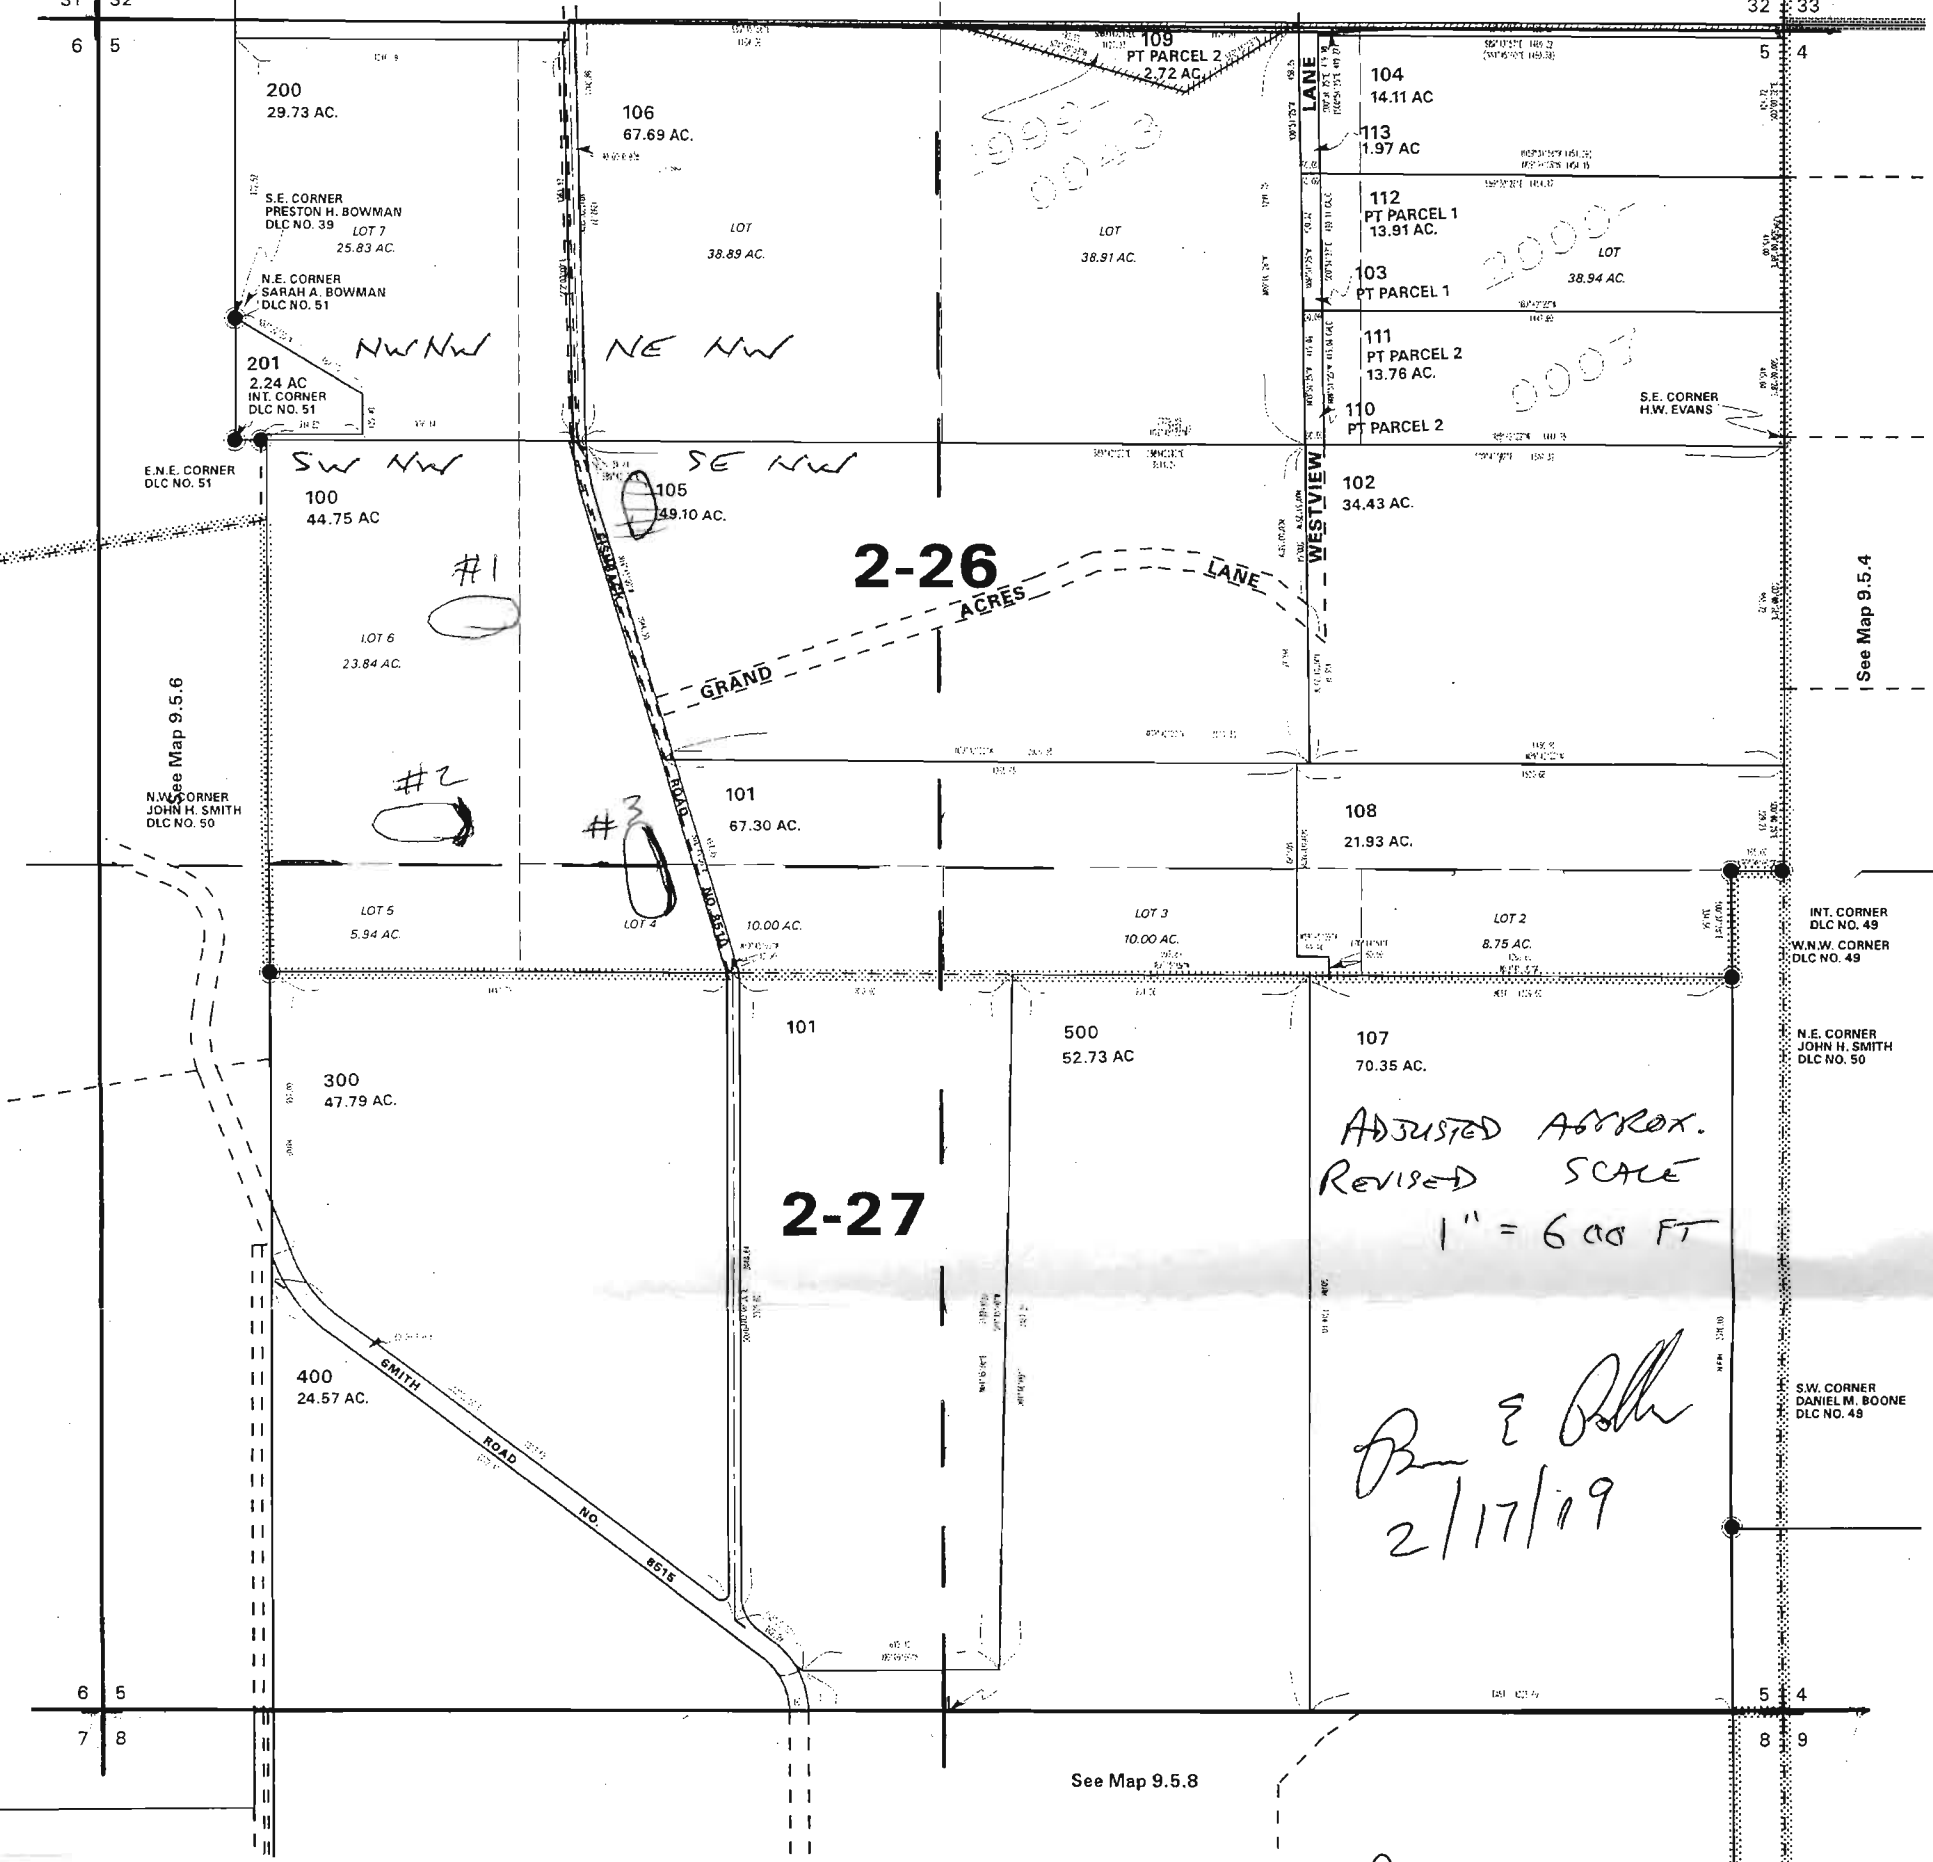

See Map 9.5.4

INT. CORNER
 DLC NO. 49
 W.N.W. CORNER
 DLC NO. 49

N.E. CORNER
 JOHN H. SMITH
 DLC NO. 50

S.W. CORNER
 DANIEL M. BOONE
 DLC NO. 48

See Map 9.5.8

3 RESERVOIRS MEASURED from
 NW CORNER SECTION 5

RESERVOIR #1	1850	ft	SOUTH	&	1150	ft	EAST
RESERVOIR #2	2500	ft	SOUTH	&	1000	ft	EAST
RESERVOIR #3	2650	ft	SOUTH	&	1725	ft	EAST