


R-87393

RECEIVED Monmouth
JUL 8 1996 3.6 mi
WATER RESOURCES DEPT.
SALEM, OREGON

R. 5 W.

Bruce E. and Wendy S. Robbins
14975 Fishback Road
Monmouth OR 97361

#2

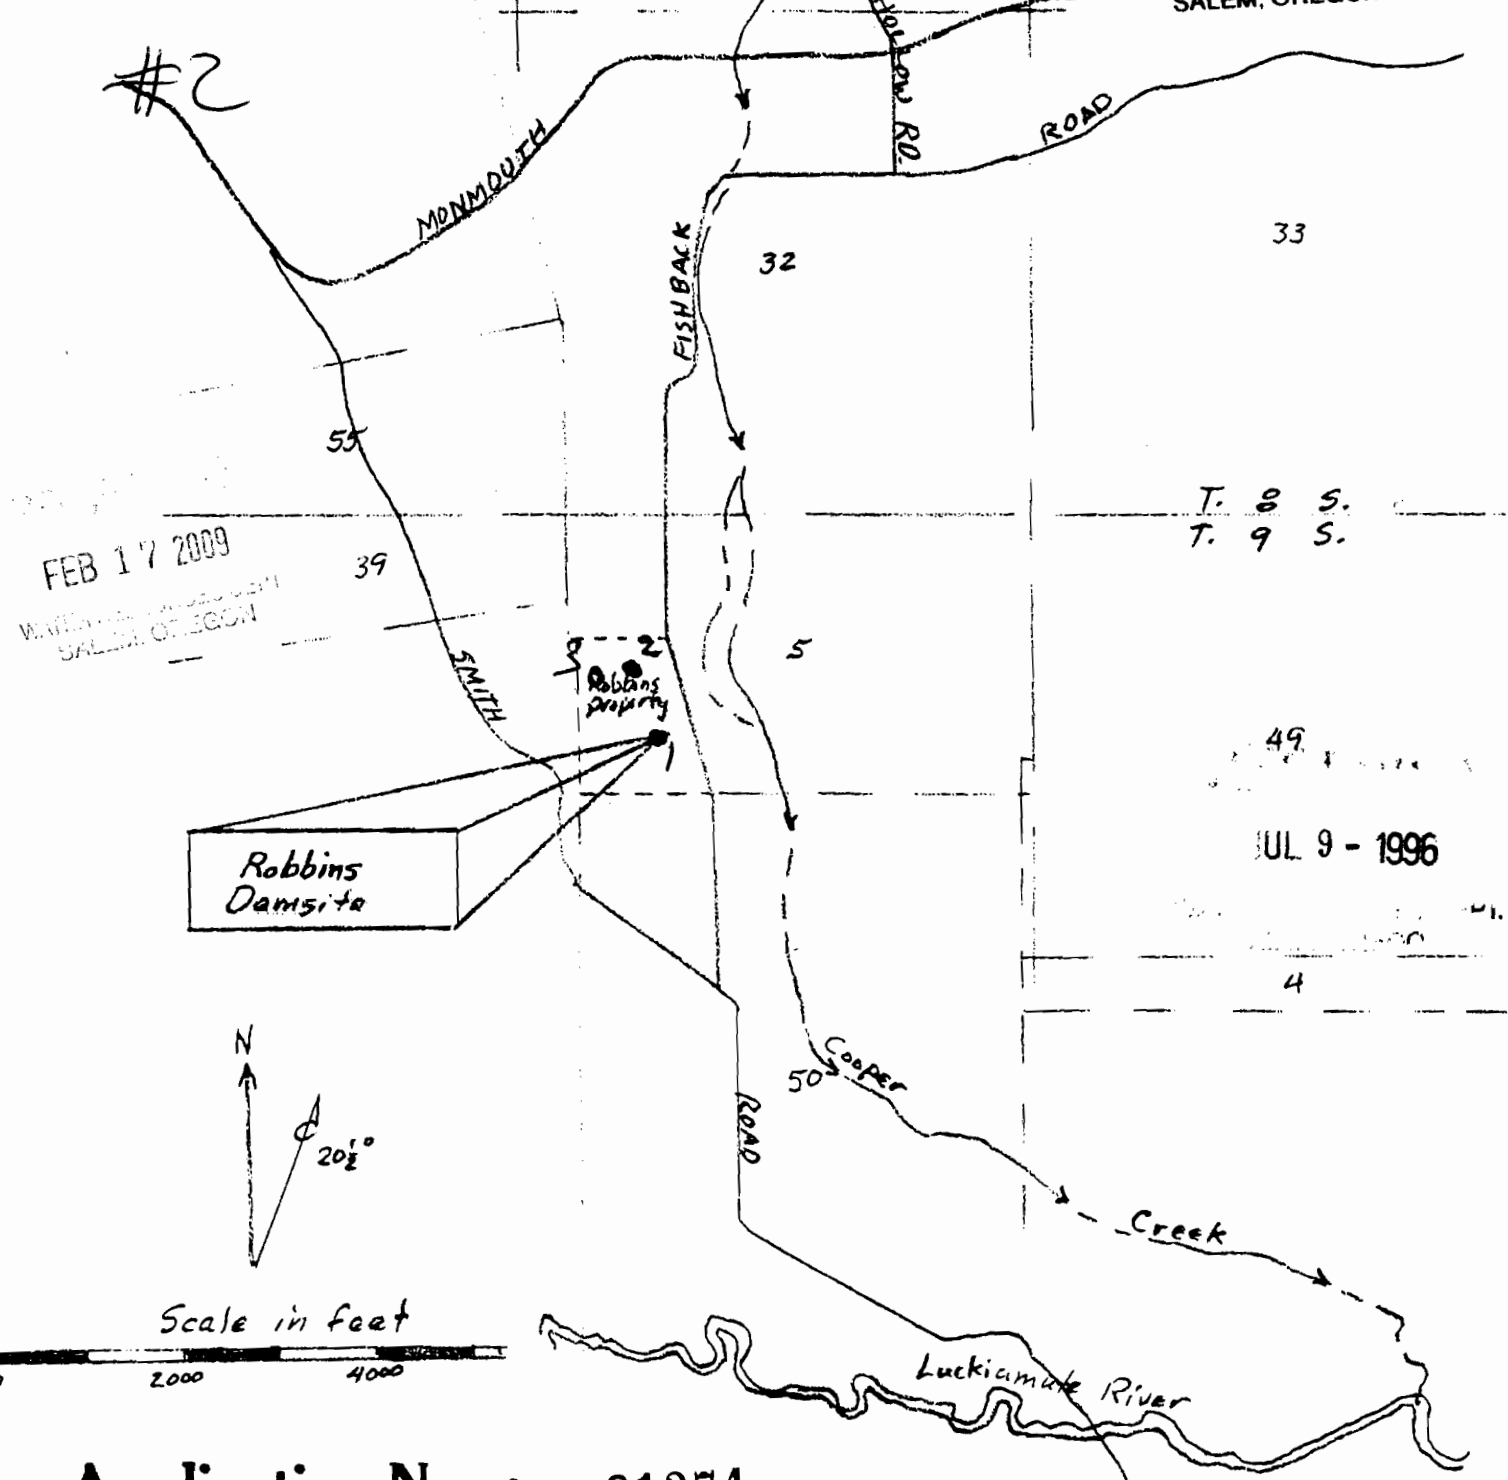

FEB 17 2009
WATER RESOURCES DEPT.
SALEM, OREGON

T. 8 S.
T. 9 S.

JUL 9 - 1996

Application No. R- 81274
Permit No. R12149

The Robbins damsite is located approximately 2500 feet south 21°00' East of the Northwest corner of Section 5, Township 9 South, Range 5 West of the U.M.

IMPORTANT
This Map for Assessment
and Taxation Purposes
ONLY

SEC. 5 T9S R5W WM
POLK COUNTY

Scale 1" = 600'


RECEIVED

FEB 17 2009

WATER RESOURCES DEPT
SALEM, OREGON

See Map 8.5.32

WESTVIEW
LANE

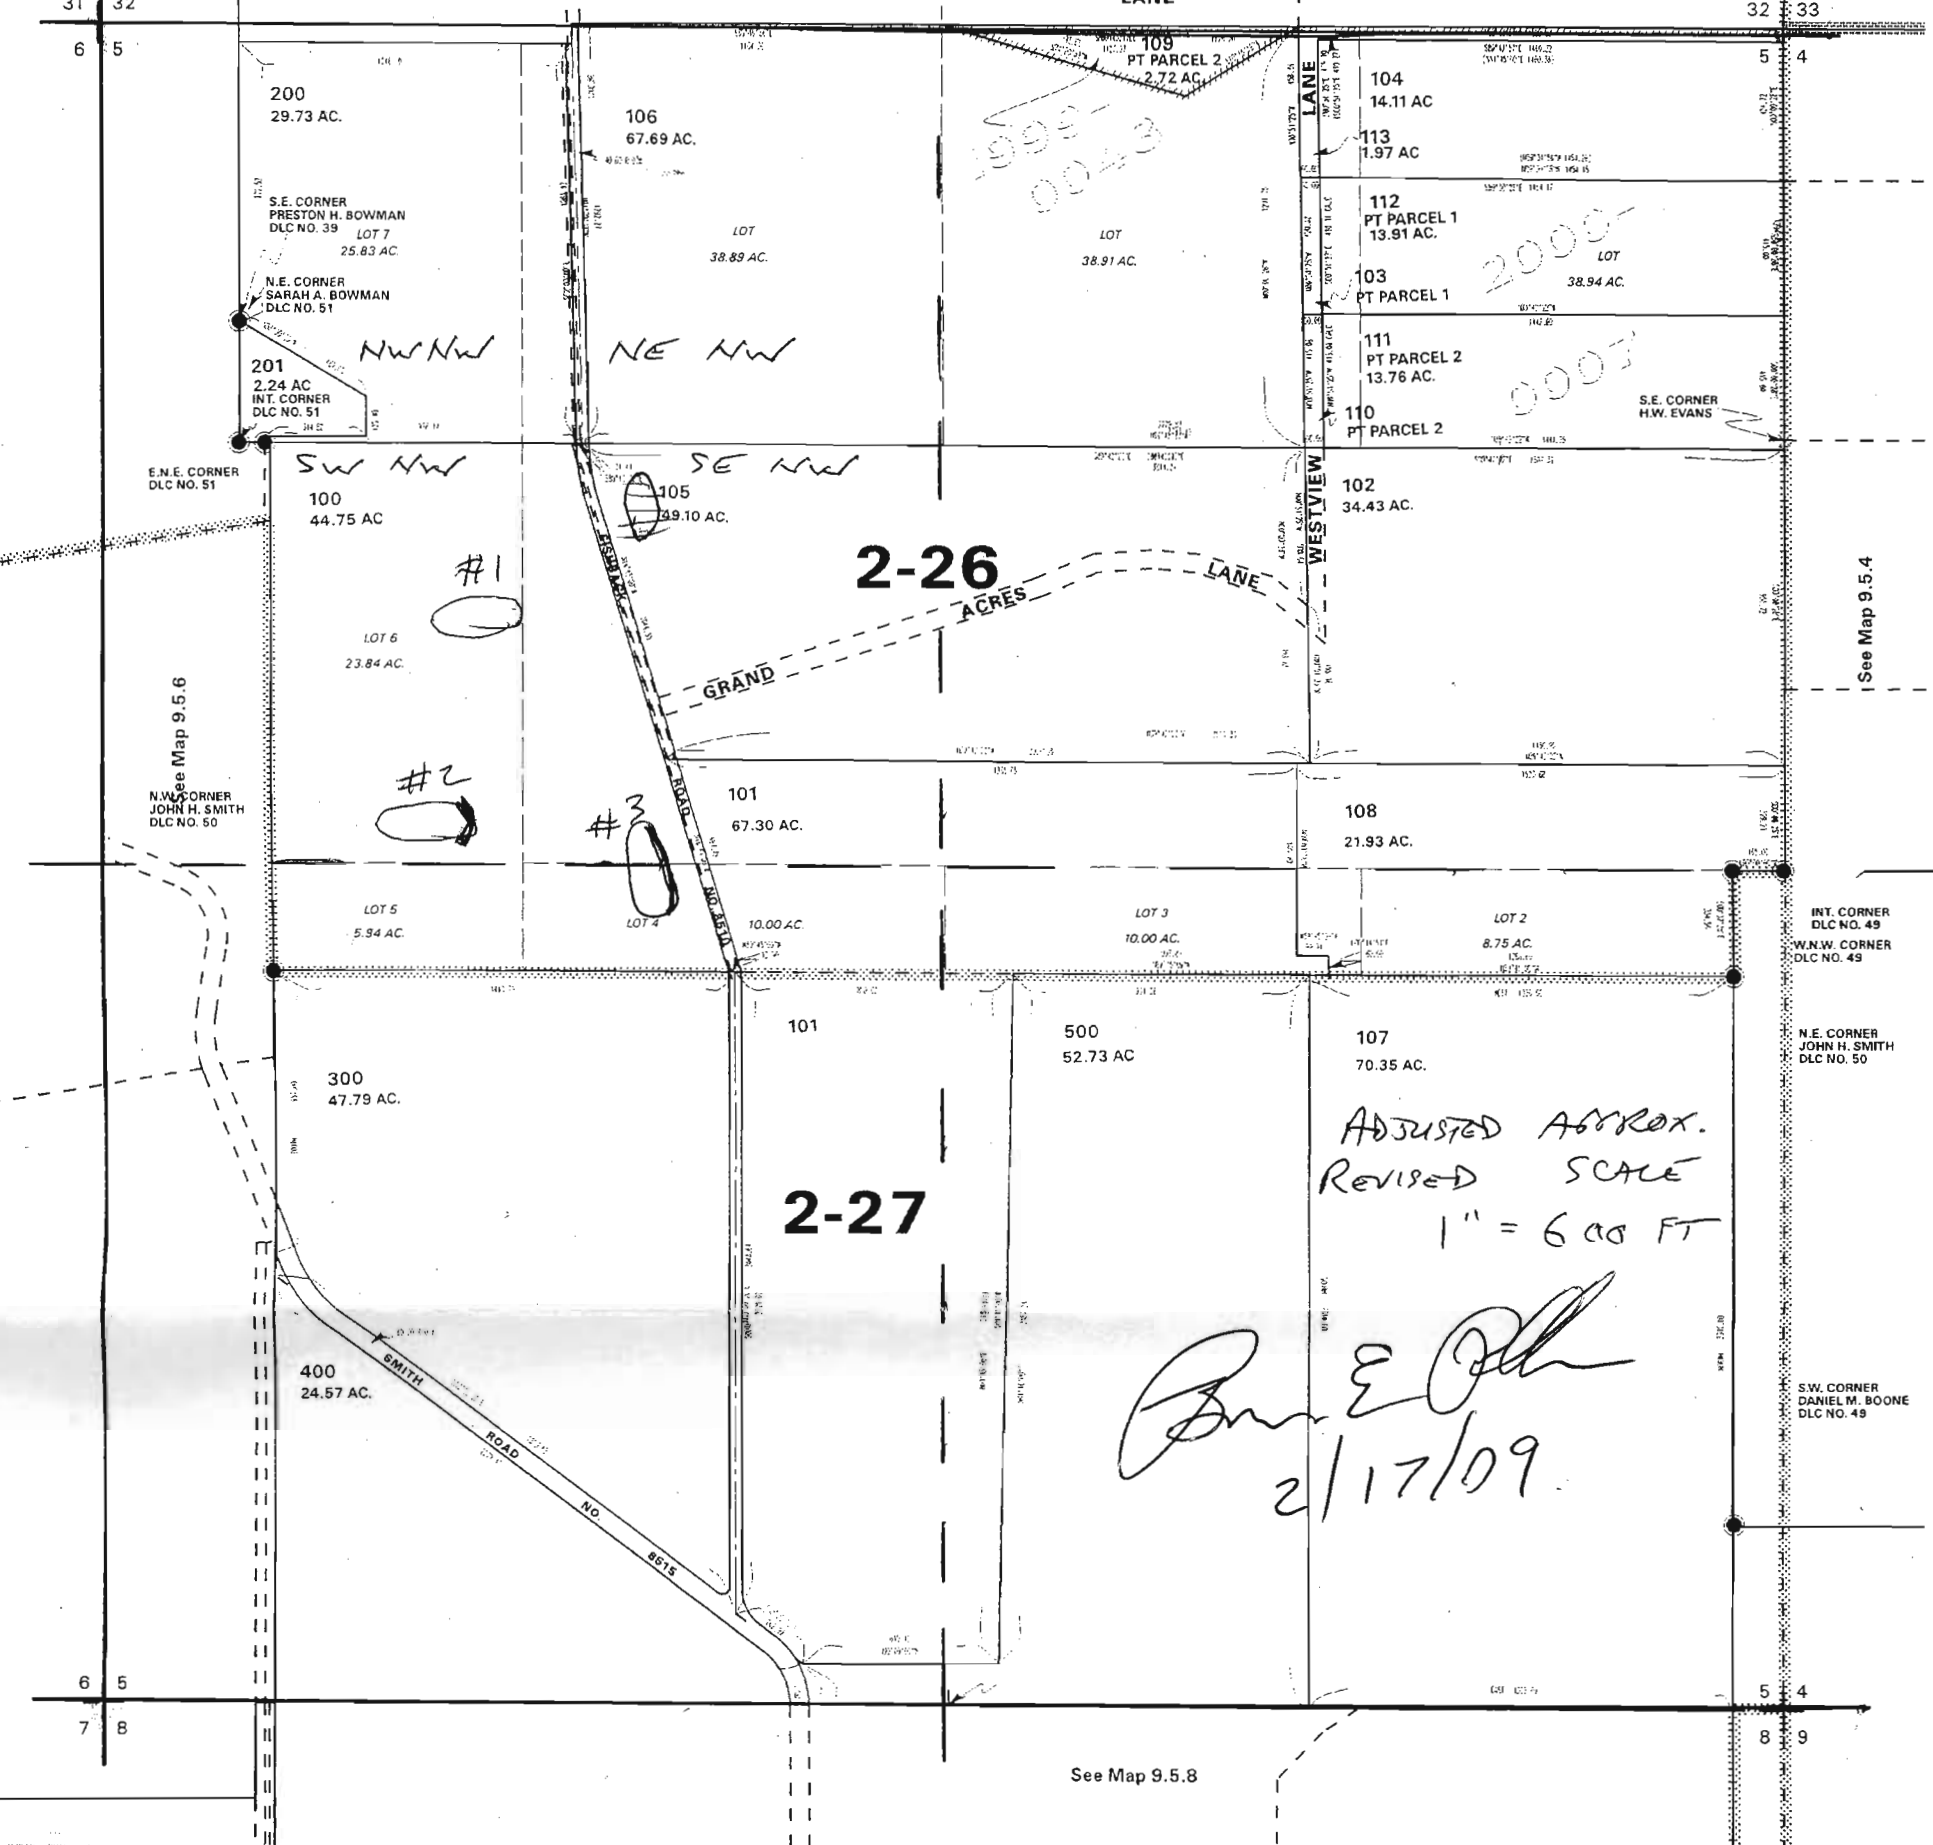

3 RESERVOIRS MEASURED from
NW CORNER SECTION 5

RESERVOIR #1	1850	ft	SOUTH &	1150	ft	EAST
RESERVOIR #2	2500	ft	SOUTH &	1000	ft	EAST
RESERVOIR #3	2650	ft	SOUTH &	1725	ft	EAST