

S.W. 1/4 SEC. 10 T. 33S. R. 15W. W.M.
CURRY COUNTY
1" = 200'

33S15W10C
CANCELLED:

THIS MAP WAS PREPARED FOR
ASSESSMENT PURPOSE ONLY

0 100 200 400 Feet

WATER RESOURCES DEPT.
SALEM, OREGON

FEB 09 2009

RECEIVED

NORTH

P.O.D. IS LOCATED

537.5' south of cen sec.

262.5' west of lot 200 N. line

P.O.U. IS LOCATED

marked 


562.5' south of cen. sec.

262.5' west of lot 200 N. line

WATER RESOURCES DEPT.
SALEM, OREGON

FEB 17 2009

RECEIVED

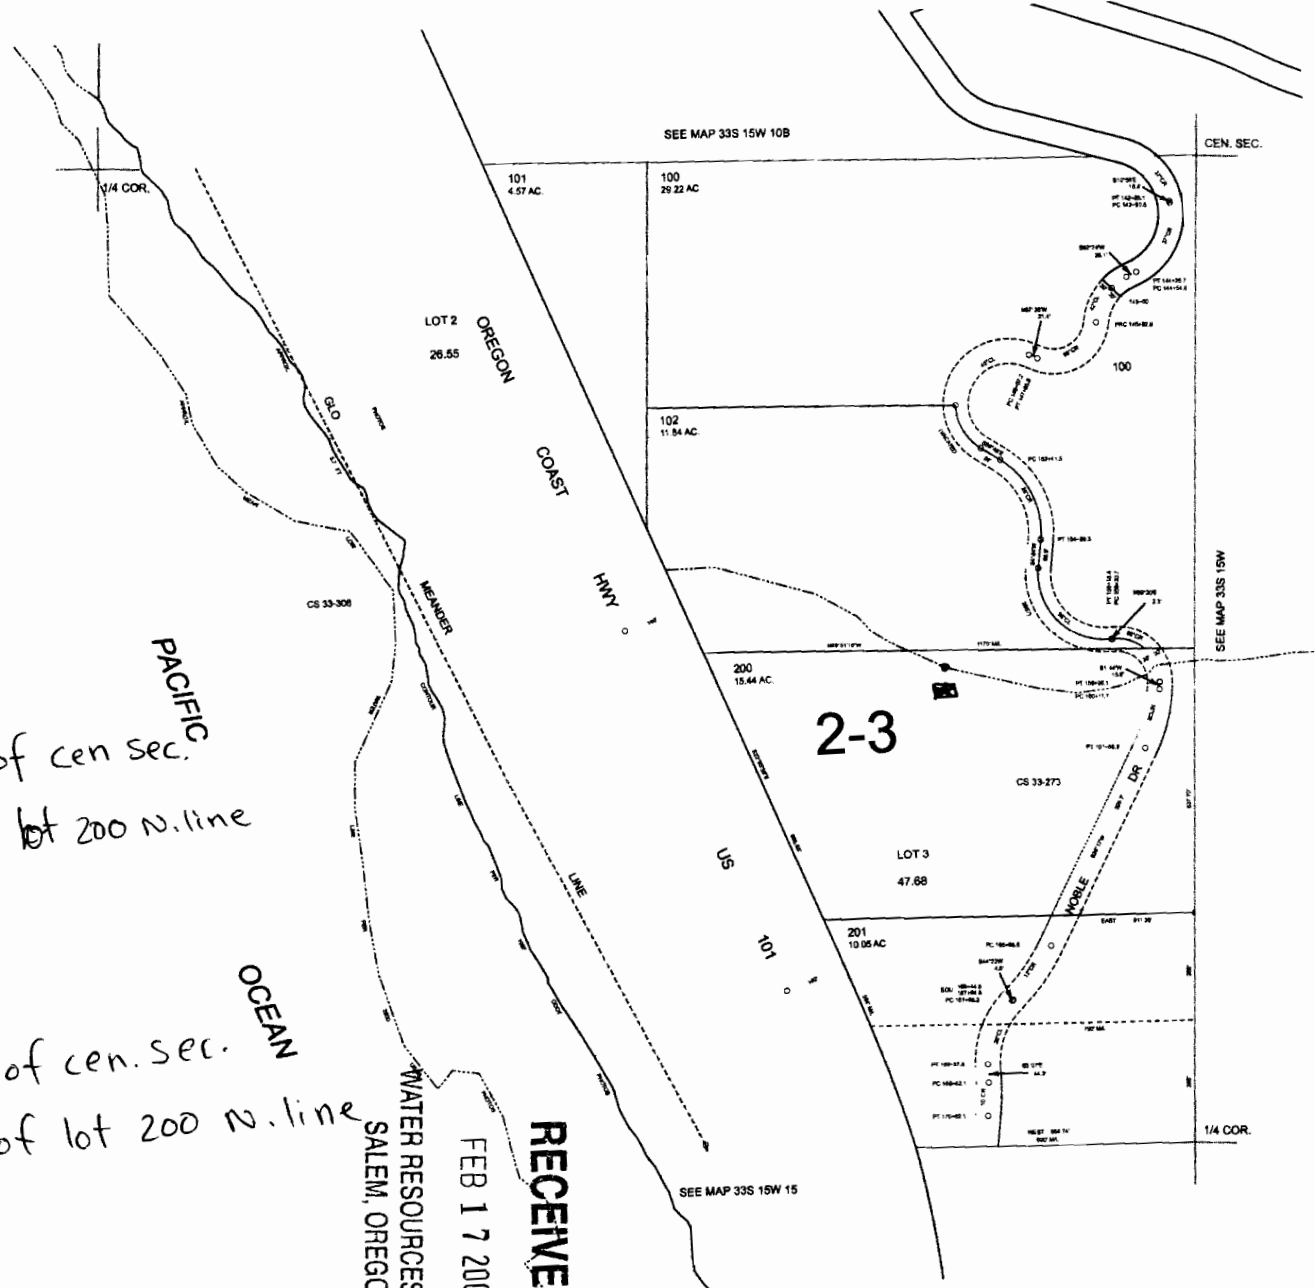

Revised RAA
12/04/2007

33S15W10C

S-87394

S.W.1/4 SEC.10 T.33S. R.15W. W.M.
CURRY COUNTY
1" = 400'

USE THIS MAP

THIS MAP WAS PREPARED FOR
ASSESSMENT PURPOSE ONLY

0 100 200 400 Feet

CORRECTED ADJUSTED
APPROX. SCALE
1" = 400 FEET


WATER RESOURCES DEPT
SALEM, OREGON

FEB 09 2009

RECEIVED

P.O.D. IS LOCATED
1365' south of "cen. sec."
and 600' west

P.O.U. IS LOCATED
marked 
1430' south of "cen. sec."
and 600' west

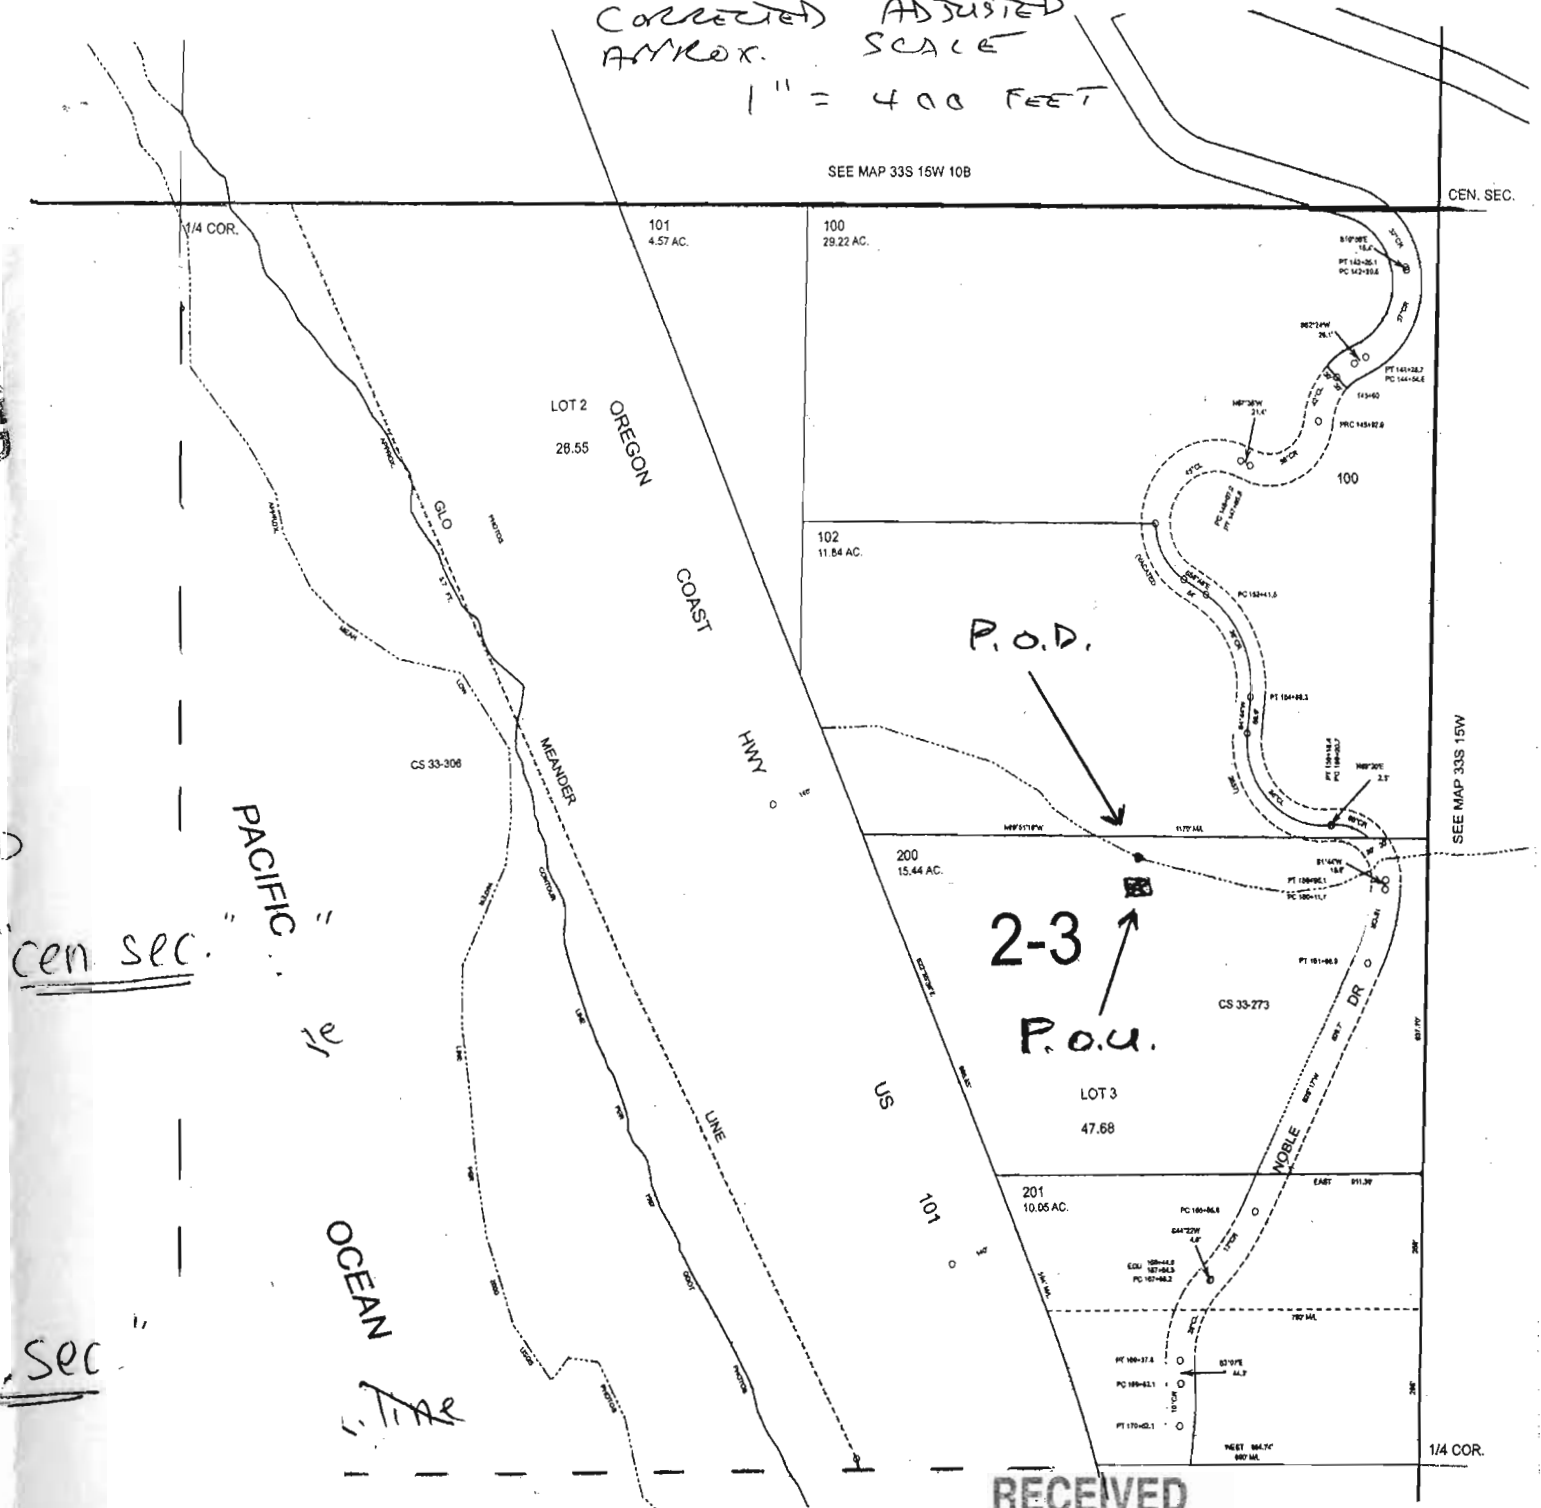

RECEIVED

FEB 17 2009

WATER RESOURCES DEPT
SALEM, OREGON

Teal Fleming 2-12-2009