

RECEIVED


FEB 19 2009

WATER RESOURCES DEPT  
SALEM, OREGON

# T. 1N., R. 32 EWM

UMATILLA COUNTY

N

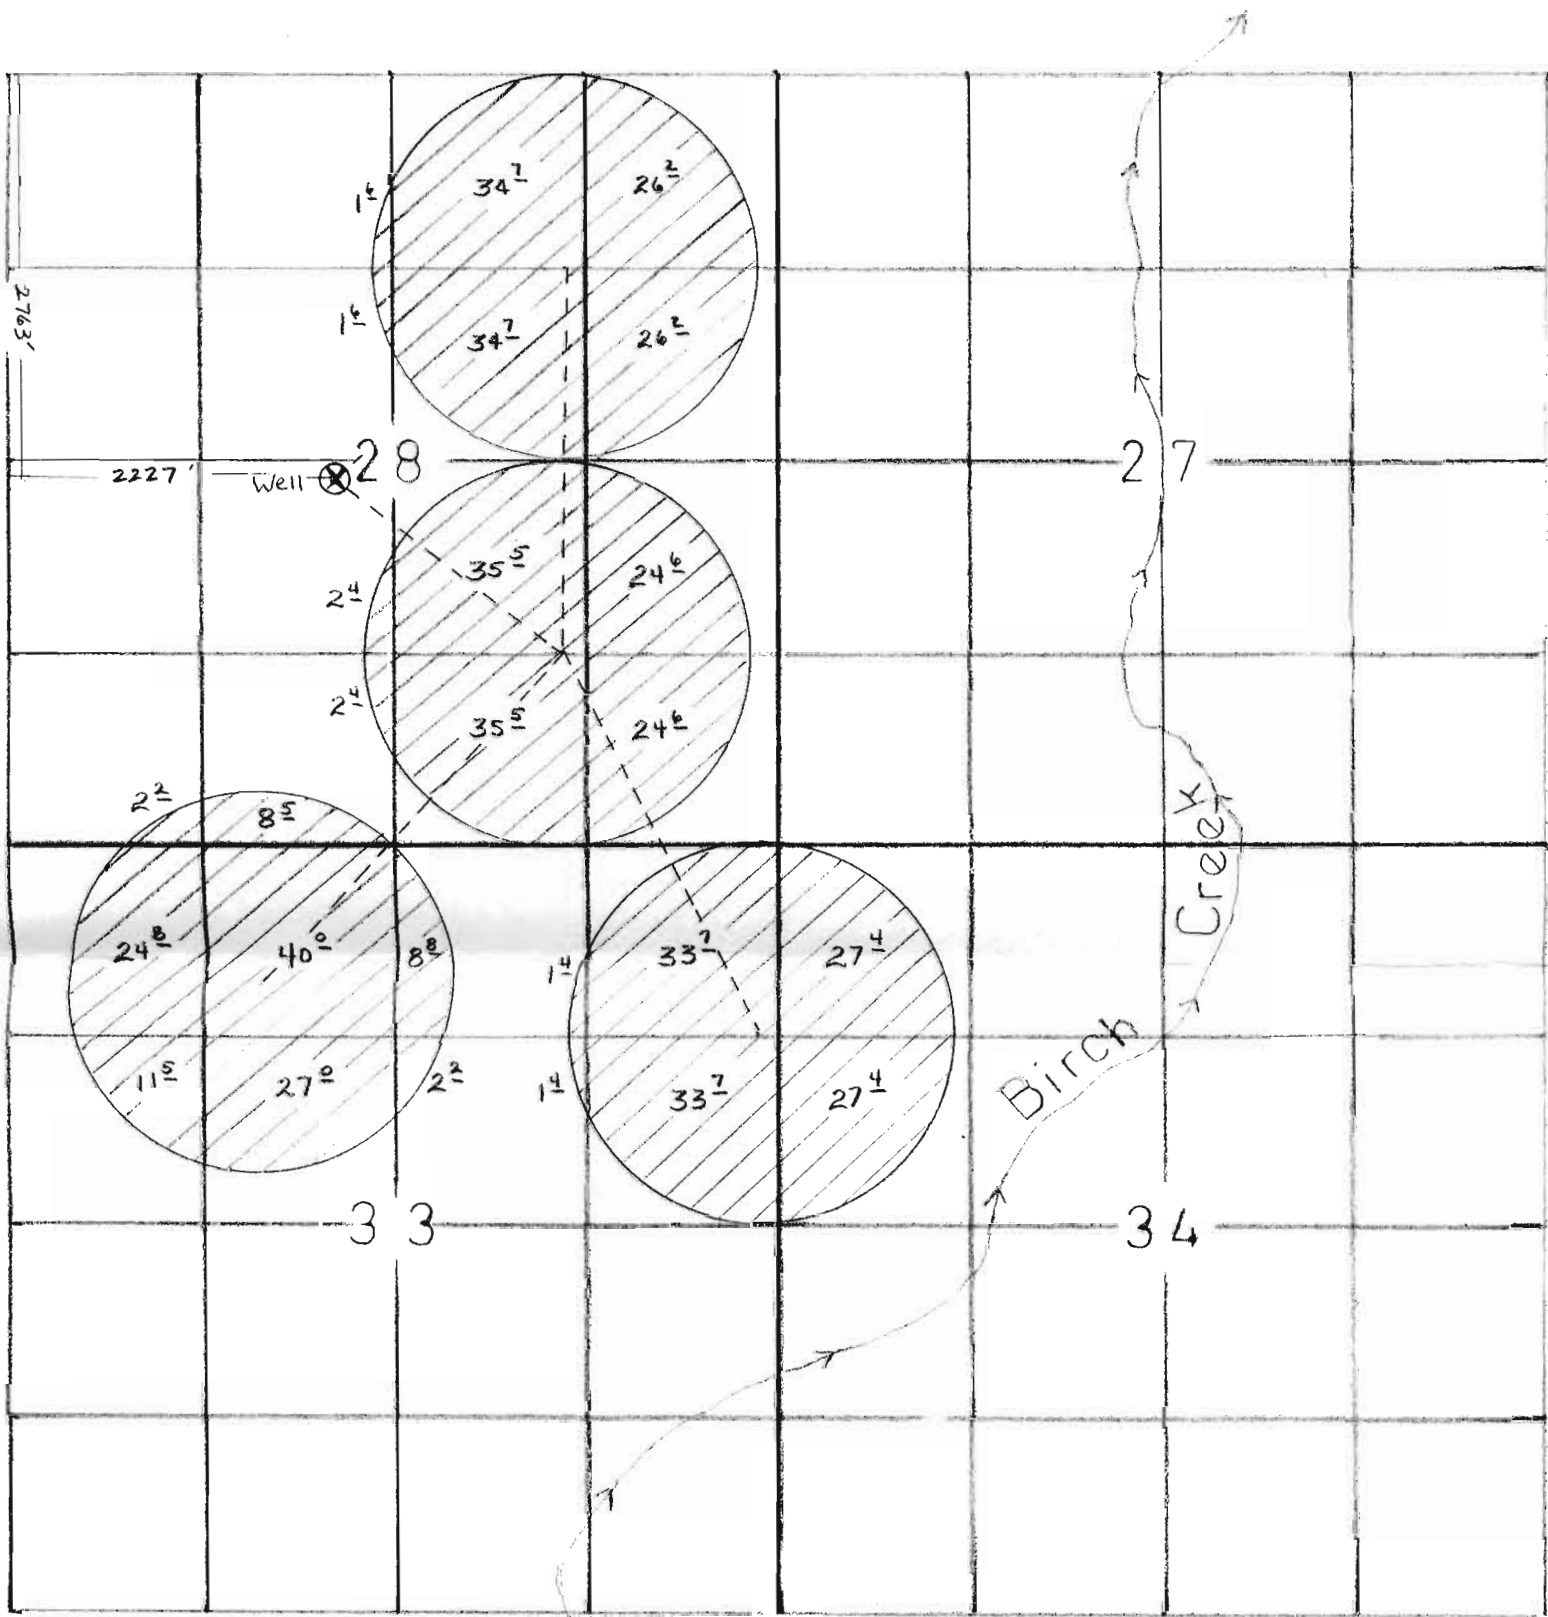

Scale: 1" = 1,320'

G-17119