


T-4791

T. 13S., R. 33E., W. M.

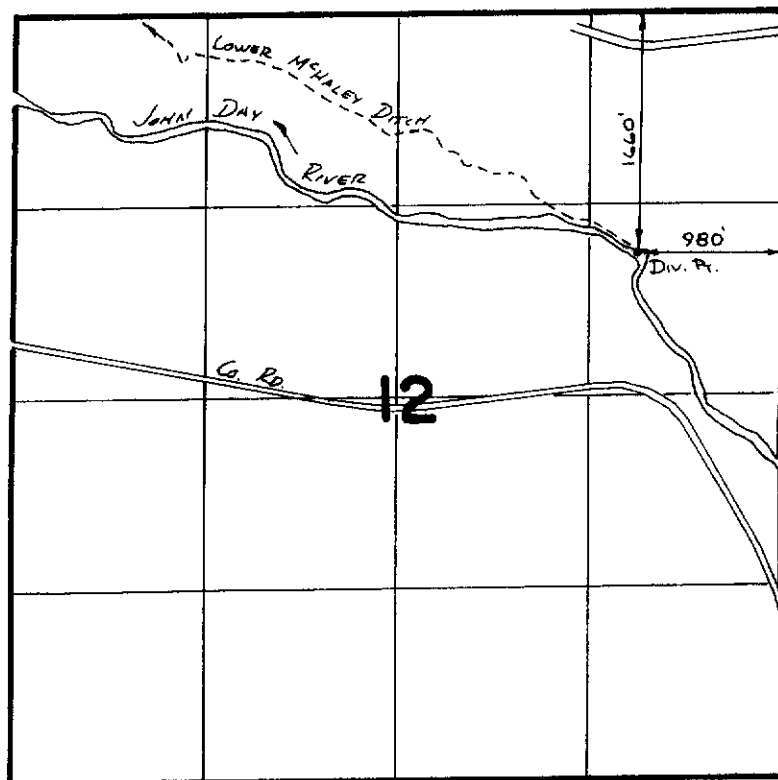

SCALE 1" = 1320'

FINAL PROOF SURVEY
UNDER

TRANSFER 4791
IN NAME OF

.....**JOHN FORREST**.....

Surveyed ..3..19..... 19.86., by h. Tall.....


T. 13 S., R. 33 E., W.M.

T-4791

TRANSFER APPLICATION MAP FOR

S.O.V. 35 P. 176

JOHN FORREST

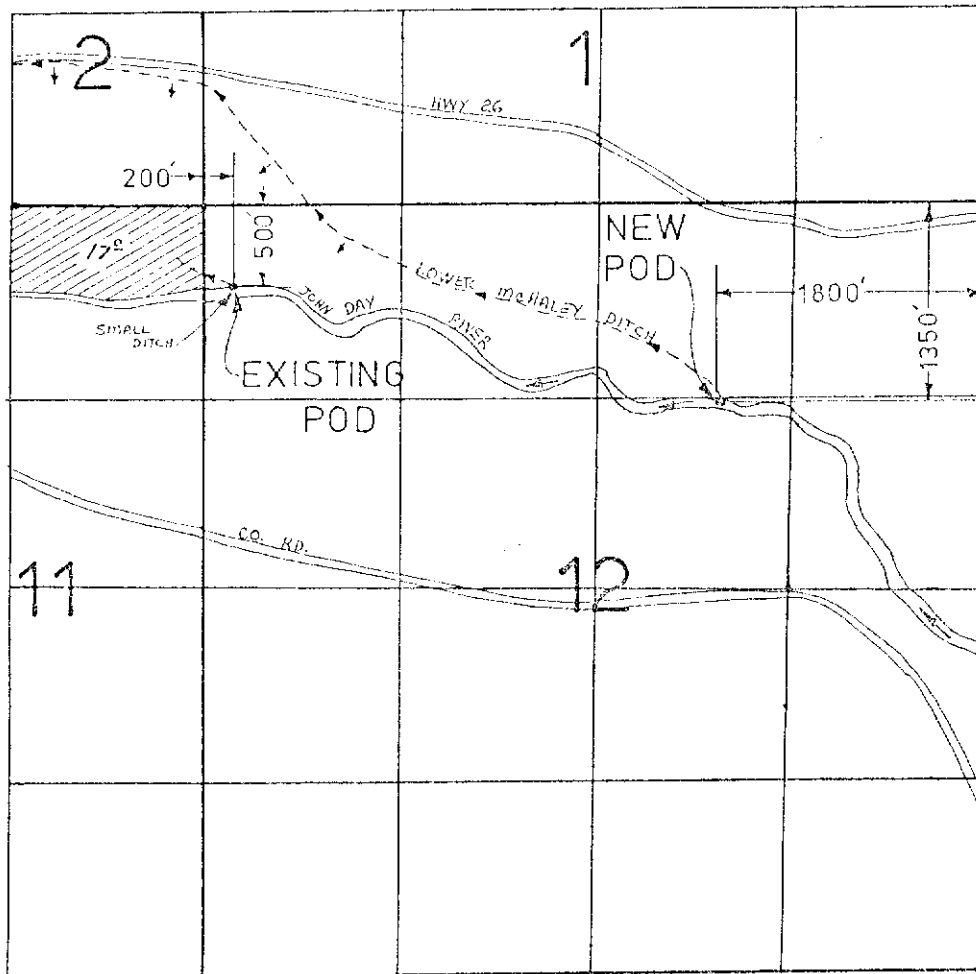

APPROVED _____

RECEIVED

JUN 19 1981

WATER RESOURCES DEPT
SALEM, OREGON