


R-27357

SURFACE WATER APPLICATION
 FOR: PAULETTO RANCH LLC
 BY DUANE W. KIRBY
 T 26S, R 7W W.M. TAX LOT 1400 AND 1800
 SEC 3

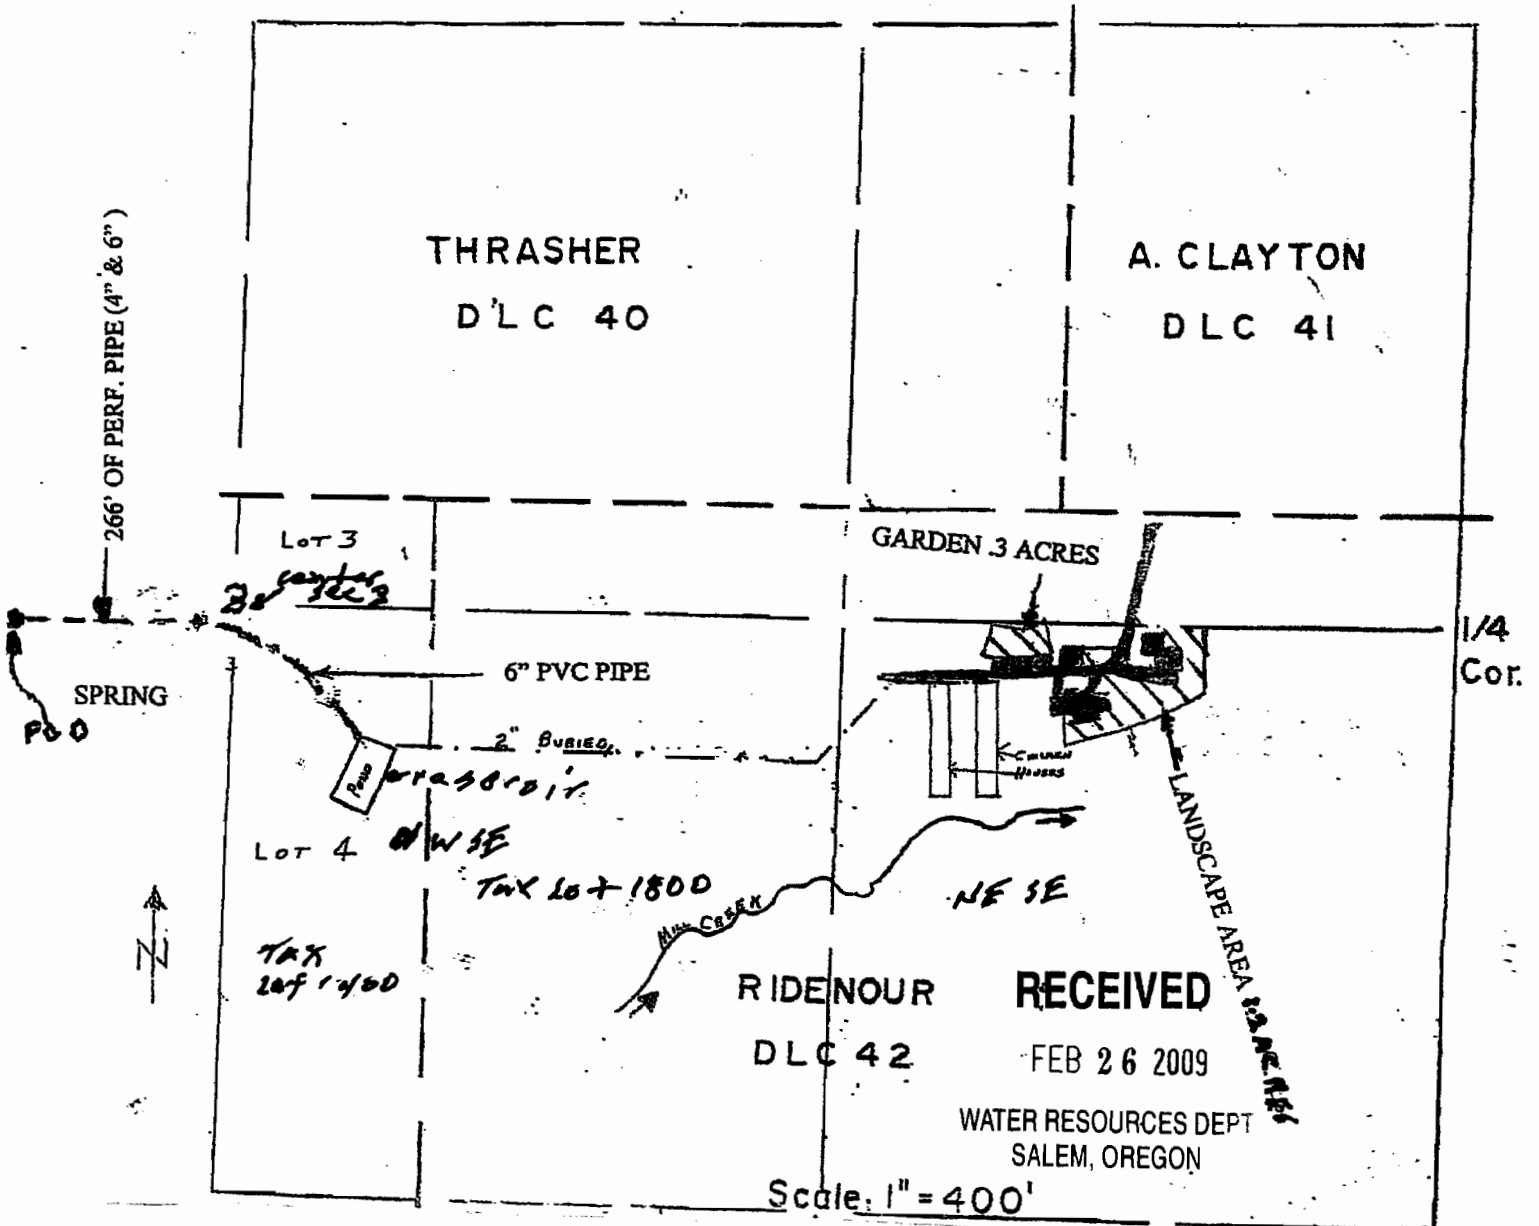

DIV. POINT LOCATED 420 FEET WEST AND 10 FEET SOUTH OF CENTER SECTION 3.

CENTER OF RESERVOIR IS 350 FEET SOUTH AND 280 FEET EAST OF CENTER OF SECTION 3.

THE PURPOSE OF THIS MAP IS TO IDENTIFY THE LOCATION OF THE WATER RIGHT. IT IS NOT INTENDED TO PROVIDE INFORMATION RELATIVE TO THE LOCATION OF PROPERTY OWNERSHIP BOUNDARY LINES.

