

R-87403



MAUL FOSTER ALONGI

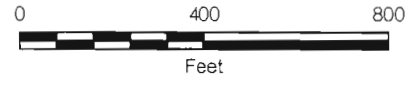


Figure Site Map


Malarkey Residence Pond
Columbia County, Oregon

Pond Location: Northwest and northeast quarters of the southwest quarter of Section 30, Township 4 North, Range 1 West of the Willamette Meridian

Source: Tax map obtained from the Oregon Map <www.ormap.org>; section lines obtained from the Bureau of Land Management

Legend

- Pond
- Section Line

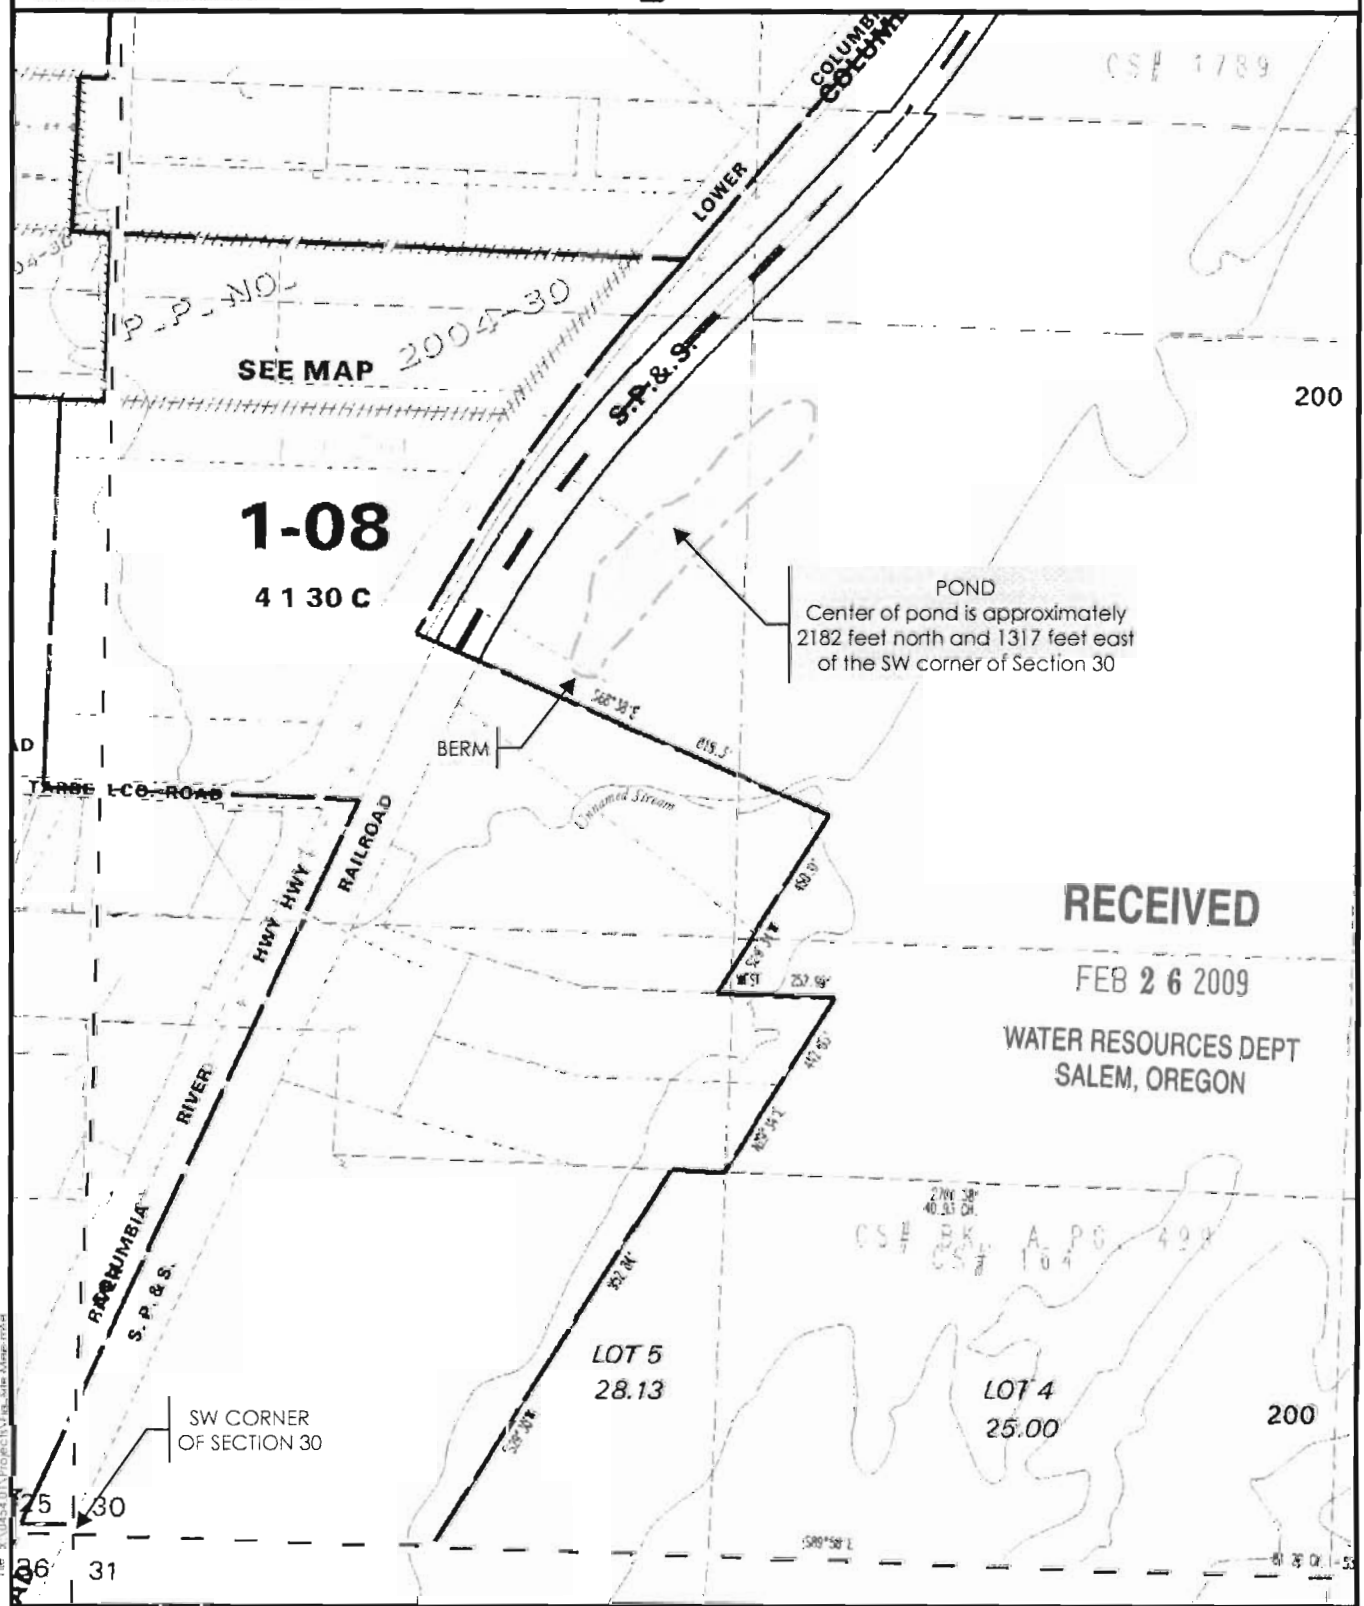

File: X:\0454.DIV\Projects\Fig_Site_Map.mxd