


Township 5 South, Range 11 East, Section 36
North West Quarter

SEE MAP 53 11 23

scale = 1" : 400'

Center point of dam is 1340' east and 744' south of the Northwest corner of Section 36

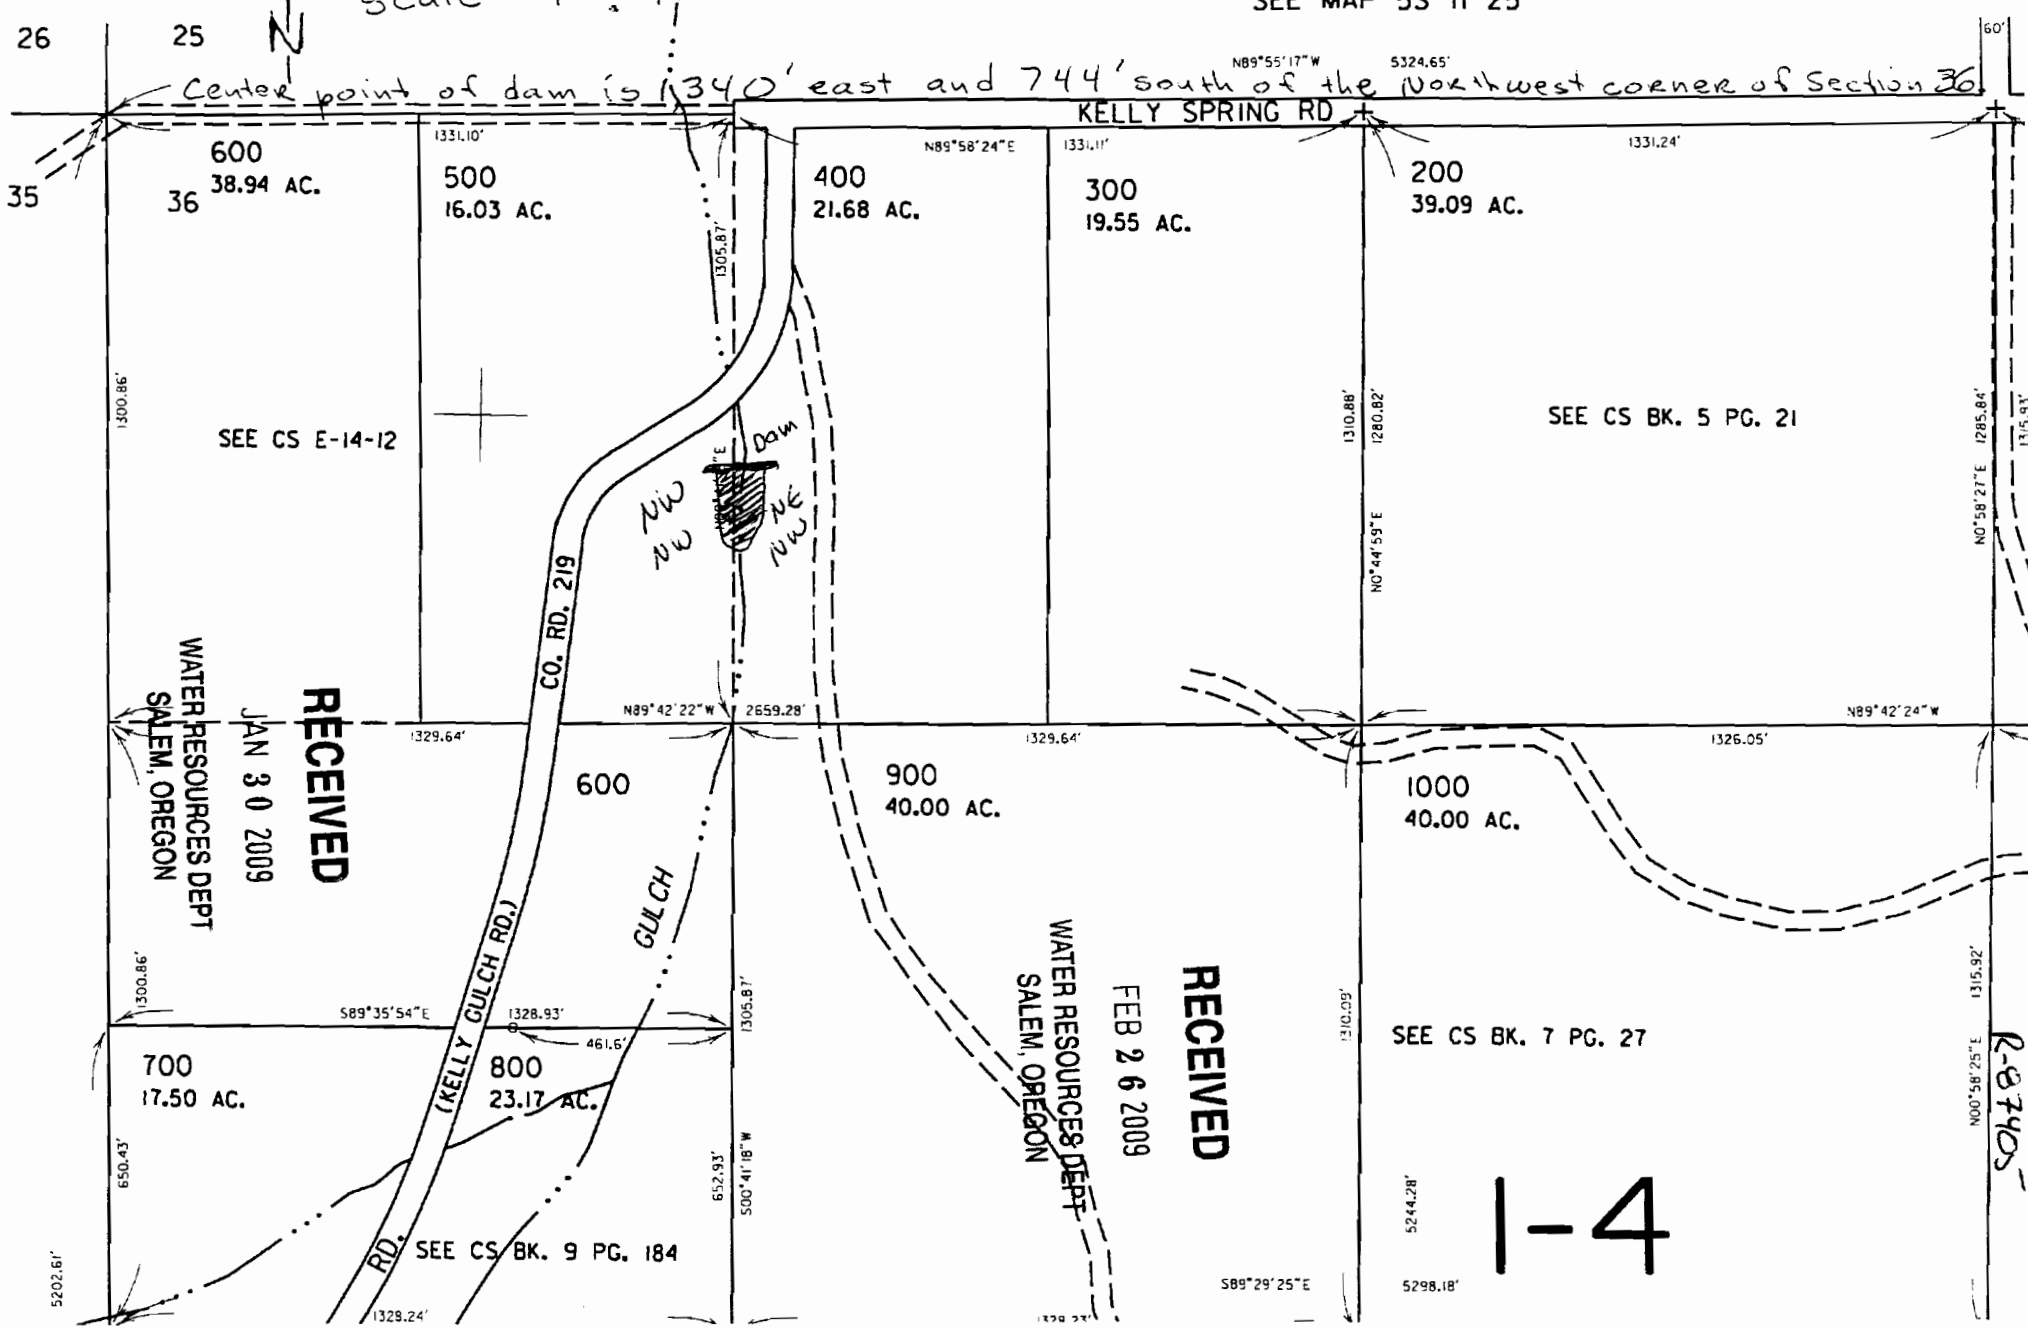

1-4

P-87405

