

T-5613

T-5613



V. 40 P. 77

RECEIVED

MAR 27 1985

WATER RESOURCES DEPT  
SALEM, OREGON

T.13S.  
R.33E.  
W.M.

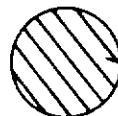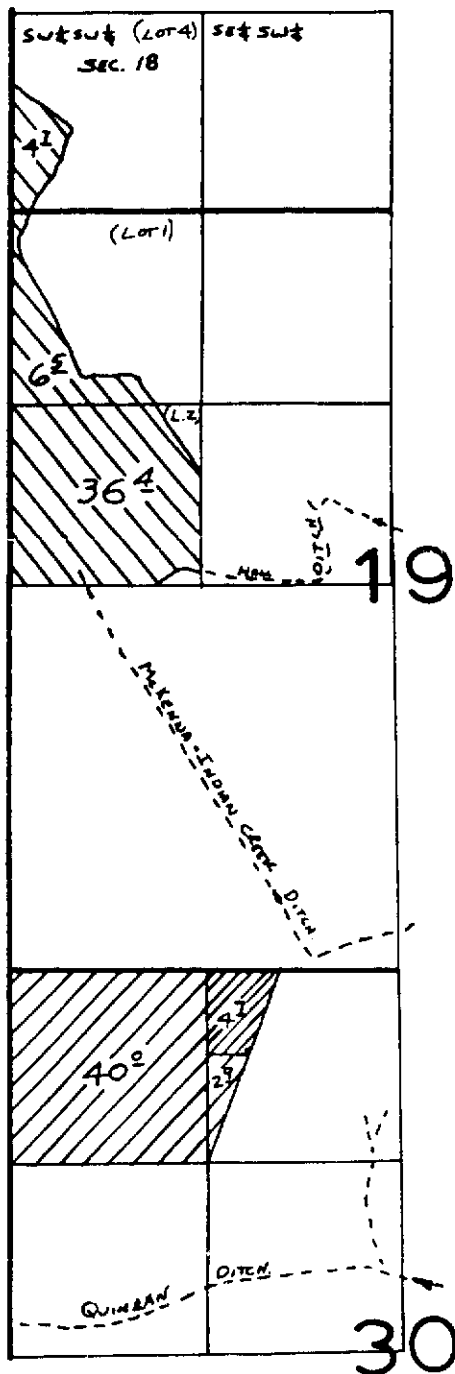


Existing C-52555 1872  
Proposed 1879

Maintaining Diversions  
from the HALL & McKENNA -  
INDIAN CREEK.


RECEIVED

NOV 22 1985

WATER RESOURCES DEPT  
SALEM, OREGON

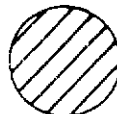

Existing C-25463 1879  
Proposed 1864

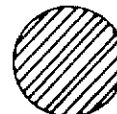

Existing C-25463 1879  
Proposed 1872

Maintaining Diversion  
from the Quinlan Ditch.

SEE Adjudication Map:

- C-52555 → Hall Ditch - SE½SE½ of Sec. 19, T13S R33E WM.
- McKenna-Indian Creek Ditch - SE½NW½ of Sec. 29, T13S R33E WM.
- John Long Ditch - lot 1 of Sec. 4, T14S R33E WM.
- C-25463 → Quinlan Ditch - SW½SE½ of Sec. 29, T13S R33E WM.

RECEIVED

JUN 24 1985

WATER RESOURCES DEPT  
SALEM, OREGON