

# SECTION PLAT

G-17184

Section 17 & 18


Township 26-5

Range 30-E

County of HARNEY

State of OR

NORTH

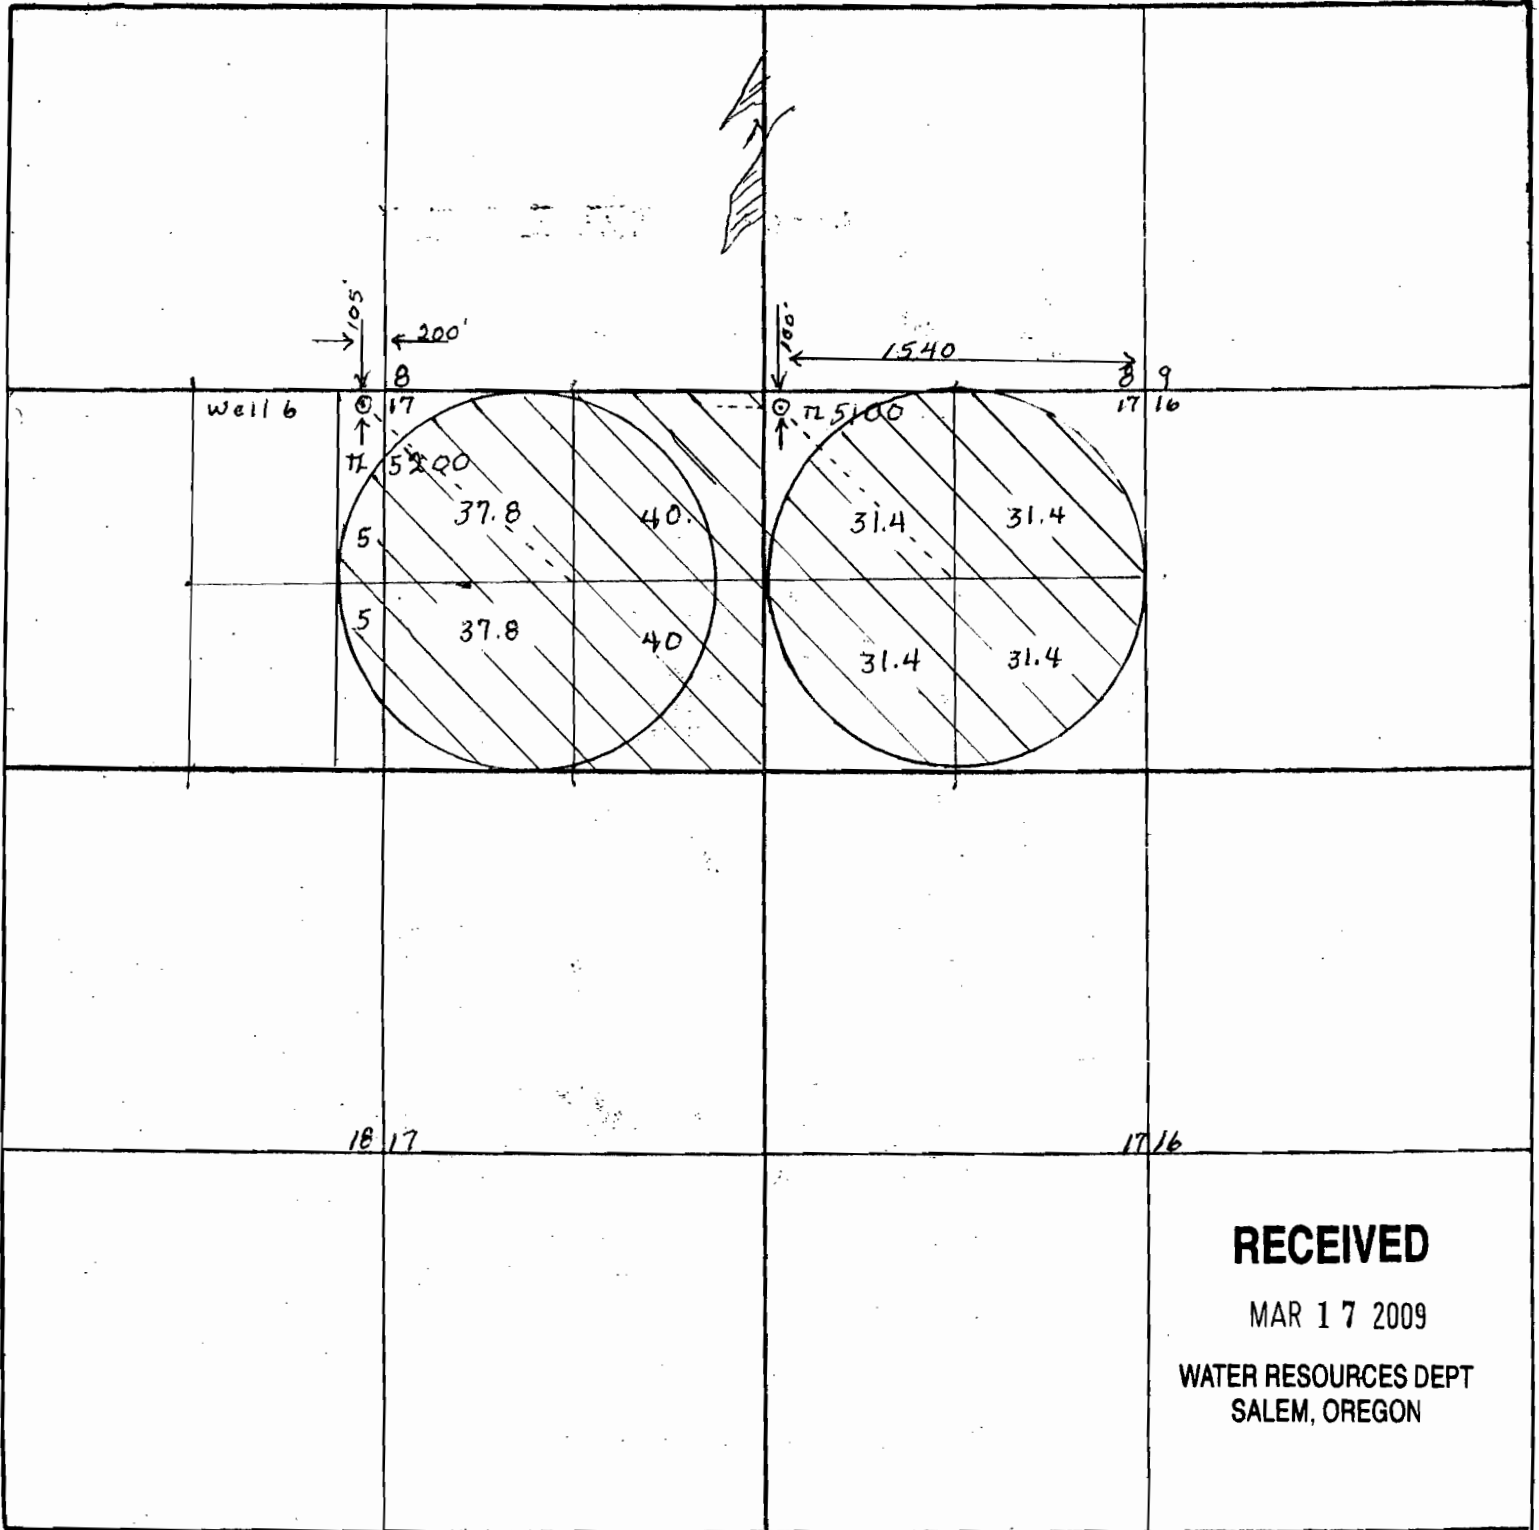

**RECEIVED**

MAR 17 2009

WATER RESOURCES DEPT  
SALEM, OREGON

S

Remarks scale -  $\frac{4}{8} = 1$  mile - 660) -