

# SECLUSION ESTATES


Community Water System  
W 1/2 W 1/2 Sec. 6 T36S., R6W..

## ATTACHMENT 2B

G-7144

REFERENCE MAP

NORTH

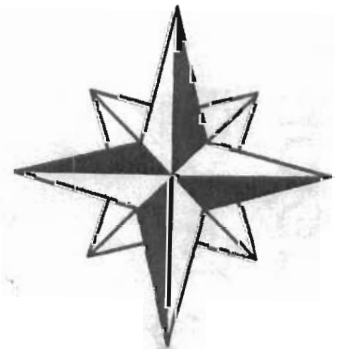

RECEIVED

MAR 02 2009

WATER RESOURCES DEPT  
SALEM, OREGON



RECEIVED

MAR 23 2009

WATER RESOURCES DEPT  
SALEM, OREGON

LEGEND

- Well Locations
- Water Tank
- 1 1/2 Inch Pipe to Tank
- 3 inch Mainlines
- 1 1/2 Inch Stubs
- Valve Locations

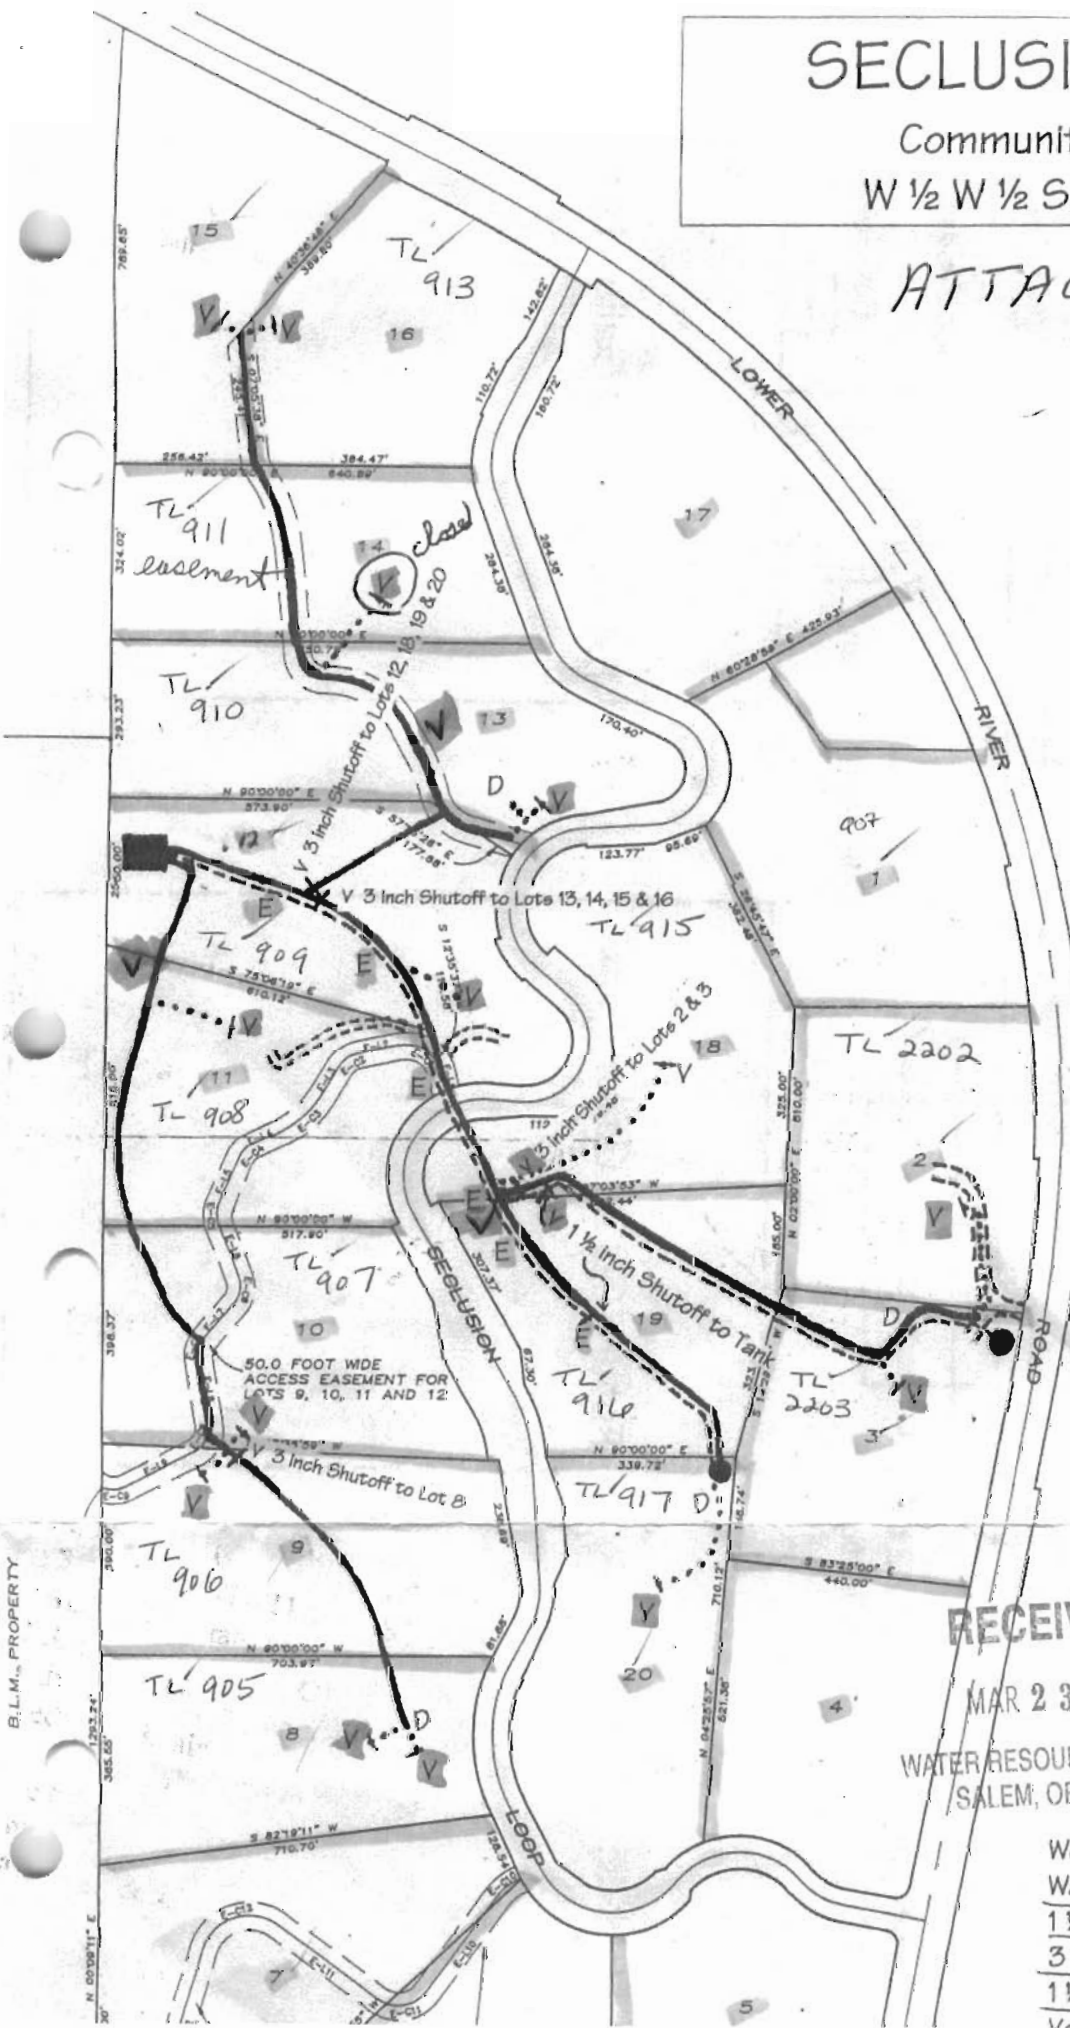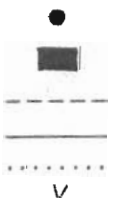

B.L.M. PROPERTY