

SE 1/4 Sec 2., T15S., R31E

Tr. # C-203

RECEIVED

SEP 4 1969

STATE ENGINEER
SALEM, OREGON


RECEIVED

OCT 15 1969

STATE ENGINEER
SALEM, OREGON



Note: (New "A" irrigates the
4.3 acres in the SE 1/4 SE 1/4)
(New "B" irrigates the
12.8 acres in the NE 1/4 SE 1/4)

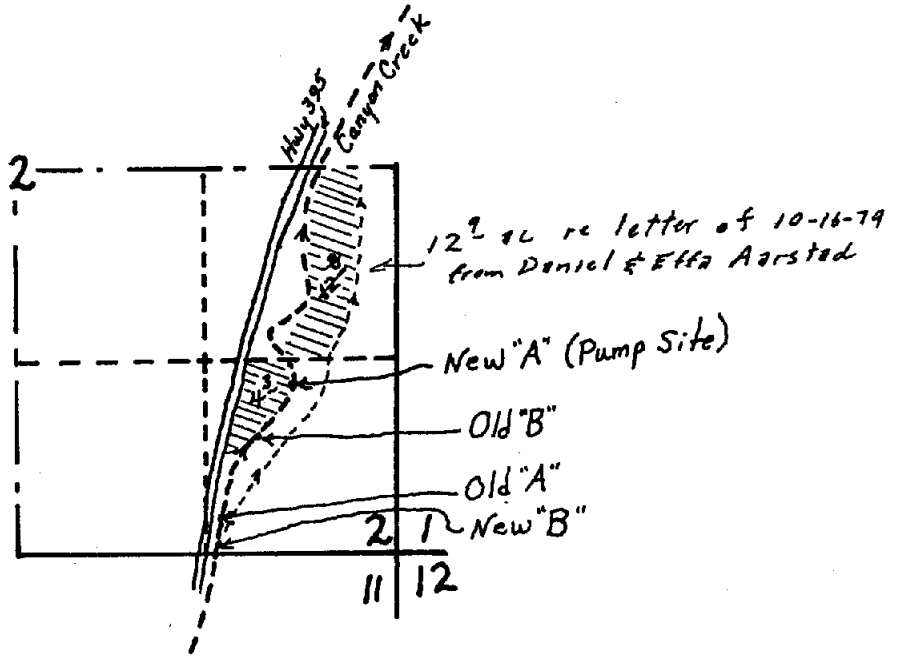

New "A" 1150' N & 680' E of the
SW Cor. of the SE 1/4 SE 1/4
Sec. 2., T15S., R31E., W.M.

Old "A" 240' N & 60' E of the
SW Cor. of the SE 1/4
SE 1/4 Sec. 2., T15S., R31E., W.M.

New "B" 60' N & 60' E of the
SW Cor. of the SE 1/4 SE 1/4
Sec. 2., T15S., R31E., W.M.

Old "B" 800' N & 400' E of the
SW Cor. of the SE 1/4 SE 1/4
Sec. 2., T15S., R31E., W.M.

Map approved by: Curtis C. Carpenter