


R-5419

RECEIVED
MAY 28 1969

STATE ENGINEER
SALEM, OREGON

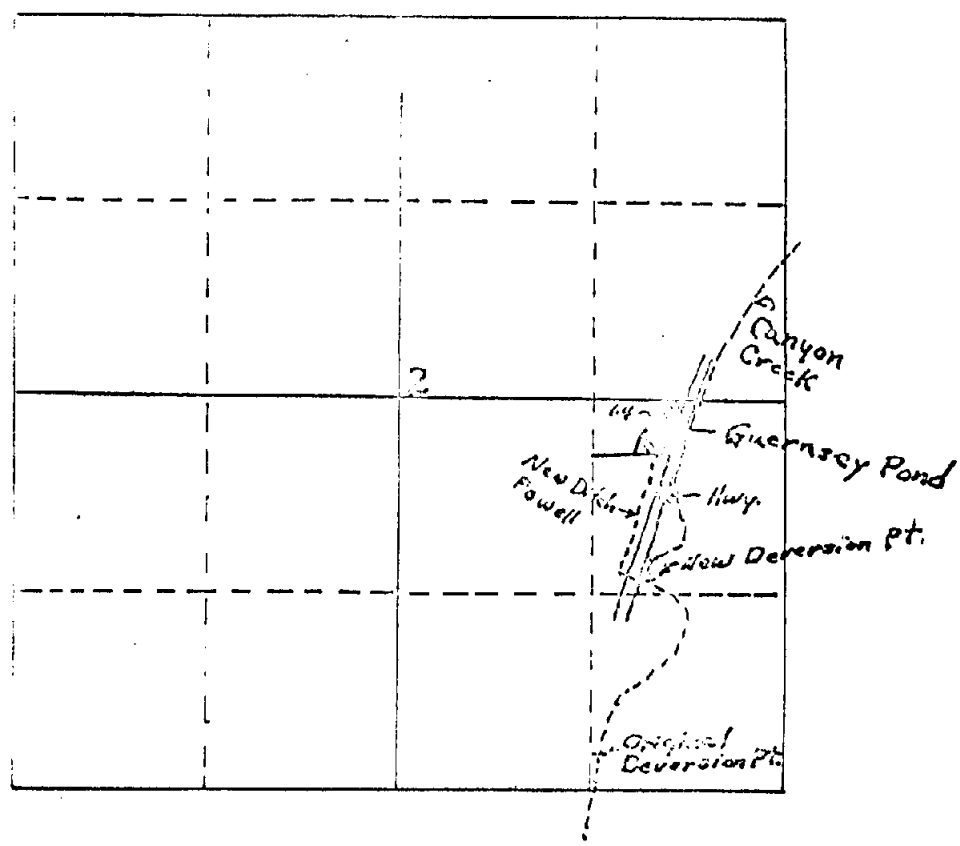

Sec. 2 T. 15 S. R. 31 E. W. M.

Map to accompany the following in the name of J. H. Guernsey:

- Reservoir Application, File No. R-45686
- Point of Diversion Transfer, File No. G-81
- Permit Application for Fish Culture

Map Approved by: J. H. Guernsey
J. H. Guernsey

Application No. R45-686
46086
Permit No. R-5419 + 54128