

 Place of Use

well is located 620' south and 600 east of NE 1/4, NW 1/4
Section 3

SCALE 1" = 1000'

RECEIVED

MAR 25 2009 4 1W 03

WATER RESOURCES DEPT
SALEM, OREGON

CLACKAMAS

LEGEND

LINE TYPES

- TAX LOT BOUNDARY OLD PROPERTY LINE
- ROAD RIGHT-OF-WAY VACATED RIGHT-OF-WAY
- RAILROAD RAILROAD RIGHT-OF-WAY
- STREAM, LAKE, ETC. STREAM, LAKE, ETC.
- TAX LOT BOUNDARY NON-BOUNDARY
- SUBDIVISION BOUNDARY PARTITION PLAT BOY.
- TAX CODE BOUNDARY EASEMENT

SYMBOL TYPES

- D.L.C.
- CONTROL POINTS
- SURVEY MONUMENTS
- C.L.G. CORNERS
- SECTION 1/4 SEC 1/16 SEC

NUMBERS

TAX CODE NO.
000 00 00 0

ACKNOWLEDGE - ALL ACRESSES INCLUDE ANY PORTION THAT MAY LIE WITHIN THE INDICATED PUBLIC RIGHT OF WAY.

TICK MARKS - WHEN A TICK MARK IS INDICATED ON THE EXTENSION OF A LINE, THEN THE DIMENSION GOES TO THE TICK MARK. GENERALLY THIS IS USED WHEN DIMENSIONS GO INTO PUBLIC RIGHT OF WAYS.


ARROWS ARE USED WITH DIMENSIONS IN AREAS OF GREATER COMPLEXITY.

NOTICE: This map was created for Assessor's Office use ONLY.



SCALE 1" = 400'
or 1:4000

Plot file created: March 7, 2006

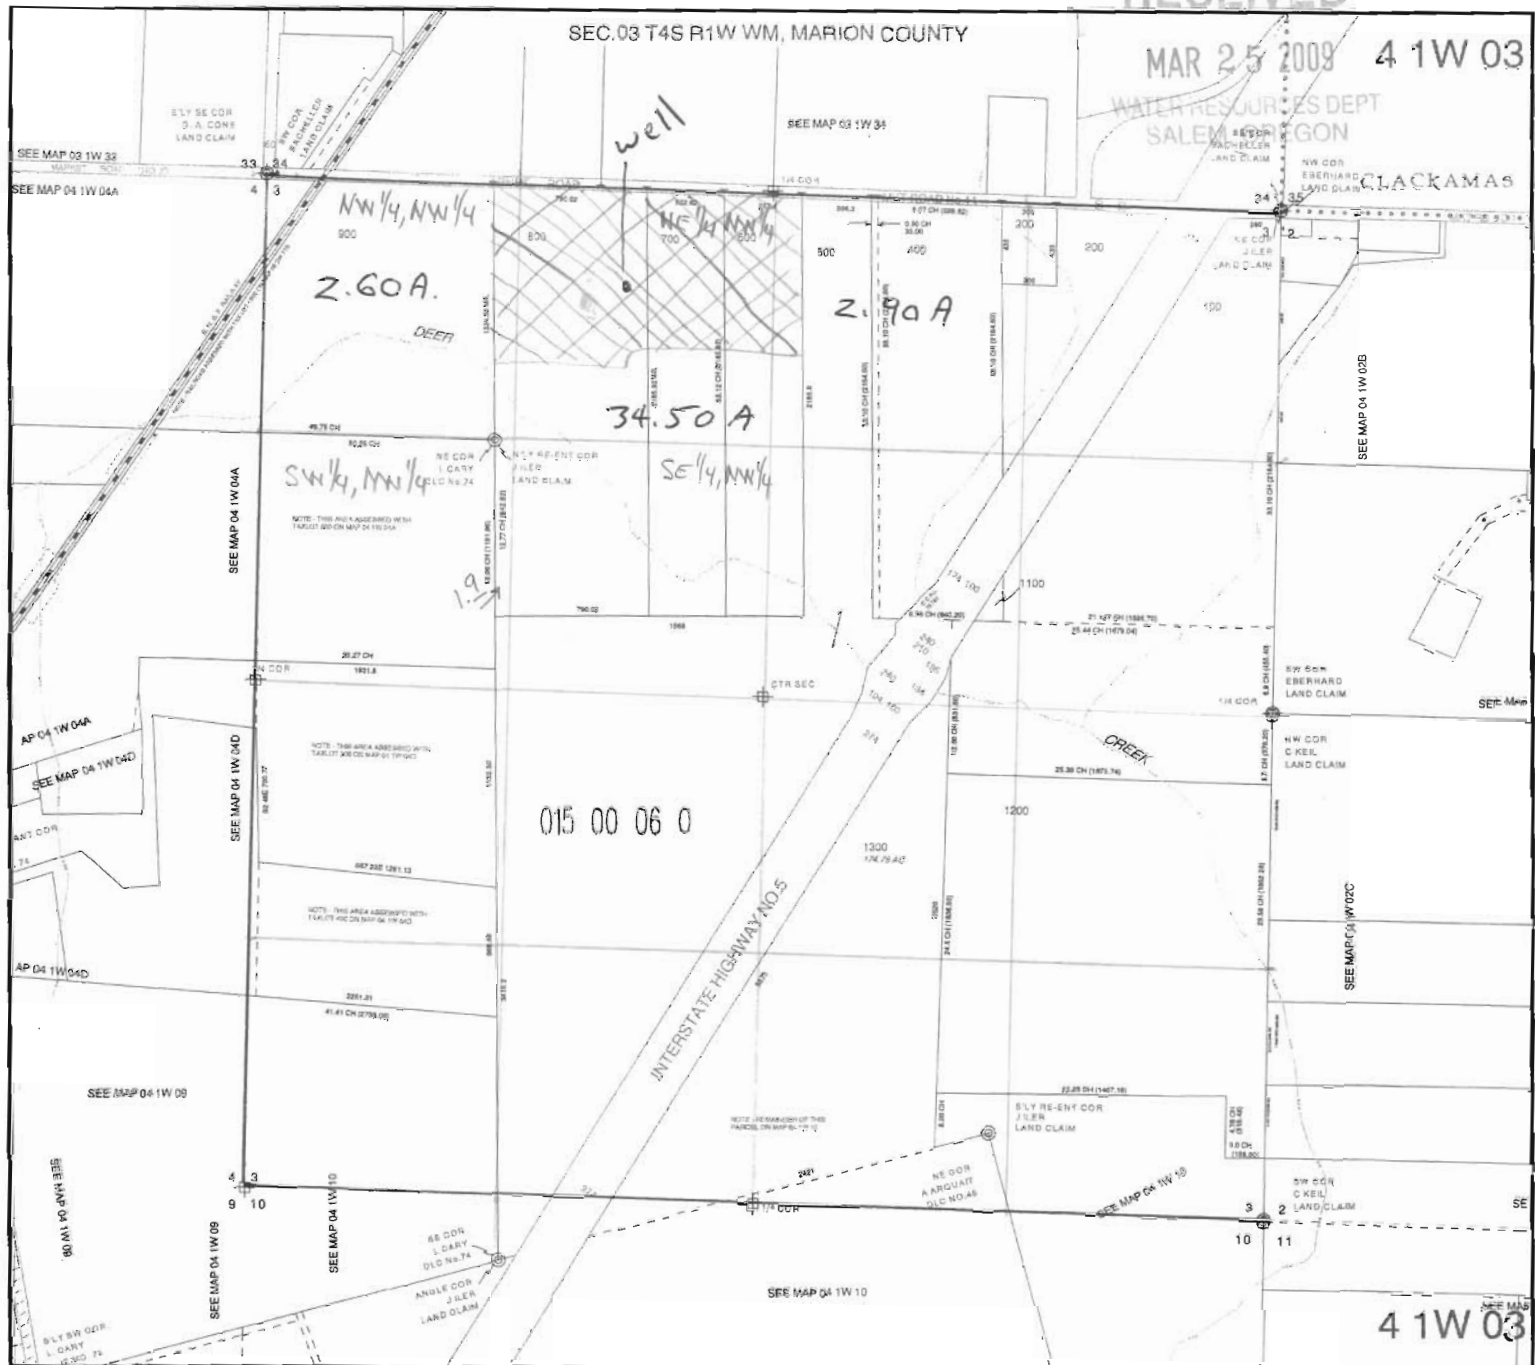

4 1W 03