


207433


SEE MAP 38 5 23

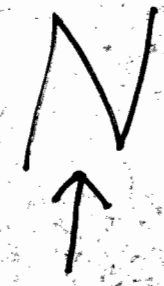

SCALE
1" = 400'
T38S
R5W
Sec 22
Lot 702

Frog Pond is
600 feet west
and 100 feet
south from
center of

T38S
R5W
Sec 22

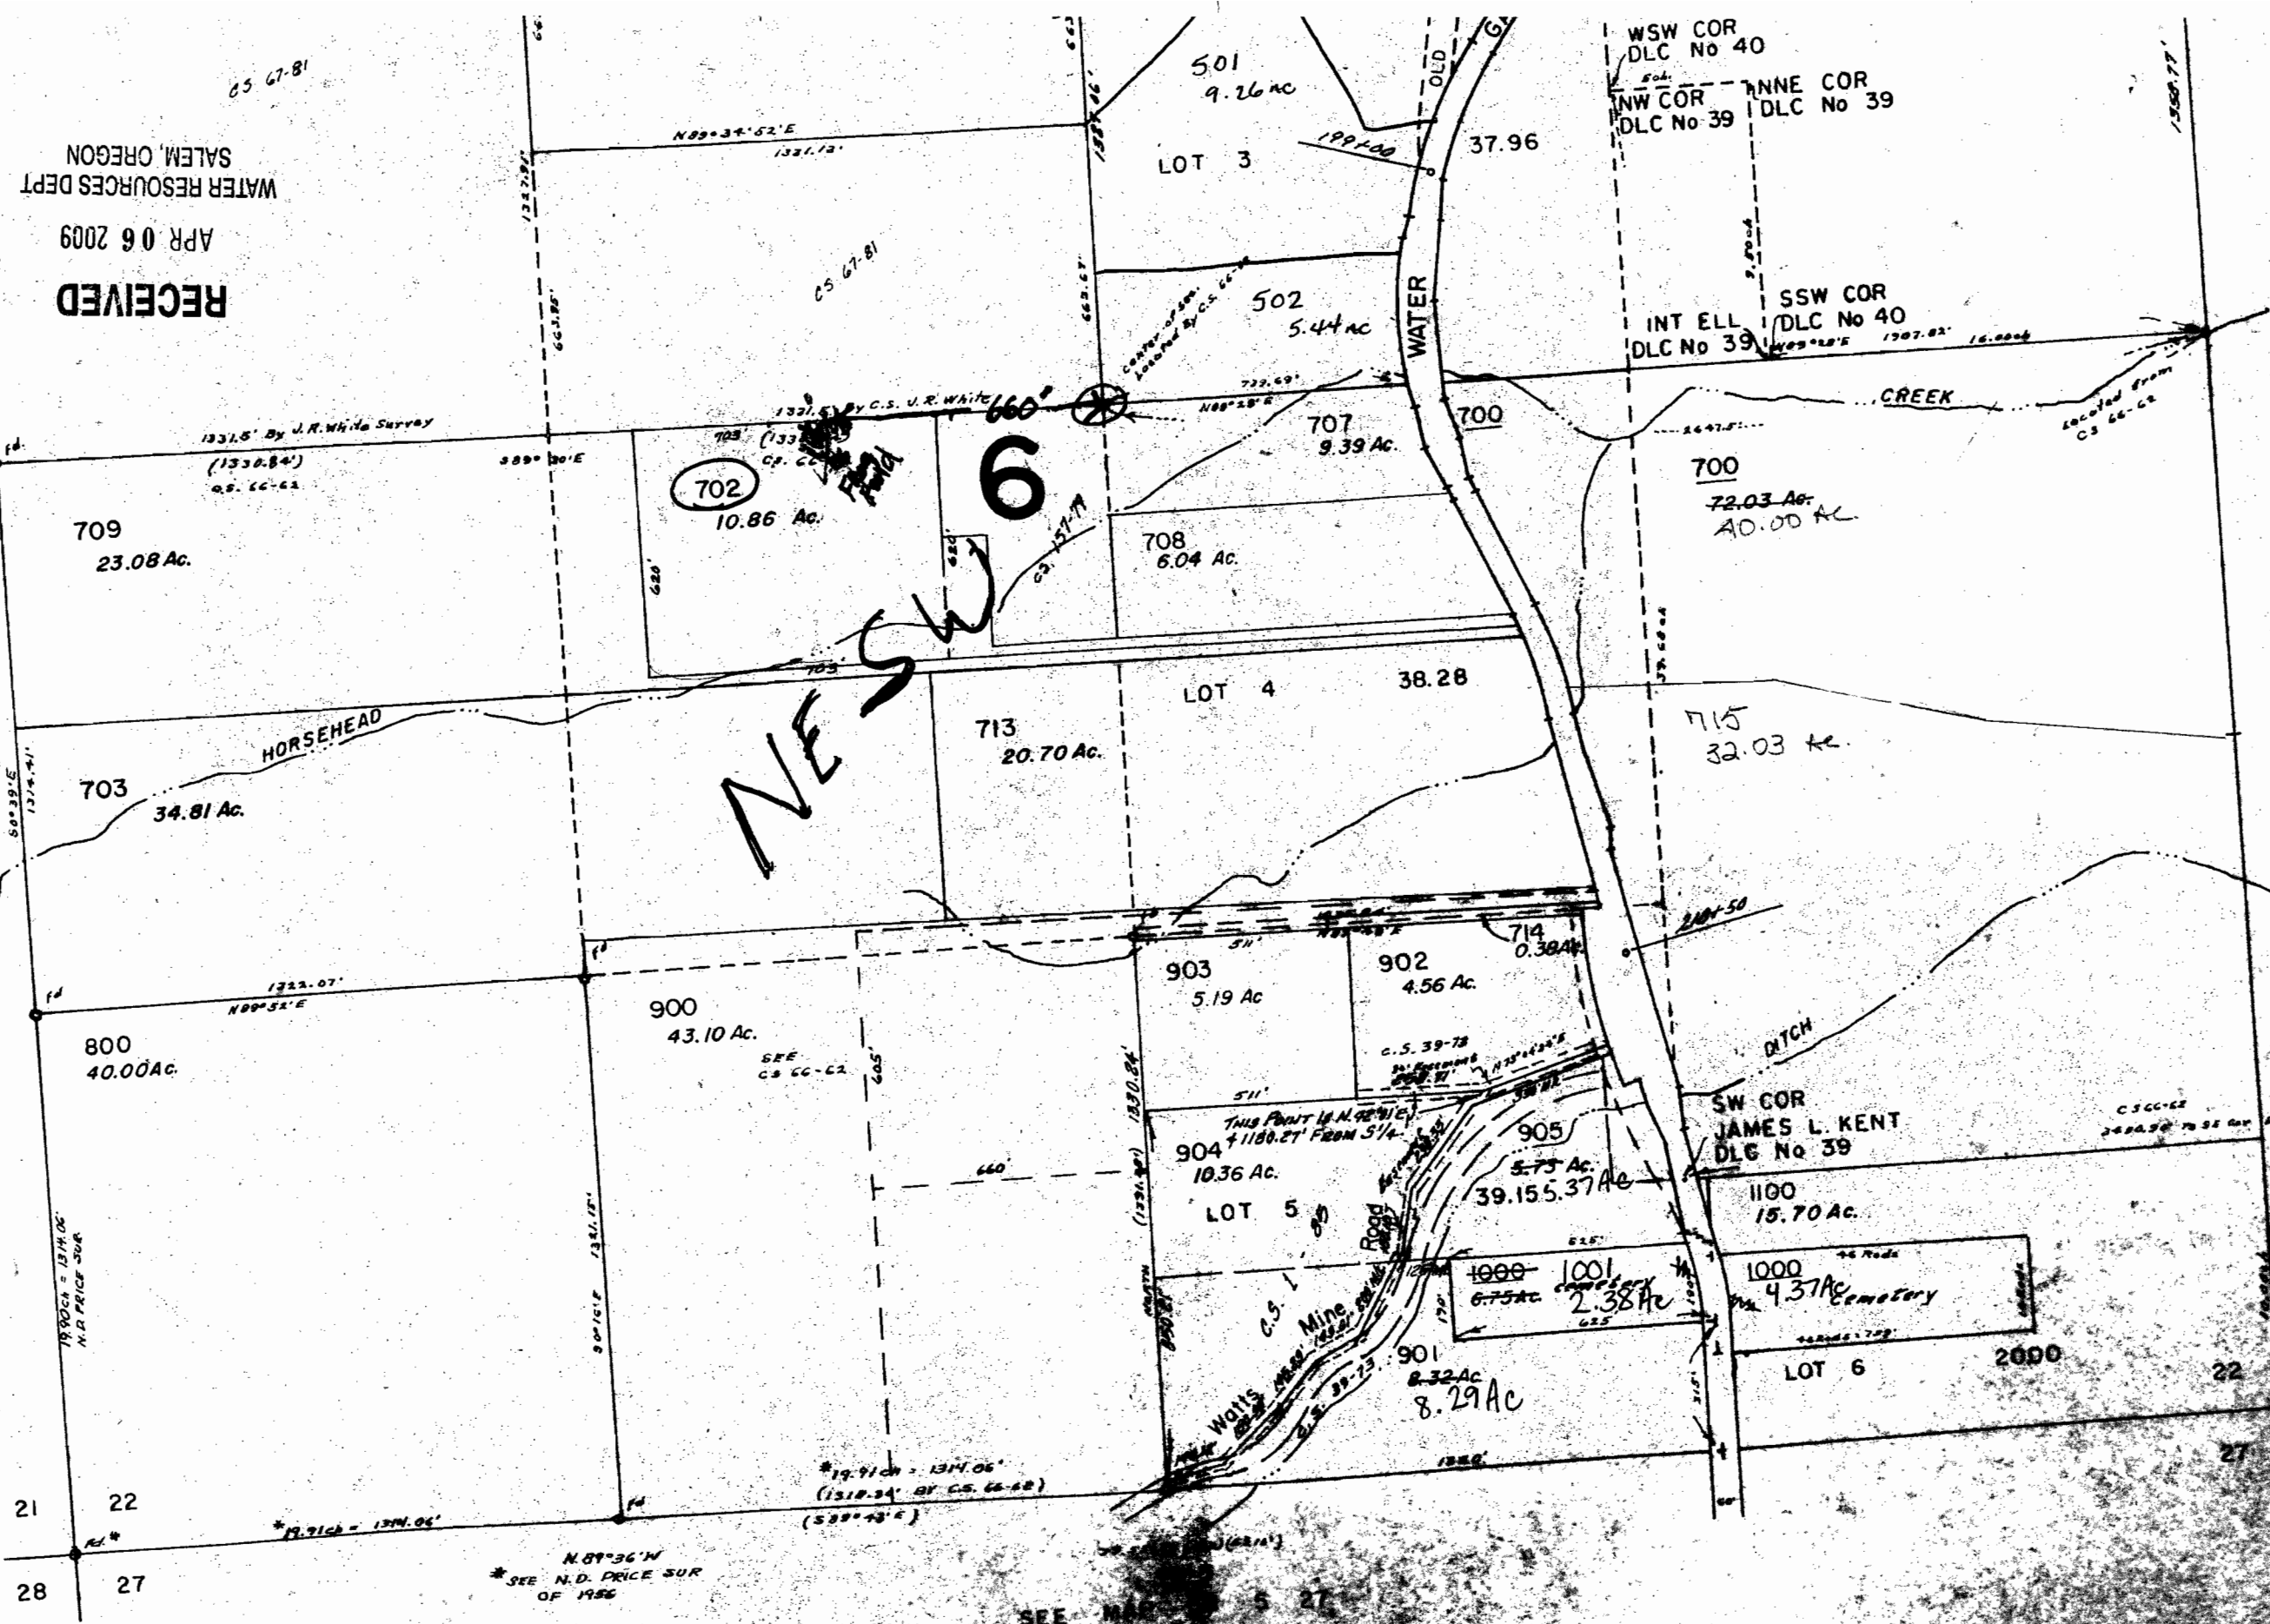

RECEIVED
APR 06 2009
WATER RESOURCES DEPT
SALEM, OREGON

SEE MAP 38 5

SEE MAP 38 5 23