



API

6

WATER RE
SALE

12

7

NW 1/4 SE 1/4

Cat

SW 1/4 SE 1/4

Text

POD is located approx
3620 Ft. East 3
1000 Ft. North of the
SW corner of section 7,
T 23 S R 6 E Wm

13

18

587434

RECEIVED


APR 08 2009

WATER RESOURCES DEPT
SALEM, OREGON

THIS MAP WAS PREPARED FOR
ASSESSMENT PURPOSE ONLY.

11/20
DETAIL MAP OF T.23S. R.06E. W.M.
KLAMATH COUNTY

23 06
DETAIL MAP NO. 1

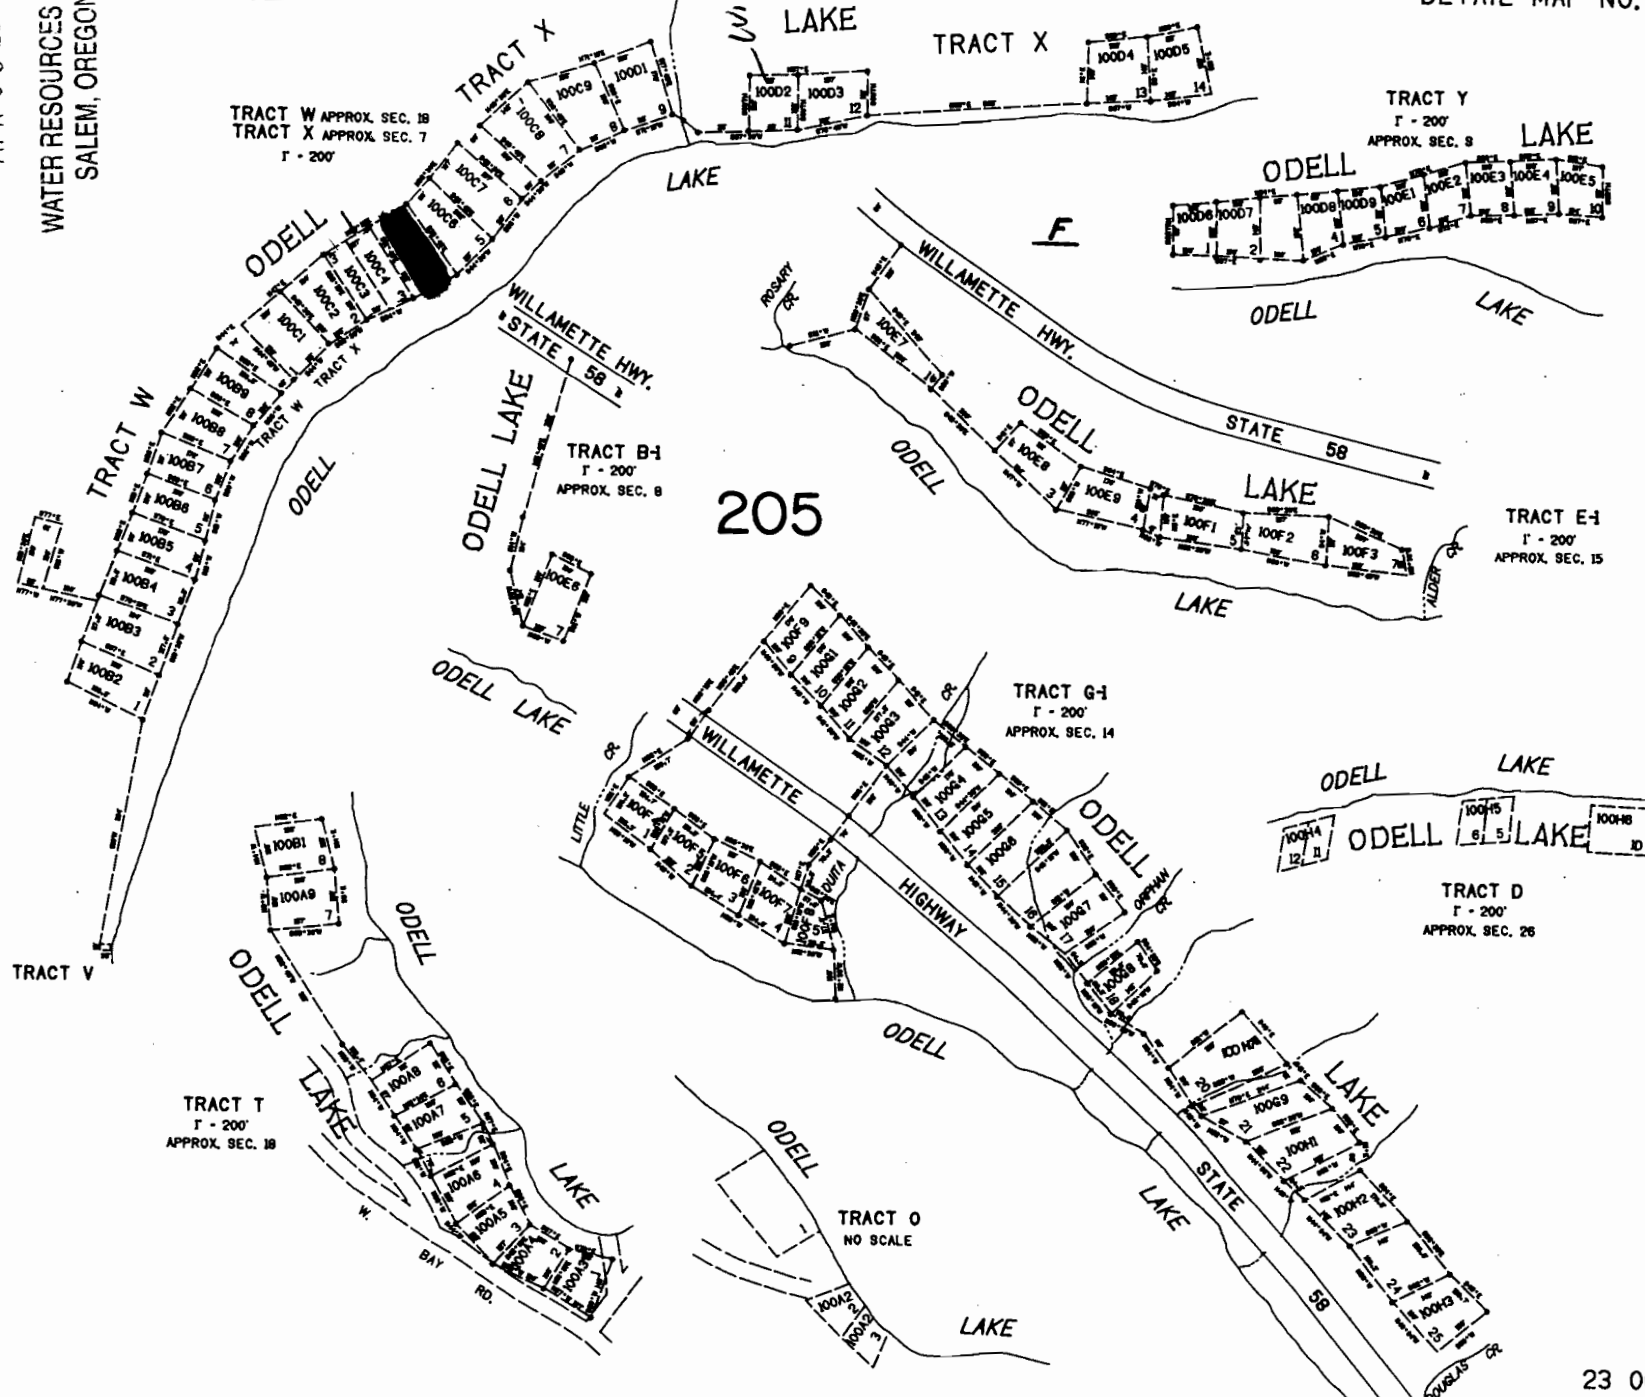

23 06

587434

T.23S. R.06E. W.M.
KLAMATH COUNTY


23:06

DESCHUTES COUNTY

RECEIVED

APR 08 2009


WATER RESOURCES DEPT
SALEM, OREGON

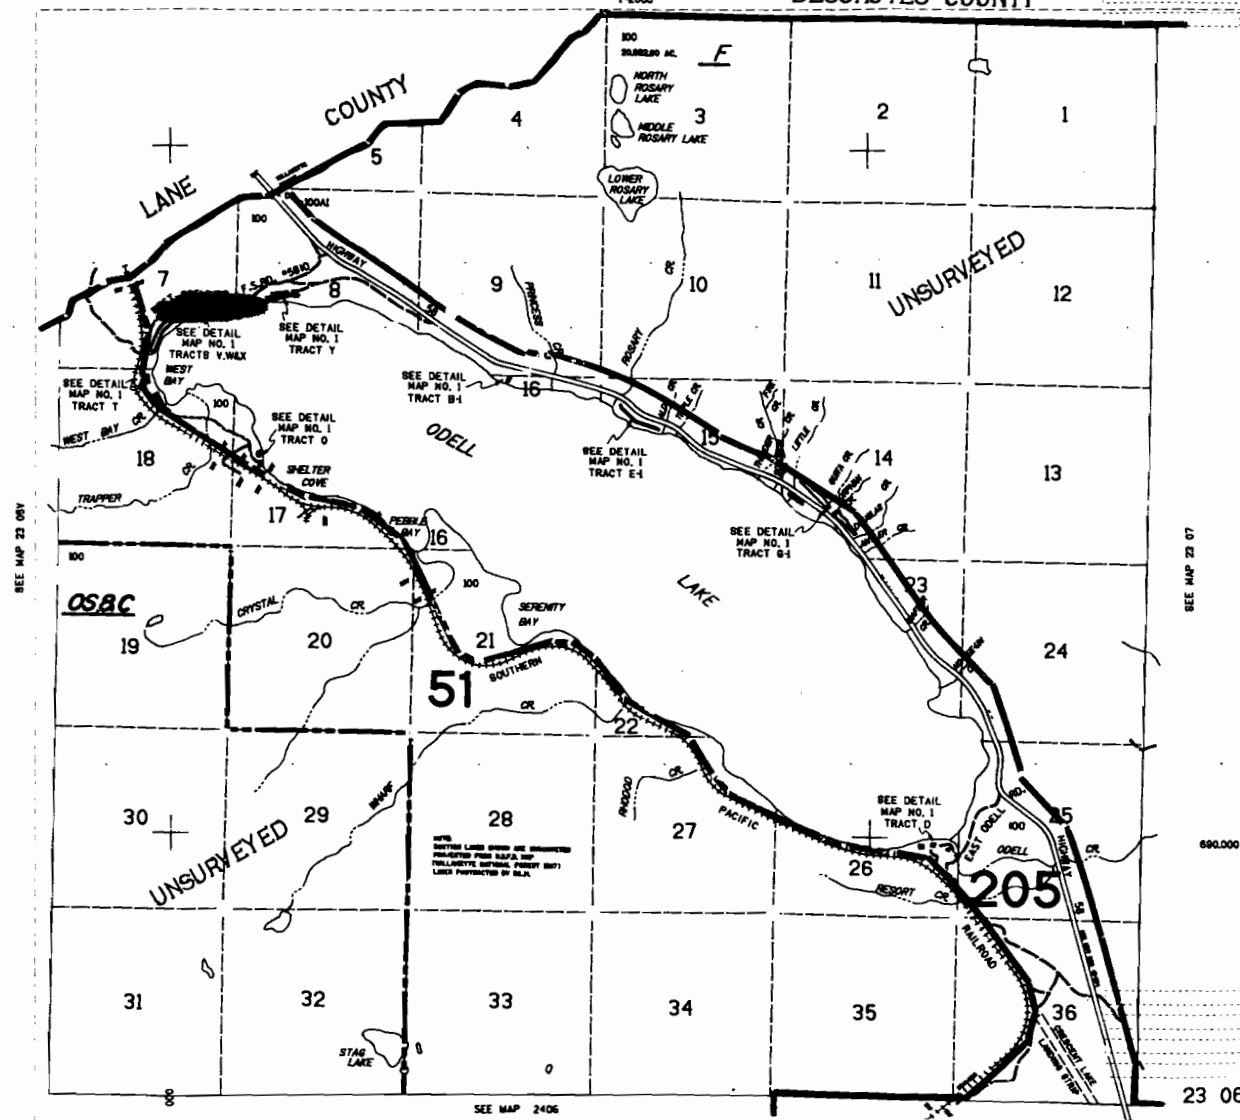

587434

Odell Lake Tract X, Lot 5

RE

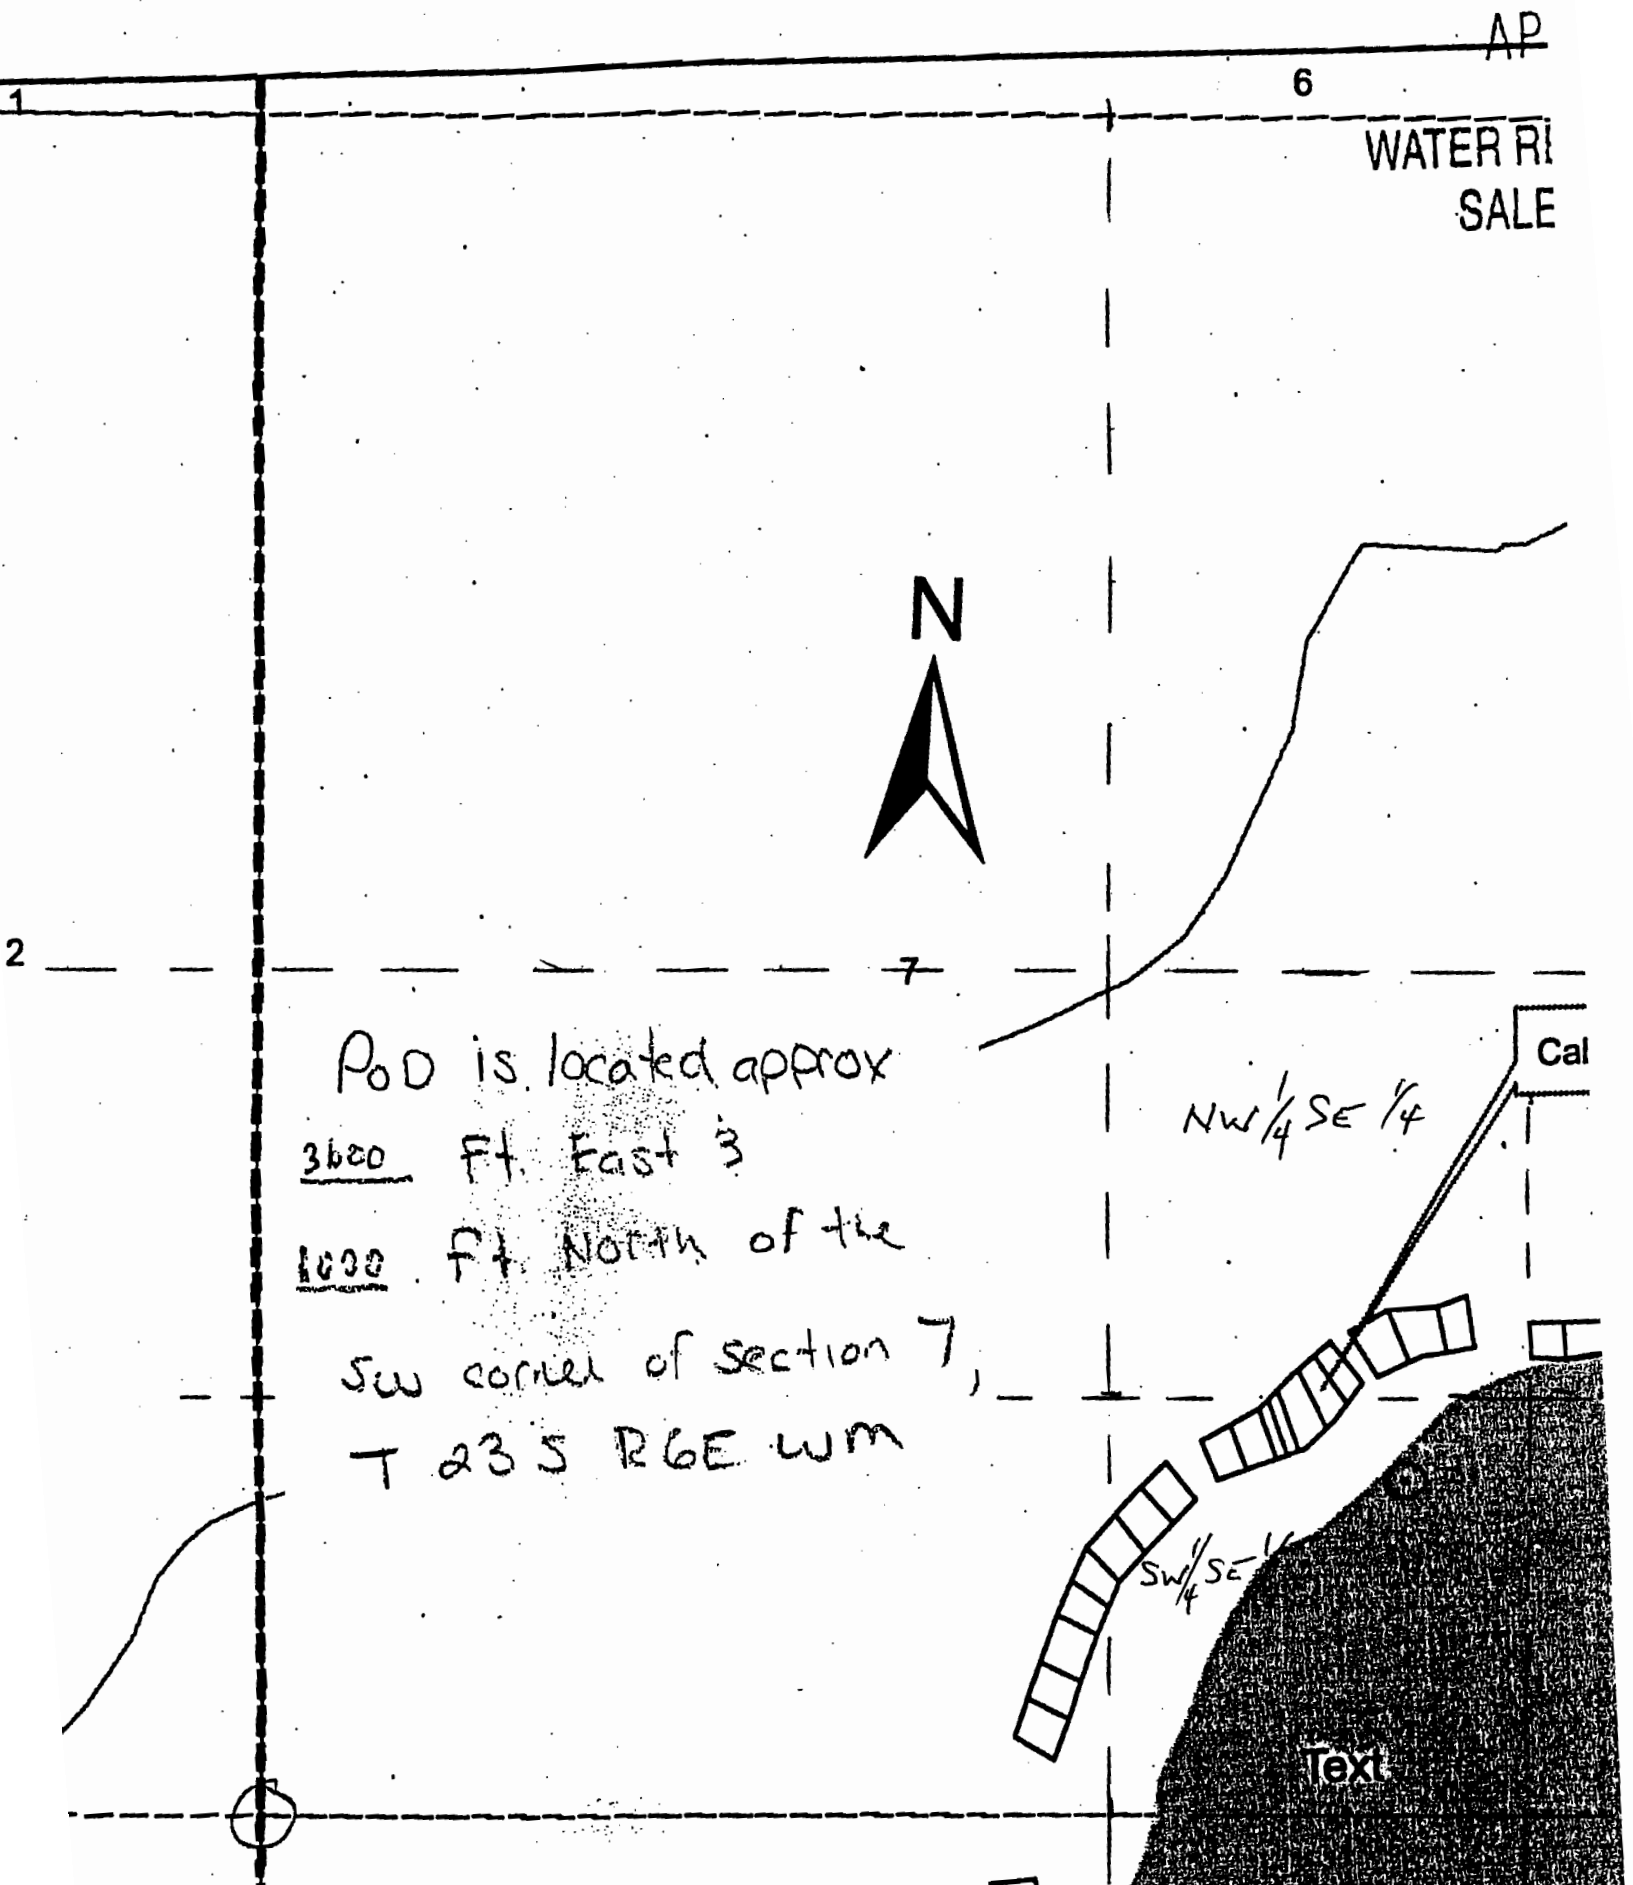


Odell Lake Tract X, Lot 5

RECEIVED

APR 08 2009

WATER RESOURCES DEPT
SALEM, OREGON

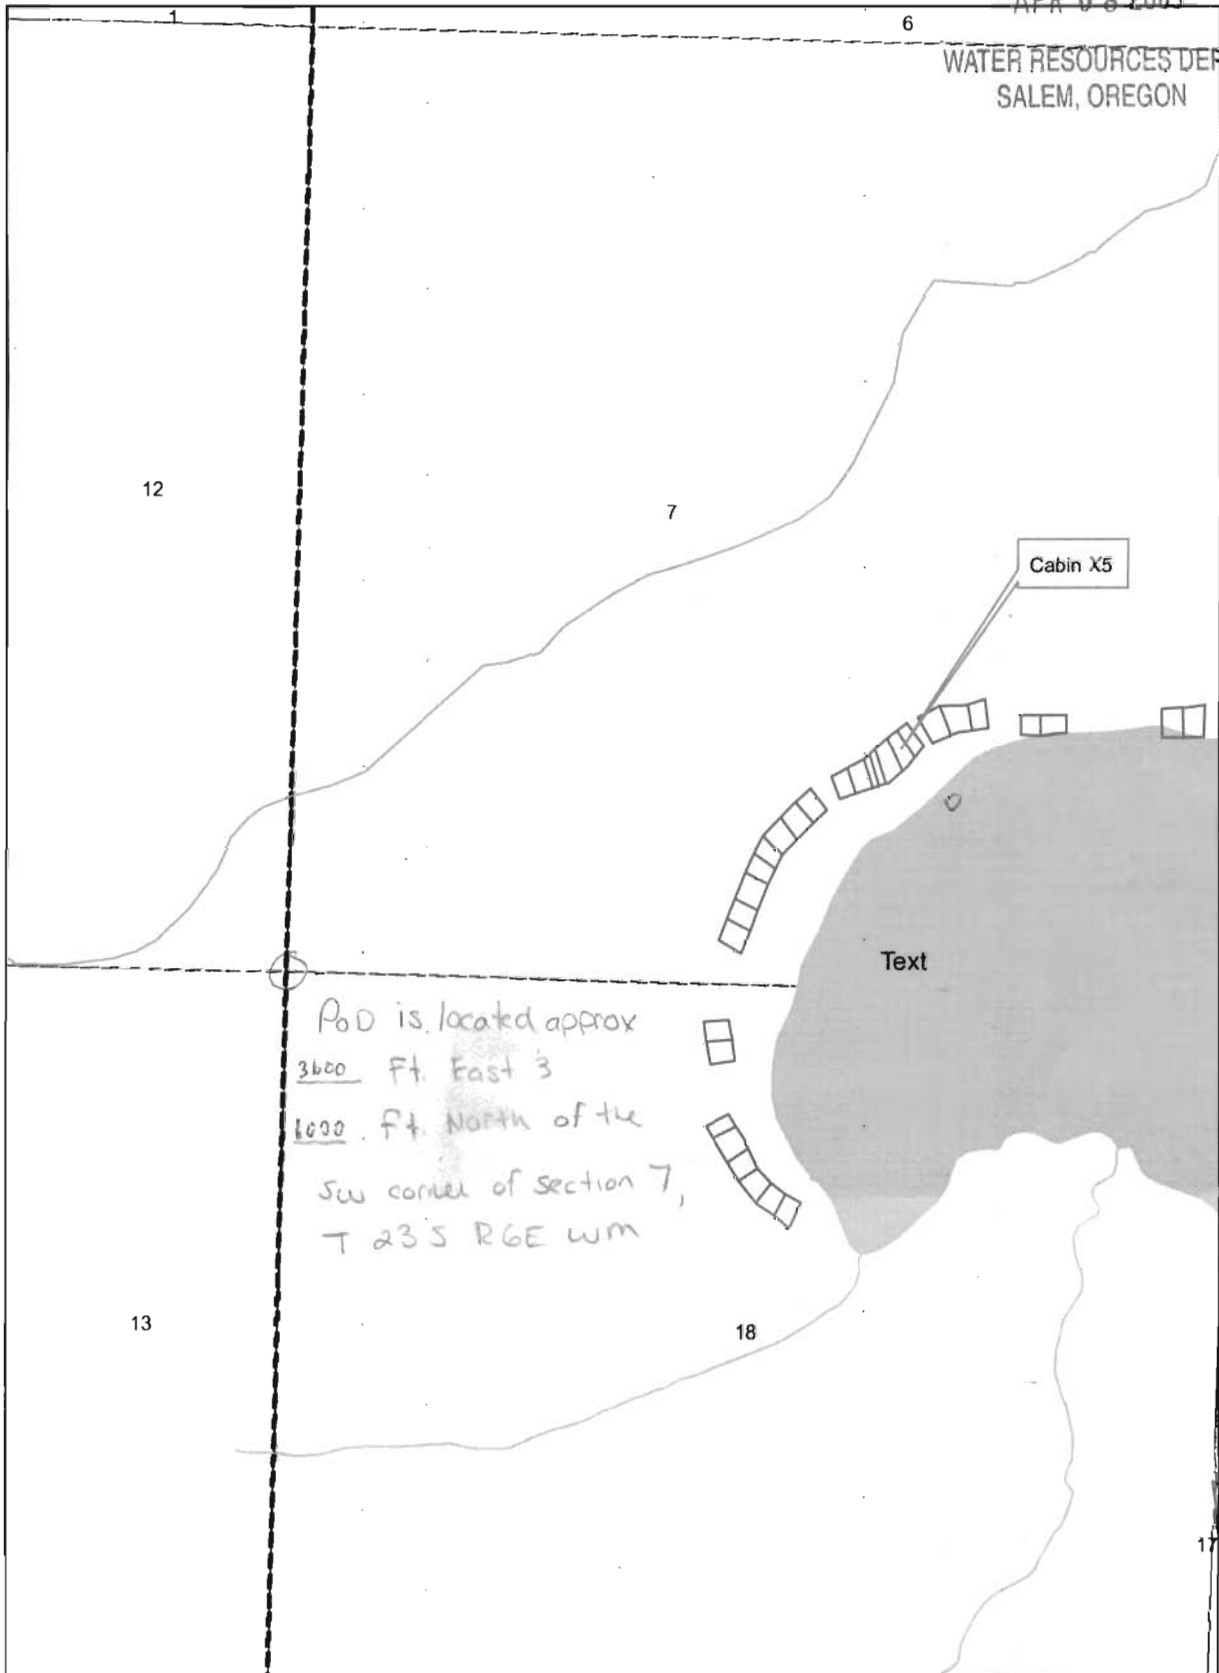

0 500 1,000 2,000
Feet

Deschutes National Forest
12/30/2008

S 87434