


APPLICATION MAP
SECTION PLAT

G-17202
COLEMAN RANCH
P.O. BOX 797
CRANE, OR 97732


Section 16 Township 25S Range 36E
County of HARNEY State of OREGON

TAX Lot 800

NORTH

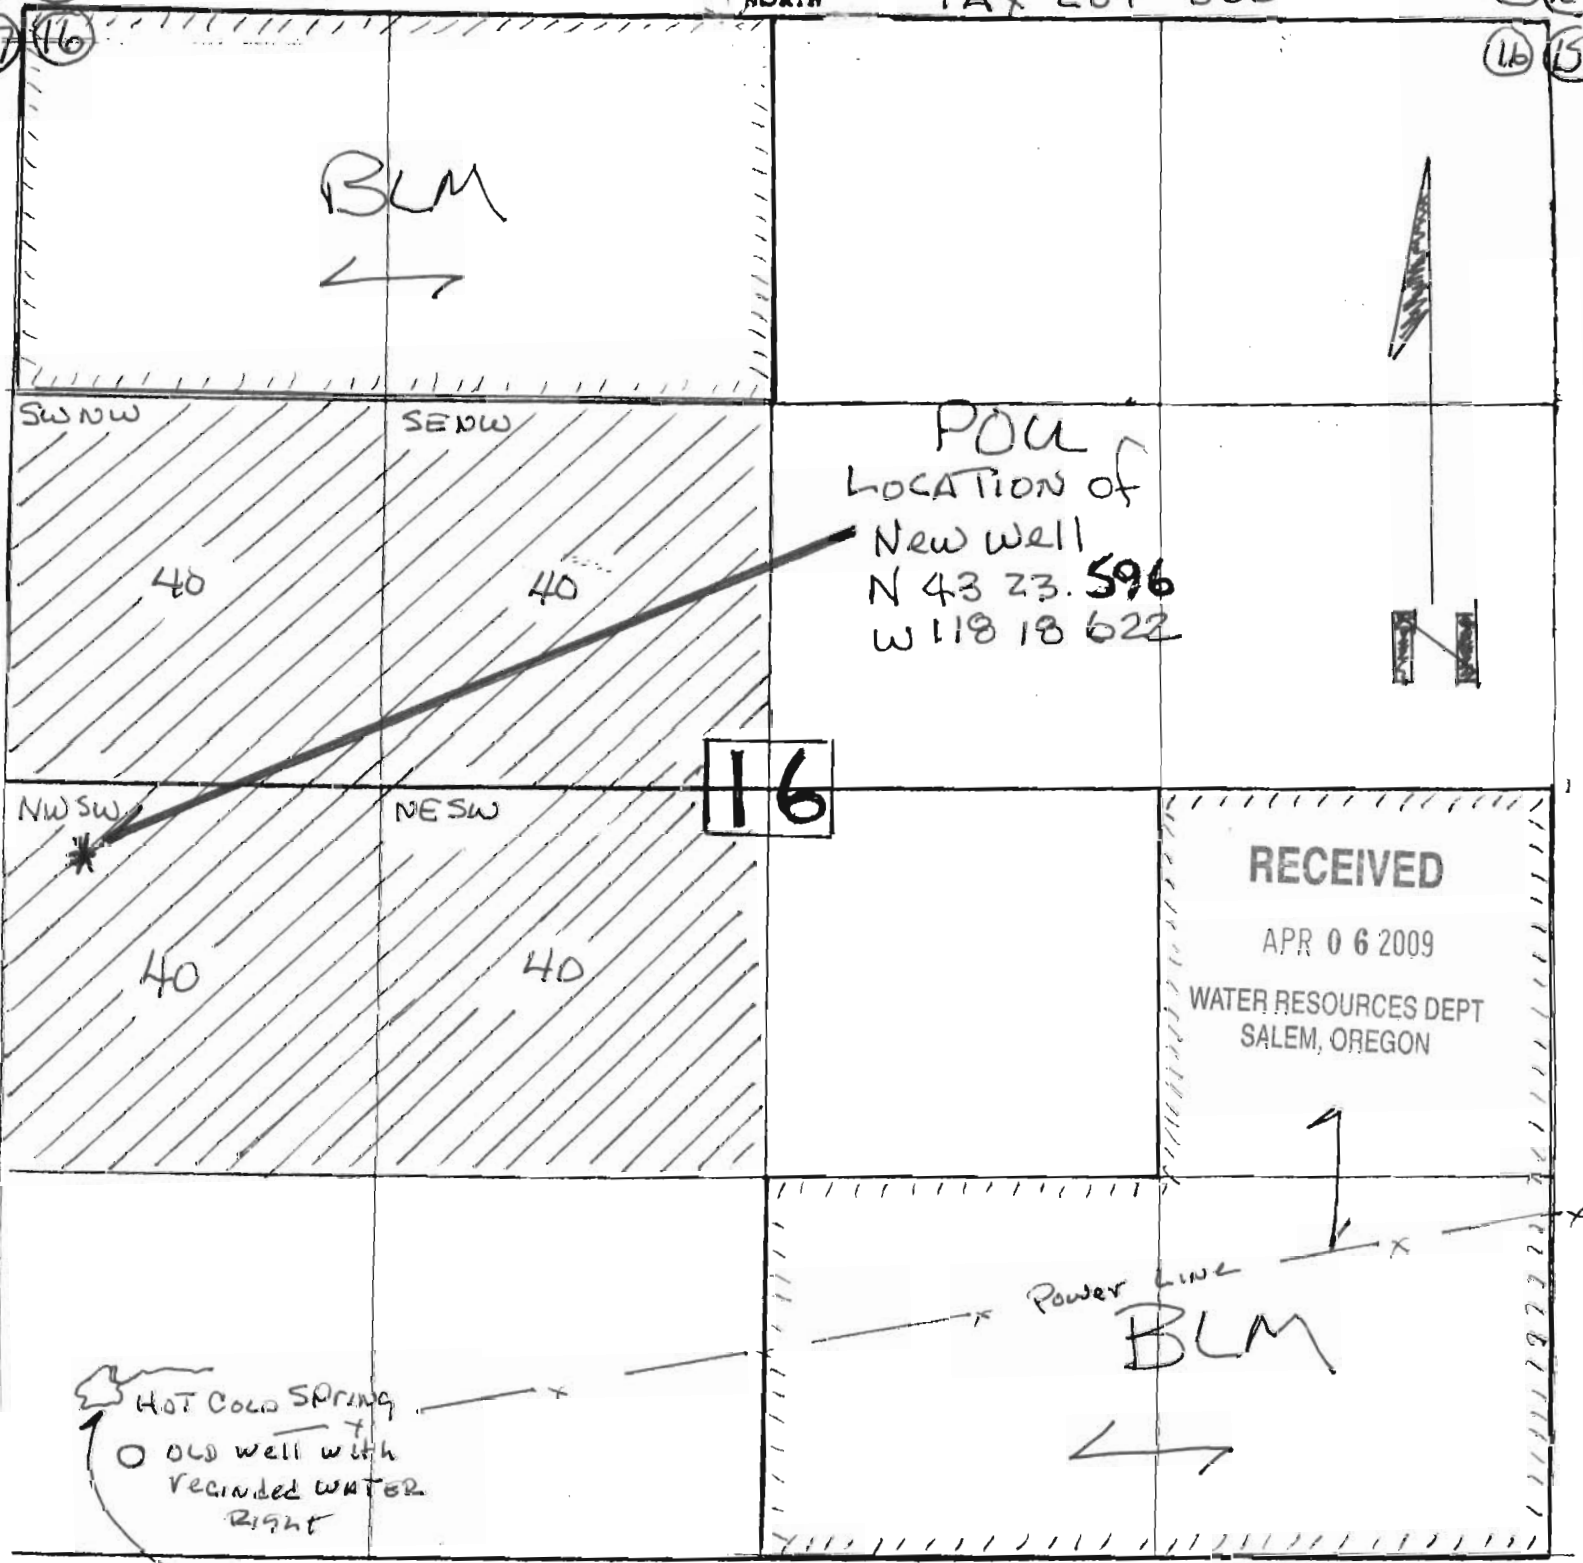

N 43 23.688
W 118 18 592

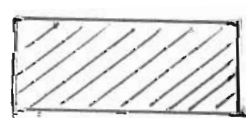


160 Acres to be IRRIGATED

WORK COPY ADDED TO LOCATE WELL
NOT TO SCALE, BUT HAS APPLICANT'S INITIALS.
ATTACHED MAP IS TO SCALE 1"=500 FT.

Section 16 Township 25S Range 3E

County of HARNEY State of OREGON

⑨

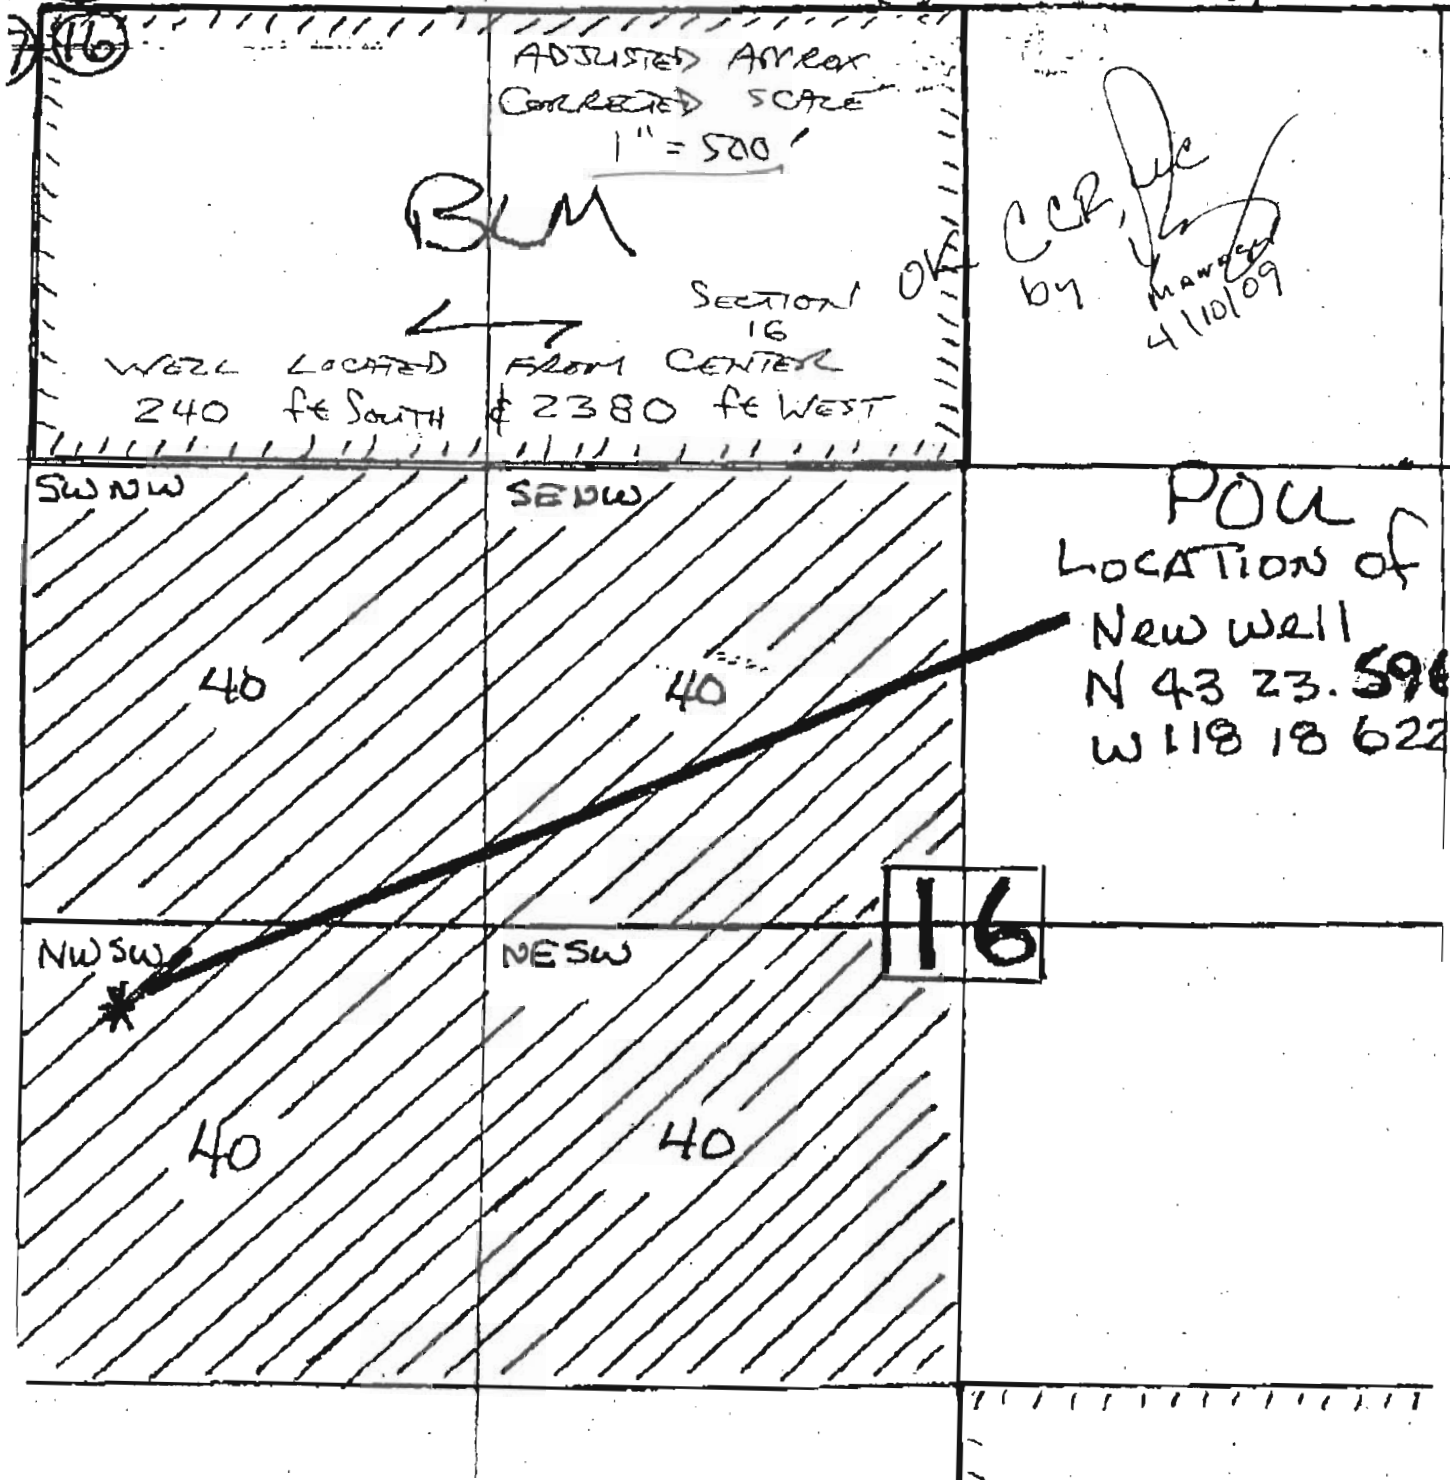

G-17202

BLM

PRIVATE
OTT

Coleman Cr Ranch LLC
P.O. Box 797
CRANE, OR 97132
255 366
HARNEY CO. OR

Creek
COLUMBIAN

MEADOW

Diversion
Dam

PACIFIC

UNION

BLM

Carey
Reservoir

x 3635

3438

Dunnean

x 3710

BM 3451

BLM

RECEIVED

APR 06 2009

WATER RESOURCES DEPT
SALEM, OREGON

Coleman Cr Ranch

Rock
Spring

x 3725

Malheur

3602

x 3846

PRIVATE
2ND ORE

PRIVATE
OPIE

CRANE LAND

x 3543

x 4030

McEwen
Spring

JEEP

TRAIL

BLM

3906 x

14

Proposed
Well 3587'

16

1 1/4 mile

1575'
Below
well
3512'

x 3572

BM 3595

Closest
Surface
Water
Body

Springs
(Hot)

South

PRIVATE

BLM

PRIVATE
2ND ORE