

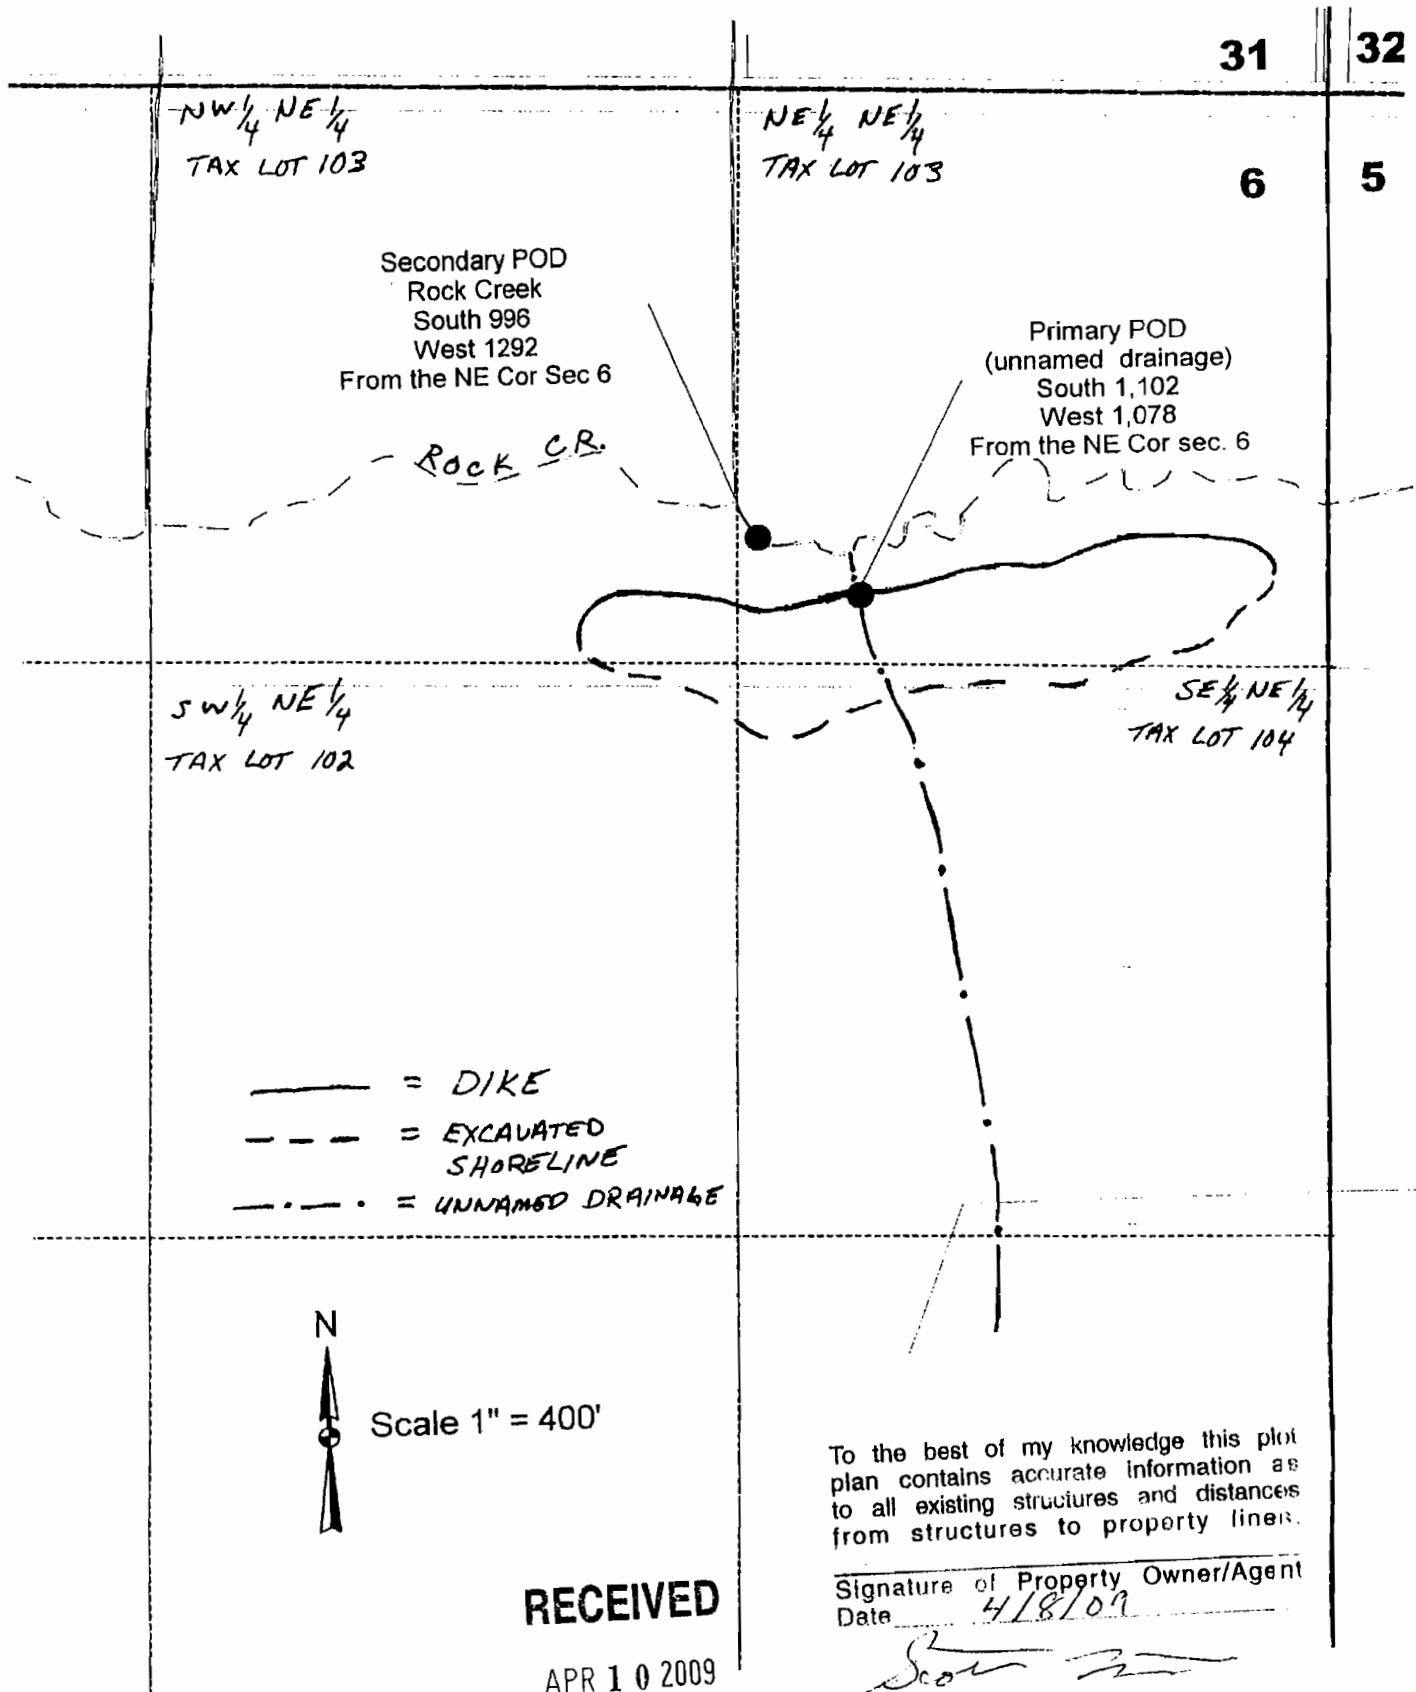


T 36 S, R 2 W, W.M. Sec 6

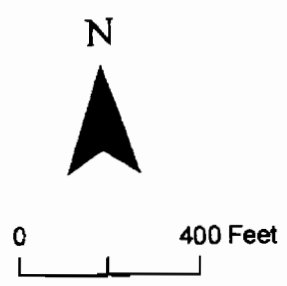

WATER RESOURCES DEPT
SALEM, OREGON

Application Map
Scott and Laura Lillie
T36S, R2W, Sec 6

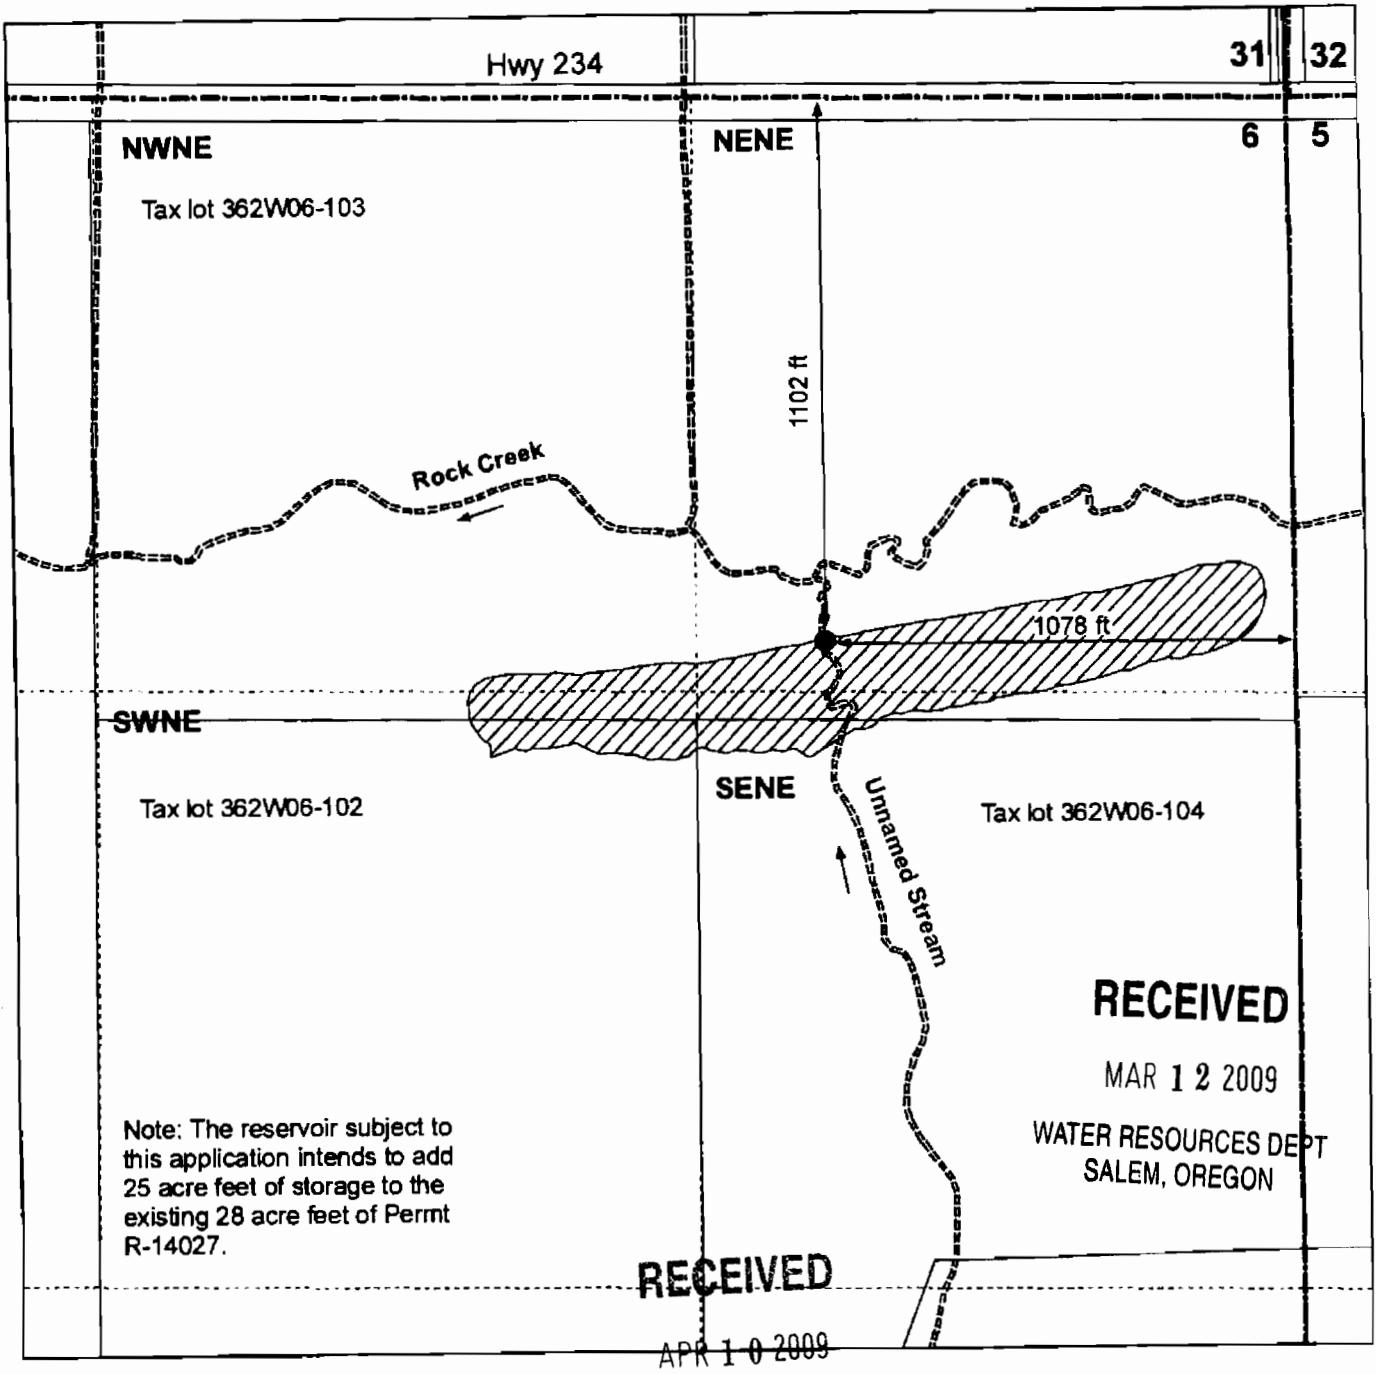

Legend

- Reservoir
- Section line
- Quarter-quarter line

WATER RESOURCES DEPT
SALEM, OREGON



PO Box 5286
Central Point, Oregon 97502
Phone 541-664-5599
Fax 541-664-5603
Email hafarber@charter.net

Farber & Sons, Inc.
431 Oak Street
Central Point, Oregon
Tax ID: 93-1057173