


KLAMATH ADJUDICATION CLAIM 25 MAPPING OF LANDS AS PER STIPULATION TO RESOLVE CONTESTS NO. 3780 AND 4082

SECTION 35, TOWNSHIP 31 SOUTH,
RANGE 13 EAST, W.M., LAKE COUNTY, OREGON

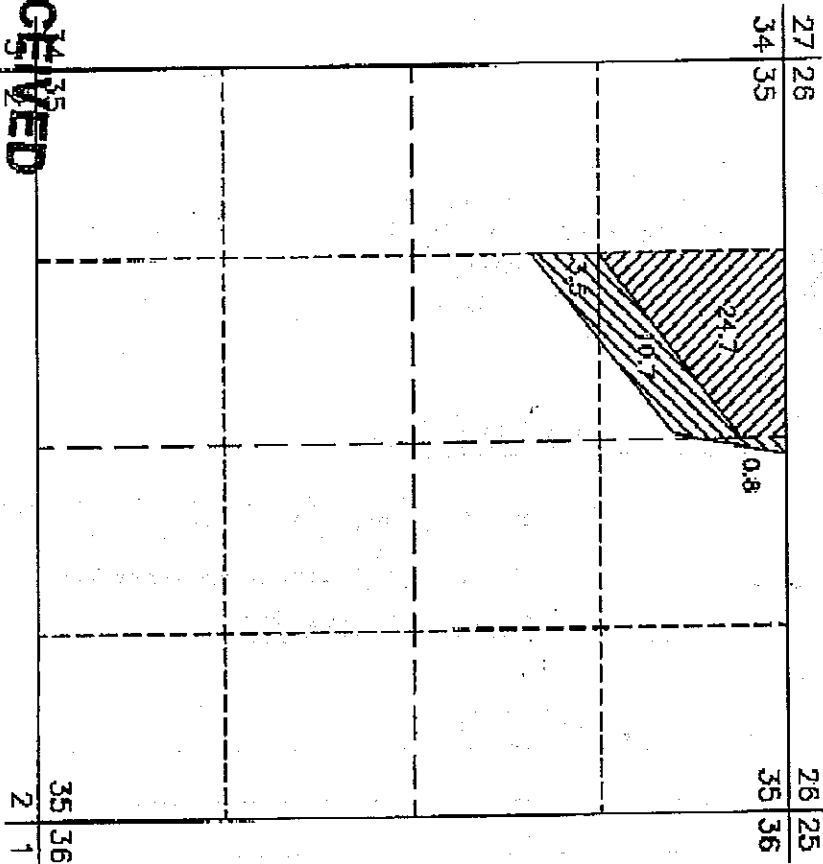

LEGEND


15.0 ACRES TO BE REMOVED AS PER
STIPULATION TO RESOLVE CONTESTS
NO. 3780 AND 4082.

24.7 ACRES TO BE REMAIN AS PER
STIPULATION TO RESOLVE CONTESTS
NO. 3780 AND 4082.

SOURCE: COYOTE CREEK, A TRIBUTARY
TO SYCAN RIVER.

POINT OF DIVERSION

LOCATED IN THE NE1/4SE1/4 OF SECTION
27, TOWNSHIP 31 SOUTH, RANGE 13 EAST,
W.M., LAKE COUNTY, OREGON AS
MAPPED BY THE OREGON WATER RESOURCES
DEPARTMENT.

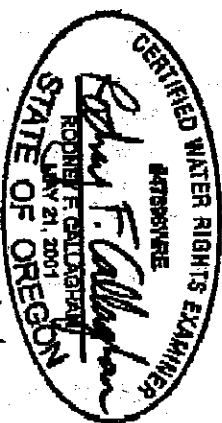

RE-NEW: 12/31/05

THIS MAP IS FOR THE PURPOSE
OF LOCATING A WATER RIGHT ONLY
AND HAS NO INTENT TO PROVIDE
LEGAL DIMENSIONS OR THE
LOCATION OF PROPERTY LINES.

SCALE 1"=1320'

RECEIVED
MAY 26 2004
WATER RESOURCES DEPT
SALEM, OREGON

R13E

PREPARED BY:

CLS

CALLAGHAN LAND SURVEYING
427 SOUTH H STREET
LAKEVIEW, OR 97630
(541) 947-5841

DATE: 5/25/2004

DRAWING: 200407A

PREPARED FOR: MARTIN LESTER PERNOLL
705 GREENSBURG CIRCLE
RENO, NV 89509