


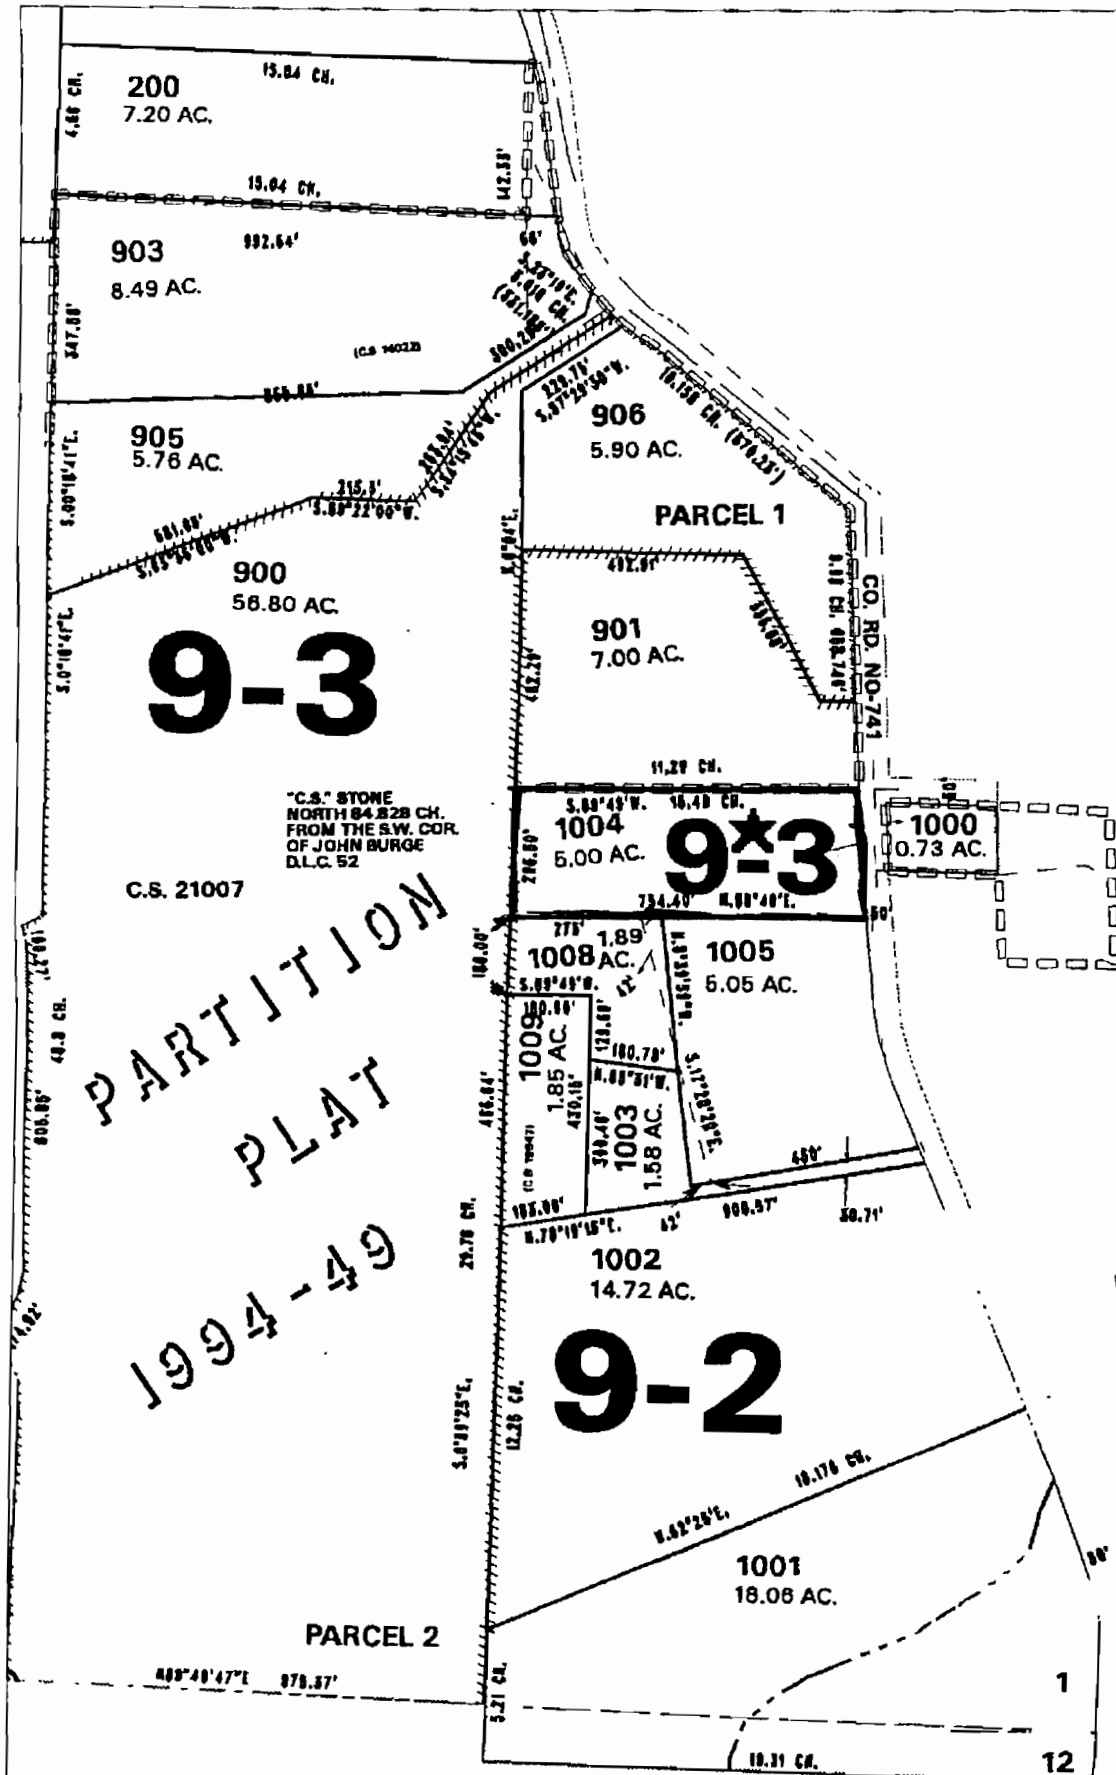

RECEIVED

MAR 30 2009

WATER RESOURCES DEPT
SALEM, OREGON

TMK

13 2W 1


SEE MAP 13 2W 12

07/20/01.15:18:11.Fri

1" = 100'

S

W

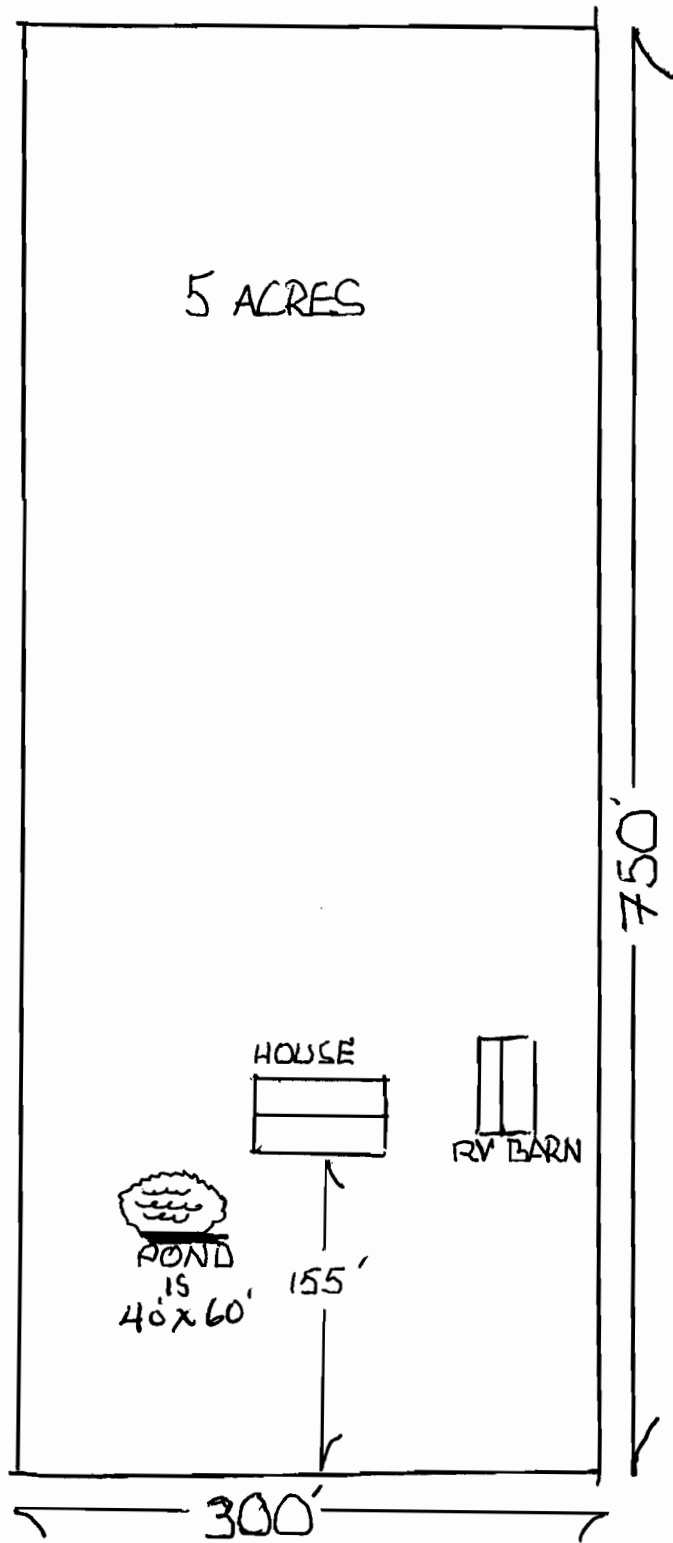

POND LOCATED 1800 FEET NORTH
AND 625 FEET WEST OF SOUTHEAST
CORNER OF SECTION 1 (ONE)

R.87442

 Proposed Pond
— Dam
RECEIVED

APR 20 2009

WATER RESOURCES DEPT
SALEM, OREGON

RECEIVED

MAR 30 2009


WATER RESOURCES DEPT
SALEM, OREGON

← 30066 SODAVILLE MTN HOME RD LEBANON OREGON →

⌈

TOWNSHIP	RANGE	SECTION	QUART/QUART	TAX LOT
13S	02W	01	N/A	1004

R-87442

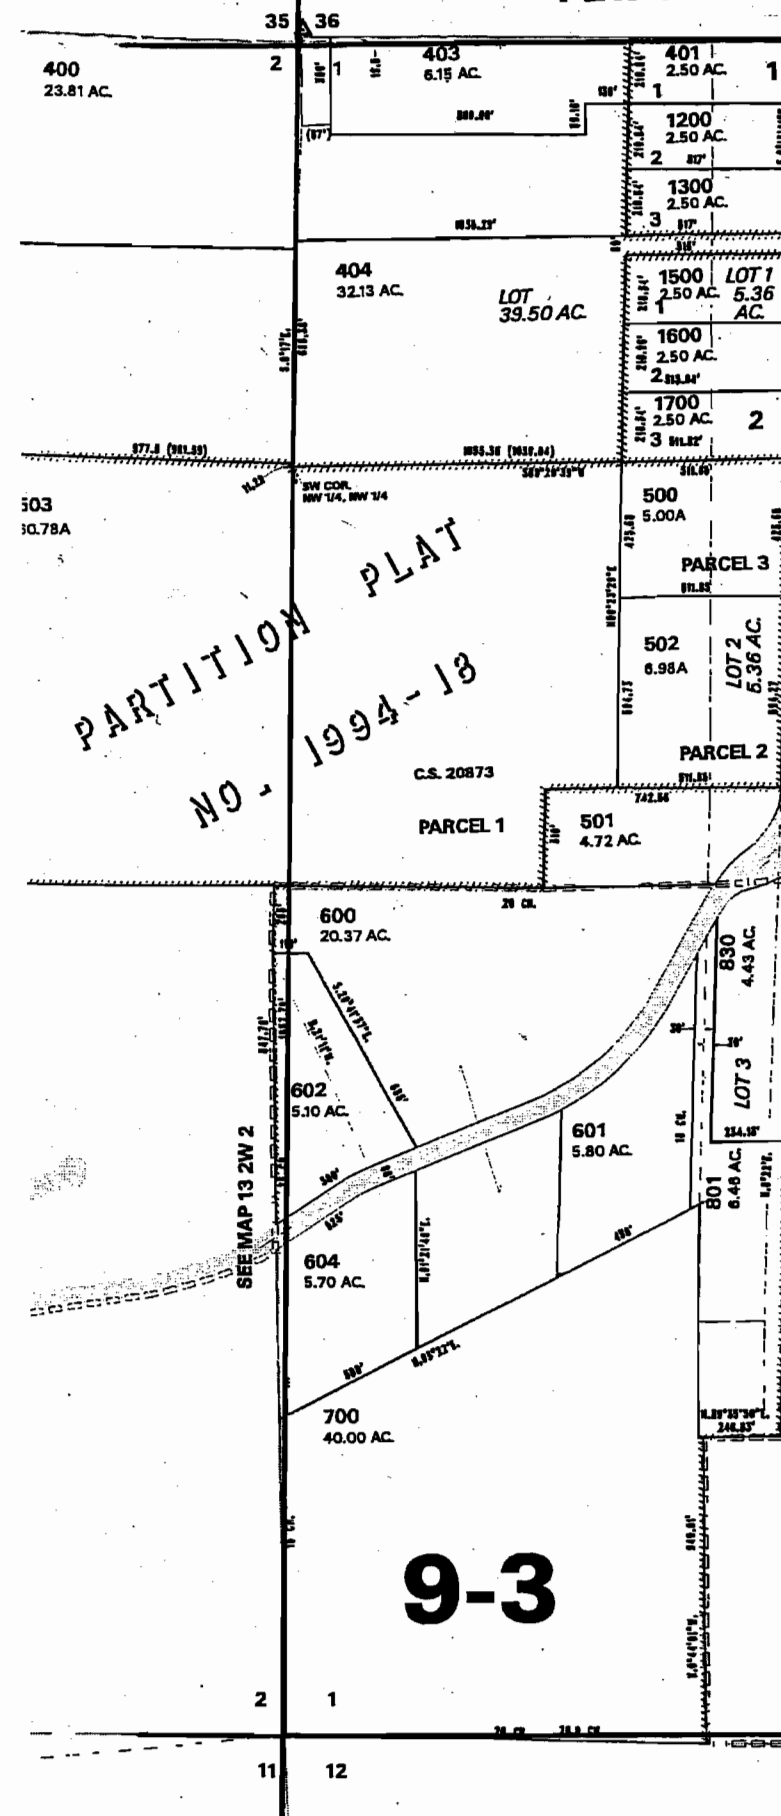

9-2

SEE MAP 13 1W 6

PODS LOCATED 1800 FEET NORTH
AND 625 WEST OF SOUTHEAST CORNER
OF SECTION 1 (ONE)
(PER CONVERSATION WITH HENRY 4-17-2009)
THANKS HENRY!


**SEE MAP
13 2W 1C**

9-3

C.S. 21007
 D.L.C. 52
 PARTITION
 PLAT

RECEIVED

APR 20 2009
WATER RESOURCES DEPT

094-49

9-2

1001
18.08 AC.

PARCEL 2

(12.31.02)

1 | 6

12 7