


T. 26S., R. 6W., W.M.

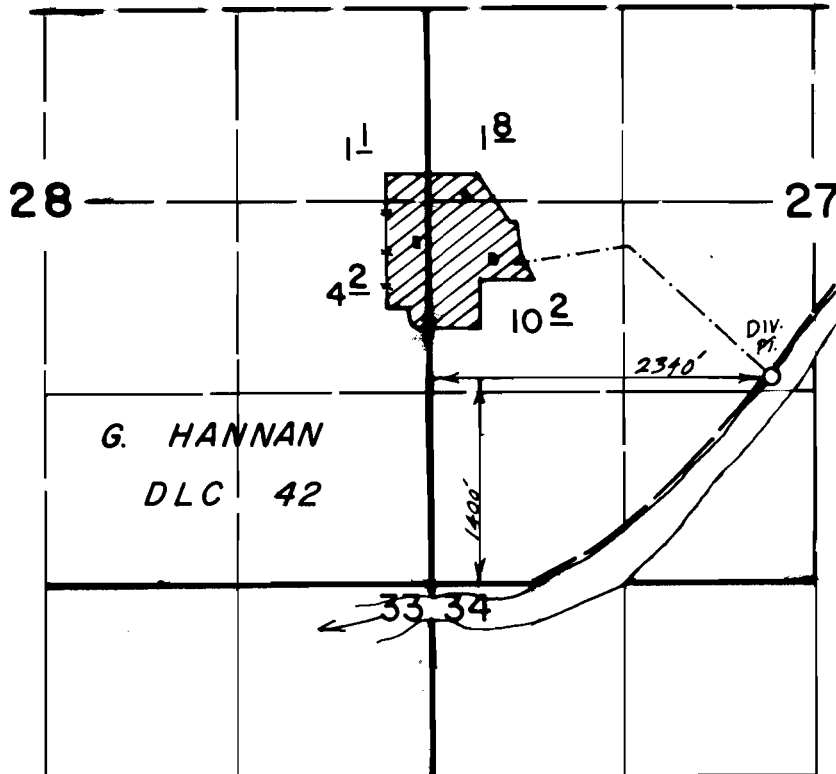

Scale 1" = 1320'

**FINAL PROOF SURVEY
UNDER**

Application No. 60362 Permit No. 45157.....
IN NAME OF

VEZZE.T.T.I., PAULSON, SWANSON.

Surveyed March 20, 1996, by S. DE HAAS.....

RECEIVED

APR 03 1996
WATER RESOURCES DEPT.
SALEM, OREGON