


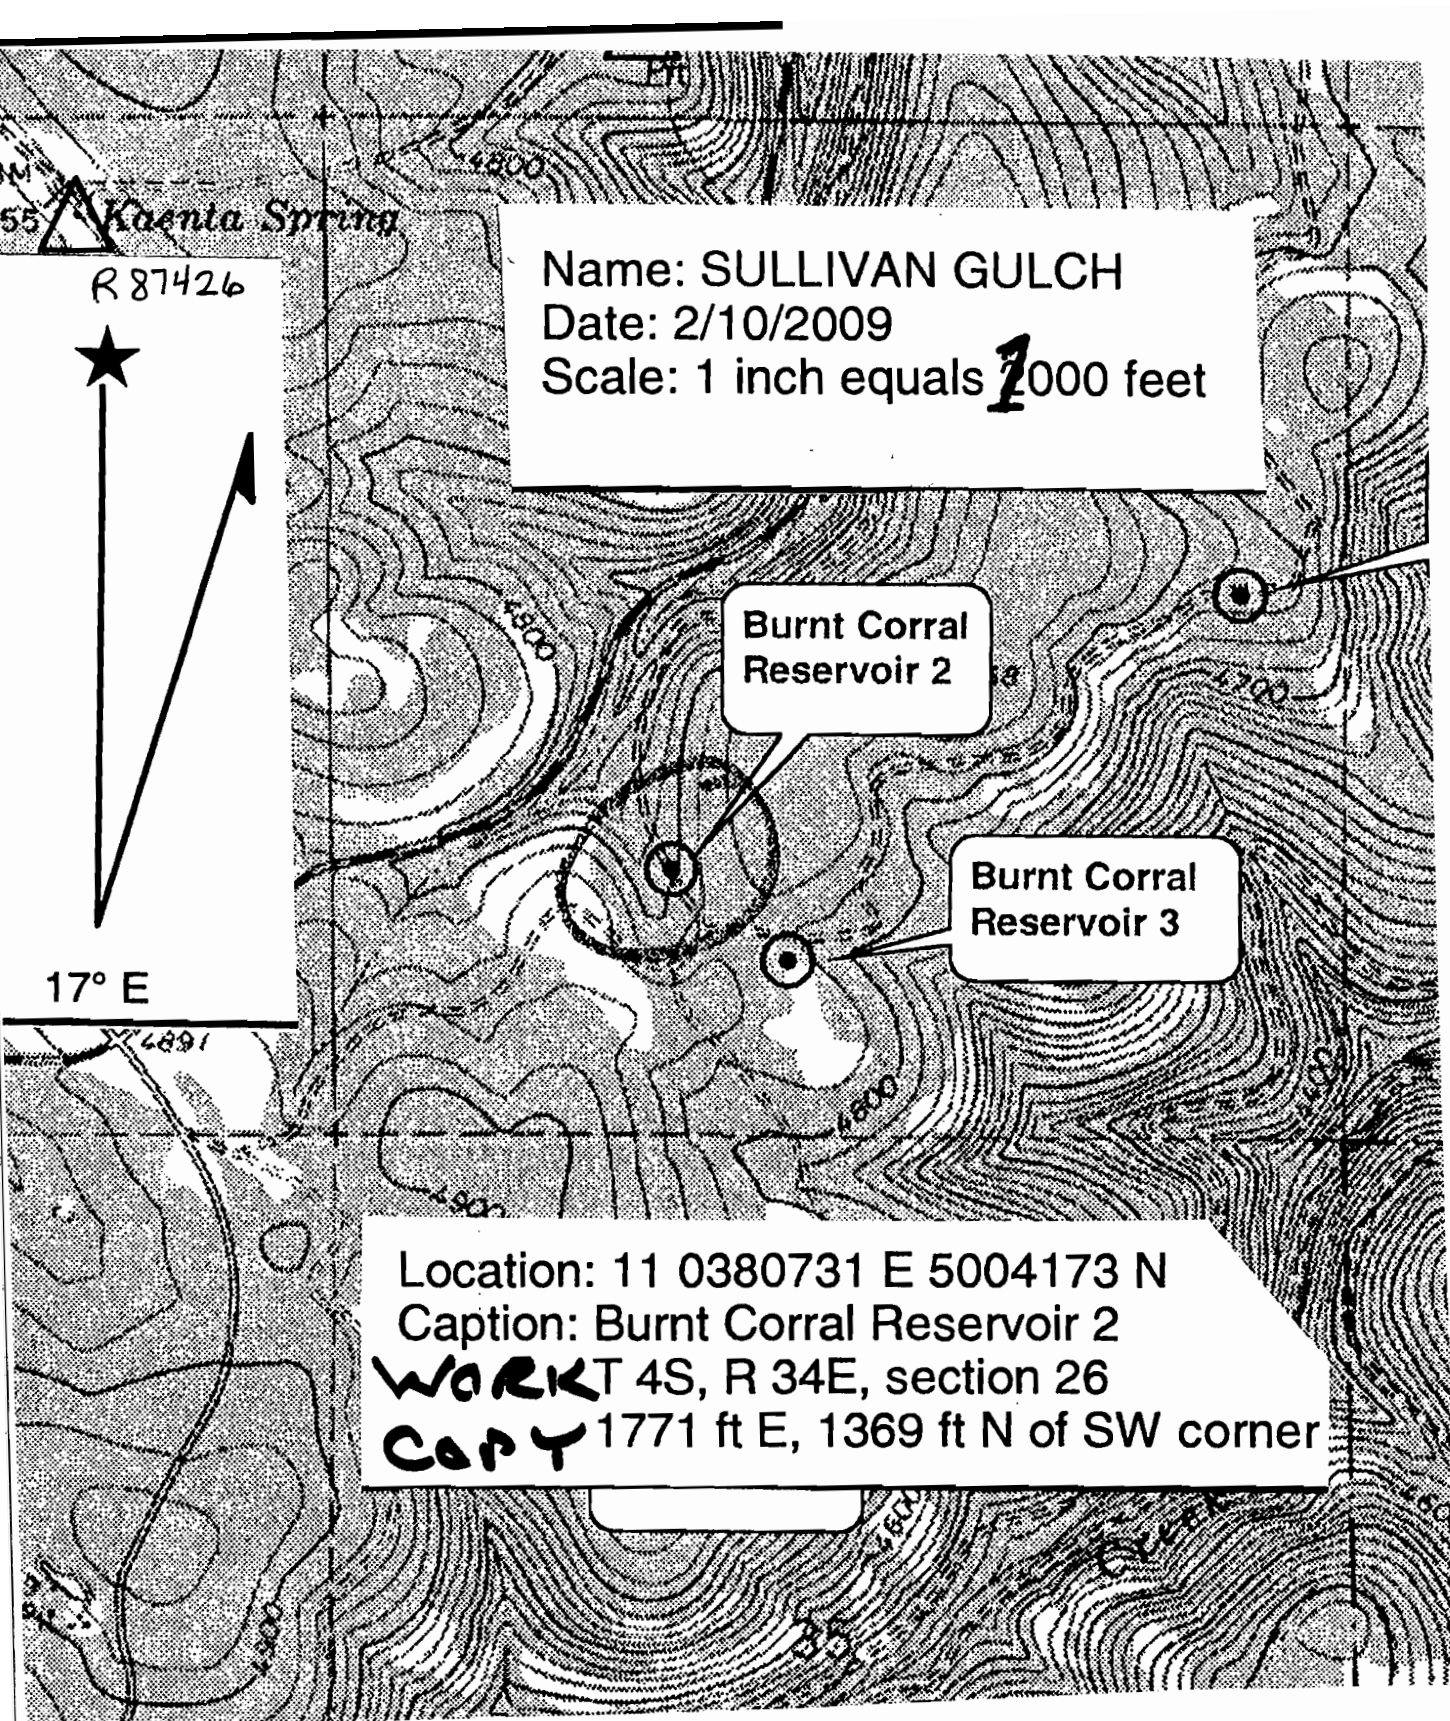

Name: SULLIVAN GULCH
Date: 2/10/2009
Scale: 1 inch equals **1**000 feet

Location: 11 0380731 E 5004173 N
Caption: Burnt Corral Reservoir 2
WORK T 4S, R 34E, section 26
COPY 1771 ft E, 1369 ft N of SW corner

