


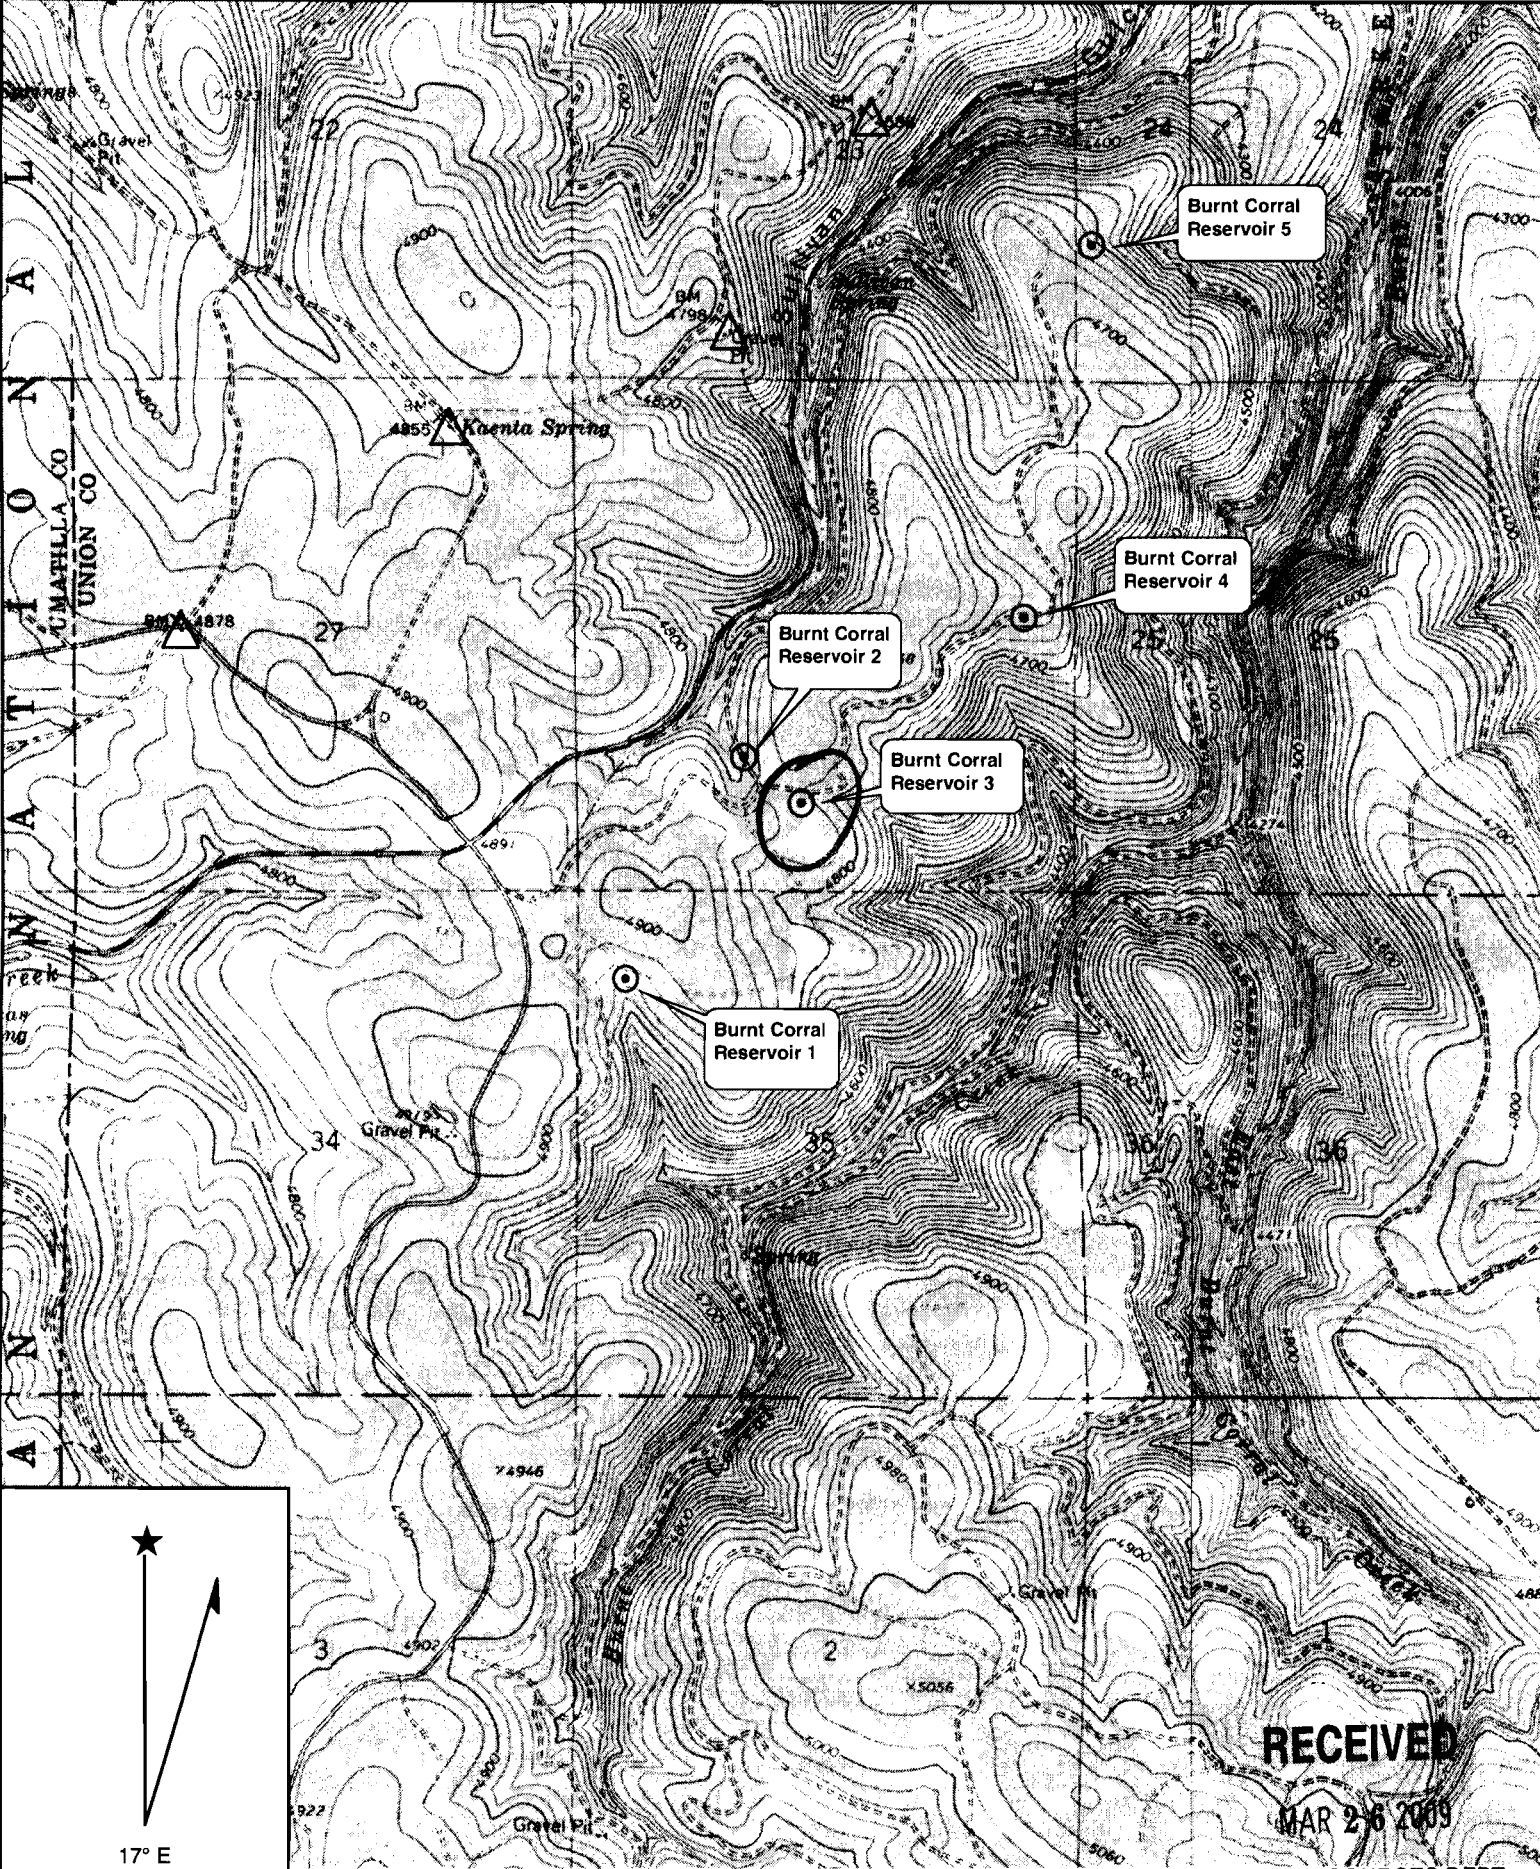


Name: SULLIVAN GULCH
Date: 2/10/2009
Scale: 1 inch equals 2000 feet

Location: 11 0380731 E 5004173 N
Caption: Burnt Corral Reservoir 3
T 4S, R 34E, section 26
2383 ft E, 915 ft N of SW corner section 26

WATER RESOURCES DEPT
SALEM, OREGON

R-87427

OK

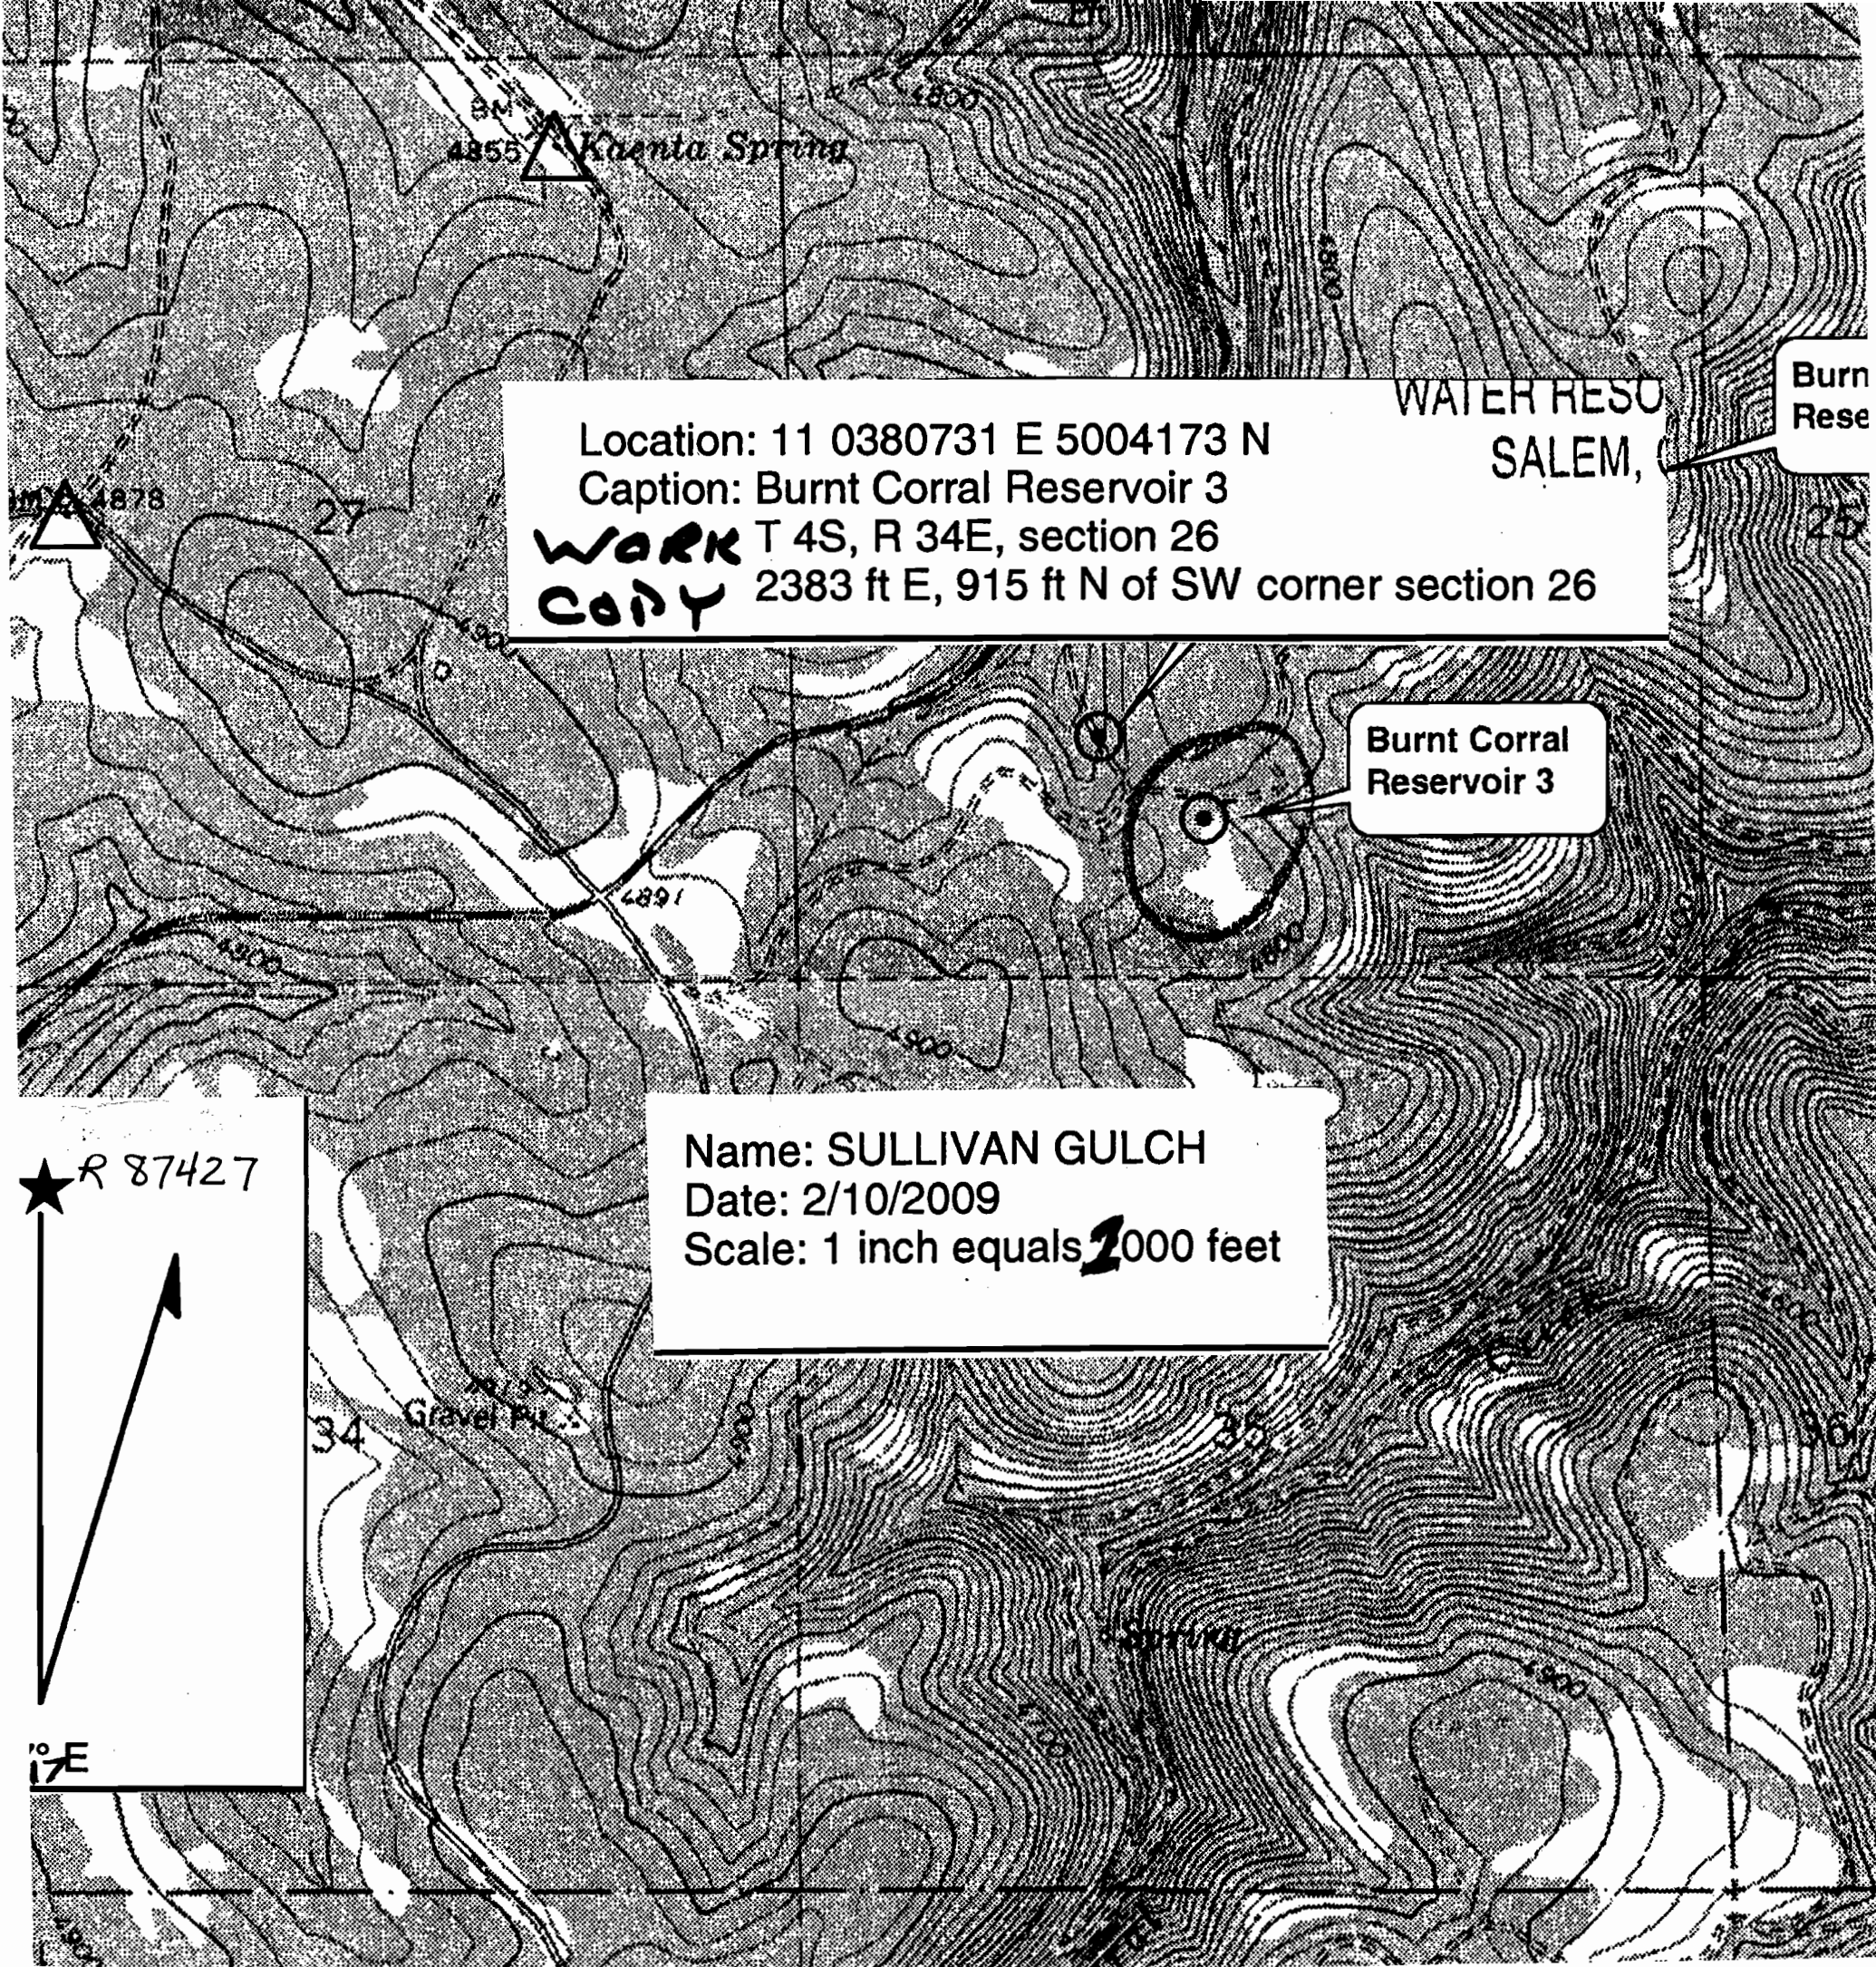

Location: 11 0380731 E 5004173 N
Caption: Burnt Corral Reservoir 3
WORK COPY T 4S, R 34E, section 26
2383 ft E, 915 ft N of SW corner section 26

WATER RESO
SALEM, O
Burn
Rese

Burnt Corral
Reservoir 3

Name: SULLIVAN GULCH
Date: 2/10/2009
Scale: 1 inch equals **2**000 feet

