


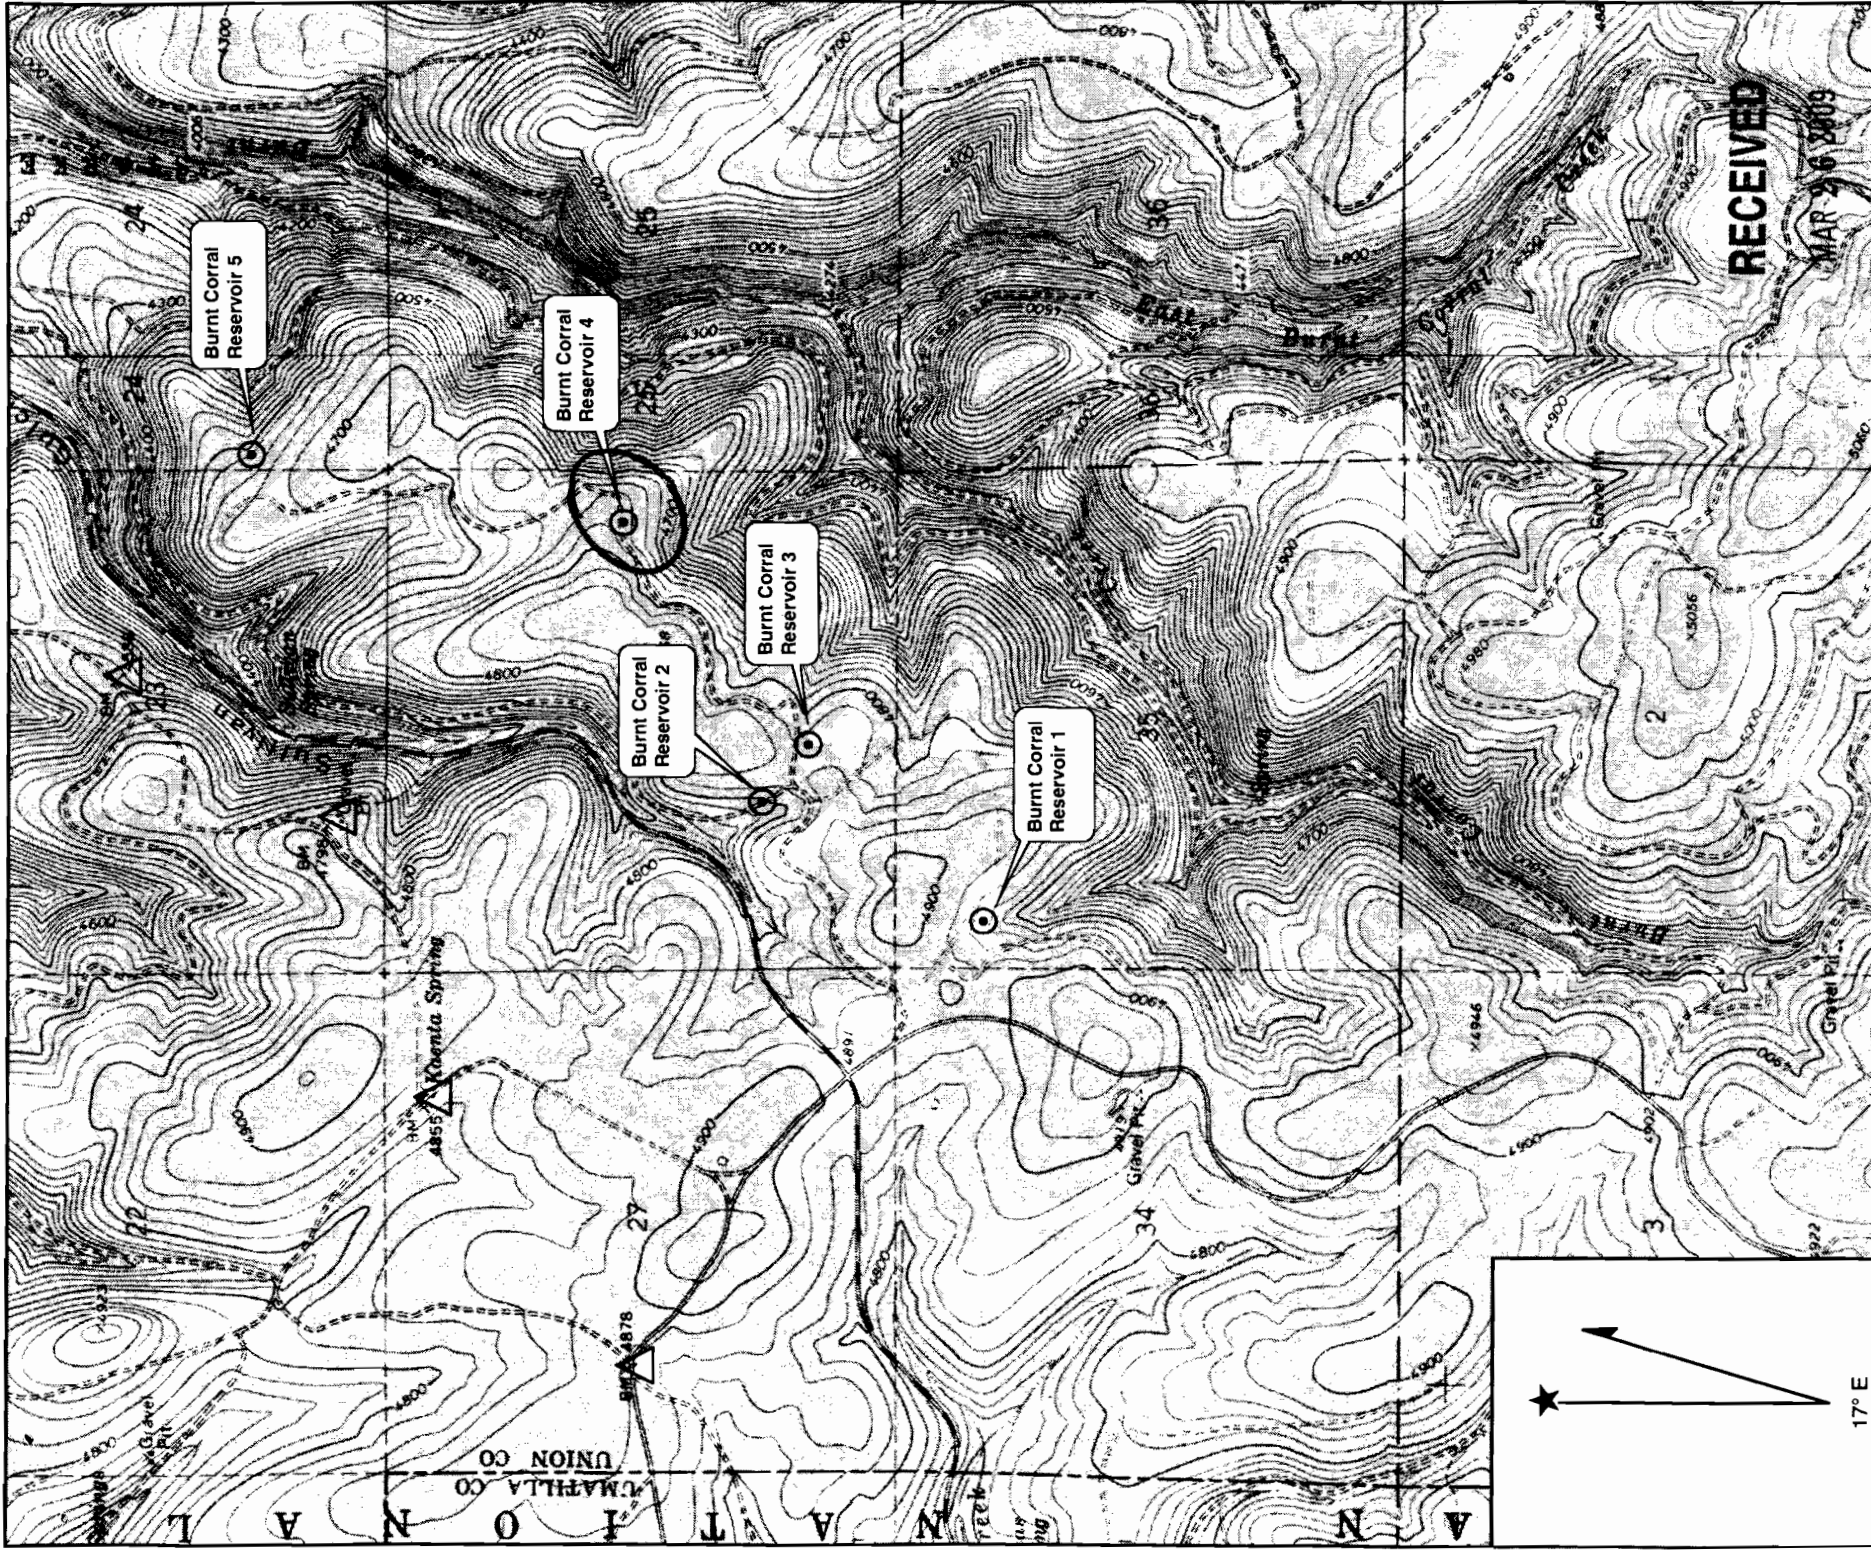

RECEIVED

MAR 26 2009

WATER RESOURCES DEPT

SALEM, OREGON


R87428

Location: 11 0380731 E 5004173 N
Caption: Burnt Corral Reservoir 4
T 4S, R 34E, section 26
511 ft W, 2474 ft S of NE corner section 26


Name: SULLIVAN GULCH
Date: 2/10/2009
Scale: 1 inch equals 2000 feet

Copyright (C) 1999, Maptech, Inc.

OK

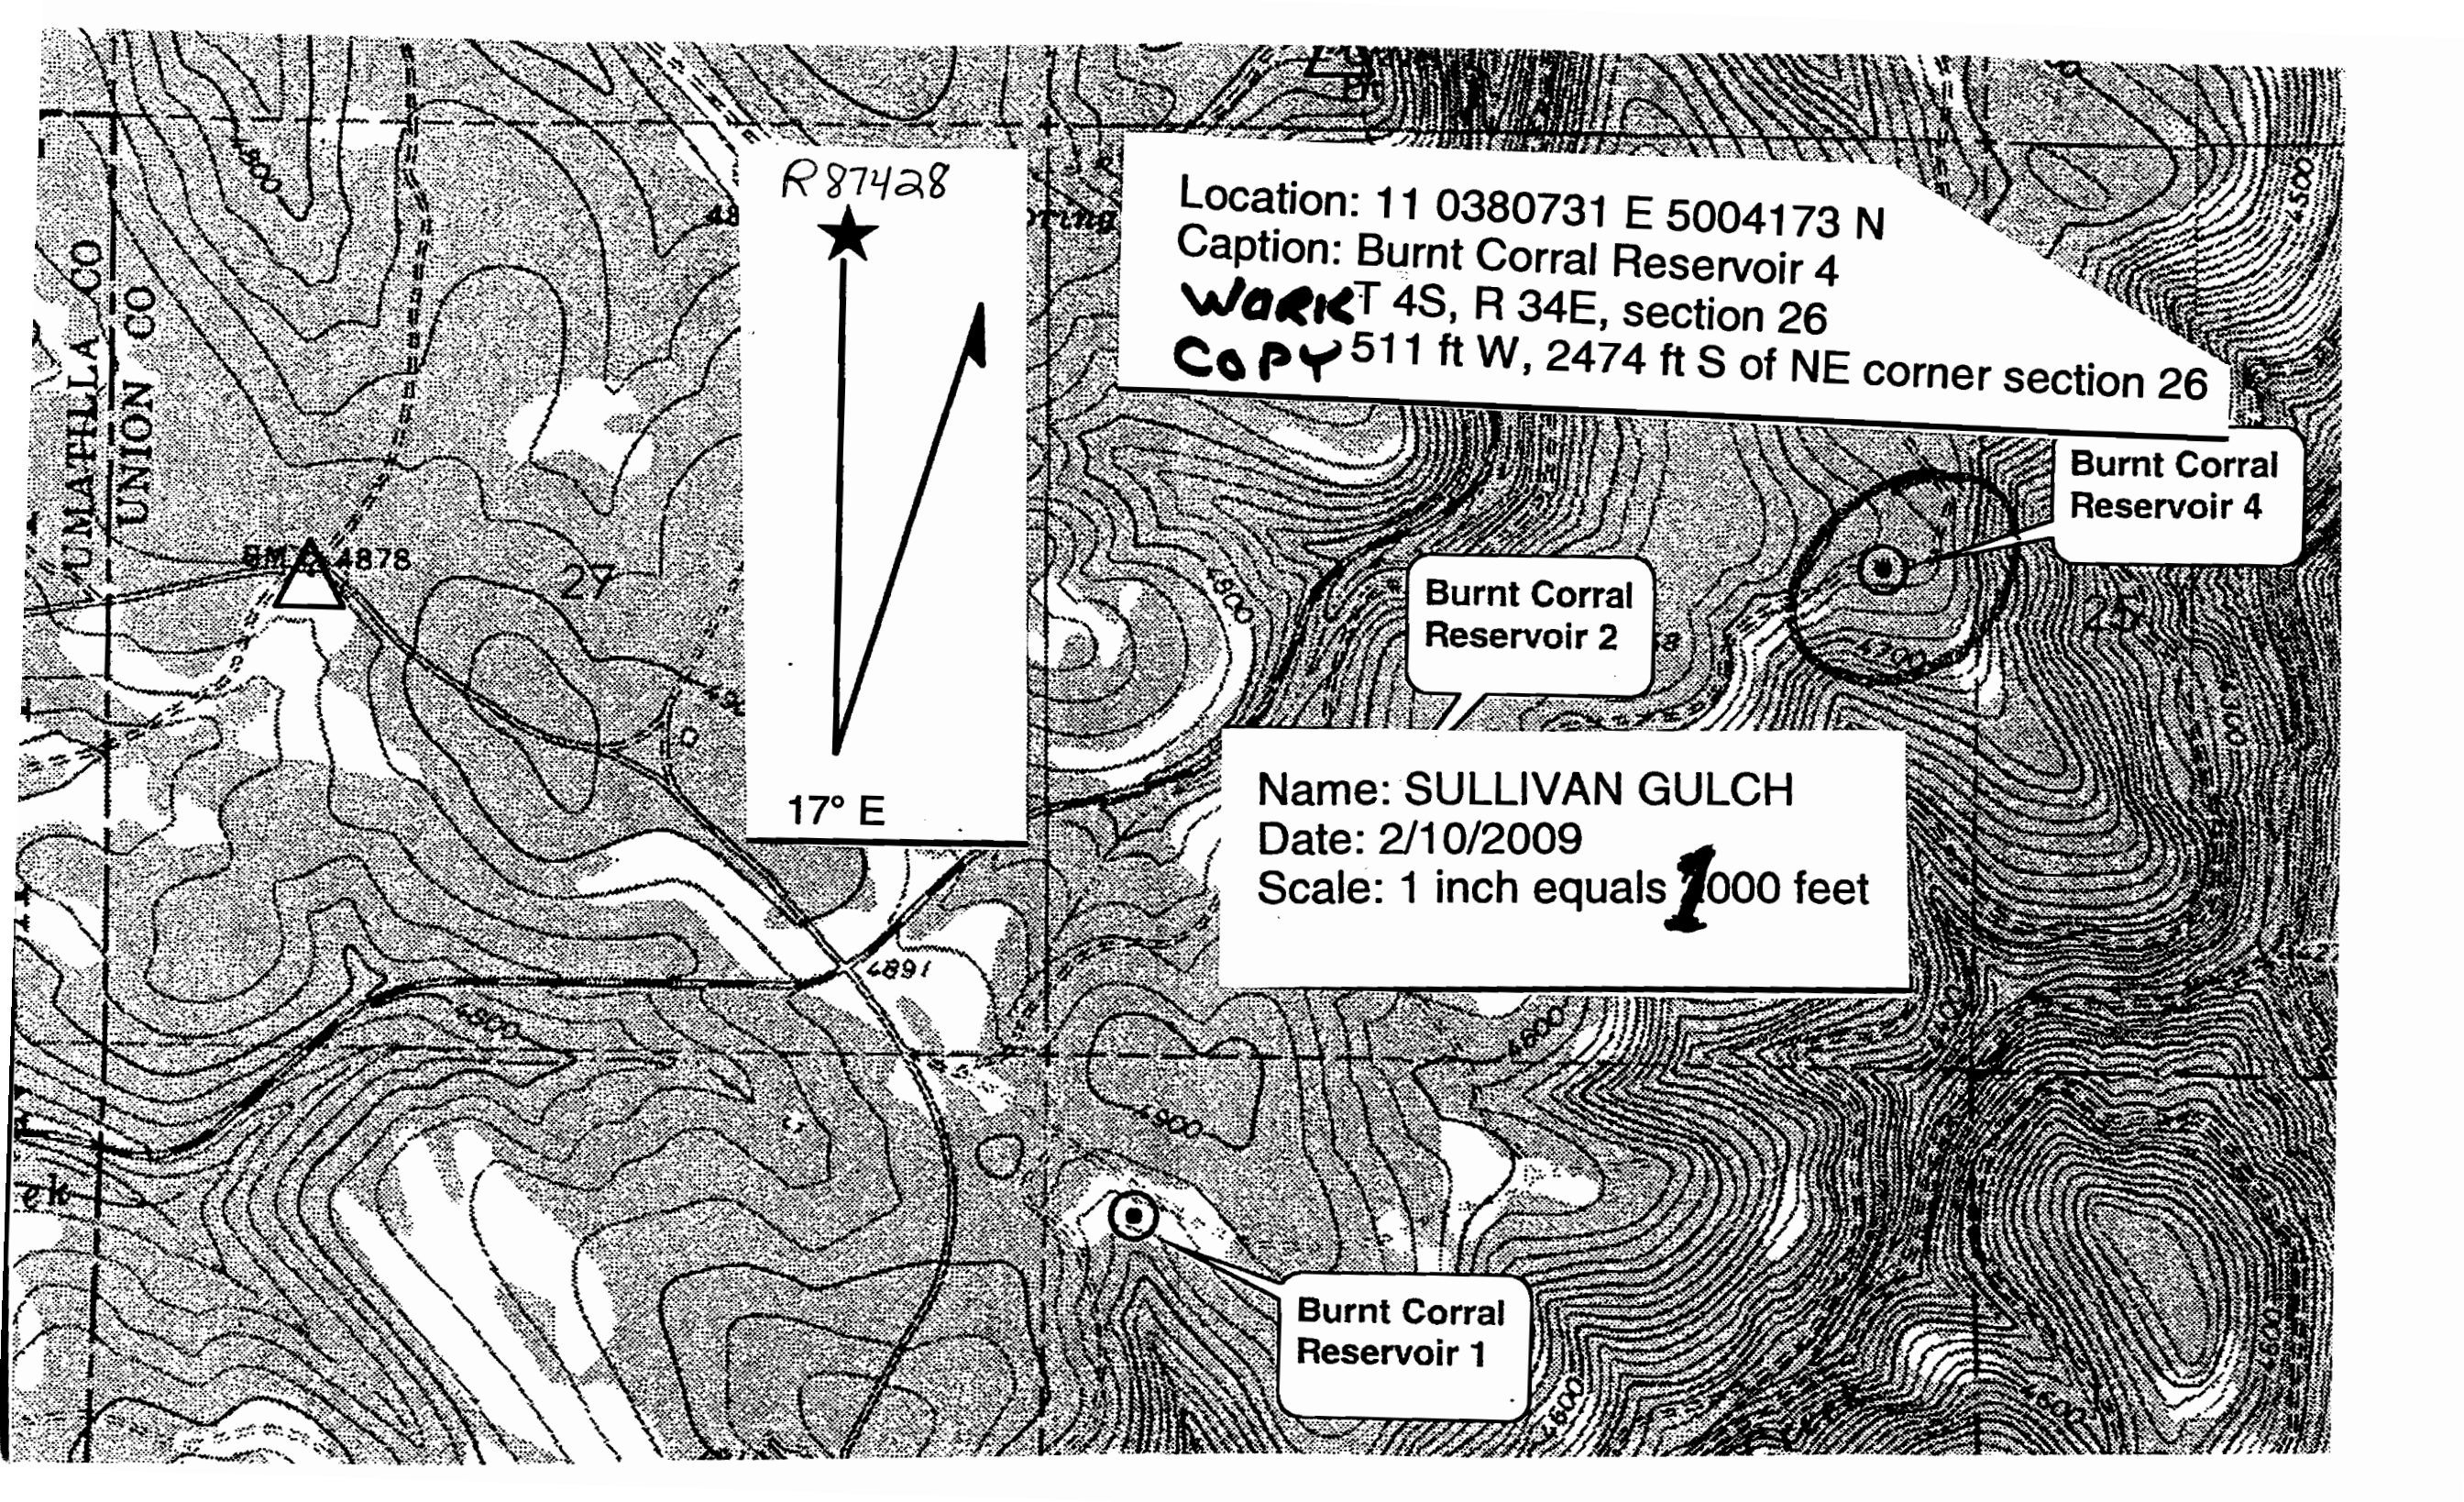

Location: 11 0380731 E 5004173 N
Caption: Burnt Corral Reservoir 4
WORK T 4S, R 34E, section 26
COPY 511 ft W, 2474 ft S of NE corner section 26

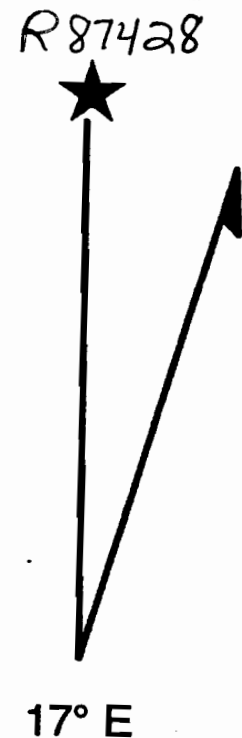

Burnt Corral
Reservoir 4

Burnt Corral
Reservoir 2

Name: SULLIVAN GULCH
Date: 2/10/2009
Scale: 1 inch equals **1**000 feet

Burnt Corral
Reservoir 1