



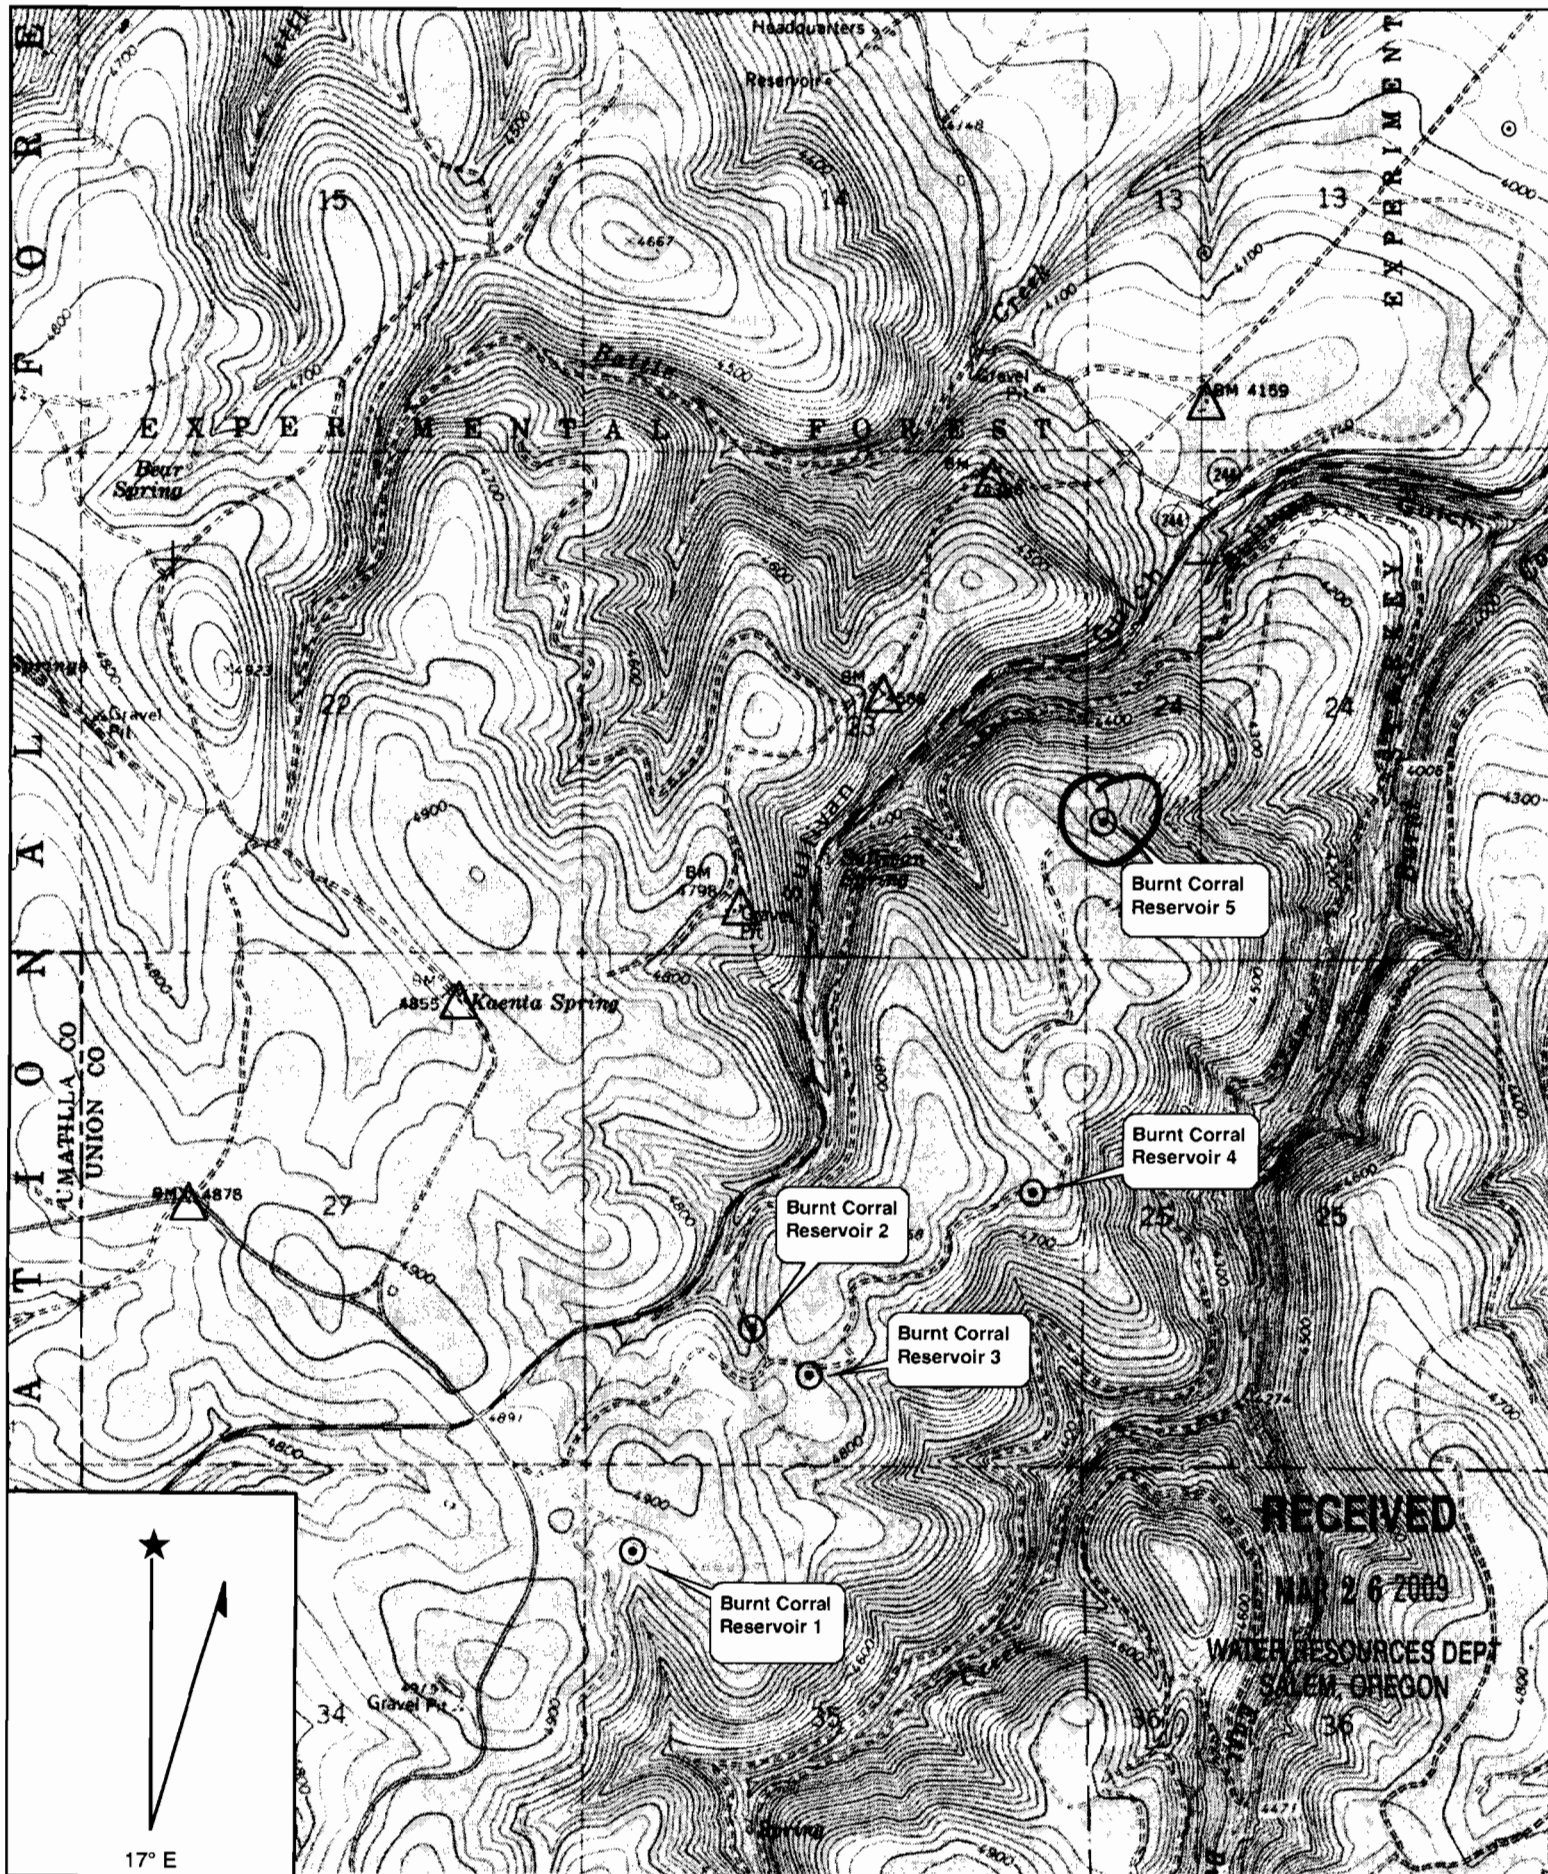

Name: MARLEY CREEK
 Date: 2/10/2009
 Scale: 1 inch equals 2000 feet

Location: 11 0380763 E 5005977 N
 Caption: Burnt Corral Reservoir 5
 T 4S, R 34E, section 24
 1781 ft N, 187 ft E of SE corner section 24


R87429

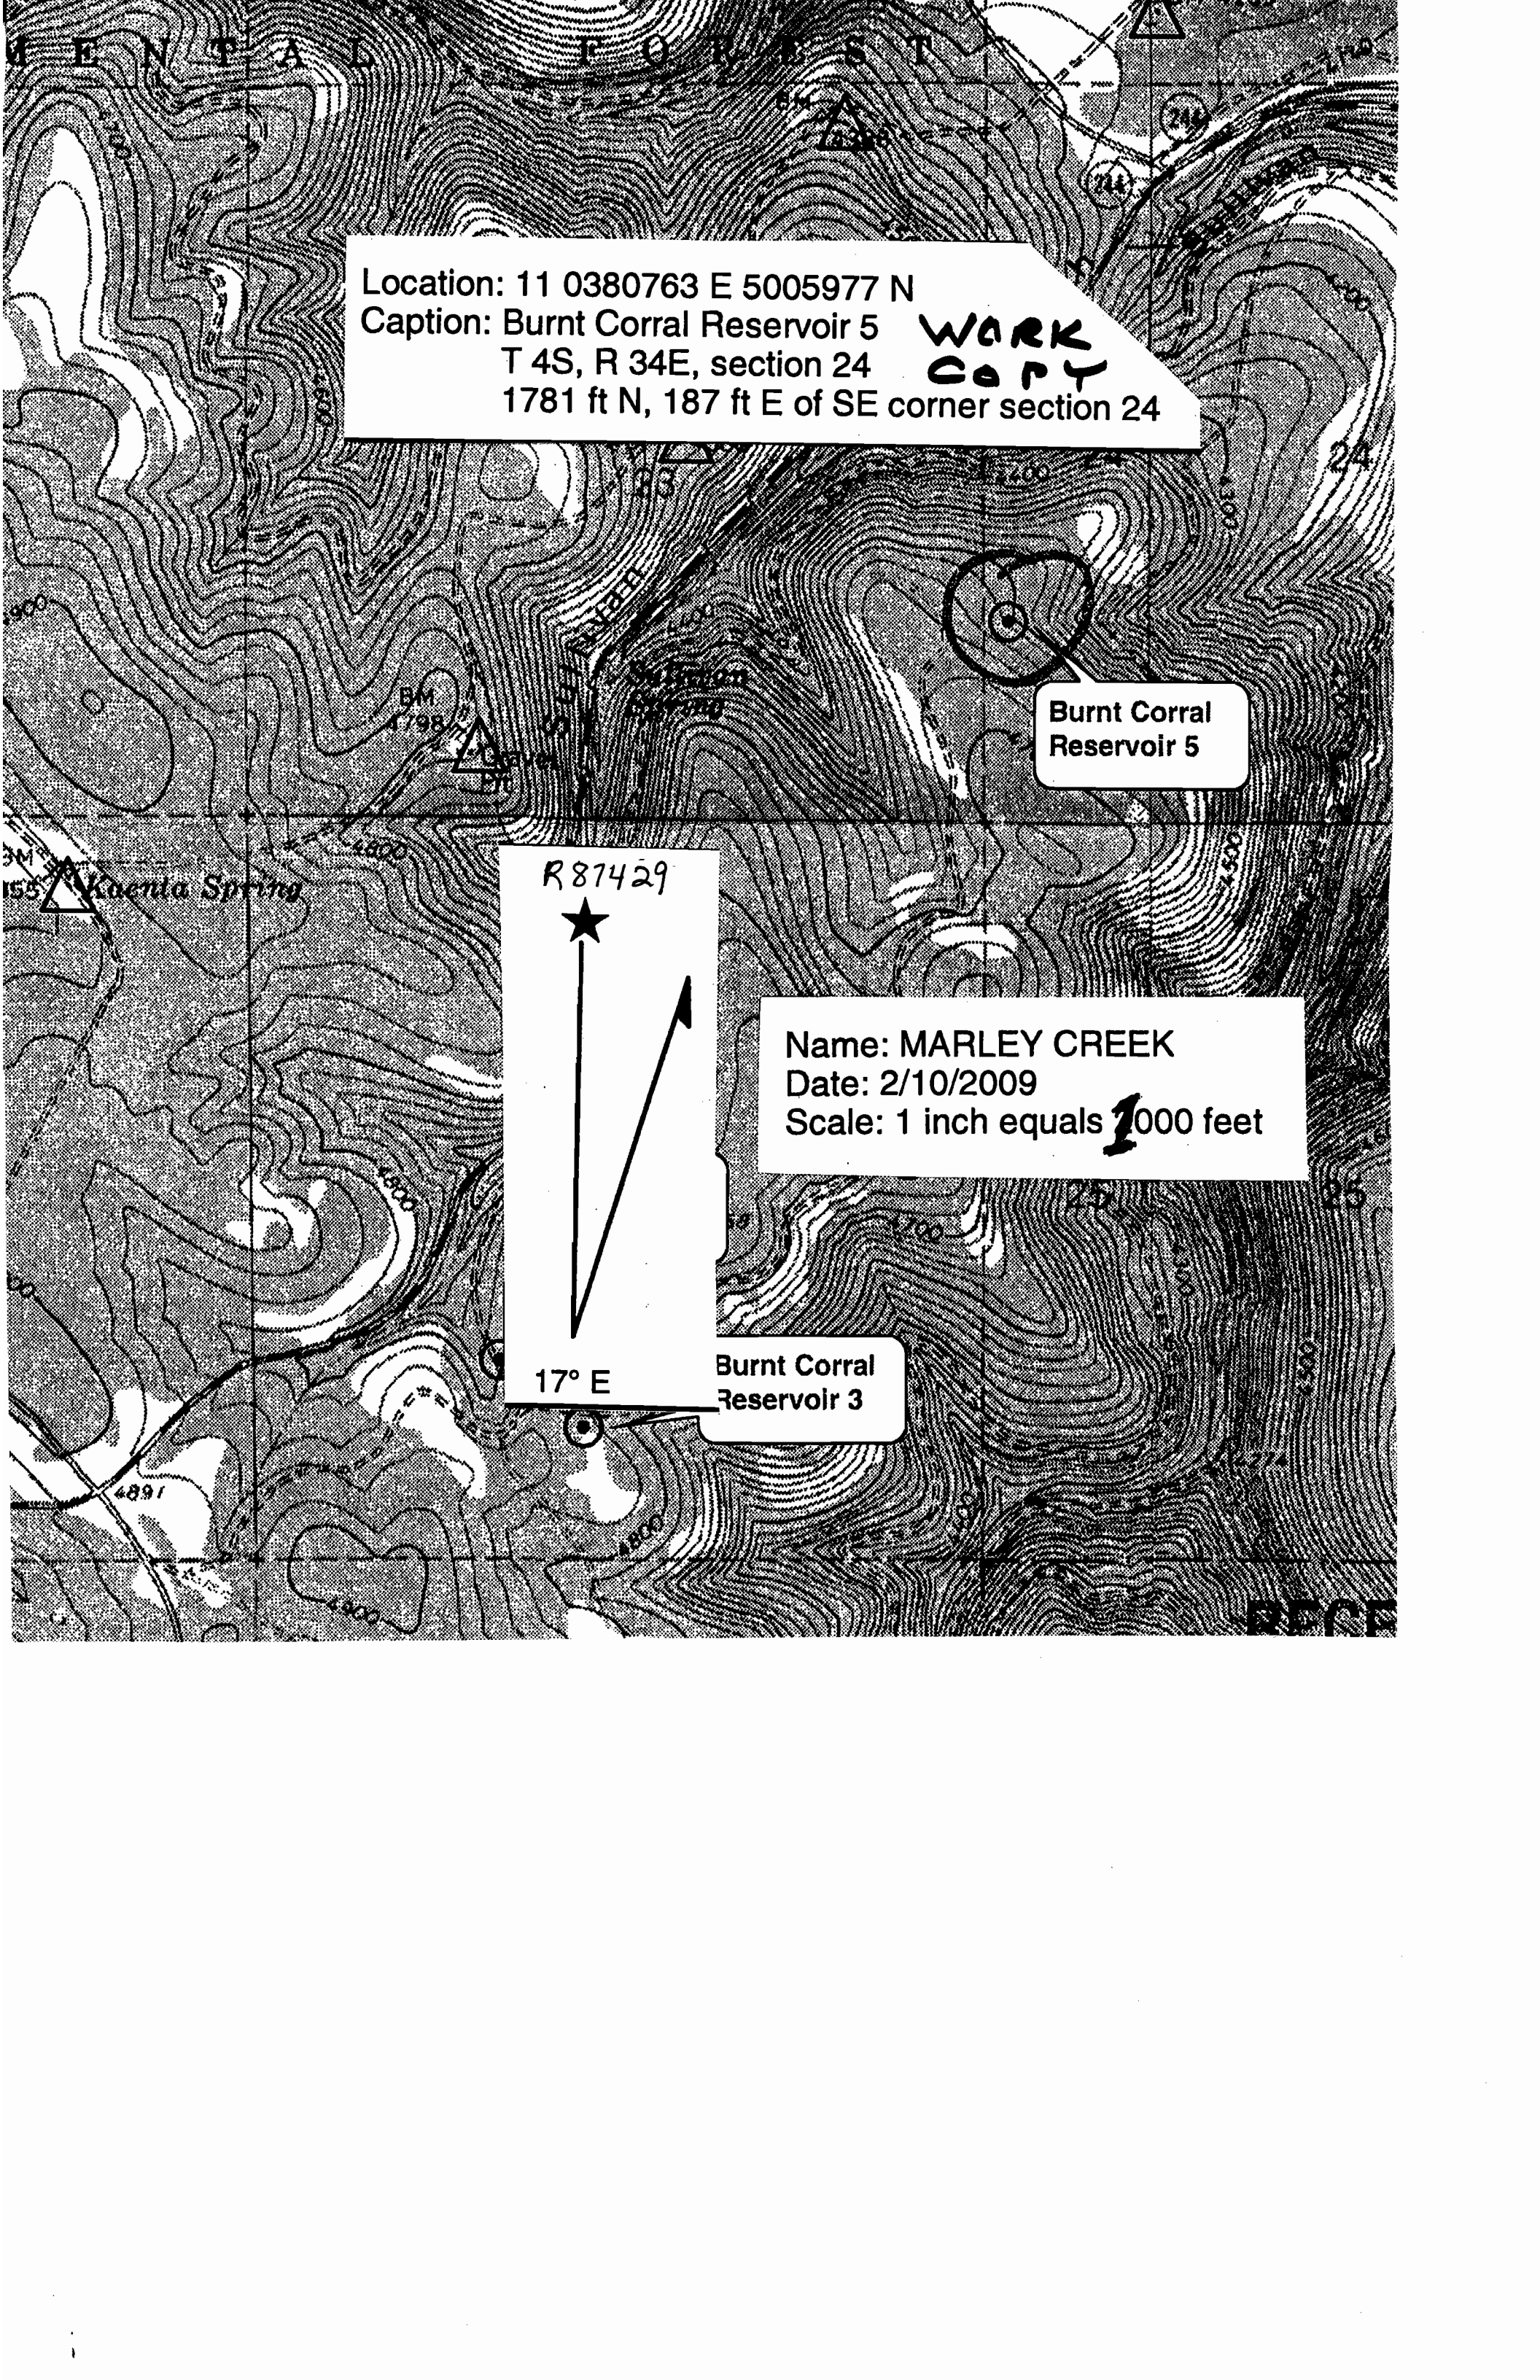

Location: 11 0380763 E 5005977 N
Caption: Burnt Corral Reservoir 5
T 4S, R 34E, section 24
1781 ft N, 187 ft E of SE corner section 24

WORK
COPY

Burnt Corral
Reservoir 5

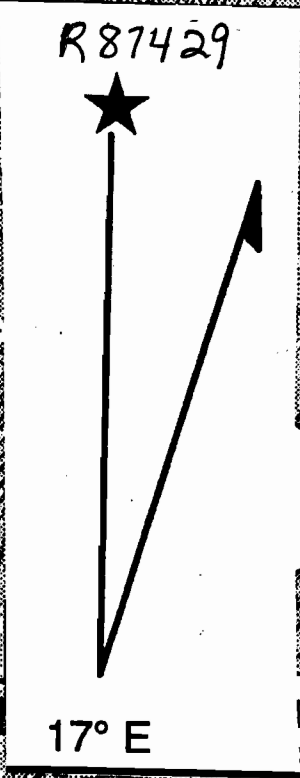

Name: MARLEY CREEK
Date: 2/10/2009
Scale: 1 inch equals 1000 feet

Burnt Corral
Reservoir 3

RECE