


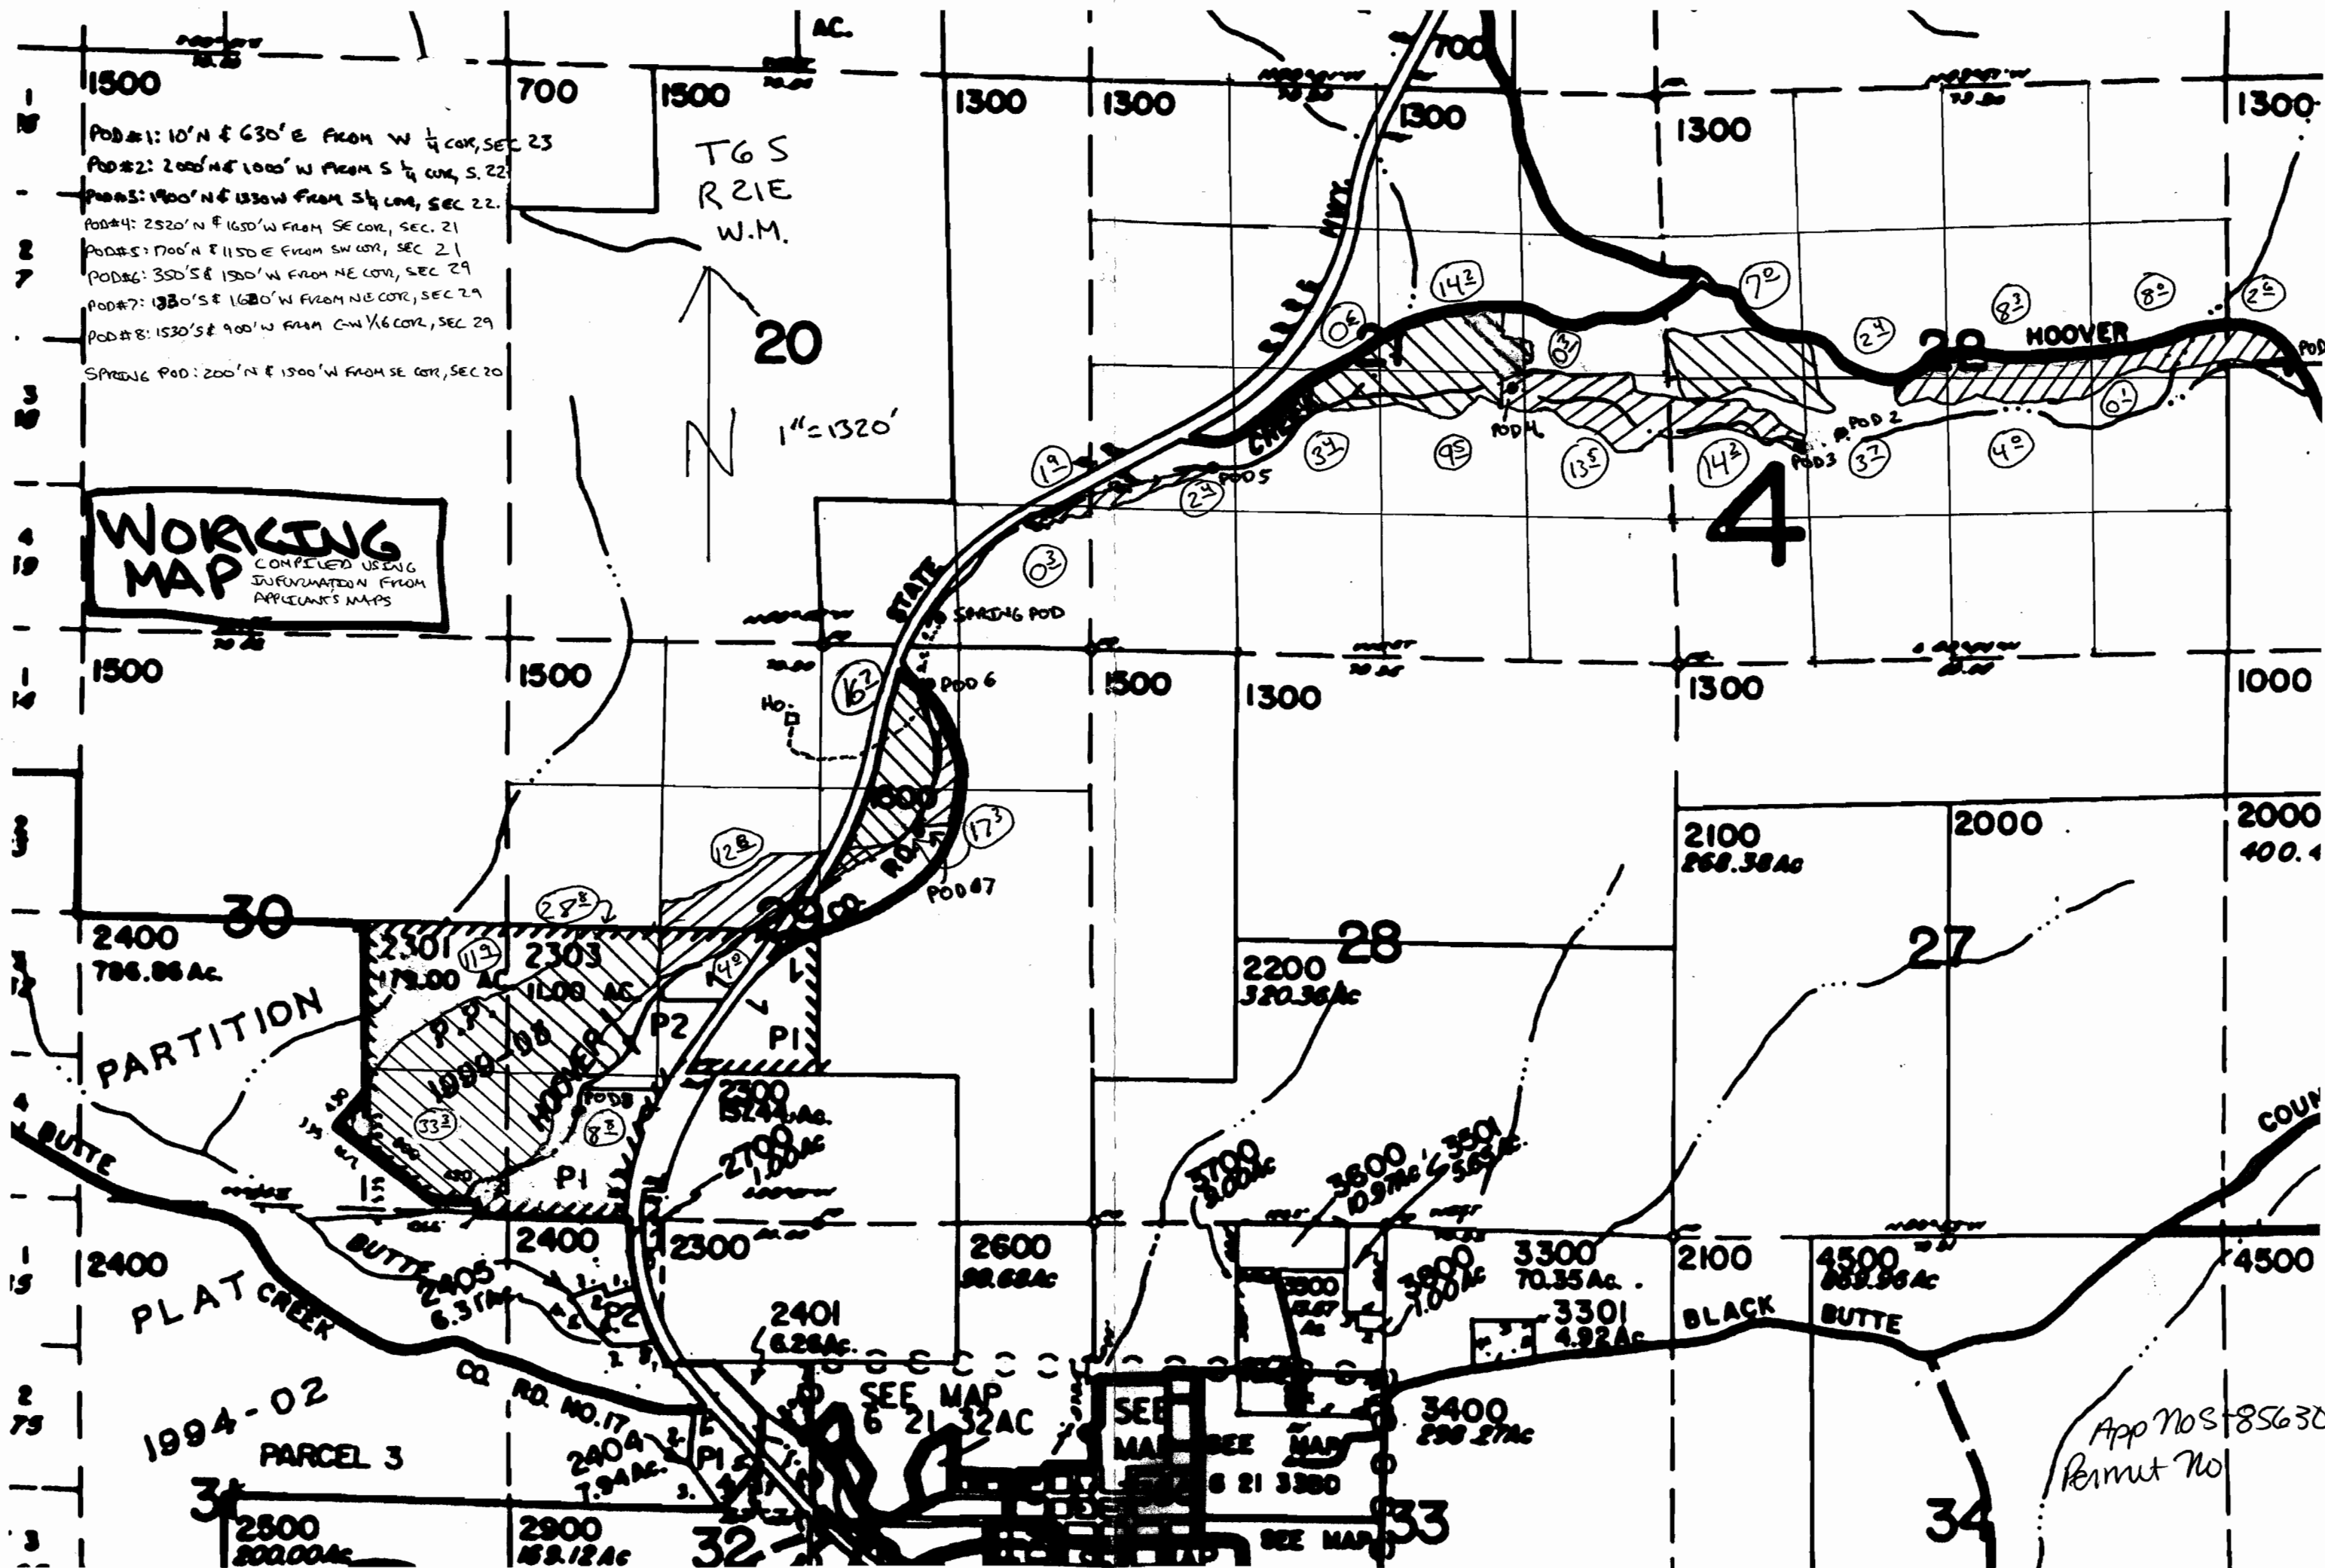

WORKING MAP
COMPILED USING
INFORMATION FROM
APPLICANT'S MAPS

PARTITION

1994-02
PARCEL 3

App No 85630
Permit No