

STATE OF OREGON
WATER RESOURCES DEPARTMENT
ADJUDICATION SECTION

TO: Reed Marbut
FROM: Don Knauer

DATE: January 9, 1992

SUBJECT: Indorsement of SWR-9

I have completed a review of the registration statement form, map and evidence submitted by the following claimant. I have made a inspection of the property identified in the claim and I have reviewed the WRD records. Based on my review and inspection I suggest the following information be included on the " Notice of Proposed Order " under ORS 539.240 (8):

NAME: Doris I. Matthews
ADDRESS: 6987 Coos Bay Wagon Rd
Roseburg OR 97470

SOURCE: Rock Creek a tributary of South Umpqua River.

USE: Irrigation, domestic and stockwater.

PRIORITY DATE: 1870 and 1887 (see below)

AMOUNT OF WATER FOR EACH CLAIMED USE:

	<u>1870</u>		<u>1887</u>
irrigation:	0.0036 CFS	irrigation:	0.0009 CFS
domestic use:	0.0075 CFS	domestic use:	0.0075 CFS
stockwater:	0.0055 CFS	stockwater:	0.0055 CFS

DIVERSION POINT:

NE $\frac{1}{4}$ SE $\frac{1}{4}$ Section 2, T. 28 S., R 8 W., W.M.

PLACE OF USE:

	<u>1870</u>		<u>1887</u>
2.0 acres	SE $\frac{1}{4}$ SE $\frac{1}{4}$	0.5 acre	SE $\frac{1}{4}$ SE $\frac{1}{4}$
Stocwater	SE $\frac{1}{4}$ SE $\frac{1}{4}$	Stockwater	SE $\frac{1}{4}$ SE $\frac{1}{4}$
Domestic	NE $\frac{1}{4}$ SE $\frac{1}{4}$	Domestic	SE $\frac{1}{4}$ SE $\frac{1}{4}$

Section 2,
Township 28 S., Range 8 W., W.M.

PERIOD OF USE:

The irrigation season is April 1 thru September 30. Other uses are allowed all year.

NOTE: There have been changes of diversion points and places of use within the property boundaries.

FILE C:\WP51\SWR\CLAIMANT\SWR-0009.0IM



STATE OF OREGON

INTEROFFICE MEMO

TO: Adjudication Section

FROM: Gary Ball, Watermaster *GB*

SUBJECT: Surface Water Registrations - No Comment

DATE: 08/29/91

I have no comment on the SWR's of which I have made copies of the first page and attached.

RECEIVED

SEP - 3 1991

WATER RESOURCES DIVISION
OF THE STATE OF OREGON

6987 Coast E. Hagen Rd.
Roseburg, Oregon 97470
August 12, 1991

S.H.R. Field Operations
3850 Portland Rd. N.E.
Salem, Or. 97310

RECEIVED

AUG 15 1991
WATER RESOURCES DEPT.
SALEM, OREGON

Dear Sirs:

Enclosed is a copy of the "Chronological order" you requested during your visit to our place today concerning S.H.R. #9.

Also, this letter is to request that S.H.R. #9 be listed in my name, Doris L. Matthews. My husband, Ivan M. Matthews was killed in a motor vehicle accident in British Columbia, Canada, on July 10, 1991. Our real & other property was listed in both our names so lawyer advised that it would not have to go thru probate. The Court house records are being changed to just my name using my middle name initial, "L", instead of maiden name initial "I" as I usually sign.

Thank you.

Yours truly,
Doris L. Matthews

1890 date
established from
census records
for school attendance
+ purchase of lumber
from Surrency mill

RECEIVED
AUG 15 1991
WATER RESOURCES DEPT
SALEM, OREGON

Chronological History of Ivan Matthews' Place
Benefitting from Rock Creek in Reston Area

- 1870 A. A. Matthews built house & barn #1 (hse. burned in 1927)
 Ditched water from Rock Creek for house, garden, live-
 stock, and fruit trees.

- 1887 *George (1) Matthews built house and barn #2 on home-
 stead. (dismantled in 1904 to build hse. #3)

- 1887-1891 Wooden flume constructed

- 1894 Sawmill installed

- 1904 { George (1) Matthews built house #3 and barn #3.
 { Sawmill dismantled and house and barn #2

- 1909 Orchard Planted

- 1927 Barn #1 dismantled

- 1927-1928 Barn #4 built by George (2) Matthews (still in use)
 House #1 burned

- 1929 Orchard enlarged

- 1935 Arthur M. Matthews built large chicken house

- 1936-1937 Barn #3 collapsed

- 1938 Water ditched to garden put in at site of Barn #3

- 1944 Wooden flume abandoned
 Iron Pipeline installed
 Pasture irrigation started

- 1951 { Water ran removed
 { Electricity came in

- 1955 Arthur M. Matthews built house #4 (presently occupied by
 Rick L. Matthews)

- 1971 Ivan Matthews built house #5 (occupies same)

- 1976 Mobile home^{#6} placed by Rick L. Matthews ~~was~~ (Presently
 occupied by Arthur C. Matthews)

- 1980 George (1) Matthews' house #3 was burned

* Two George E. Matthews'

TO: FILE SWR-9

August 12, 1991

FROM: DON KNAUER

CONTACT: MRS. DORIS I. MATTHEWS AND HER SON
BY: DON KNAUER AND DWIGHT FRENCH

We meet with Mrs. Doris I. Matthews and her son. They told us the following:

#3) Amount 0.045 cfs = domestic = 33%
stock = 25%
irrigation = remainder

0.045 x 33% = 0.015	$0.015 / 2 = 0.0075$
0.045 x 25% = 0.011	$0.011 / 2 = 0.0055$
0.045 x 42% = 0.019	
TOTAL = 0.045 cfs / 2.5 acres = 0.009 / 1/2 ac	

$\begin{array}{r} 0.045 \\ - 0.009 \\ \hline 0.036 \end{array}$

They explained the chronological history of the Ivan Matthews place and showed it written out. I suggested they send us a copy.

At present there are three houses on the water system for domestic use. Two houses use began prior to 1909 and one house use began in 1955.

There are two acres of irrigation begun in 1870 with a change in point of diversion and place of use in 1907.

They said the answer to #4) is:

1870 = Domestic, stock, 2.0 acres irrigation
1887 = 0.5 acre irrigation, domestic, stock

Mrs. Matthews' son showed us the diversion points and use. It appears the changes in diversion points' and place of use would not injure any other water rights. The changes took place on their property.

NOTE: See maps by J. Gosson to understand change in place of use and point of diversion.

SWR-0009.001

July 31, 1991

Mrs. Ivan M. Matthews
6987 Coos Bay Wagon Rd
Roseburg, OR 97470

RE: Surface Water Registration

Dear Mrs. Matthews:

We are meeting with all of the Surface Water Registration claimants in the Roseburg-Coquille area the week of August 12 - 16. This is to confirm that we have agreed to meet at your residence on Monday, August 12, at approximately 2:00 p.m.

As I discussed with you on the phone, there are a couple things on your form that may need some clarification.

If you are unable to keep the appointment please contact me to see if we can arrange another meeting time. I can be reached in Salem 378-3739. If I am unavailable, please ask for Don Knauer.

Sincerely,


Dwight French
Adjudications Section



3850 Portland Rd NE
Salem, OR 97310
(503) 378-3739
FAX (503) 378-8130

CO. CO.

COOS DOUGLAS

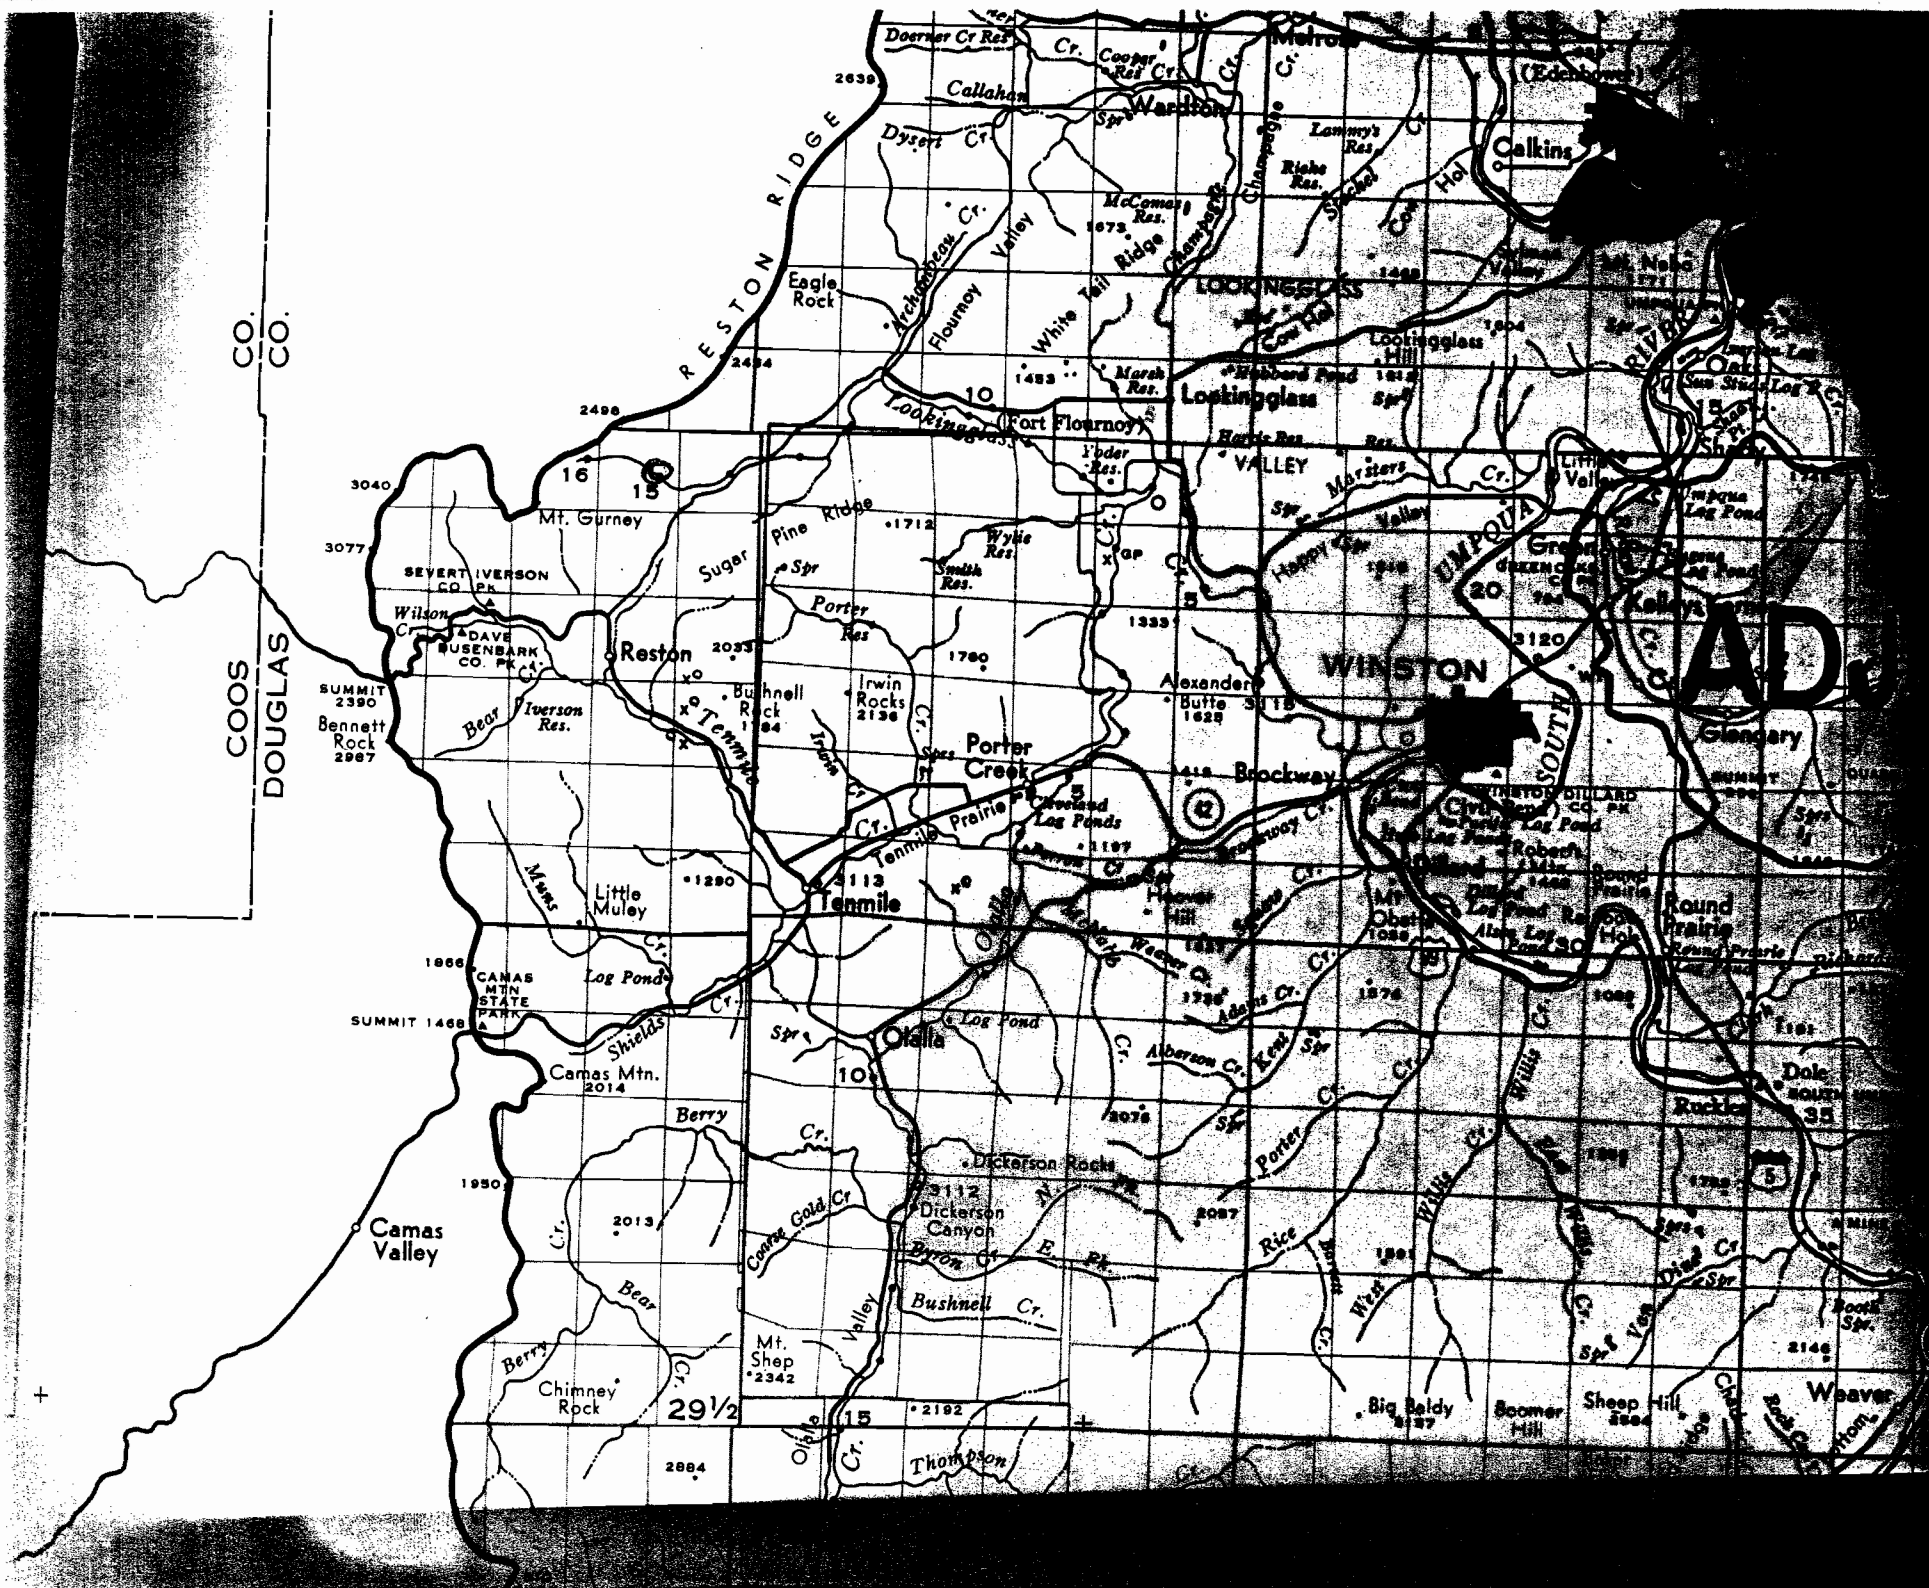

SURFACE WATER REGISTRATION STATEMENT CHECK LIST

1. Date Stamped In ✓
2. Receipt ✓ *yes OK*
3. Payment Entered and Signed ✓
4. Acknowledgement Letter
5. Enter on Water Right Records
 - A. Stream Index ✓
 - B. Plat Cards ✓
6. Review
 - A. Form
 - B. Map *CURT* ✓
 - C. Exhibits
7. Records Check
 - A. Conflicting Rights *AMP 70158*
 - B. Confirming or Conflicting Evidence
8. Letter of Correction, Completion or Acceptance
9. Enter on PARADOX
10. Accepted as OK by WRD

0308j



Water Resources Department

3850 PORTLAND ROAD NE, SALEM, OREGON 97310

PHONE 378-3066

January 26, 1990

Ivan Matthews
6987 Coos Bay Wagon Road
Roseburg, OR 97470

RE: SURFACE WATER REGISTRATION SWR-9

Dear Mr. Matthews:

We have received your surface water registration statement and have numbered it SWR-9. I am enclosing our receipt numbered 60615 for fees paid in the amount of \$430.00.

The application, map and documentation appear to be complete. We are in the process of adopting rules to officially endorse and confirm these claims. We can send you the draft rules in April with a notice of our hearing. We should have final rules by August 1990.

We will inform you if we need anything more to complete our work. Thank you for your patience.

Sincerely,

MARY S. GRAINEY, Manager
Adjudication Section

MSG:jt

Enclosure
0513j

WATER RESOURCES
DIVISIONREGISTRATION STATEMENT CLAIMING A RIGHT TO APPROPRIATE SURFACE WATER
IN THE NAME OF IVAN M. MATTHEWS
SUPPLEMENTAL SHEET #1

General Information Regarding Points of Diversion

Point of Diversion #1 (1870-1907)

The works consisted of an irrigation ditch. Faint traces of the ditch remain, however, its actual location at the point of diversion and its terminus could not be precisely located as they were obliterated. Some evidence of the house exists and several fruit trees (apple and pear) remain alive and standing. No evidence of the barn could be found. Its location is estimated. The ditch had a flat, or nearly flat, bottom approximately 12 inches or less across, and had side slopes of approximately 1:1. The grade was approximately two feet per thousand feet. The capacity was approximately 0.06 ft.³/sec. The use consisted of domestic for one family, irrigation of two acres, and stockwater for an estimated 35 sheep, 6 pigs, 80 chickens and turkeys, 10 cows with calves and 4 horses.

Point of Diversion #2 (1887-1944)

The original works (1887-1929) consisted of a combination of wood flume and ditches. Traces of the ditch remain. No trace of the flume could be found. The flume was flat bottom, approximately eight inches wide, with vertical sides approximately six inches high. The ditch had a flat, or nearly flat bottom of approximately 12 inches or less across, and had side slopes of approximately 1:1. The grade was approximately two feet per thousand feet. The capacity was approximately 0.06 ft.³/sec. The use consisted of domestic for one family, irrigation of four acres, and stockwater. It is also believed that this diversion served a sawmill, its crew, oxen, etc. The system was reconstructed in 1929, eliminating the ditches. The alignment was changed slightly due to the conversion to all flume.

Point of Diversion #3 (1930-1951)

The works consisted of a water ram and 3 inch diameter iron receiving pipe and a 3/4 inch diameter iron delivery pipe. The elevation difference between the ram and the place of use is estimated to be 40 feet, or less. The capacity was approximately 0.01 ft.³/sec. The use consisted of domestic for one family, irrigation of 1/2 acre, and stockwater. The water ram remains on the property, but not at its working location.

JAN 02 1990

WATER RESOURCES DIVISION
IN THE NAME OF IVAN M. MATTHEWS
SUPPLEMENTAL SHEET #2

General Information Regarding Points of Diversion

Point of Diversion #4 (1932-1955)

The works consisted of an irrigation ditch. No traces of the ditch remain. The ditch had a flat, or nearly flat, bottom approximately 12 inches or less across and had side slopes of approximately 1:1. The capacity is estimated to have been 0.02 ft.³/sec. The use consisted of the irrigation of approximately 1/2 acre.

Point of Diversion #5 (1944-1971)

The works consisted of a one inch gravity pipeline. The grade was approximately 50 feet per 1000 feet. The capacity was approximately 0.03 ft.³/sec. Portions of the pipeline remain. The use consisted of domestic, irrigation of four acres, and stockwater.

Point of Diversion #6 (1951-Present)

The works consist of a directly connected 3/4 horsepower electric motor and centrifugal pump. This works replaced the water ram at the same location. The use consists of domestic for three families (one family from 1951 to present, two families from 1971 to present and three families from 1976 to present), and stockwater. A 3/4 inch P.V.C. pipe serves as the delivery system. The maximum elevation difference between the pump and place of use is approximately 45 feet.

Pump Brand: Goulds	Motor Brand: Goulds
Type: Centrifugal	Model #: C48K2DB11A4
Model #: JL07N	Serial #: 7B84
Serial #: 739900	Horsepower: 3/4
Intake: 1 1/2"	R.P.M.: 3450
Discharge: 3/4" x 700'-800'	
Suction Head: 4 ft.	
Discharge Head: 45 ft.	
Operating Pressure: 40 psi (estimated)	

The capacity of the pumping system is approximately 0.205 ft.³/sec.

JAN 02 1990

WATER DIVISION
IN THE NAME OF IVAN M. MATTHEWS
SUPPLEMENTAL SHEET #3

General Information Regarding Points of Diversion

Point of Diversion #7 (1951-Present)

The works consist of a 2 horsepower electric motor and centrifugal pump. A 1 1/2 inch P.V.C. pipe serves as the delivery system. The maximum elevation difference between the pump and the place of use is approximately 80 feet. The use consists of the irrigation of 4.3 acres.

Pump Brand: Unknown	Motor Brand: Sta-Rite
Type: Centrifugal	Model #: LSG
Model #: Unknown	Serial #: F62
Serial #: Unknown	Horsepower: 2.0
Intake: 1 3/4"	R.P.M.: 3450
Discharge: 1 1/2" x 1000'±	
Suction Head: 5 ft.	
Discharge Head: 75 ft.	
Operating Pressure: 40 psi (estimated)	

The system operates up to eight model 30 Rainbird sprinklers with 3/32" nozzles at a setting. Several hose bibs are also served by the system.

The capacity of the delivery system is approximately 0.077 ft.³/sec.
The capacity of a sprinkler set (8 sprinklers) is approximately 0.041 ft.³/sec.
The capacity of a sprinkler set and hosebibs is approximately 0.074 ft.³/sec.

Point of Diversion #8 (1971-Present)

The works consist of a 1/3 horsepower electric motor and centrifugal pump. A 3/4 inch P.V.C. pipe serves as the delivery system. The maximum elevation difference between the pump and the place of use is approximately 20 feet. The use consists of the irrigation of 1/2 acre of noncommercial lawn or garden.

Pump Brand: Goulds	Motor Brand: A.O. Smith
Type: Centrifugal	Model #: C48H2DA12C1
Model #: Unknown	Serial #: L70
Serial #: Unknown	Horsepower: 1/3
Intake: 3/4"	R.P.M.: 3450
Discharge: 3/4"	
Suction Head: 4 ft.	
Discharge Head: 56 ft.	
Operating Pressure: 40 psi (estimated)	

The capacity of the delivery system is approximately 0.014 ft.³/sec.

JAN 02 1990

WATER DIVISION

REGISTRATION STATEMENT CLAIMING A RIGHT TO APPROPRIATE SURFACE WATER
IN THE NAME OF IVAN M. MATTHEWS
SUPPLEMENTAL SHEET #4
General Information Regarding Points of Diversion

Point of Diversion #9 (1976-Present)

The works consists of a one horsepower electric motor and centrifugal pump.

A 3/4 inch P.V.C. pipe serves as the delivery system. The maximum elevation difference between the pump and the place of use is approximately 60 feet. The use consists of the irrigation of 1/2 acre, of noncommercial lawn or garden.

Pump Brand: Scot	Motor Brand: Baldor
Type: Centrifugal	Model #: JL1309A
Model #: GDE-222	Serial #: S79
Serial #: 1030	Horsepower: 1.0
Intake: 1 1/2"	R.P.M.: 3450
Discharge: 1" to 3/4"	
Suction Head: 5 ft.	
Discharge Head: 55 ft.	
Operating Pressure: 40 psi (estimated)	

The capacity of the delivery system is approximately 0.043 ft.³/sec.

Footnote: On the basis of interviews with members of the Matthews family and others, it appears that continuous watering, or irrigation of garden plants and flowers occurred in close proximity to the houses, dating from about 1904. Hence, a claim for one domestic

including up to 1/2 acre of noncommercial lawn and garden, is being submitted.

RECEIVED

JAN 02 1990


REGISTRATION STATEMENT CLAIMING A RIGHT TO APPROPRIATE SURFACE WATER
IN THE NAME OF IVAN M. MATTHEWS
SUPPLEMENTAL SHEET #5
Chronological Order of Water Use

Year	Domestic	Stockwater	Irrigation
1870-1887	1 family	0.005	2.0 acres
1887-1894	2 families	0.005	2.5 acres
1894-1904*	2 families	0.005	2.5 acres
1904-1907	2 families	0.005	2.5 acres
1907-1927	1 family	0.005	2.5 acres
1927-1929	1 family	0.005	2.5 acres
1929-1930	1 family	0.005	2.5 acres
1930-1937	1 family	0.005	2.5 acres
1937-1938	1 family	0.005	2.5 acres
1938-1944	1 family	0.005	4.5 acres
1944-1951	1 family	0.005	4.5 acres
1951-1955	1 family	0.005	4.5 acres
1955-1971	2 families	0.005	4.3 acres
1971-1976	3 families	0.005	4.3 acres
1976-1980	4 families	0.005	4.3 acres
1980-1989	3 families	0.005	4.3 acres

*Sawmill also operated during this time period.

RECEIVED

JAN 02 1990

WATER RIGHTS SECTION
IN THE NAME OF IVAN M. MATTHEWS
SUPPLEMENTAL SHEET #6
CLAIM

Use	Acres	Amount (C.F.S.)	Location	Priority Date
Irrigation	2.0	0.025	SE4, SE4 Sec 2	1870
Stockwater		0.005	SE4, SE4 Sec 2	1870
Domestic, including up to 1/2 acre noncomm. lawn & garden		0.01	NE4, SE4 Sec 2	1870
Irrigation	<u>0.5</u>	<u>0.005</u>	SE4, SE4 Sec 2	1887
Total	2.5	0.045		

RECEIVED

JAN 02 1990

WATER RESOURCES DIV.

REGISTRATION STATEMENT CLAIMING A RIGHT TO APPROPRIATE SURFACE WATER
IN THE NAME OF IVAN M. MATTHEWS
SUPPLEMENTAL SHEET #7
General Information Regarding Use and Places of Use

IRRIGATION

Maps #1 through 5 show irrigated parcels as being rectangular in shape. Some variation to the rectangular shapes may have actually existed. Emphasis was placed in attempting to determine areas rather than actual shapes, as little physical evidence remained in most cases.

STOCKWATER

The species and number of animals have varied, however the aggregate at any given time would not consume more than the minimum stockwater allocation. With the exception of map #12, stockwater locations are intended to portray a history of stockwater use. Physical evidence of actual locations no longer exists at some locations.

DOMESTIC, INCLUDING UP TO 1/2 ACRE OF NONCOMMERCIAL LAWN OR GARDEN

At least one garden for home consumption has served the farm continuously from 1870 to the present time.

Miscellaneous additional outbuildings at various locations have also served the farm. Some of their locations either are not known, or not shown on the application maps for purposes of clarity.


RECEIVED

JAN 02 1990

WATER RIGHTS
DIVISION

REGISTRATION STATEMENT CLAIMING A RIGHT TO APPROPRIATE SURFACE WATER
IN THE NAME OF IVAN M. MATTHEWS

The information contained on the foregoing pages has been assimilated from the results of interviews with members of the Matthews' family and on-site inspections. It represents a history of water use based upon the best information available and is true and accurate to the best of my knowledge.

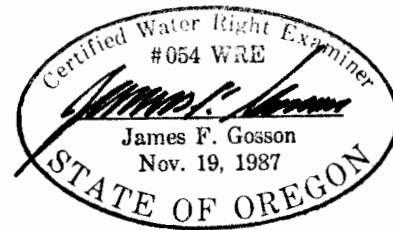

December 26, 1989

THE UNITED STATES OF AMERICA

Homestead Certificate No. 2609

Application 5-2-1892

To all to Whom these Presents shall Come—GREETING:

WHEREAS, There has been deposited in the General Land Office of the United States a Certificate of the Register of the Land Office at Roseburg Oregon whereby it appears that, pursuant to the Act of Congress approved 30th May, 1862, "To Secure Homesteads to Actual Settlers on the Public Domain," and the acts supplemental thereto, the claim of George V. Matthews

has been established and duly consummated, in conformity to law, for the East half of the South west quarter and the South half of the South East quarter of section two in township twenty eight South of Range Eight west of the Willamette Meridian in Oregon containing one hundred and sixty acres

according to the Official Plat of the Survey of the said Land, returned to the General Land Office by the Surveyor General.

NOW, KNOW YE, That there is, therefore, granted by the United States unto the said George V. Matthews the tract of land above described:

TO HAVE AND TO HOLD the said tract of Land, with the appurtenances thereof, unto the said George V. Matthews and to his heirs and assigns, forever; subject to any vested and accrued water rights for mining, agricultural, manufacturing or other purposes, and rights to ditches and reservoirs used in connection with such water rights, as may be recognized and acknowledged by the local customs, laws and decisions of Courts, and also subject to the rights of the proprietor of a vein or lode, to extract and remove his ore therefrom, should the same be found to penetrate or intersect the premises hereby granted, as provided by law.

IN TESTIMONY WHEREOF, I, Benjamin Harrison President of the United States of America, have caused these Letters to be made Patent, and the Seal of the General Land Office to be hereunto affixed.

Given under my hand, at the City of Washington, the Third day of June, in the year of our Lord one thousand eight hundred and ninety one, and of the Independence of the United States the one hundred and fifteenth

BY THE PRESIDENT: Benjamin Harrison
By Ellen Macfarland Sec. Secretary.

Recorded Vol. 16 Page 316 J. M. Townsend Recorder of the General Land Office.

Filed for Record at 10 o'clock A. M. Nov 30. A. D. 1892, and recorded at the request of

By George V. Matthews
J. L. Chapman Deputy. W. H. Benson
W. H. Benson

THE UNITED STATES OF AMERICA,

Certificate

No. 4637

To all to whom these presents shall come, Greeting:

Whereas A. A. Matthews of Douglas County Oregonhas deposited in the General Land Office of the United States a Certificate of the Register of the Land Office at Roseburg Oregon whereby it appears that full payment has been made by the said A. A. Matthews

according to the provisions of the Act of Congress of the 24th of April, 1820, entitled "An Act making further provision for the sale of the Public Lands," and the acts supplemental thereto, for the lot numbered one, the south east quarter of the north east quarter and the north half of the south east quarter of section two, in township twenty eight south of range eight west of Willamette Meridian in Oregon containing one hundred and fifty eight acres and sixty three hundredths of an acre.

according to the Official Plat of the Survey of the said Lands, returned to the General Land Office by the Surveyor General, which said Tract has been purchased by the said A. A. MatthewsNow know ye, That the United States of America, in consideration of the premises, and in conformity with the several Acts of Congress in such case made and provided, have given and granted, and by these presents do give and grant, unto the said A. A. Matthewsand to his heirs, the said Tract above described: To have and to hold the same, together with all the rights, privileges, immunities, and appurtenances, of whatsoever nature thereunto belonging, unto the said A. A. Matthews and to his

heirs and assigns forever; subject to any vested and accrued water rights for mining, agricultural, manufacturing, or other purposes, and rights to ditches and reservoirs used in connection with such water rights, as may be recognized and acknowledged by the local customs, laws, and decisions of courts, and also subject to the right of the proprietor of a vein or lode to extract and remove his ore therefrom, should the same be found to penetrate or intersect the premises hereby granted, as provided by law.

In testimony whereof, I, Chester A. Arthur, President of the United States of America, have caused these letters to be made Patent, and the Seal of the General Land Office to be hereunto affixed.Given under my hand, at the City of Washington, the twentieth day of April, in the year of our Lord one thousand eight hundred and eighty two, and of the Independence of the United States the one hundred and sixth.

BY THE PRESIDENT:

Chester A. Arthur

By

M. H. Book

Secretary.

J. W. Leach

Recorder of the General Land Office.

Recorded, Vol. 9, Page 384

RECEIVED

JAN 02 1890

WATER RESOURCES DEPT.
S. FM. OREGON

THE UNITED STATES OF AMERICA.

Certificate No. 4637

To all to Whom these Presents shall Come—GREETING:

WHEREAS, *A. A. Mathews of Douglas County Oregon*

has deposited in the General Land Office of the United States a Certificate of the Register of the Land Office at *Roseburg Oregon* whereby it appears that full payment has been made by the said *A. A. Mathews*

according to the provisions of the Act of Congress of the 24th of April, 1820, entitled "An Act making further provisions for the sale of the Public Lands," and the acts supplemental thereto, for the *lot described*

one and the South East quarter of the North east quarter and the North half of the South East quarter of Section two in Township Twenty eight south of Range eight west of Willamette Meridian in Oregon containing one hundred and fifty eight acres and sixty three hundredths of an acre

RECEIVED

JAN 02 1990

WATER RESOURCES
SALEM, OREGON

according to the official Plat of the Survey of the said Land, returned to the General Land Office by the Surveyor General, which said Tract has been purchased by the said *A. A. Mathews*

NOW KNOW YE, That the United States of America, in consideration of the premises, and in conformity with the several Acts of Congress in such case made and provided, have GIVEN and GRANTED, and by these presents do GIVE and GRANT, unto the said *A. A. Mathews*

and to *his* heirs, the said Tract above described.

TO HAVE AND TO HOLD the same, together with all the rights, privileges, immunities and appurtenances, of whatever nature, thereunto belonging, unto the said *A. A. Mathews*

and to *his* heirs

and assigns, forever; subject to any vested and accrued water rights for mining, agricultural, manufacturing or other purposes, and rights to ditches and reservoirs used in connection with such water rights, as may be recognized and acknowledged by the local customs, laws and decisions of Courts, and also subject to the right of the proprietor of a vein, or lode, to extract and remove his ore therefrom, should the same be found to penetrate or intersect the premises hereby granted, as provided by law.

IN TESTIMONY WHEREOF, I,

Charles A. Arthur

President of the United

States of America, have caused these Letters to be made Patent, and the Seal of the General Land Office to be hereunto affixed.

Given under my hand, at the City of Washington, the *twentieth* day of *April*, in the year of our Lord one thousand eight hundred and *Eighty two*, and of the Independence of the United States the one hundred and *Seventy*

BY THE PRESIDENT:

Charles A. Arthur

By

H. H. Cook

Secretary.

Recorded Vol.

9

Page

384

Filed for Record at

at

M.

Nov 30th

A. D. 1892 and recorded at the request

of

J. D. Chapman

Deputy.

W. M. Benson

Asst. Clerk

From Abstract Compiled
for George E. Matthews, Est.

RECEIVE

JAN 02 1990

George E Matthews (sg Geo E
Matthews) Mary E Matthews (sg
Mamie Matthews) his wife,

Grantor

To

William O Matthews,

Grantee

Character of Instrument,

Warranty Deed,

Dated July 23, 1888,

Recorded July 31, 1888,

In Book 20 of Deeds, page 270

Consideration, \$200.00,

Signatures are Scrolled not sealed

Witnessed by Leonard Buell,
Mary Jones,

Acknowledged on July 23, 1888, before Leonard Buell N P Ore.
Seal affixed,

Granting words, Convey revise release and forever quit claim.

Covenant, Unusual.

Description and Remarks:

All the following described premises situated in
Douglas County, State of Oregon, viz: The east half of north
east quarter and all that part of the north half of the south
east quarter lying north and east of Rock Creek and all in Sec
2 in Township 28 South Range 8 West Willamette Meridian and all
the privileges and appurtenances thereto belonging,

To have and to hold the above described premises subject to
a certain mortgage held by George Haines for the sum of three
hundred dollars to the said Wm O Matthews his heirs and assigns
for his and their use and behoof forever.

Shall warrant and defend the same to the said William O.

Matthews his heirs and assigns forever against the lawful claims
and demands of all persons claiming by through or under me but
against none other.

FROM THE OFFICE OF
DOUGLAS COUNTY ABSTRACT COMPANY
ROSBURG, OREGON



UNITED STATES OF AMERICA,

Grantor

To

George E Mathews,

Grantee

United States Patent.

Dated June 3, 1891,

Recorded November 30, 1892,

In Book 25 of Deeds, Page 91

Seal of the G. L. O. Affixed.

Certificate No. 2659

Issued by Authority of the Act of Congress of May 20, 1862,
and the acts supplementary thereto.

Executed by the President, Benjamin Harrison,

By the Secretary, Ellen Macfarland, Asst.

By

J M Townsend,

Recorded Vol. 6 page 310,

Recorder of the General Land Office

Description:

The claim of George E Mathews has been established and
duly consummated in conformity to law for the East half of the
South west quarter and the south half of the south east quarter
of section two in Township twenty eight south of range eight west
of the Willamette Meridian in Oregon, containing one hundred and
sixty acres, according to the official plat of the survey of the
said lands returned to the General Land Office by the Surveyor
General.

Subject to any vested and accrued water rights etc.



RECEIVED
APR 20 1882
RECORDED NOV 30 1892

1880

RECEIVED

UNITED STATES OF AMERICA,
Grantor

To

A A Mathews,

Grantee

United States Patent.
Dated April 20, 1882,
Recorded November 30, 1892,
In Book 25 of Deeds, Page 526
Seal of the G. L. O. Affixed.
Certificate No. 4637

Issued by Authority of the Act of Congress of April 24, 1820,
and the acts supplementary thereto.

Executed by the President, Chester A Arthur,
By the Secretary, W H Crook,

By

S W Clark,

Recorded Vol. 9 page 384

Recorder of the General Land Office

Description:

The lot numbered one and the South east quarter of
the North east quarter and the North half of the South east quar-
ter of Section Two in Township twenty eight South of Range eight
west of Willamette Meridian in Oregon, containing one hundred and
fifty eight acres and sixty three hundredths of an acre, accord-
ing to the official plat of the survey of the said land, returned
to the General Land Office by the Surveyor General,
Subject to any vested and accrued water rights, etc.



RECEIVED

A A Matthews (fails to state whether married or single.)

Grantor

To

George E Matthews,

Grantee

Character of Instrument,

Warranty Deed

Dated August 31, 1885,

Recorded September 8, 1885,

In Book 16 of Deeds, page 482-3

Consideration, \$400.00,

Signatures are Sealed,

Witnessed by Leonard Buell,
Josirus West,

Acknowledged on August 31, 1885,, before Leonard Buell, N P Ore.

Granting words, Convey release and forever quit claim. Seal affixed,

Covenant, Unusual.

Description and Remarks:

All that tract or parcel of land situated in Douglas County aforesaid and described as follows, viz: The North half of South East quarter and east half of the north east quarter of section Two in Township twenty eight south range eight west and containing one hundred and fifty eight and sixty three hundredths of an acre

Except a certain mortgage held by Elijah F Whistler and that I will and my heirs executors and administrators shall warrant and defend the same to the said George E Matthew his heirs and assigns forever, against the lawful claims and demands of all persons claiming by through or under me but against none other.



p. 2
get out. can not walk at all will
out a cane. the lameness
has all been in my right
side from my hip down.
until yesterday morning. when
I got up I could not step
on my left foot. all day
yesterday my foot cramped
right in the top. it sure
hurts. I just have to
holler when the cramp
comes. when I even sneeze
or cough. it hurts my
right leg. I cant see
what makes it well
I sure am some cripple.
The boys are going to
Butcher & Hugel hogs
3 will weigh 250, one
300. Dad has been with
us all fall. the school
marm and son stayed
here last night.

Written from Reston by George E.
Matthews. widow. (Past Officer located at
Lookingglass.)

RECEIVED

JAN 02 1990

WATER RESOURCES DEPT.
SALEM, OREGON

Looking Glass
Dec 7th 1921

Dear Girls

Well it has
been 3 weeks since I got
your last letter. why dont
you write. I have sure looked
for a letter was afraid you
all were sick. I called Sunday
at the Harris Station they
said you were all well. it sure
helped me a whole lot. I have
written 2 letters. this is the
third. since I got Ruth.
it was written the 14 of Nov.
well I sure am a cripple.
can hardly get in bed and
when I get in bed can hardly

p. 4
did you get your
photo. I sent them
3 week ago. how is
Archie. Joe is waiting
to go to the mail post
love to all. from
mamma

RECEIVED

JAN 02 1990

WATER RESOURCES DEPT.
SALEM, OREGON.

p. 3
Gramma is all right,
but never comes near.
Effa was up Sunday
she said that she never
asked no one but just
come and told Frank
to come and get her.
Amy has been sick
for a month is in
bed most of the time
if she dont croak be.
she will be all right
in 7 or 8 months.
Maggie is feeling fine.
Otha and Hilene are
batching. Amy and
Cathleen are out. Hells.
Dall live right close
to Arthur and mag.
Clara is working at
Harry Winstons. Rose
is his address. Ruth you must
write to him

Written by Geo E. Matthews' widow
To daughter Lillian

Mamie
(Mamie
Dec'd 7-28-22)

Looking Glass
May 23
My Dear Daughter
We received your letter a few
days ago, was very glad to hear
from you, and glad you both were
well. I have been quite sick,
down in bed with Ponroliter,
am about all right again,
but have not much strength,
we sure having some rainy weather,
but I guess it has cleared up
at last, it sure has put the boys
behind with there spring work,
have not got all our garden plants
yet, fore planting garden today

Joe wanted me to have Arch look
around and see what would be
the chance of getting work for the
boys and team or teams on the
road or any where, and what the
wagger would be, my the mountain
road is sure bad. The ^{Wagon} trailer
all the cars up on this side,
charged \$10 for hauling them
up. Some days he hauls up 3
a day, if you start out
soon let us know and we
will meet you down on the
other side with team, will be
glad when Ruth gets home
am not very able to do all
this work, my side feels better every
day.

13
but am not stout in that side, I
give out in that shoulder and arm.
When I do much work, the same
strawberries will soon be ripe,
the vines are loaded, have out
about 23 hundred of ever bearing
strawberry. some we just put on
and some we have out for a month.
the first we put out are loaded with
berries all ready, some have 24
berries on them, and only been
out a month, have 10 little calves.
have lost a good many of the
Turkeys, have about 70 or 80
little chickens. you must not
work too hard you will make
your self sick, when you

4
make a dress, don't try to make
it in a day, you know you are
working by the week, not by the
dress, what wages do you get?
I would not work for less than
\$5 per week, you know it is not
what you do but what you know
it's what you should get pay
for, I think the law requires
all public work to pay not less than
20 per week, I see last week where
several business men in Roseburg
^{last week} were pulled for paying less.

Colleen Fitzgerald is
very low in the Hospital in
Roseburg, has been in there for

Written by Geo. E. Matthews' widow, Mamie,
while living at Reston.

(Post Office at)
Looking Glass
Oct 5th 1921

Dear Girls,

Well I got Lilly's
Letter, was very glad to hear from
you all, and glad you all were well
all well but my self, and I am
still lame so I can hardly
walk. The little boys are in
school, the big boys a gathering
corn. Effa spent the day here
Sunday, she will soon leave.
Beta has quit, the straw
crop is over, although I could
pick 2 or 3 gallon in my
patch if I were able.
Brumfield's trial starts
to day. I sure would like
to attend, did your tomato
carry all right. I will finish

filling my 5 gallon jar with
Tomato preserves that will
be ~~some~~ ^{some} preserver want it?

Ralph wrote last night to
Ruth but I cant find
the letter, suppose he took it
to school. he was afraid for
me to read it.
Well it is about mail time
and I will have to ~~hop~~ hobble
over to the mail post, or my
mail will go back. Love
to all from
Mamie.

P.S. will send the cows
in a few days

Grandma
Juan M. Matthews
Mar 6, 8, 13
age 63 years



Looking Glass, Oregon

Cost = 40c

Looking Glass, Oregon

(Notation made from Records at Museum)

Douglas County Persons Engaged in
Forest Products Industries 1850 to 1900 compiled
by Barbara Vatter

p. 10
1890¹⁰ 1894 Beston Moved Sawmill to George Matthews
old home.

RECEIVED

JAN 02 1990

WATER RESOURCES DEPT.
SALEM, OREGON

Portland, then worked his way south finally landed in Camas Valley.

Alston Martindale, William P. Day, and Abraham Patterson were the first three to locate and take up donation land claims. Alston's first house was a log cabin by the middle fork of the Coquille River. This house later served as the valley's first school, (1861).

Alston married Nancy Katherine Fitzhugh Shambrook on September 1, 1855, at Garden Valley, Douglas County. Nancy had one daughter, Austria Shambrook.

As a protection against the Indians, Alston built his second home into a fort with a stockade 100 feet square. All the settlers came to the fort during Indian raids. After the fort burned, Alston built a third house where he and Nancy kept the first stage station. Alston served as postmaster from June 12, 1879, until December 3, 1898. He also served in Company B, 2nd regiment Oregon Mounted Volunteers, under Captain Nolan and Captain Buoy.

The Martindale children were: Ella Mira (1857-1864), Tulla Ann (1859-1936), Henry (1861-1914), Robert Lee (1863-1951), William Alston (1866-1888), Nettie Jane (1868-1900), Nancy Violet (1871-1930), James Dickey (1874-1946), Rolla (1877-1911).

Still living on a part of the old donation land claim are: a granddaughter and her husband, Welcome and James Combs; a great-granddaughter and her husband, Sharon and Robert Moore; and two great-grandsons, Bradley Allen and Bret Eugene Ross. Martindale Combs

John Matthews was born in 1750 in the New England area of the United States of America. He married Rachel Benedict on October 28, 1772 in Danbury, Connecticut. According to the Benedict Genealogy, Rachel was the daughter of John and Lydia Gregory Benedict. They had thirteen children including William and Jeremiah, who was the youngest. John served in the Revolutionary War and then moved to the area around Burlington, Vermont where he died well advanced in years. Rachel died there in 1797.

Jeremiah Matthews, son of John and Rachel, was born August 24, 1793 possibly at Williston, Vermont and died January 1, 1860 at Stowe, Vt. He was buried at the Matthews lot at Underhill Flats, Vt. The marker is still there and in good condition.

Jeremiah married Nancy Farnum (Farnham) about 1822 in Williston, Vermont. Nancy was born in 1803 at Waterbury, Vermont and died on January 25, 1873 at the age of 70 years. She was buried beside Jeremiah, according to the story in the Genealogical and Family History of the State of New Hampshire, Volume III, 1908.

Jeremiah was left motherless at the age of three and was given by his father to be cared for by Linus Atwater, a tavern keeper at Williston, Vermont with whom he lived until he was 28 years of age. He then became a partner with his brother, William, in a retail Hat and Fur Store in Burlington, Vermont. He later went into farming for the remainder of his life.



Arthur Matthews Family, 1938: Front, L to R: Arthur, Virginia, Elaine, Margaret. Back Row: Ivan, Lillian and Dale.

Jeremiah served in the War of 1812 in Tyler's 3rd. Regiment of Vermont Militia, Capt. Roswell Morton's Co. Jeremiah and Nancy had nine children, the eldest being Albert Atwater followed by Mary, Rachel, George Benedict, Byron Dexter, Jane E., Lyman, Ellen M. and Martha.

ALBERT ATWATER MATTHEWS, son of Jeremiah and Nancy, was born November 11, 1822 near Williston, Chittenden County, Vermont.

Albert traveled west over the Oregon Trail in 1850 and arrived in Portland, Oregon Territory, on October 4, 1850. He kept a diary of his journey which has been lost, possibly in 1927 at the time the old Matthews family home was destroyed by fire in Reston, Oregon.

Albert settled on Donation Land Claim #832 on November 8, 1852 in the North Umpqua area adjacent to the land later to become Donation Land Claim of Elijah F. Whisler.

In the 1960's Douglas county located the Whistlers Bend County Park on the site of the Elijah F. Whisler's donation land claim.

Albert married Mary Jane Guild on June 8, 1853 in Washington county, Oregon Territory. Mary Jane and her twin sons died at their birth on August 4, 1854. It is assumed that they were buried in the area.

Records show that Albert was the clerk of the Oak Creek School District in 1854. Albert sold his claim and purchased land in the Reston area. He is mentioned as the man to organize the first Sunday School at Reston. He is listed in "The History of Southern Oregon" by A.G. Walling in 1884 as follows: "Albert A. Matthews lives in Flournoy Valley; is a merchant and farmer; was born in Williston, Chittenden Co., Vermont; was married in 1859 to Alice B. Whisler."

Flournoy Valley lies adjacent to the now Reston area at the foot of the Coast Range Mountains. Albert was an assessor for the county, a schoolteacher, a merchant and farmer. He delivered meat on a regular route, door to door, during the harvest season. When the railroad through Roseburg was being built he had a tent Store and moved it along with the progress of the railroad. On September 25, 1859 Albert married Barbry Alice Whisler, daughter of Elijah F. Whisler and Sarah Van Buskirk Whisler. (See the Whisler story elsewhere in this book.) Albert Atwater Matthews died April 8, 1900. His wife, Barbry Alice Matthews, died February 5, 1927.

They are buried in the Lookingglass Cemetery.

Albert Atwater Matthews and his wife, Barbry Alice had five sons: Frank Lyman, George Edwin, Albert Byron, William Oscar, and Elijah Melvin. Their children:

Frank Lyman Matthews — Oct. 22, 1860, Mar. 27, 1901, wife Harriet Andrews, Nov. 26, 1864, June 26, 1938; Children — Effa Matthews — Feb. 15, 1891, Dec. 20, 1978, husband Emanuel LeFebre; Una Alice Matthews — Sept. 17, 1892, July 10, 1908; Ruby Anita Matthews — Jan. 12, 1894, Mar. 11, 1962, husband Clay Thomas Ulam — Sept. 6, 1892, Oct. 26, 1965; Grace Matthews — March 15, 1895, Feb. 22, 1977, husband William Frank Toll; Elizabeth Pearl Matthews — Apr. 28, 1896,

husbands Dick Ulam, Almer Meserve, Peter Ulam, 1946, 1976; Albert Lafayette Matthews — May 14, 1897, Aug. 16, 1973; wife Neva Blanche Pickens — Sept. 7, 1902, Jan. 23, 1979; Elsa Faye Matthews — Jan. 18, 1899, Apr. 24, 1963, husband Ray E. Allen; Frank Lyman Matthews — Mar. 13, 1901, Sept. 18, 1979, wife Ruby O. Weitz — Sept. 6, 1909; George Edwin Matthews — Jan. 21, 1862, Sept. 30, 1908, wife Mary Elizabeth Woodin — Dec. 20, 1862, July 28, 1922; Children — Otto Oscar Matthews — Sept. 21, 1887, Feb. 13, 1980, wife Amy Ora Conn — May 11, 1895, Oct. 23, 1961; George Edwin Matthews — Dec. 8, 1888, 1970, wife Zelma May Finch — Mar. 3, 1906, May 18, 1966; Arthur Melvin Matthews — Nov. 26, 1890, wife Margaret Arvilla Conn — Oct. 10, 1897, Apr. 6, 1974; Lillian Matthews — May 15, 1892, husband Archie L. Bushnell — Dec. 17, 1956; Albert Atwater Matthews — Nov. 28, 1895, July 3, 1971, wife Grace Bonnin; Claude Matthews — April 8, 1897, Aug. 1971, wife Hattie Josephine; Joseph Shirley Matthews — Nov. 1, 1899, wife Edwina Harriet Perrin — Mar. 23, 1903; Ruth Matthews — Feb. 9, 1904, Apr. 9, 1929; William Wallace Matthews — Feb. 1, 1906, wife Edith Minnie Ely; Ralph Matthews — Sept. 22, 1907, Oct. 1979, wife Buelah Emert; Albert Byron Matthews — Jan. 20, 1864, Sept. 25, 1883; William Oscar Matthews — July 30, 1865, May 11, 1948, wife Vina Jane Tompkins — Apr. 19, 1868, Apr. 14, 1933; Children — Alice Myrtle Matthews — Dec. 6, 1890, Dec. 27, 1977, husband Elmer Holverstott — Sept. 20, 1884, Apr. 22, 1957; Mary Edith Frances Matthews — May 19, 1896, husbands Charles H. Smith, P.J. Defoxis Lundgren; William Herbert Matthews — Aug. 19, 1898, Jan. 24, 1958, wives Issie Brown, Olive Trowbridge; Ralph Edwin Matthews — Sept. 11, 1899, 1928; Elden Matthews — Oct. 19, 1908, wives Edna May Vulgamore, Lynn; James Austin Matthews — May 8, 1910, wife Mildred Viola Vulgamore — Jan. 26, 1913, Dec. 23, 1980; Elijah Melvin Matthews — July 13, 1868, 1942, wife Stella Caroline Inman; Child — Ernest Melvin Matthews — Nov. 16, 1896, wife Ethel.

Albert Atwater Matthews and Barbry Alice Matthews had twenty-five grandchildren and fifty-one great grandchildren.

Cousins Rosalie Viola Matthews Flint and Alice May Matthews Tesh, daughters of James Austin and Mildred Viola Matthews, have compiled and printed a Family History Book: "Our Matthews, Van Buskirk and Whisler Ancestors." The book was printed

RECEIVED

JAN 02 1990

by Instant Press, Wenatchee, Washington. The book was copyrighted by Rosalie V. Flint, 1981. Limited Edition. Much of the data in the foregoing story was taken, by permission, from the above mentioned Family History Book.

Albert Atwater Matthews History was submitted by Lillian Matthews Kenworthy, great granddaughter of Albert Atwater Matthews, granddaughter of George E. Matthews, and daughter of Arthur Melvin and Margaret Conn Matthews.

NATIVE OF DOUGLAS COUNTY

Matthews, Arthur M., born November 26, 1890, at what they called the old Mountain House, now known as Iverson Park. At that time it was a stage stop and his Grandma Wilson operated the telegraph there.

He was the third in a family of ten children born to George Edwin and Mary (Mamie) Elizabeth Wooden Matthews. Grandma Wilson and Grandma Gurney assisted in his birth.

Remembers living in Coos County for a couple of winters then returned to homestead place at Reston. They farmed and made posts and shakes — there was a good market for them at that time. A sawmill was put in and oxen were used to log with, later they used mules.



George Edwin Matthews

Father died when Arthur was 17. He helped out at home until he was twenty one. At that time he rented the McClintock place, a nearby farm and raised veatch hay, oats, wheat, turkeys, sheep, pigs and cattle — farmed with two and three horse teams. During World War I the Army purchased three horses from him at \$160. apiece.

Married Margaret (Maggie) Conn on October 15, 1917. She was a sister to brother Otto's wife, Amy. They were married in the house at Melrose built by her brother, H.P. Conn, from lumber obtained at the mill on the Matthews' place at Reston.

They had five children, Lillian, Dale, Ivan, Elaine, and Virginia. Lived and farmed in the Melrose, Roseburg, Umpqua, and Reston area. Lost their home at Umpqua to fire in

1922. Rebuilt by Cleve Miller with assistance from Otto Mohr and George Gurney.

They were renting and farming the land where the State Office Building now stands when their daughter, Lillian, was born. He raised broccoli for many years there and at Melrose and Umpqua. They cured their own bacon and hams from animals they raised. Arthur worked in prune dryers during harvest season for forty years. After son, Ivan, was discharged from the Navy, they bought a 9N Ford Tractor and this lightened the work load considerably. Son, Dale, also served in the Navy.

The family enjoyed trips to the coast, family and community gatherings, hunting trips to Eastern Oregon, and trips back over the mountain from their place to look after their cattle, grazing on government land.

A highlight in later years was an auto trip to Fairbanks, Alaska, to visit Dale and family. They were accompanied by Ivan, Lillian, Elaine and families, taking camping equipment and three cars.

Wife died in 1974 at age 76 and is buried in Lookingglass Cemetery. Arthur lived with Ivan and family for over a year and spent time also with Virginia and family for while as he was confined to a wheelchair from the crippling effects of arthritis and related problems. He is now 91 years old and living at the Grandview Care Home in Roseburg. Mrs. Ivan Matthews

FRANK LYMAN MATTHEWS FAMILY

Frank Lyman was the oldest of five sons born to Albert Atwater Matthews and Barbary Alice Whisler. He was born October 22, 1860 in Douglas County, Oregon and died March 27, 1901, at the Matthews home place in Reston. He was buried in the Lookingglass, Oregon, Cemetery.

He married Harriet Jane Andrews in 1889 or 1890 in Virginia City, Nevada.

After being away from Douglas County for some years, Frank had come back to help his mother take care of the place. Frank died the year after his father, and Harriet was left with eight children, the oldest ten and the youngest three weeks. See the book, "Our Matthews, Van Buskirk and Whisler Ancestors," compiled by Rosalie Viola Matthews Flint and Alice May Matthews Tesh in the Douglas County Museum Library.

Albert (Abb) Lafayette Matthews was born May 14, 1897 at McClay, Oregon, the sixth child and oldest son of Frank Lyman and Harriet (Hattie) Matthews. Abb served in the U.S. Navy in WW I and married Neva Blanche Pickens December 24, 1921 at Roseburg, Oregon. They lived fifty-two years in the Missouri Bottom (Tri-City) area of Douglas County, where Abb farmed.

Abb and Neva had two children: Mabel Jane, born January 27, 1928 and Robert Clayton, born September 23, 1932.

Mabel Jane Matthews married Webster Briggs (see Ernel Briggs Family this book) June 19, 1948.

Their children are: Gerald, born April 9, 1949; Matthews, Lee, born May 25, 1959; William Franklin, born September 23, 1960; and David Alan, born June 18, 1964. Robert Clayton Matthews was born 23



Harriet Jane Andrews Matthews.



Franklin Lyman Matthews



Neva Blanch Pickens Matthews 1921



Albert Lafayette Matthews 1922

September 1932 at Roseburg, Oregon. Married LaVonne Phyllis Olson 22 September 1952. She was born 6 November 1932 at Guthrie, Minn. She was the daughter of John Olson and Amalia A. Holmberg. They had 5 children. Robert is Administrative Assistant at Riddle High School.

Kevin James Matthews was born 22 May 1953 at Ashland, Ore. He married Norma Jean Doty 3 February 1978 at Albany, Ore. Norma was born 1 June 1949 at Corvallis, Ore., and was the daughter of Norman Doty and Clara Belle Anderson. They live in Archer City, Texas. Their daughter Rebecca Galadriel was born 2 February, 1980 at Albany, Oregon.

Gregory Robert Matthews was born 18 June 1954, at Medford, Oregon. He married Cheryl Diane Carlson 10 December 1977 at Ashland, Oregon. Cheryl was born 17 December 1955 at Ashland, Oregon, and was the daughter of Vernon Carlson and Mary Lou Woods. They live in Corvallis, Oregon.

Bruce Edward Matthews was born 1 August 1956 at Ashland, Oregon. He lives in Portland, Oregon.

John Albert Matthews was born 14 January 1958 at Klamath Falls, Oregon, and married Linda Joyce Shown 8 August 1981 at Ashland, Oregon. Linda was born 2 March 1959 at Toledo, Ohio, and was the daughter of Robert Michael Shown and Janis Stromwall. They live in Albany, Oregon.

Drew Williams Matthews was born 28 January 1960 at Klamath Falls, Oregon. Robert Matthews

GEORGE E. MATTHEWS

George E. Matthews was a son of pioneer Albert Atwater and Barbary A. (Whisler) Matthews. (See Matthews Family in this book.)

They raised a family of eight sons and two daughters on the "old Matthews Place" at Reston. The place is now in the possession of Ivan and Doris Matthews. He is a great grandson of Albert A. and Barbary

JAN 02 1990

(Whisler) Matthews, a grandson of George Edwin and Mary Elizabeth (Woodin) Matthews and a son of Arthur Melvin and Margaret (Conn) Matthews.

Arthur Woodin 1870 — married Ada Beasley. They raised three daughters Alta, Wanda and Bea. He worked many years at Southern Pacific roundhouse at Roseburg.

Junetta Wilson (1878-1957) married George Byron on June 8, 1903.

Charles Wilson (1880-1967) married Mettie Goodman. Dale Matthews

NATIVE OF DOUGLAS COUNTY

born Christmas Day, 1921, at Umpqua. Lived there and attended first year of school at Coles Valley School. Was third of five children born to Arthur M. and Margaret Conn Matthews.

Family moved in 1929 to the four hundred acre homestead at Reston, west of Lookingglass, part of which was homesteaded by Ivan's great-grandfather, George Edwin Matthews. They raised various crops, livestock, and sold some timber.



Ivan, Clark, Doris and Rick Matthews, 1959

Ivan attended Reston Grade School and graduated from Lookingglass High School in 1941. He played basketball all four years and has remained an ardent fan of local teams.

Family returned to Umpqua in 1941 where Ivan became acquainted with and later married the "girl next door," Doris Leonard.

He entered the Navy in 1942, training at "boot camp" in San Diego. He was assigned to the submarine tender, U.S.S. Sperry. Served in the South Pacific and Asian Theatres, visiting many islands and Australia.

After a leave of absence in October, 1944, when he presented Doris with an engagement ring, was assigned to a troop transport, the U.S.S. Lavaca. His ship pulled into Tokyo Harbor alongside the U.S.S. Missouri on V.J. Day, September 2, 1945, where the peace treaty was being signed.

Was discharged a Carpenter's Mate 3/C in December and he and Doris were married in pastor's study at Presbyterian Church on December 7, 1945, with both their parents in attendance.

Doris was born in Vernon, Texas, May 8, 1925, second of eight children born to Lloyd and Thelma Rippstein Leonard. They came to Oregon in a Model T. Ford when Doris was only three months old. She at-

tended grade school at Millwood, the school at Sutherlin and Roseburg. After graduation in 1943, was interviewed and hired by J.H. Booth to work in their family owned Douglas National Bank.

Ivan and Doris lived in a cabin near his parents until February 1946, when they purchased fifty acres in Lookingglass Valley. Ivan's employment included Joelson Lumber Co., Roseburg Sand and Gravel, and Umpqua Plywood Co.

They had two sons, Arthur Clark and Rickey Lloyd. Clark married Michelle Chartier, they have three children: Rebekah, Jacob, and Elizabeth. Rick married and later divorced Mary Gazley. They have two children, Jennifer and Joshua.

Ivan and family spent fourteen months in Fairbanks, Alaska, where brother Dale, lived for many years. Ivan worked in power plant at Ladd Air Force Base and Doris at Alaska National Bank. Were there when Statehood was approved for Alaska in June, 1958.

Returned home to farming and logging. Doris worked for short while for telephone office, until First National Bank of Roseburg opened it's doors in May, 1959. She retired from the Winston Branch in February, 1972. (Name had been changed to Douglas National Bank.)

Bought homestead from parents at Reston, built new house, and have been logging the marketable timber since.

Brother, Dale, and sisters, Lillian Kenworthy, Elaine Becker, and Virginia Willis all live within seventeen miles of each other in the Roseburg area. Mother died April 6, 1974 at age 76, father is in Grandview Care Home, age 91. Mrs. Ivan Matthews

JOE MATTHEWS

Joe Matthews was born in Reston, Oregon, a descendant of the Whistler and Wooden families.

Sarah Van Buskirk and her parents, William and Margaret, came from Ohio, crossing the plains in 1852. Margaret died on the way and was buried in the Blue Mountains midway between the Grande Ronde and Umatilla Rivers.

Sarah and Elijah Whistler were married and lived in the Glide area. They had seven children, one of whom was Barbry Alice. She married Albert Atwater Matthews who had come to Oregon from Pennsylvania. They were married in 1859 and are buried in the Lookingglass cemetery. They



George E. Matthews Family: Back Row, L to R: Ruth, Arthur, Albert, Joseph, Otto and Lillian. Front Row, L to R: Wallace, George (father), Mamie (mother) and Ralph (Claude is absent WWI).

homesteaded in the Reston area and farmed for a living. The original homestead is still owned by descendants of the family.

Barbry and Albert had five sons. George E., one of the sons, married Mary Elizabeth (Mamie) Wooden in 1806. They continued to live on the family farm.

George died in 1908 of a ruptured appendix and Mamie raised their ten children, listed as follows:

Otto C., b. 1881, married Amy Conn, children — Kilane, Catherine, and twins Ruby and Ruth.

George E., b. 1888, married Zelma Finch, children — Doris and Wilma.

Arthur M., b. 1890, married Margaret Conn, children — Lillian, Dale, Ivan, Elaine and Virginia.

Lillian, b. 1892, married A.L. Bushnell, no children.

Albert A., b. 1895, married Grace Bonnin, children — Shirley Lee and Micheal.

Claude, b. 1897, married Josephine Blinco, no children.

Joseph S., b. 1899, married Edna Perrin, children — Bonnie Jean and Arthur E. (Bill).

Ruth, b. 1904, died 1929.

Wallace W., b. 1906, married Edith Ely, children — twin daughters Berneice and Deneice.

Ralph, b. 1907, married Beulah Emmett, children — Mary Lou and Patricia.

The doctor who came from Roseburg to tend George drove the first automobile that Joe had ever seen.

Joe has always loved music. When he was about four years old his brother Claude would take him to a nearby lumber camp "cook shack" and Joe would sing for cookies. Besides singing, Joe played the harmonica, fiddle and piano.

He farmed for several years, then worked as grader operator for Douglas County, maintaining and building roads. Later he worked for the city and a private logging company as grader operator.

In his active life Joe liked to hunt, fish and garden, and he knew a great deal about the plant and animal life of Douglas County.

During the later part of Joe's life he suffered from rheumatoid arthritis and because of its crippling effects was denied the activities he enjoyed. He died in March, 1982. Arthur Matthews

ROBERT LEON MATTHEWS

Robert Leon Matthews was born on May 30, 1896 on the donation land claim east of

James F. Gosson
Consulting Engineer

RECEIVED

JAN 02 1990

WATER RESOURCES DEPT.
SALEM, OREGON

December 29, 1989

Oregon Water Resources Department
3850 Portland Road, N.E.
Salem, Oregon 97310

Attention: Wayne Overcash


Re: Registration Statement Claiming a Right to Appropriate
Surface Water - Ivan M. Matthews

Enclosed are the following documents:

- ✓Registration Statement Forms
- ✓Application Maps, (16) four copies of each
- ✓Supplemental Sheets (7)
- ✓Certification Statement by James F. Gosson, CWRE
- ✓Copy of Homestead Certificate #2659 in the name of George E. Matthews, June 3, 1891
- ✓Copy of Homestead Certificate #4637 in the name of A. A. Matthews, August 31, 1885
- ✓Copy of pages 5,6,7 & 11 from Abstract compiled for George E. Matthews Estate
- ✓Copies of three letters written by Mamie (widow of George E. Matthews) prior to her death on July 28, 1922, mentioning crops, livestock, and poultry being raised for their livelihood.
- ✓Notation made from records at Douglas County Museum placing time of sawmill going in in 1894 on George Matthews place.
- ✓Copies of pages 216, 217 and 218 from Historic Douglas County, Oregon, published in 1982 by Douglas County Historical Society
- ✓Six notarized letters attesting to water usage
- ✓Legal description of the Matthews property
- Check #1131 in the amount of \$430 (irrigation \$30, domestic \$200, and stockwater \$200).

You will notice that the application maps consist of three xerox paper copies and one vellum copy. Please advise if this arrangement is not satisfactory. Please contact me or the Matthews if you should have any questions or need additional information.

Very truly yours,

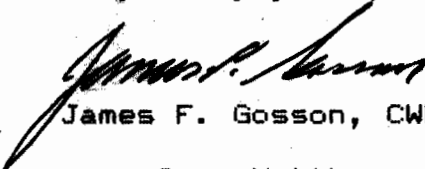
James F. Gosson, CWRE

cc: Ivan Matthews
Enclosures

1257 S.E. Washington, Roseburg, Oregon 97470 • (503) 672-8384

Roseburg, Oregon 97470

Dated May 3, 1989

RECEIVED

JAN 02 1990

To Whom it May Concern:

I am Ivan Matthews' sister and I am writing this to confirm the water usage from Rock Creek that flows through Ivan Matthews' property in sections 1 and 2 of Township 28S Range 8W.

WATER RESOURCES DEPT
HELM, OREGON

Our great grandfather, A. A. Matthews, homesteaded and built a home on a 160 acre portion of this property in 1870. A few years later his son, George E. Matthews (our grandfather) homesteaded and built a home on another 160 acre portion. Later, the family acquired an additional 80 acres to make a total of 400 acres. Since 1870 one or another of our family members have lived on this property with the exception of two years during 1942-1944.

My father said A. A. Matthews flumed water from the creek to supply his household and irrigate his garden. George Matthews built his house adjacent to the creek and water for the house was carried in buckets, but irrigation water was also flumed from the creek.

During the 1890's and the early 1900's there was a sawmill on this property powered by Rock Creek.

I was born there in 1936 and at that time there was a water powered hydraulic ram that pumped water for our house and garden.

In 1944 my father instated a gravity flow water system, taking water through a one inch pipe, from the creek above the house. He raised a large vegetable garden, everbearing strawberries for market and also irrigated some pasture.

In 1951 he bought a 2hp electric irrigation pump and since then the owners have irrigated at least five acres of garden and pasture. At the present time the creek also furnishes three homes with water.

Submitted this 3rd day of May, 1989.

Virginia Willis
Virginia Willis

State of Oregon)
County of Douglas) SS.

May 3, 1989, Personally appeared the above named Virginia Willis and acknowledged the foregoing instrument to be her voluntary act and deed.

Before me:

Sherry D. Brint
Notary Public for Oregon

My commission expires: 11-4-89

Sherry D. Brint
SHERRY D. BRINT
NOTARY PUBLIC-OREGON
My Commission Expires 11-4-89

Address: 1010 Shadow Ranch Lane
Roseburg Oregon 97470

Date: 5-11-89

RECEIVED

To Whom it May Concern:

JAN 02 1990

This is a statement supporting claims of water usage from Rock Creek flowing through the Ivan Matthews' property, formerly Arthur M. Matthews, formerly George E. Matthews and Albert A. Matthews, located at 6987 Coos Bay Wagon Road, Roseburg, Oregon. (Reston Area) WATER RESOURCES DISTRICT 1, SALEM, OREGON

I, Elaine Elizabeth Matthews Becker, was born 12-16-25 to Arthur M. and Margaret A. Matthews at Umpqua, Oregon. At that time I had two older brothers, Dale and Ivan, an older sister, Lillian, and a younger sister, Virginia, was born in 1936.

In 1929 our family moved to the home place at Reston, Oregon. Rock Creek flowed across our place supplying us with water for:
(1) household usage at first carried by bucket, later pumped by a "ram";
(2) livestock, turkeys, & chickens; and (3) irrigation - carried by troughs & ditches.

In the fall of 1941 our family moved back to Umpqua. In the spring of 1944 our parents and Virginia returned to the place at Reston. Usage of the water from Rock Creek resumed as before but soon the ram was replaced with an electric pump; now they could also irrigate orchards, pastures & yard.

Eventually, Dale & Ivan bought the place from our parents (who continued to live there); soon Ivan bought out Dale's share; Ivan then built a home on the place for his family; later a mobile home was set up for a son's home.

To date, our parents are gone but Ivan & his wife, Doris, and their family still live in the three homes on the place and are still using the water from Rock Creek for their household, livestock, & irrigation.

Submitted by: Elaine E. Becker

State of Oregon)
County of Douglas) ss.

On May 11, 1989, personally appeared before me the above named Elaine E. Becker, and acknowledged the foregoing instrument to be his/her voluntary act and deed.

Before me: Karan B. Reed
Notary Public for Oregon

My Commission expires: 1-29-93

Address: 4390 Reston Rd
Roseburg, Or 97470

Date: 5-5-89

To Whom it May Concern:

RECEIVED

This is a statement supporting claims of water usage from Rock Creek flowing through the Ivan Matthews property, formerly Arthur M. Matthews, formerly George E. Matthews and Albert A. Matthews, located at 6987 Coos Bay Wagon Road, Roseburg, Oregon. (Reston Area)

JAN 02 1990 EP
WATER RESOURCES DE
SALEM, OREGON

I have known the Matthews since 1933. We were in school together and spent many a night together. and Many hours at the old homestead. We would listen to the Ram push the water into holding tanks and we had gravity fed water from the creek to supply the house and also to water the garden and stock.

Submitted by: J.W. Gurney

State of Oregon)
County of Douglas) ss.

On May 5, 1989, personally appeared before me the above named J.W. Gurney, and acknowledged the foregoing instrument to be his/her voluntary act and deed.

Before me: Mary Marshall
Notary Public for Oregon

My Commission expires: 4-28-92



5001 Bay Road A-40
Blaine, Washington 98230
Dated APRIL 19, 1989

RECEIVED

JAN 02 1990

To Whom it May Concern:

WATER RESOURCES DEPT
SALEM, OREGON

I, A. Dale Matthews, wish to verify the use of water from Rock Creek that flows through the portion of the Matthews' ranch described in Homestead Certificate #2659, application #5262, issued to George E. Matthews, his heirs and assigns, containing one hundred sixty acres, and filed in General Land Office records Book 25, page 91, Douglas County, Oregon.

Also, the parcel described in Certificate #4637 filed in Book 25, page 526 of General Land Office records of Douglas County, Oregon. This parcel was issued to A. A. Matthews, his heirs and assigns, and contained one hundred and fifty eight acres and sixty three hundredths of an acre.

I was born April 3, 1920, and lived on this place with my parents, Arthur and Margaret Matthews, and a brother and three sisters, until about 1938. We obtained water for household use by carrying in buckets from the creek. Water for garden, yard, and crops was brought down by flume with gravity flow for sub-irrigating. Livestock had access to the stream below the drinking water source.

In about 1930, we installed a ram at the creek for pumping water to the house -- a big improvement over carrying water up the steep bank to the house.

At the present time, there are three houses using water from the creek for domestic purposes, yards, crops, garden and livestock, using electric pumps.

Submitted by: A. Dale Matthews
A. Dale Matthews

State of Washington)
County of WHATCOM) ss.

On APRIL 19, 1989, Personally appeared before me the above named A. Dale Matthews and acknowledged the foregoing instrument to be his voluntary act and deed.

Before me: [Signature]
Notary Public for Washington

My commission expires: JANUARY 5, 1992

Address 2730 Hubbard Creek Road

Umpqua, Oregon 97486

Date

July 25, 1989

RECEIVED

JAN 02 1990

To Whom it May Concern:

This is a statement supporting claims of water usage from Rock Creek flowing through the Ivan Matthews property, formerly Arthur E. Matthews, formerly George E. Matthews and Albert A. Matthews, located at 6987 Coos Bay Wagon Road, Roseburg, Oregon. (Reston Area)

WATER RESOURCES DEPT
SALEM, OREGON

As a relative of the Matthews family, I have been a visitor to their ranch at Reston many times in the past, dating back to about 1914.

The Matthews family has earned a good part of their livelihood from ranching and farming their acreage. Water from the stream running through their place has been vital to these activities, as well as being their source of water for household use for from one to three houses.

I recall hearing the ram operating to bring water up over the creek bank to the house.

Submitted by: Henry Crane

State of Oregon)
County of Douglas) ss.

On July 26, 1989, personally appeared before me the above named Henry Crane, and acknowledged the foregoing instrument to be his/her voluntary act and deed.

Before me:

Carmen Cox
Notary Public for Oregon

My Commission expires

CARMEN COX

NOTARY PUBLIC OREGON

My Commission Expires 05-08-90

Ione, Oregon 97843

Dated: 4-17, 1989

RECEIVED

JAN 02 1990

To Whom it May Concern:

WATER RESOURCES DEPT.
SALEM, OREGON

This letter is written to substantiate the water usage from Rock Creek, flowing through that portion of the Matthews' ranch described in Homestead Certificate #2659, application #5262, issued to George E. Matthews, his heirs and assigns, containing one hundred sixty acres, and filed in General Land Office records Book 25, page 91, Douglas County, Oregon.

Also, the parcel described in Certificate #4637 filed in Book 25, page 526 of General Land Office records of Douglas County, Oregon. This parcel was issued to A. A. Matthews, his heirs and assigns, and contained one hundred and fifty eight acres and sixty three hundredths of an acre.

I, Wallace Matthews, was born on February 1, 1906, and lived most of my "growing up" years on this home place along with nine brothers and sisters.

My father, George E. Matthews, passed away on September 30, 1908, leaving my Mother and the family to earn a living as best they could on this acreage.

We depended on the water from Rock Creek, now known as Morgan Creek when it reaches Lookingglass. We carried by buckets for household use but dammed up and flumed by gravity flow to irrigate gardens, crops such as berries, corn, and sugar beets for market and feeding livestock. The livestock had access to the creek below the drinking water source.

Submitted this 17 day of April, 1989.

Wallace Matthews
Wallace Matthews


State of Oregon)
County of Morrow) ss.

April 17, 1989, Personally appeared the above named Wallace Matthews and acknowledged the foregoing instrument to be his voluntary act and deed.

Before me:

Jane M. Russell
Notary Public for Oregon

My commission expires: 4-18-90

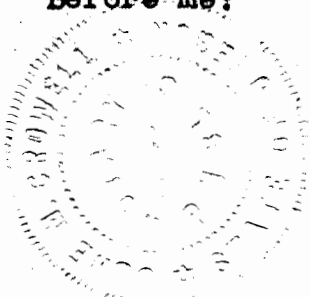

MATTHEWS

EXHIBIT A

RECEIVED

JAN 02 1990

PARCEL ONE:

WATER RESOURCES DEPT.
SALEM, OREGON

Southwest quarter of the Northwest quarter of Section One; Also the East half of the Northeast quarter and the East half of the Southwest quarter, and the Southeast quarter of Section Two. All in Township 28 South, Range 8 West of the Willamette Meridian.

PARCEL TWO:

Northwest quarter of the Southwest quarter of Section 1, Township 28 South, Range 8 West, W.M., Douglas County, Oregon.

Said parcels are subject to any rights of way and easements which now appear of record, if any, in the Douglas County, Oregon, deed records.

Also, Arthur Melvin Matthews and Margaret Arvilla Matthews, husband and wife, reserve, until the death of the survivor of them, the exclusive right for them or the survivor of them to use and occupy the following portion of said property, to-wit:

A residence situated thereon, now occupied by them, together with approximately 10 acres under said residence and surrounding the same, as well as all other improvements and an orchard situated on said ten acres.

For said term said Arthur Melvin Matthews et ux, or the survivor of them, shall also have the right of reasonable ingress to and egress from said approximate 10 acre parcel, following a roadway now serving the same, but the right to use said roadway shall not be exclusive, and all parties using the same shall be responsible for the maintenance thereof to the extent of their use of the same; and, also, said Arthur Melvin Matthews et ux, or the survivor of them, shall have the right to obtain water from a creek situated on said premises for residence and irrigation purposes to the extent that such water has been used in the years last past, by them, in connection with the use and occupancy of said residence and said approximate 10 acre parcel.

STATE OF OREGON
COUNTY OF DOUGLAS

I, DORIS L. WADSWORTH, COUNTY CLERK
AND RECORDER OF CONVEYANCES, IN AND FOR
SAID COUNTY, DO HEREBY CERTIFY THAT THE
WITHIN INSTRUMENT WAS RECORDED THIS DAY,

SEP 13 1989

DORIS L. WADSWORTH
DOUGLAS COUNTY CLERK

82-09757

Page

BY Margaret Arvilla Matthews
NO. 82-09757 FILE 82-09757

DOUGLAS COUNTY OFFICIAL RECORDS

LAW OFFICES


LUOMA, KELLEY & WOODRUFF
SUITE 206, PROFESSIONAL CENTER
TELEPHONE 673-6641
ROSEBURG, OREGON 97470

IN THE NAME OF JUAN M. MATTHEWS

SECTION 2, T28S, R8W, W. M.

JAN 02 1990

WATER RESOURCES DEPT
SALEM, OREGON

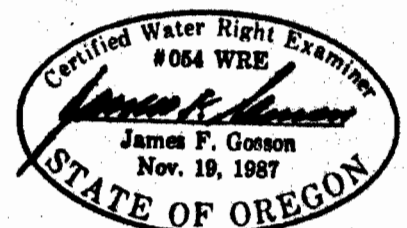

APPLICATION MAP

IN THE NAME OF IVAN M. MATTHEWS

CLAIMING A RIGHT TO APPROPRIATE SURFACE WATER


SECTION 2, T28S, R6W, W. M.

RECEIVED


JAN 02 1990

WATER RESOURCES DEPT.
SALEM, OREGON

1 INCH = 1620 FEET

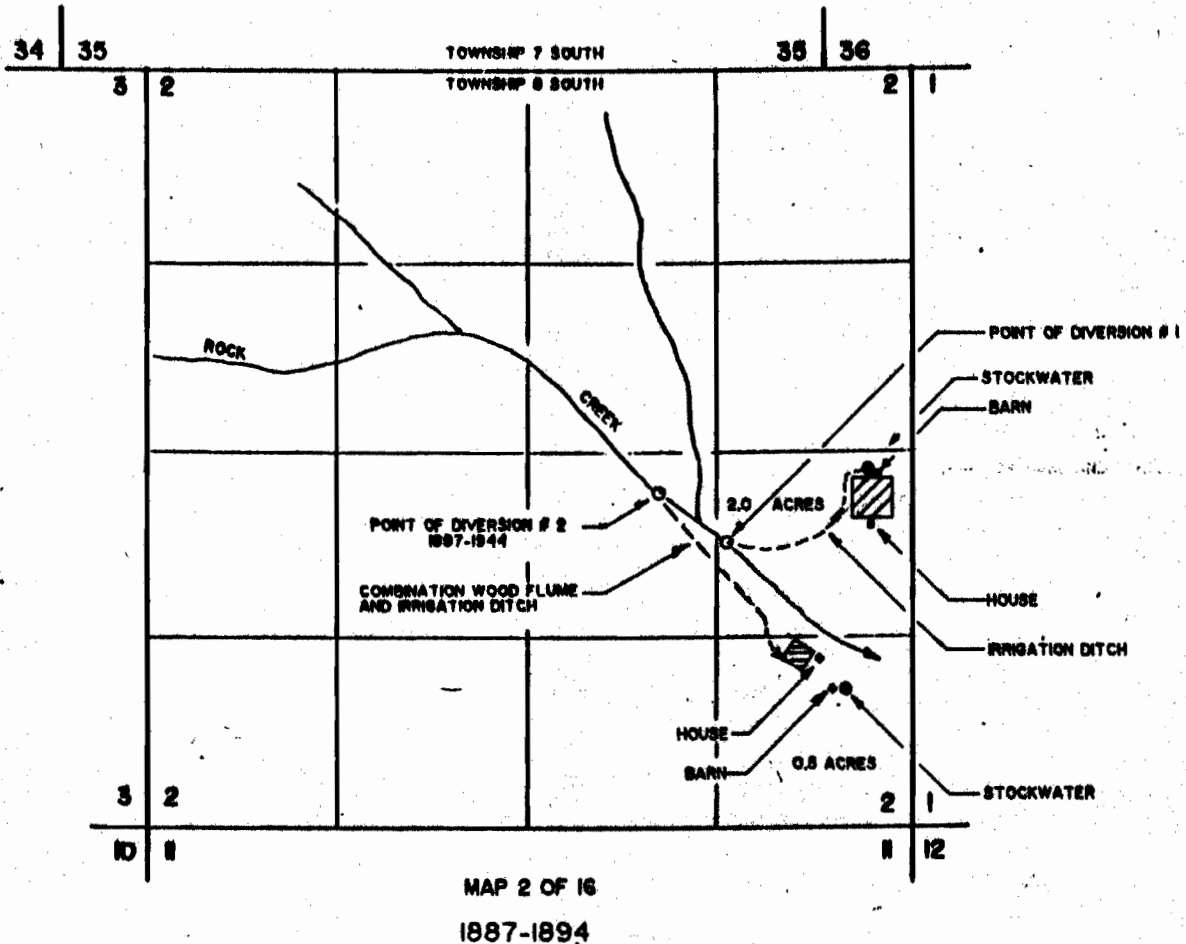

POINT OF DIVERSION #2 WAS LOCATED 2360 FEET NORTH AND 1740 FEET WEST FROM THE SOUTHEAST CORNER OF SECTION 2, BEING WITHIN THE NORTHWEST 1/4 OF THE SOUTHEAST 1/4 OF SECTION 2.

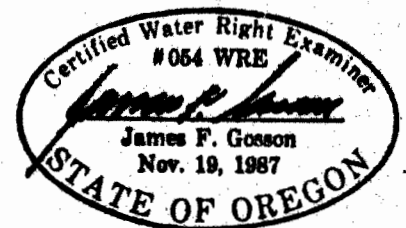

APPLICATION MAP

IN THE NAME OF IVAN M. MATTHEWS

CLAIMING A RIGHT TO APPROPRIATE SURFACE WATER

SECTION 2, T26S, R6W, W. M.


RECEIVED

JAN 02 1990


WATER RESOURCES DEPT.
SALEM, OREGON



1 INCH = 1500 FEET

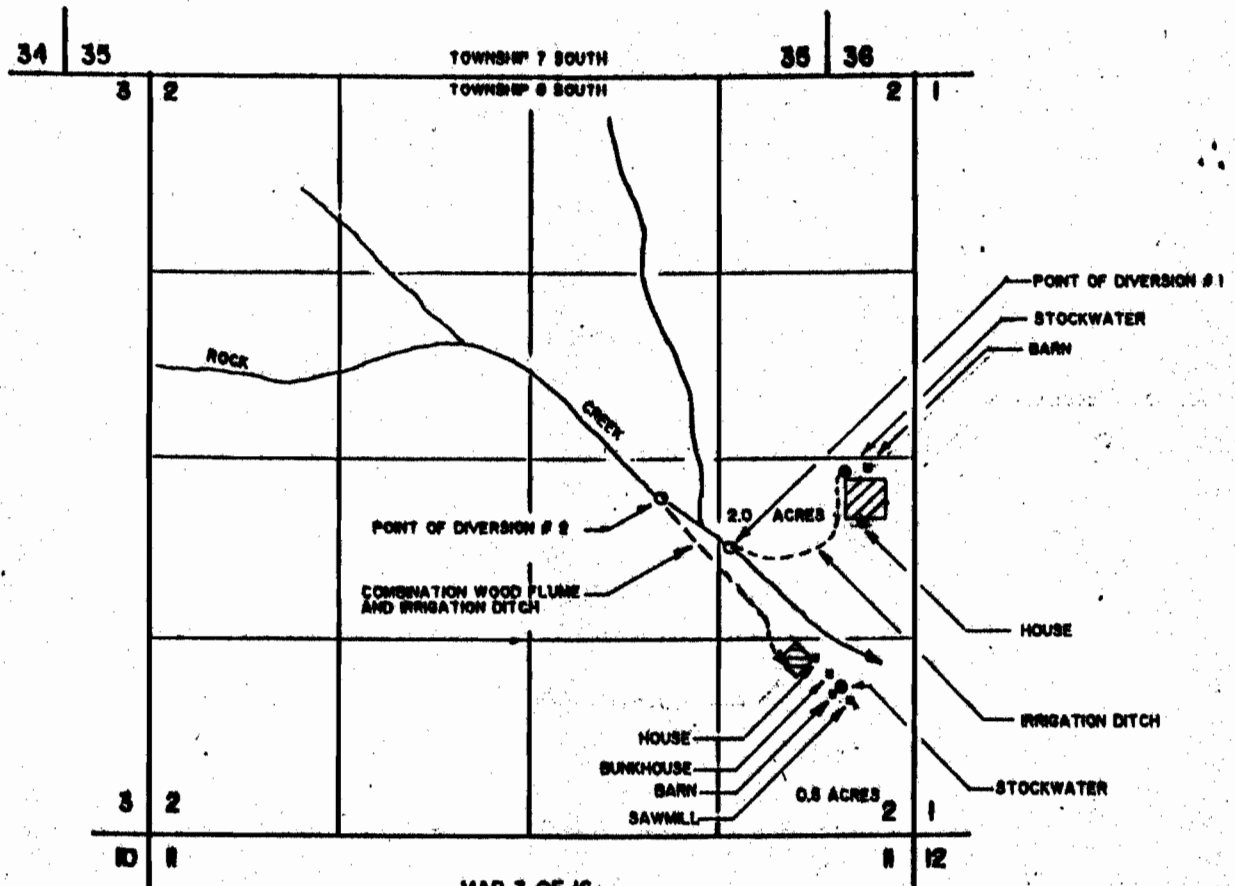

MAP 3 OF 16
1894-1904

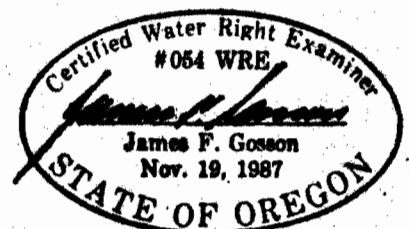

APPLICATION MAP

RECEIVED

IN THE NAME OF IVAN M. MATTHEWS

JAN 02 1990


CLAIMING A RIGHT TO APPROPRIATE SURFACE WATER

WATER RESOURCES DEPT
SALEM, OREGON


SECTION 2, T28S, R8W, W. M.



1 INCH = 1320 FEET

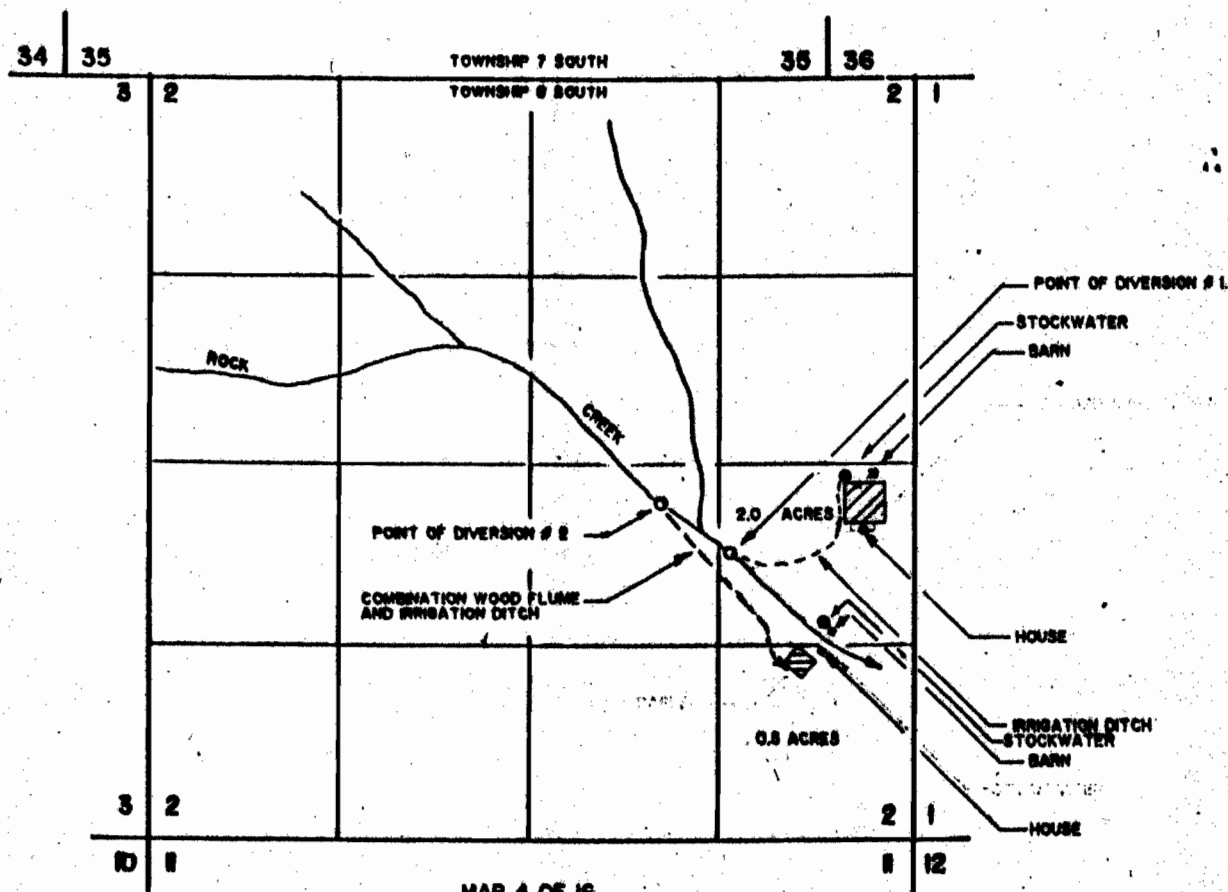

MAP 4 OF 16
1904-1907

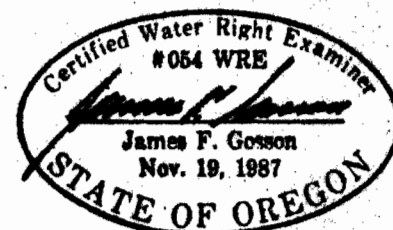

APPLICATION MAP

IN THE NAME OF IVAN M. MATTHEWS

CLAIMING A RIGHT TO APPROPRIATE SURFACE WATER

SECTION 2, T28S, R8W, W. M.


RECEIVED

JAN 02 1990


WATER RESOURCES DEPT
SALEM, OREGON



1 INCH = 1920 FEET

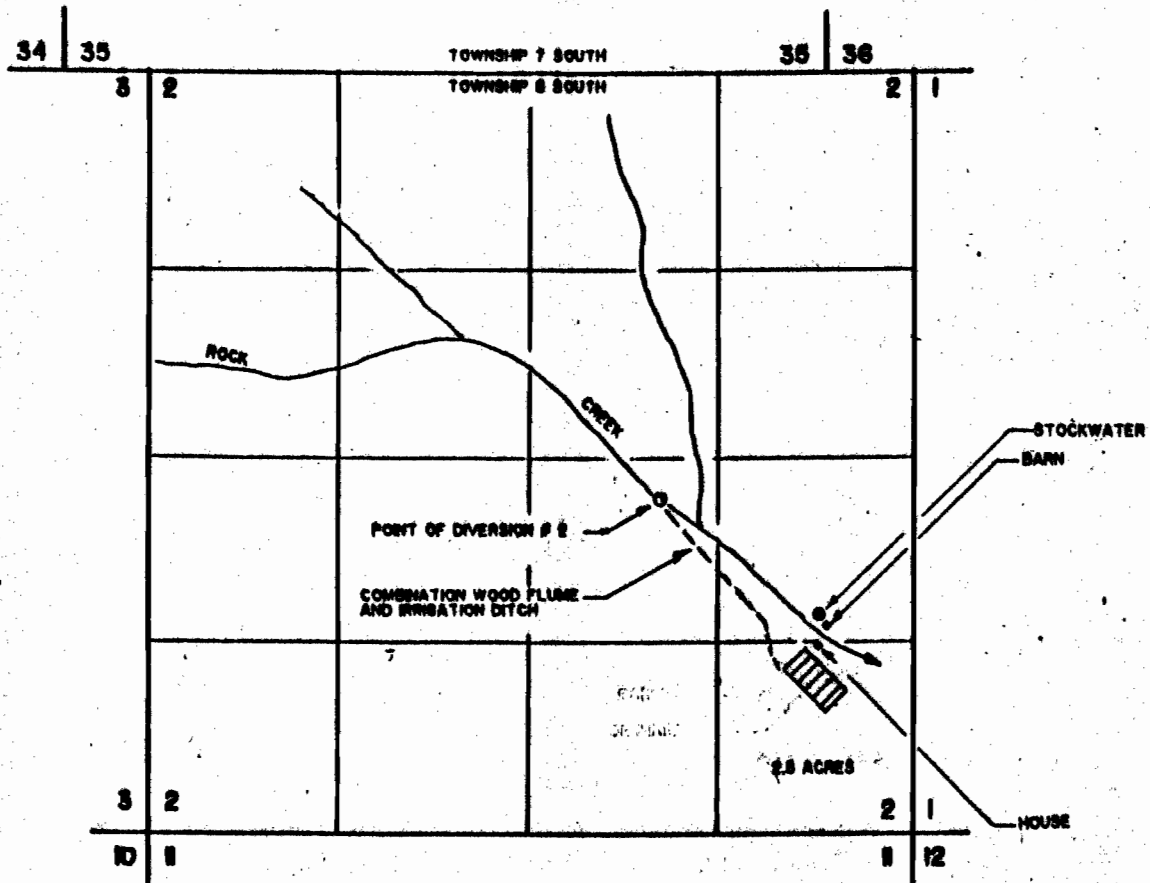

MAP 5 OF 16
1907-1927

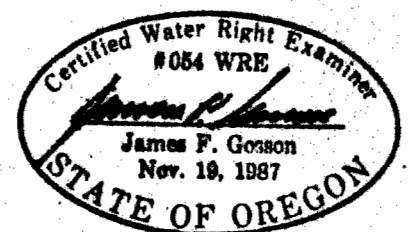

APPLICATION MAP

IN THE NAME OF IVAN M. MATTHEWS

CLAIMING A RIGHT TO APPROPRIATE SURFACE WATER

SECTION 2, T28S, R8W, W. M.



RECEIVED

JAN 02 1990

WATER RESOURCES DEPT.
SALEM, OREGON



1 INCH = 1920 FEET

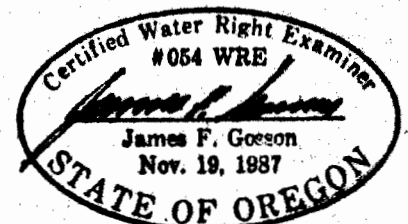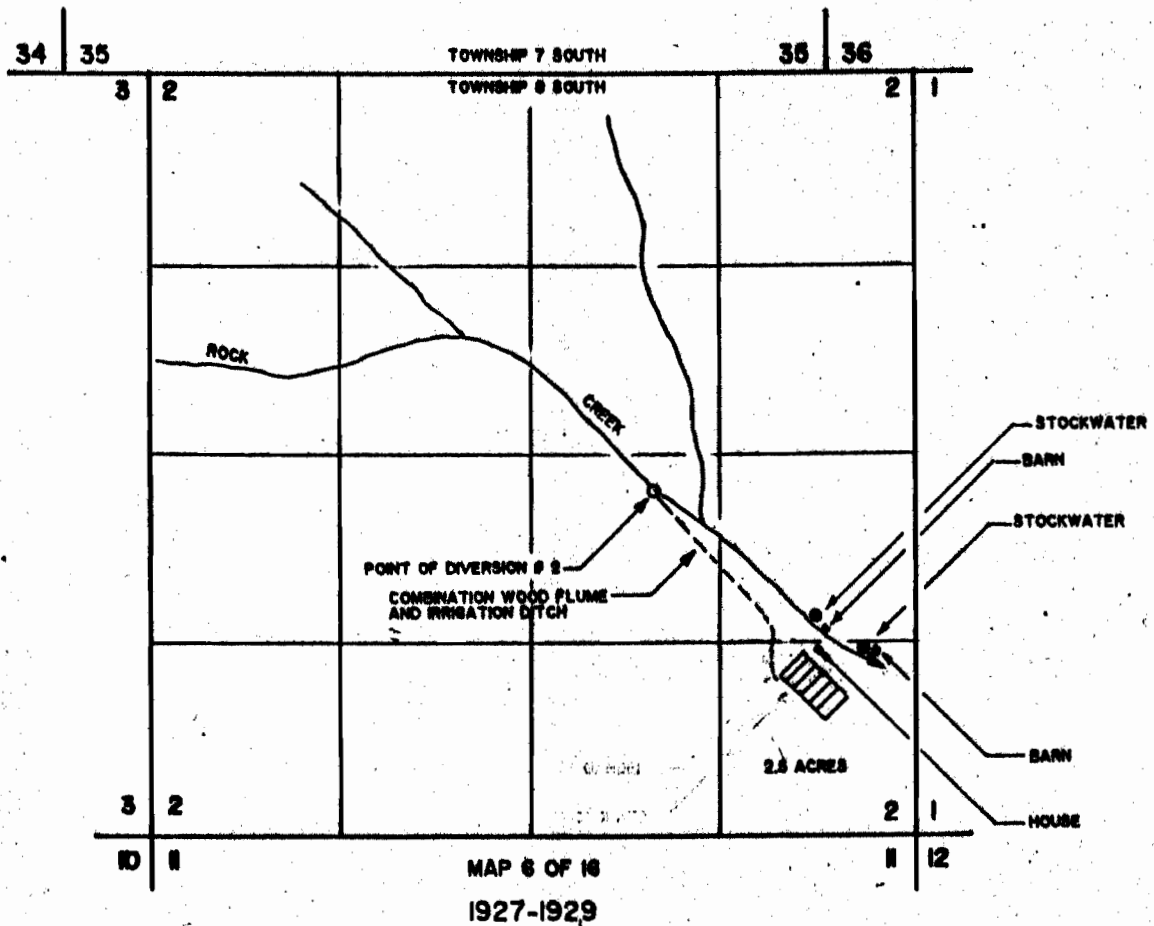

APPLICATION MAP

IN THE NAME OF IVAN M. MATTHEWS

CLAIMING A RIGHT TO APPROPRIATE SURFACE WATER

SECTION 2, T28S, R6W, W. M.


RECEIVED

JAN 02 1990

WATER RESOURCES DEPT
SALEM, OREGON



1 INCH = 1920 FEET

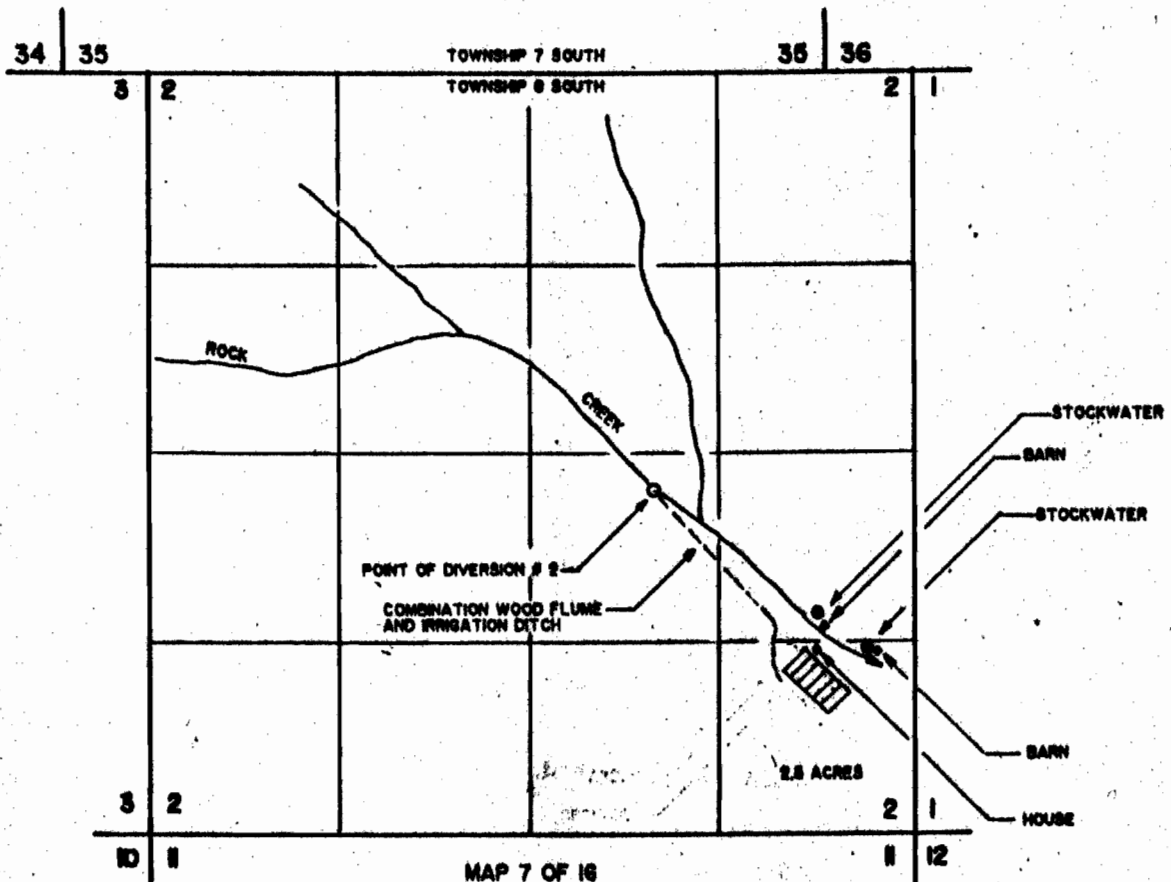

MAP 7 OF 16

1929-1930



APPLICATION MAP

IN THE NAME OF IVAN M. MATTHEWS

CLAIMING A RIGHT TO APPROPRIATE SURFACE WATER


SECTION 2, T28S, R6W, W. M.

RECEIVED


JAN 02 1990

WATER RESOURCES DEPT.
SALEM, OREGON

1 INCH = 1280 FEET

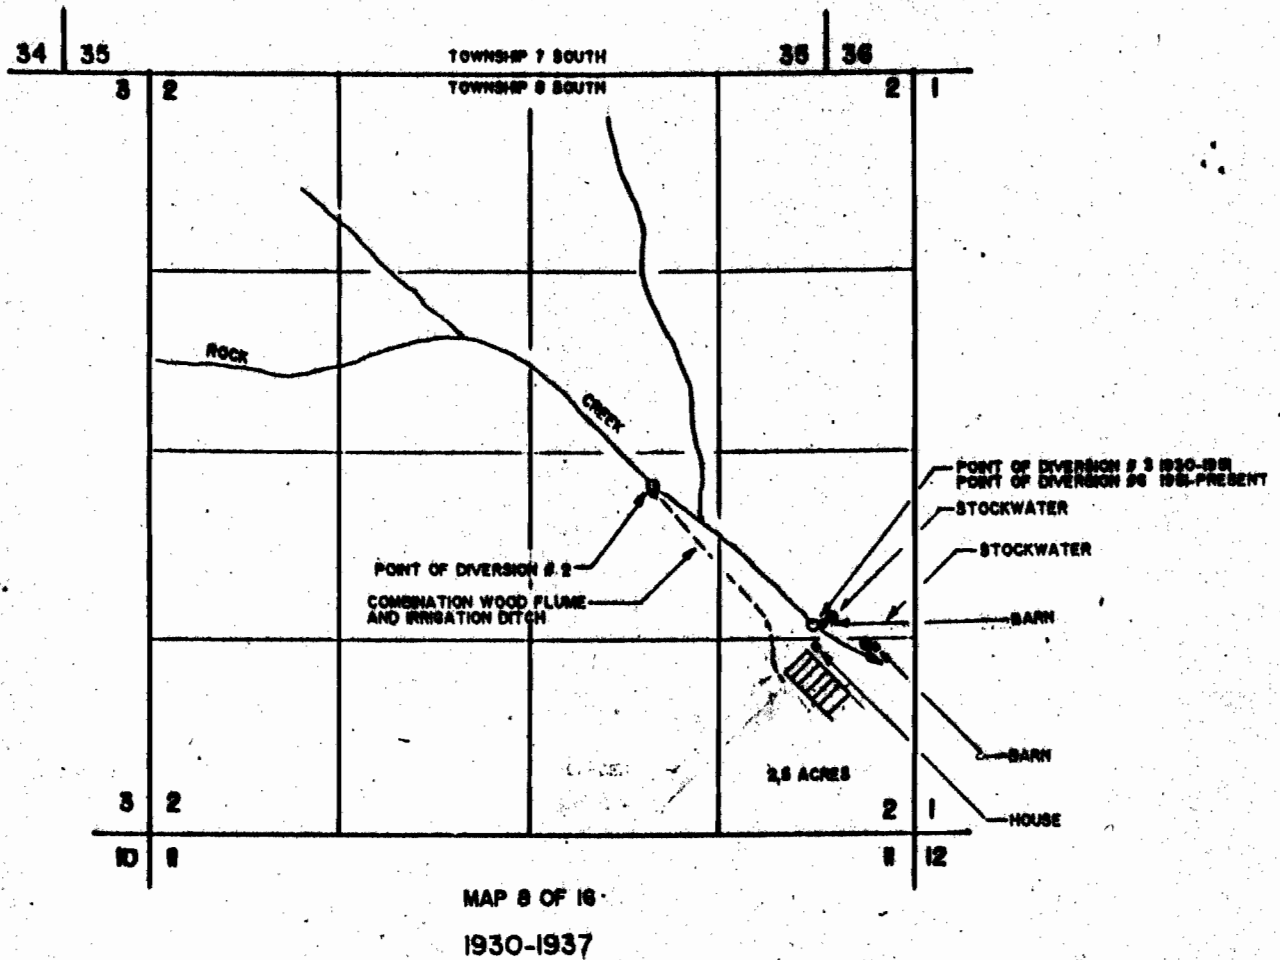

POINTS OF DIVERSION #3 AND #6 ARE LOCATED 1420 FEET NORTH AND 700 FEET WEST FROM THE SOUTHEAST CORNER OF SECTION 2, BEING WITHIN THE NORTHEAST 1/4 OF THE SOUTHEAST 1/4 OF SECTION 2.

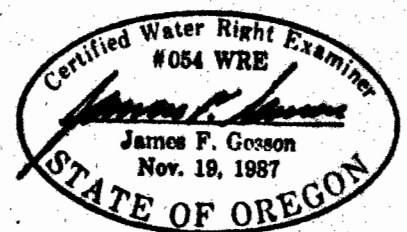

APPLICATION MAP

IN THE NAME OF IVAN M. MATTHEWS

CLAIMING A RIGHT TO APPROPRIATE SURFACE WATER

SECTION 2, T28S, R8W, W. M.


RECEIVED

JAN 02 1990

WATER RESOURCES DEPT.
SALEM, OREGON




1 INCH = 1280 FEET

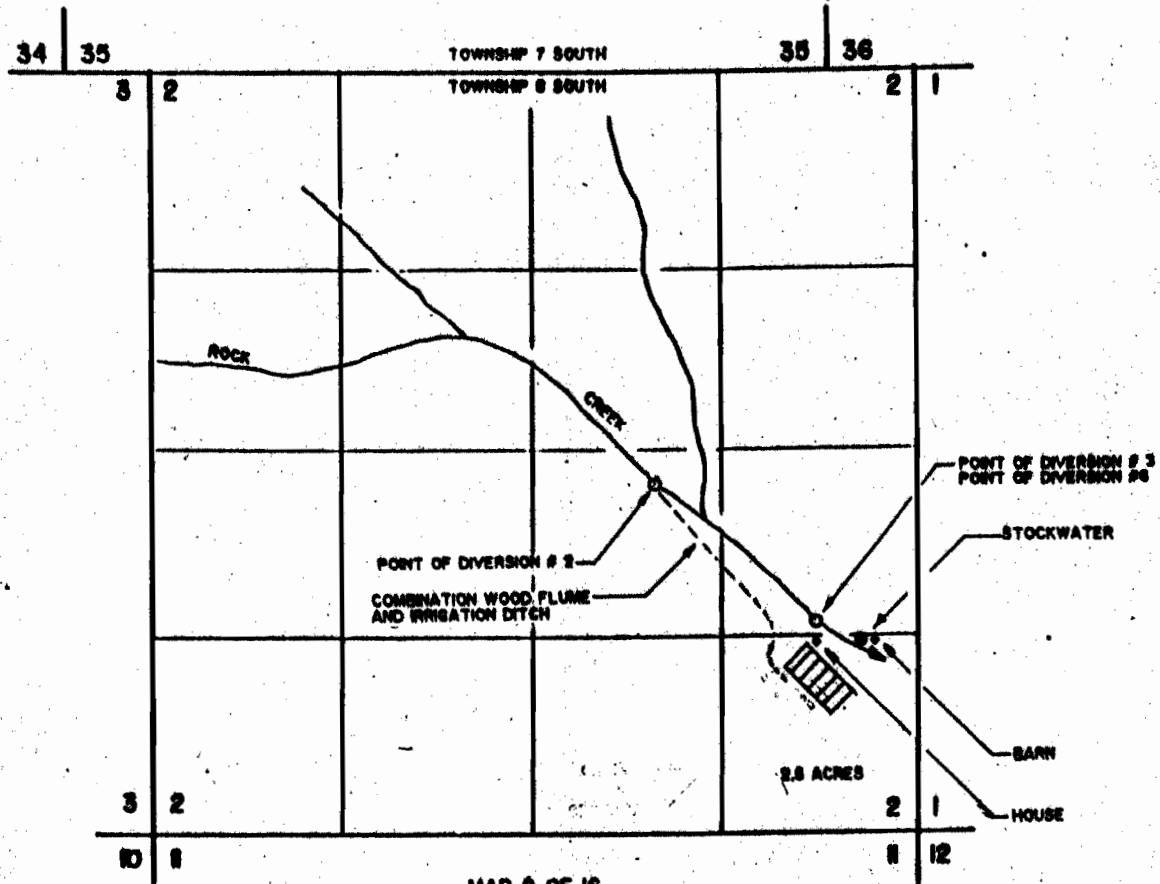

MAP 9 OF 16

1937-1938

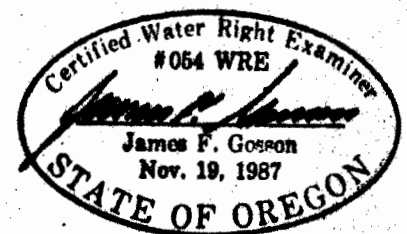

Certified Water Right Examiner
#054 WRE
James F. Gosson
James F. Gosson
Nov. 19, 1987
STATE OF OREGON

APPLICATION MAP

IN THE NAME OF IVAN M. MATTHEWS

CLAIMING A RIGHT TO APPROPRIATE SURFACE WATER

SECTION 2, T28S, R8W, W. M.


RECEIVED

JAN 02 1990


WATER RESOURCES DEPT.
SALEM, OREGON



1 INCH = 1280 FEET

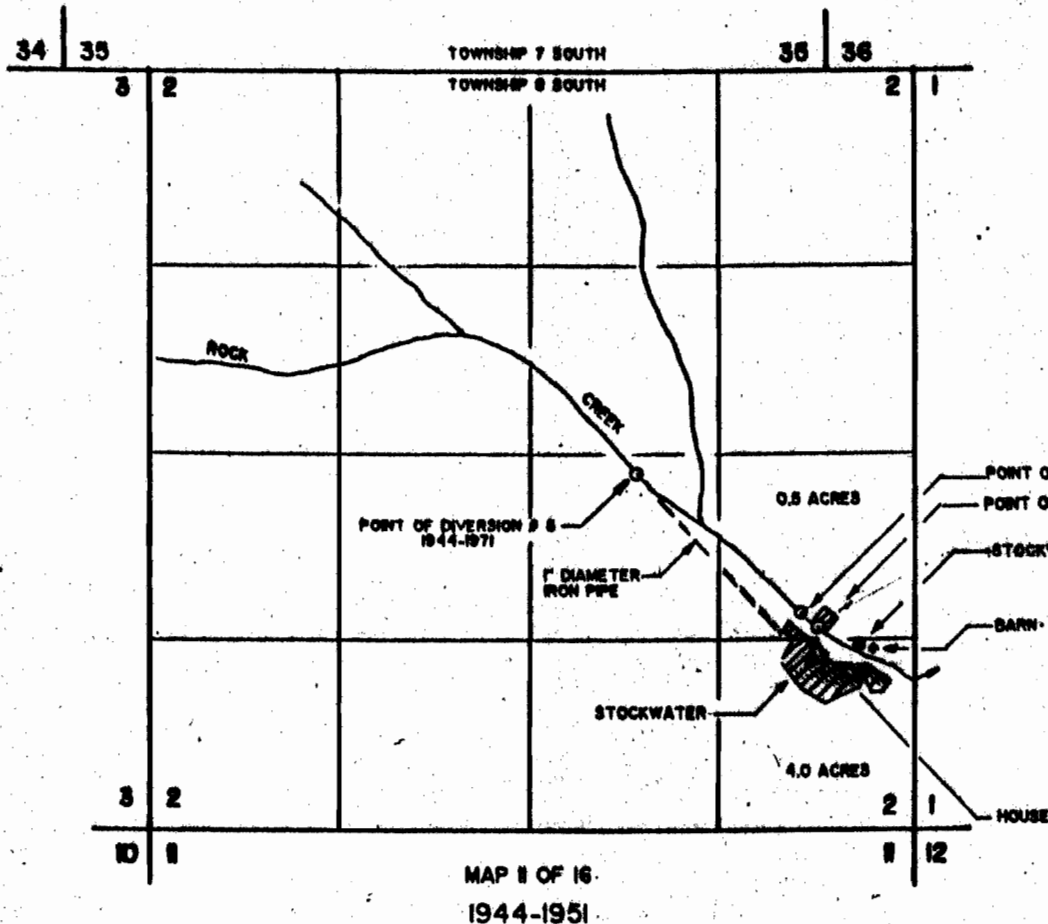

POINT OF DIVERSION #5 WAS LOCATED 2480 FEET NORTH AND
1900 FEET WEST FROM THE SOUTHEAST CORNER OF SECTION 2,
BEING WITHIN THE NORTHWEST 1/4 OF THE SOUTHEAST 1/4 OF
SECTION 2.

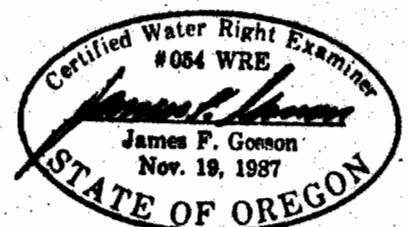

APPLICATION MAP

RECEIVED

IN THE NAME OF IVAN M. MATTHEWS


JAN 02 1990

CLAIMING A RIGHT TO APPROPRIATE SURFACE WATER


WATER RESOURCES DEPT.
SALEM, OREGON

SECTION 2, T28S, R8W, W. M.

1 INCH = 1000 FEET

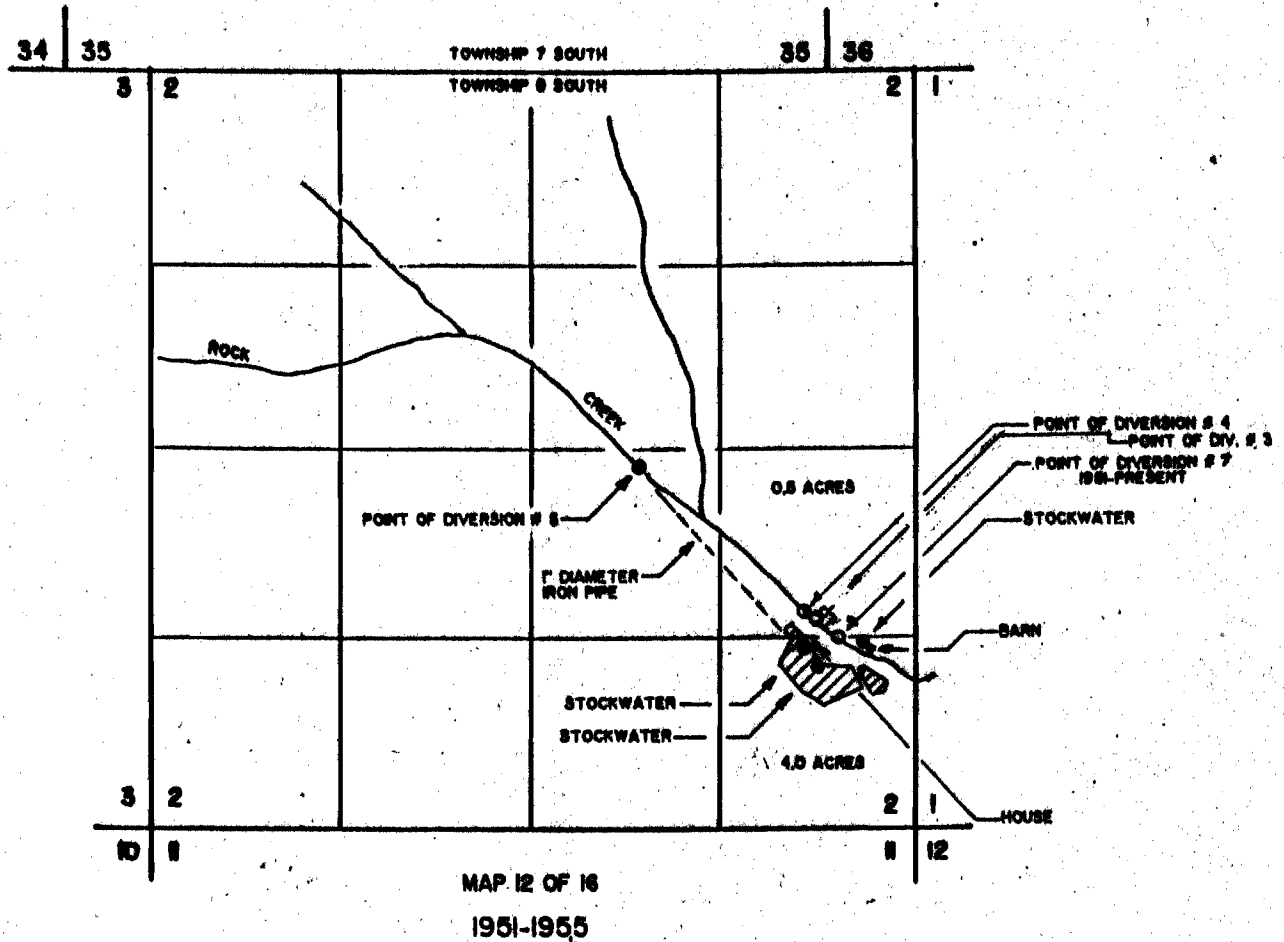

POINT OF DIVERSION #9 IS LOCATED 1300 FEET NORTH AND
820 FEET WEST FROM THE SOUTHEAST CORNER OF SECTION 2,
BEING WITHIN THE SOUTHEAST 1/4 OF THE SOUTHEAST 1/4 OF
SECTION 2.

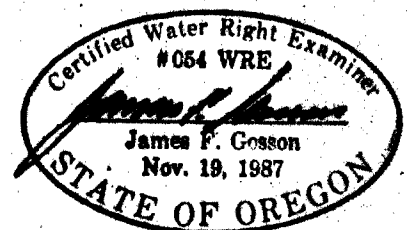

IN THE NAME OF IVAN M. MATTHEWS

SECTION 2, T28S, R8W, W. M.


RECEIVED

JAN 02 1990


WATER RESOURCES DEPT.
SALEM, OREGON



1 INCH = 1320 FEET

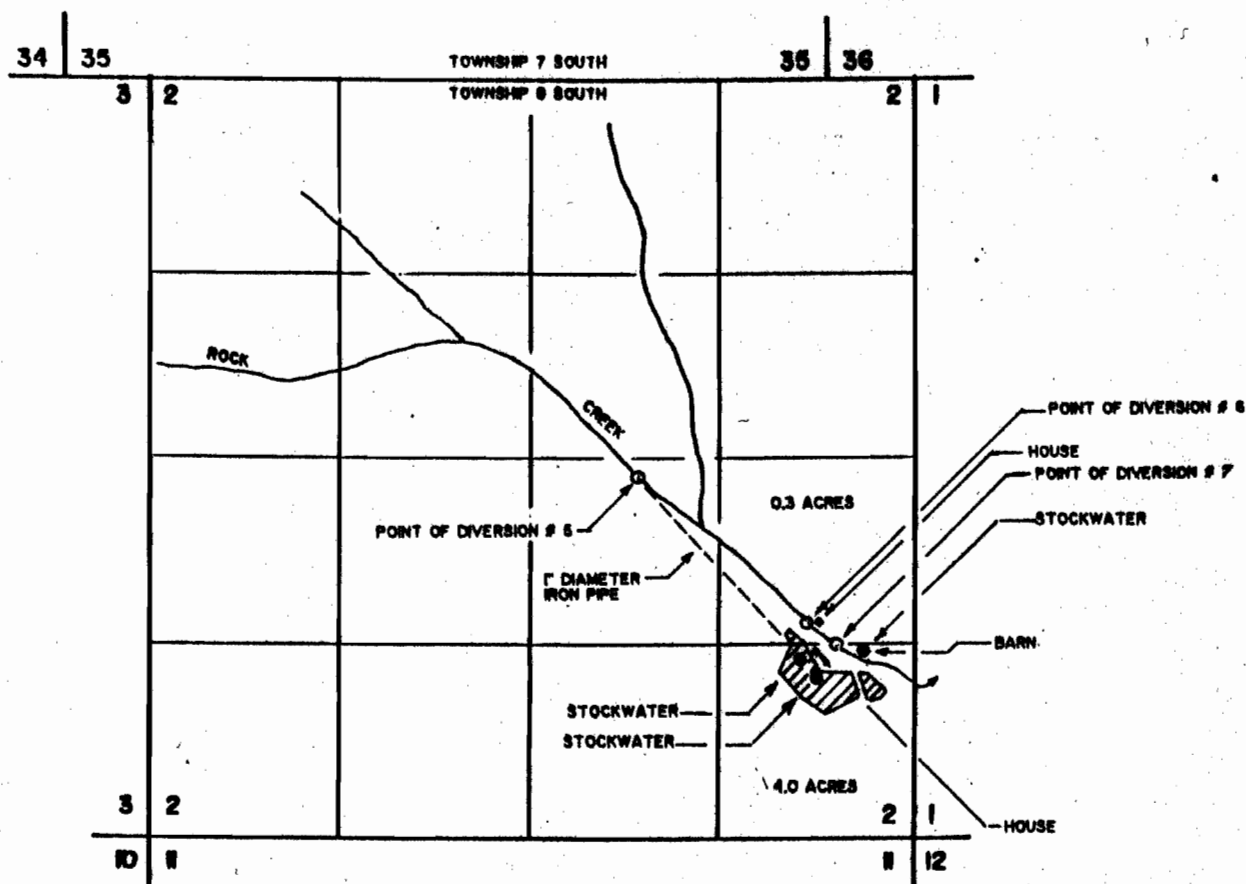

MAP 13 OF 16
1955-1971

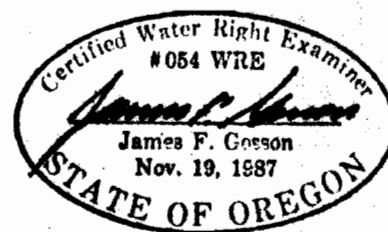

APPLICATION MAP

RECEIVED

IN THE NAME OF IVAN M. MATTHEWS
CLAIMING A RIGHT TO APPROPRIATE SURFACE WATER


JAN 02 1990

SECTION 2, T28S, R8W, W. M.

WATER RESOURCES DEPT.
SALEM, OREGON




1 INCH = 1320 FEET

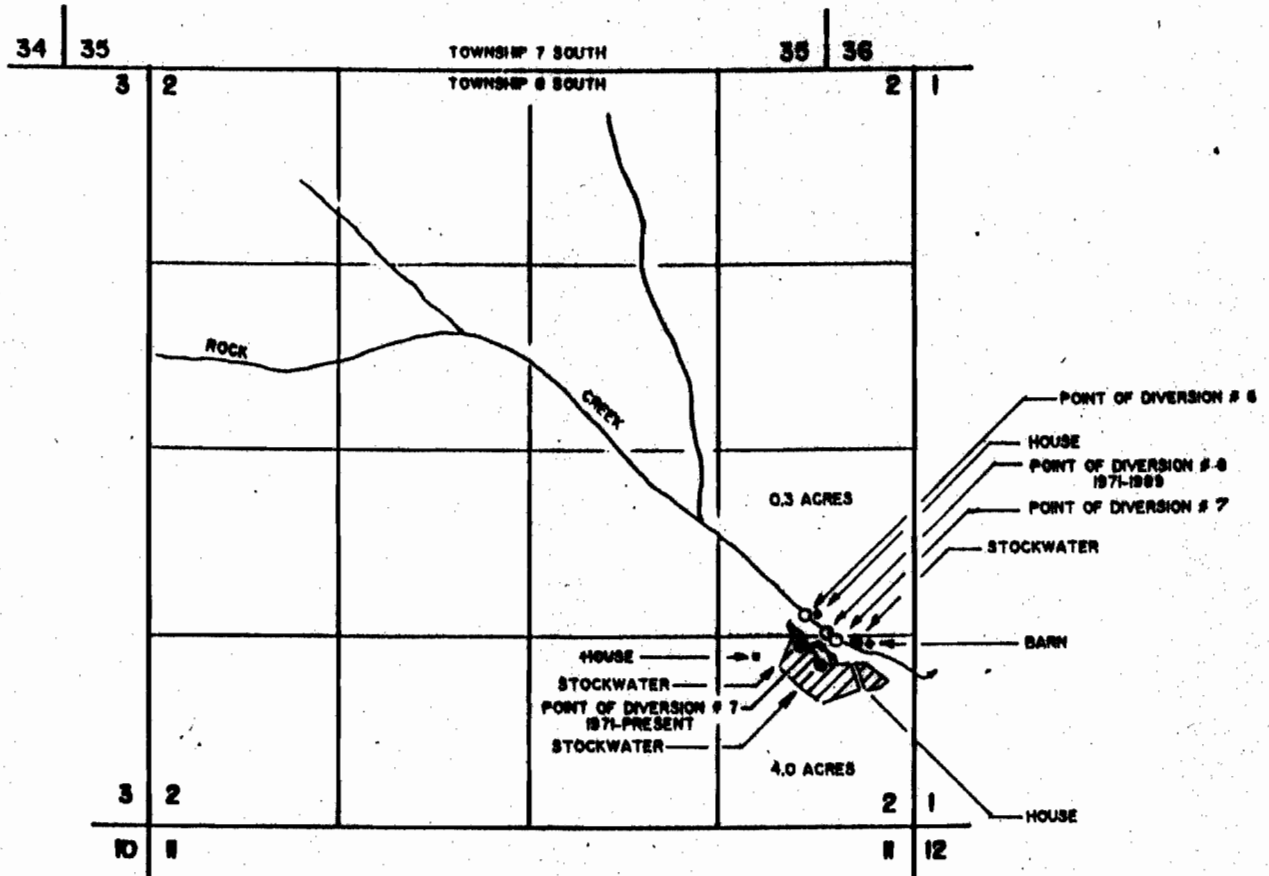

MAP 14 OF 16
1971-1976

POINT OF DIVERSION #8 IS LOCATED 1380 FEET NORTH AND
600 FEET WEST FROM THE SOUTHEAST CORNER OF SECTION 2,
BEING WITHIN THE NORTHEAST 1/4 OF THE SOUTHEAST 1/4 OF
SECTION 2.

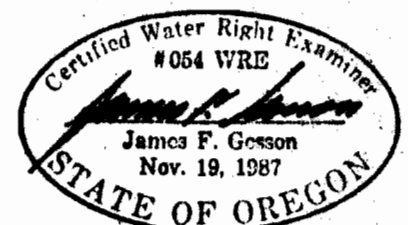

APPLICATION MAP

RECEIVED

IN THE NAME OF IVAN M. MATTHEWS
CLAIMING A RIGHT TO APPROPRIATE SURFACE WATER


JAN 02 1990

SECTION 2, T28S, R8W, W. M.


WATER RESOURCES DEPT.
SALEM, OREGON



1 INCH = 1520 FEET

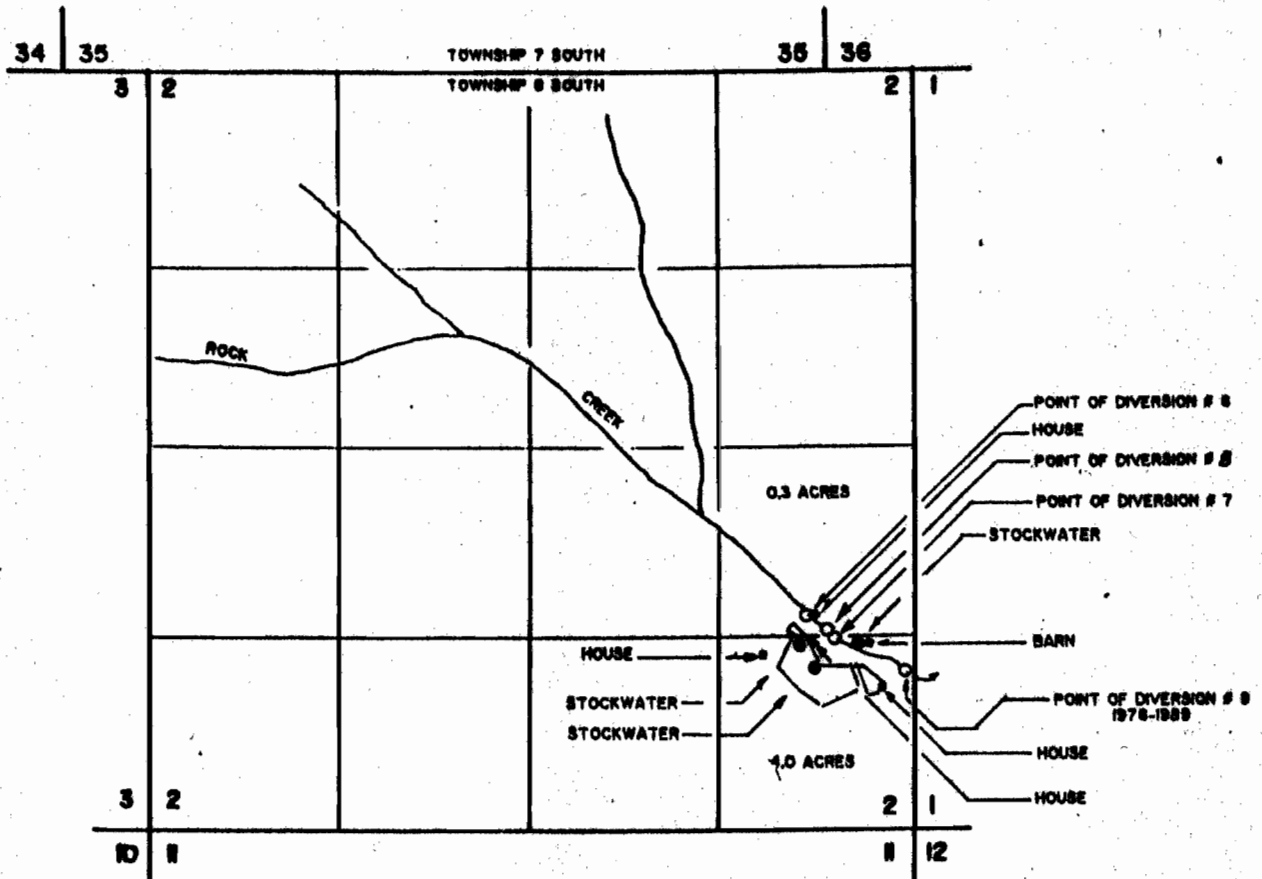

MAP 15 OF 16
1976-1980

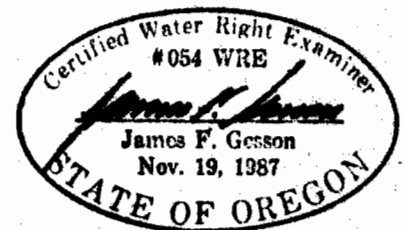


APPLICATION MAP


IN THE NAME OF IVAN M. MATTHEWS
CLAIMING A RIGHT TO APPROPRIATE SURFACE WATER
SECTION 2, T28S, R8W, W. M.



1 INCH = 1320 FEET

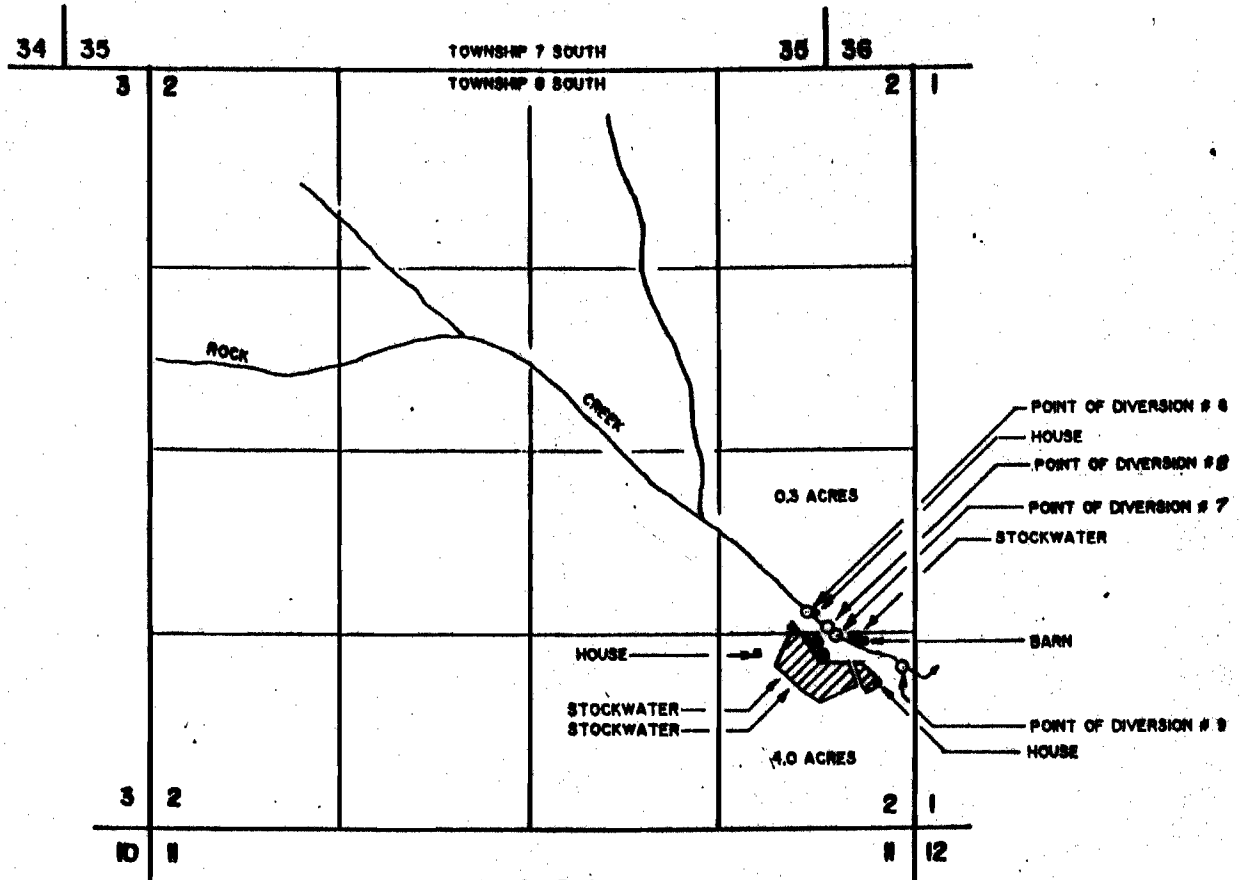

MAP 16 OF 16
1980-1989

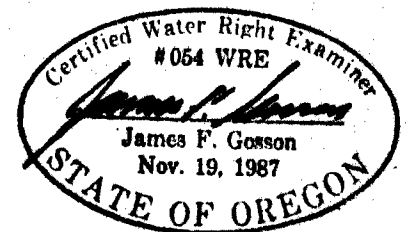

IN THE NAME OF JUAN M. MATTHEWS

RECEIVED


JAN 02 1990

CLAIMING A RIGHT TO APPROPRIATE SURFACE WATER

SECTION 2, T28S, R8W, W. M.


WATER RESOURCES DEPT.
SALEM, OREGON

1 INCH = 1280 FEET

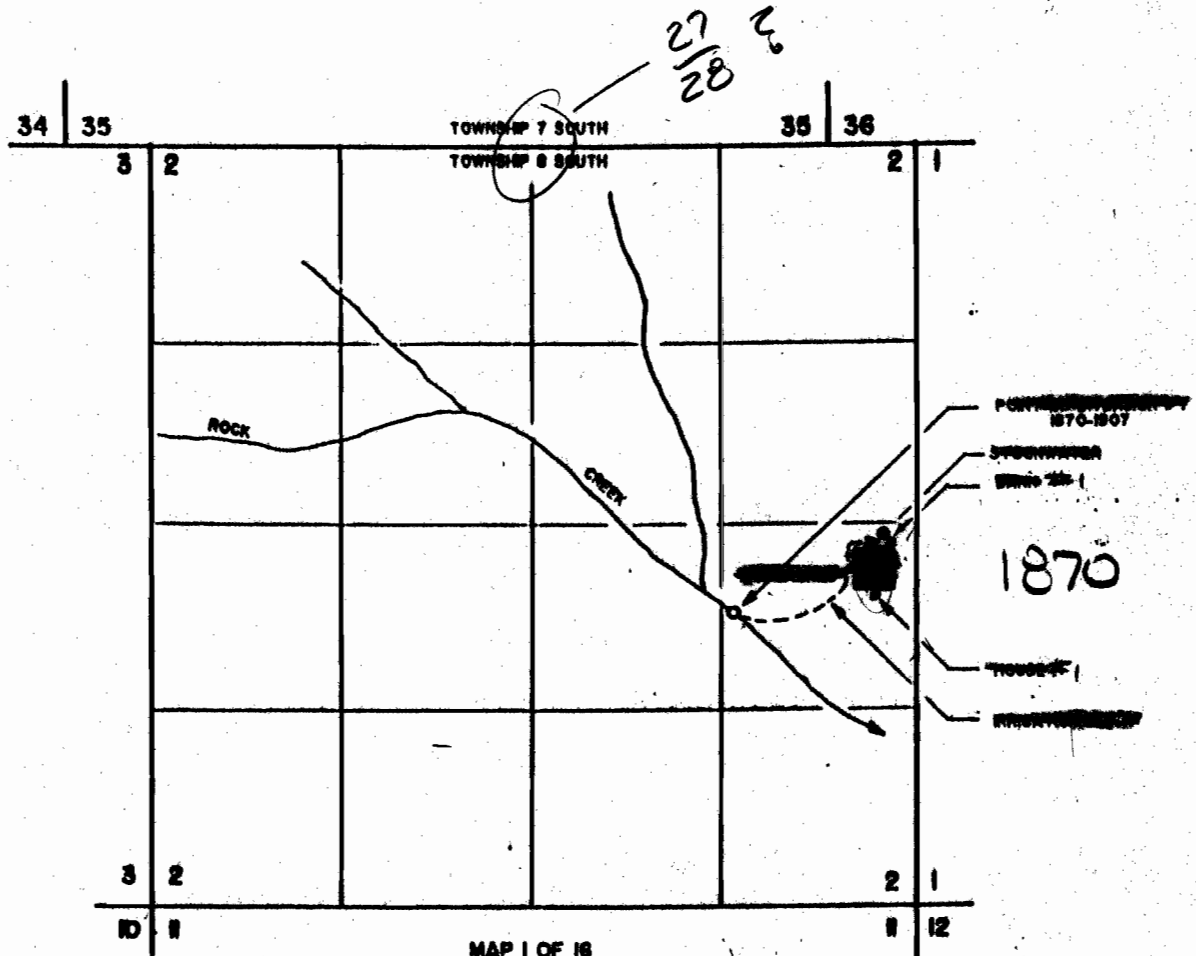

POINT OF DIVERSION #1 WAS LOCATED 1990 FEET NORTH AND 1240 FEET WEST FROM THE SOUTHEAST CORNER OF SECTION 2, BEING WITHIN THE NORTHEAST 1/4 OF THE SOUTHEAST 1/4 OF SECTION 2.

THE PURPOSE OF THESE MAPS ARE TO IDENTIFY THE LOCATION OF THE WATER RIGHT. THEY ARE NOT INTENDED TO PROVIDE INFORMATION RELATIVE TO THE LOCATION OF PROPERTY OWNERSHIP BOUNDARY LINES.

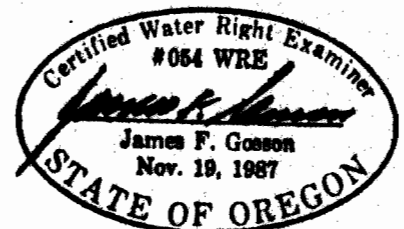


JAN 02 1990

WATER RESOURCES DEPT.
SALEM, OREGON


SECTION 2, T28S, R6W, W. M.

1 INCH = 100 FEET

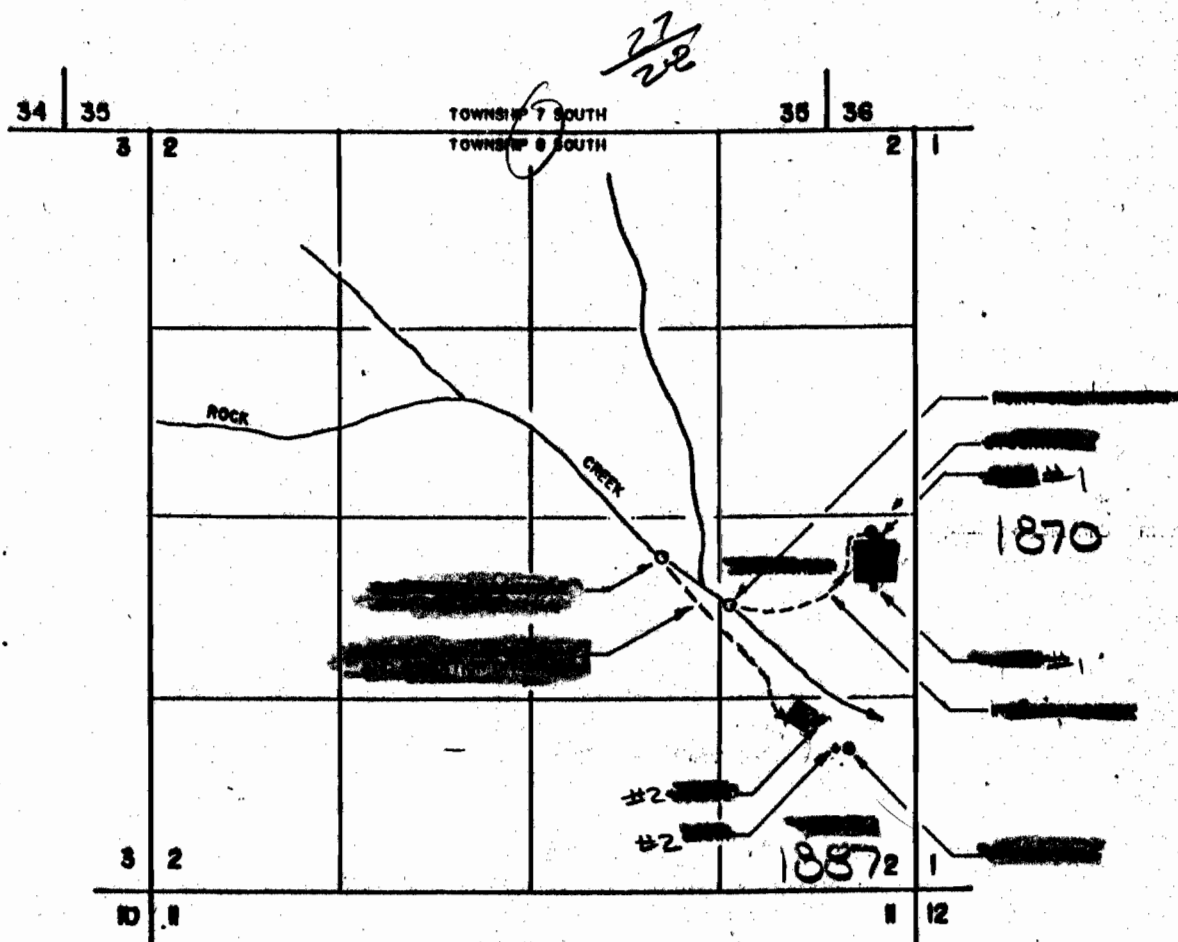

MAP 2 OF 16

POINT OF DIVERSION #2 WAS LOCATED 2360 FEET NORTH AND 1740 FEET WEST FROM THE SOUTHEAST CORNER OF SECTION 2, BEING WITHIN THE NORTHWEST 1/4 OF THE SOUTHEAST 1/4 OF SECTION 2.

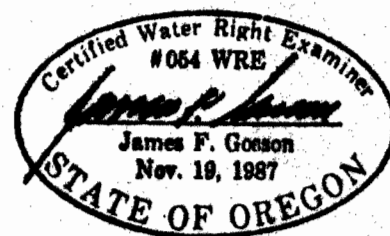

IN THE NAME OF IVAN M. MATTHEWS

CLAIMING A RIGHT TO APPROPRIATE SURFACE WATER



SECTION 2, T28S, R8W, W. M.

RECEIVED

JAN 02 1990

WATER RESOURCES DEPT.
SALEM, OREGON

1 INCH = 1620 FEET

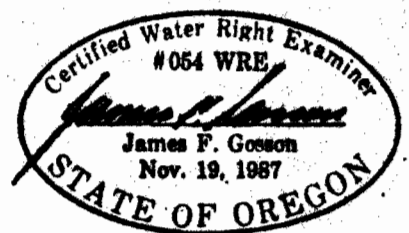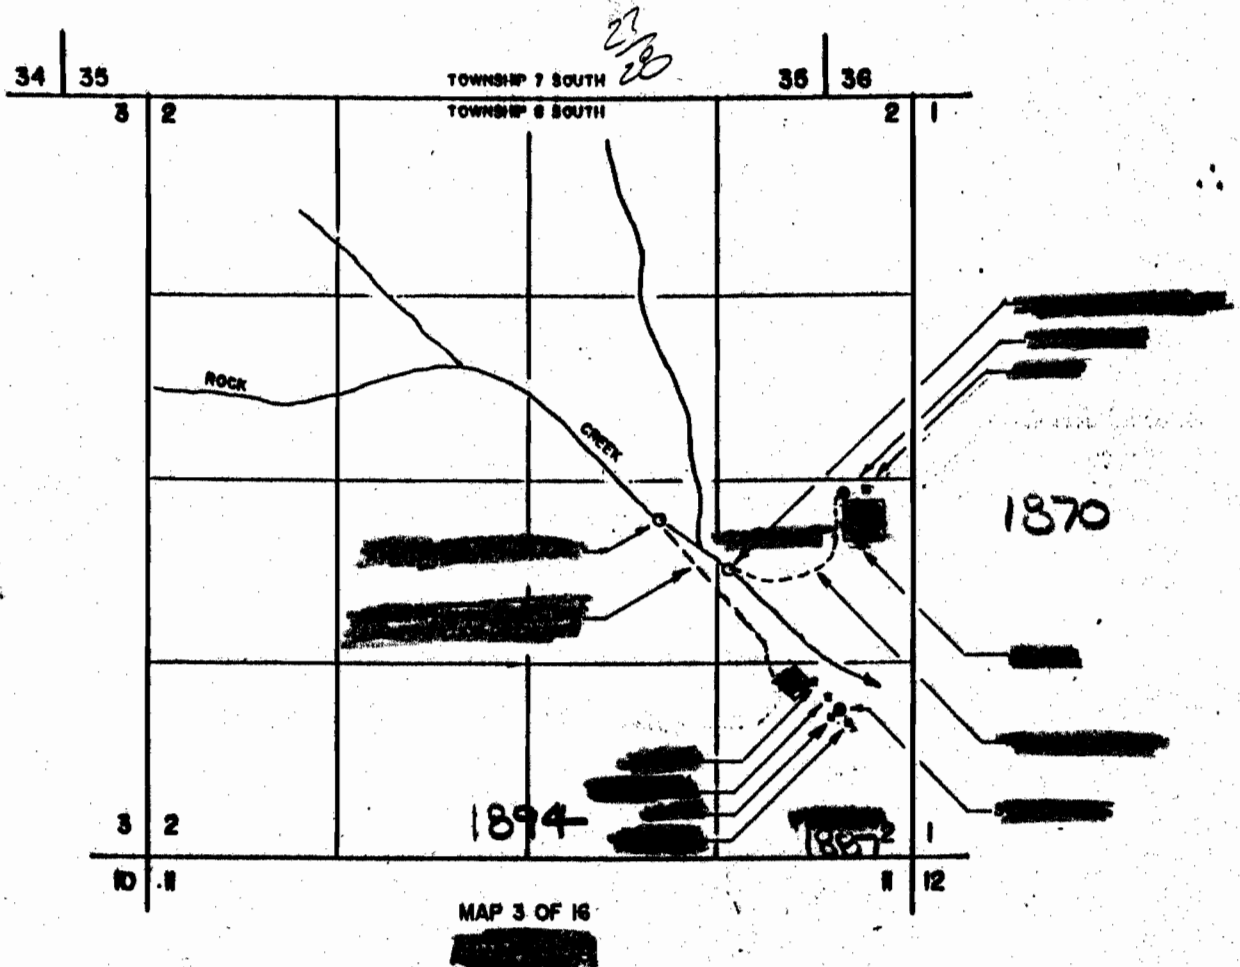

IN THE NAME OF IVAN M. MATTHEWS

RECEIVED



CLAIMING A RIGHT TO APPROPRIATE SURFACE WATER

JAN 02 1990

SECTION 2, T28S, R8W, W. M.

WATER RESOURCES DEPT
SALEM, OREGON

1 INCH = 1320 FEET

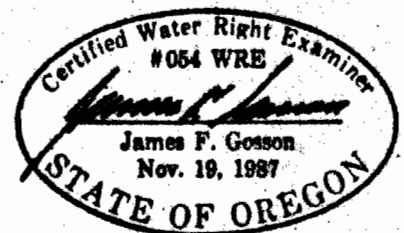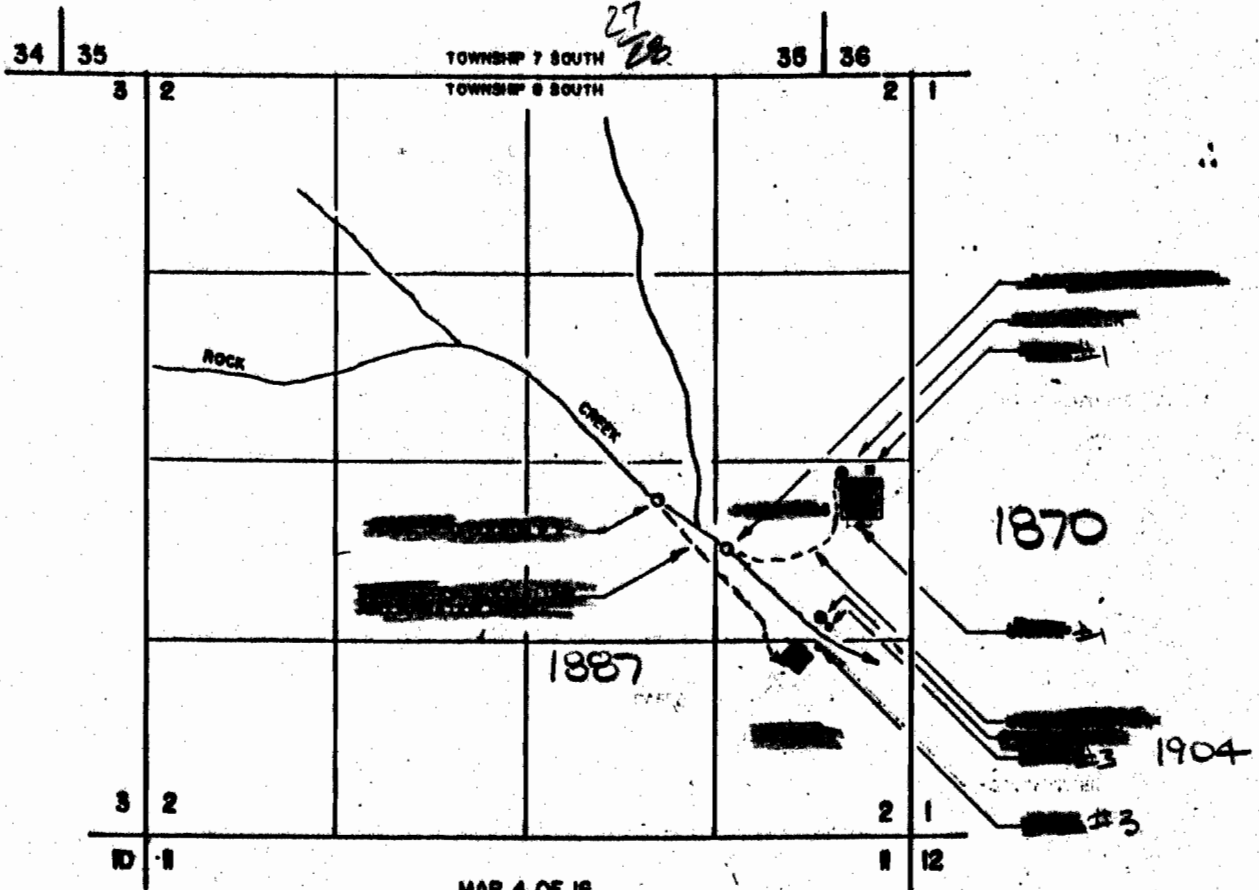

IN THE NAME OF IVAN M. MATTHEWS


CLAIMING A RIGHT TO APPROPRIATE SURFACE WATER

SECTION 2, T28S, R8W, W. M.


JAN 02 1990

WATER RESOURCES DEPT.
SALEM, OREGON

1 INCH = 1500 FEET

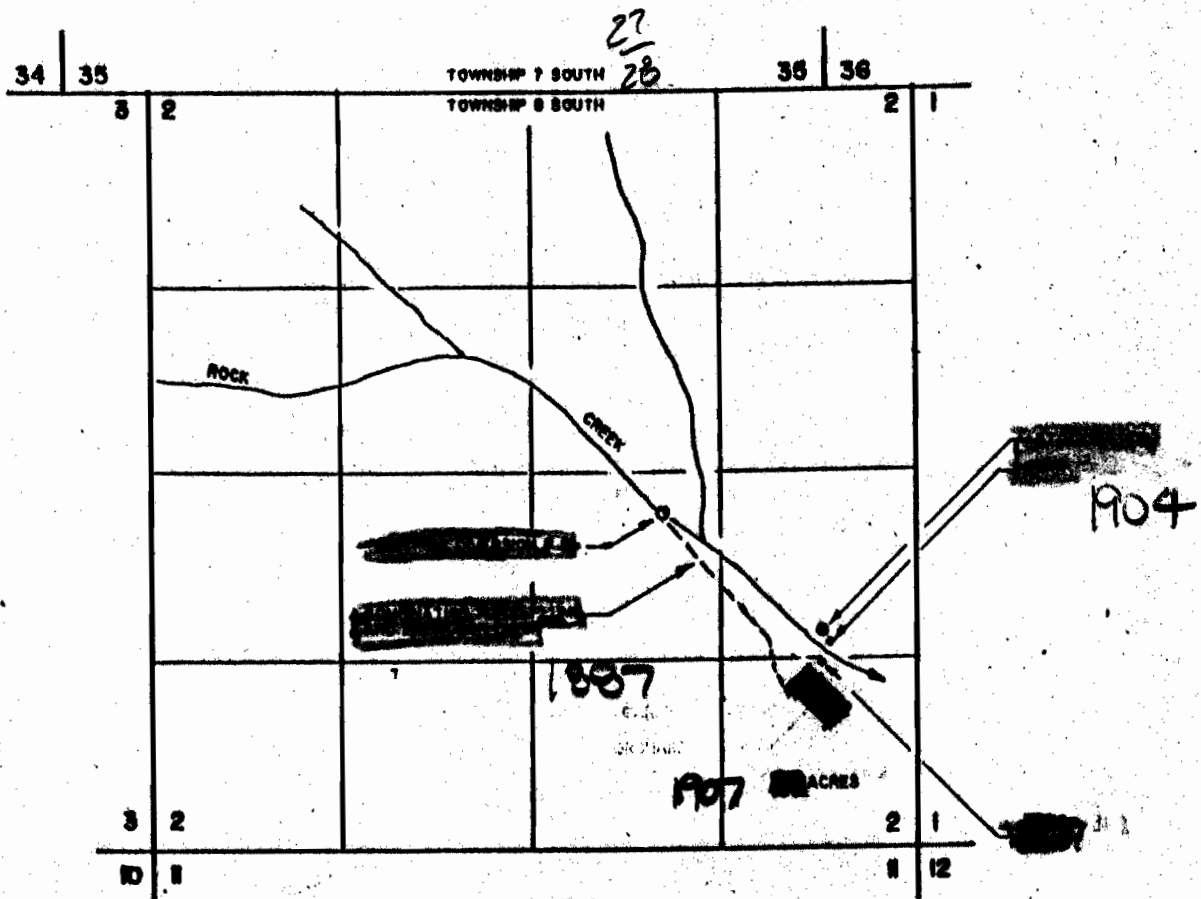

THIS MAP WAS PREPARED BY THE WATER RESOURCES DEPARTMENT OF THE STATE OF OREGON, SALEM, OREGON, IN ACCORDANCE WITH THE WATER RESOURCES ACT, CHAPTER 536, ORS, AS AMENDED.

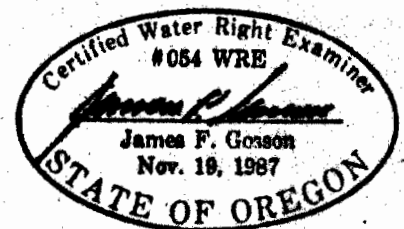

JAN 02 1990

IN THE NAME OF IVAN M. MATTHEWS

SECTION 2, T28S, R8W, W. M.

34 | 35 | 36

TOWNSHIP 7 SOUTH

TOWNSHIP 8 SOUTH

27
28

3 | 2 | 1

ROCK CREEK

1887


1907

STOCKWATER

BARN

MAP 6 OF 16

1927-1929

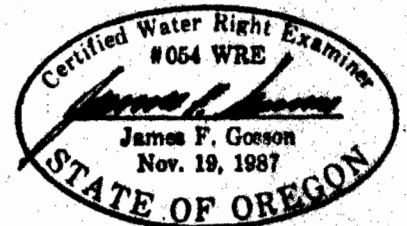

IN THE NAME OF IVAN M. MATTHEWS

RECEIVED



CLAIMING A RIGHT TO APPROPRIATE SURFACE WATER

JAN 02 1990

SECTION 2, T28S, R9W, W. M.

WATER RESOURCES DEPT.
SALEM, OREGON

1 INCH = 1920 FEET

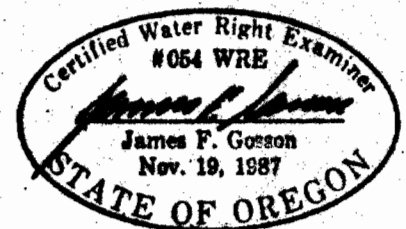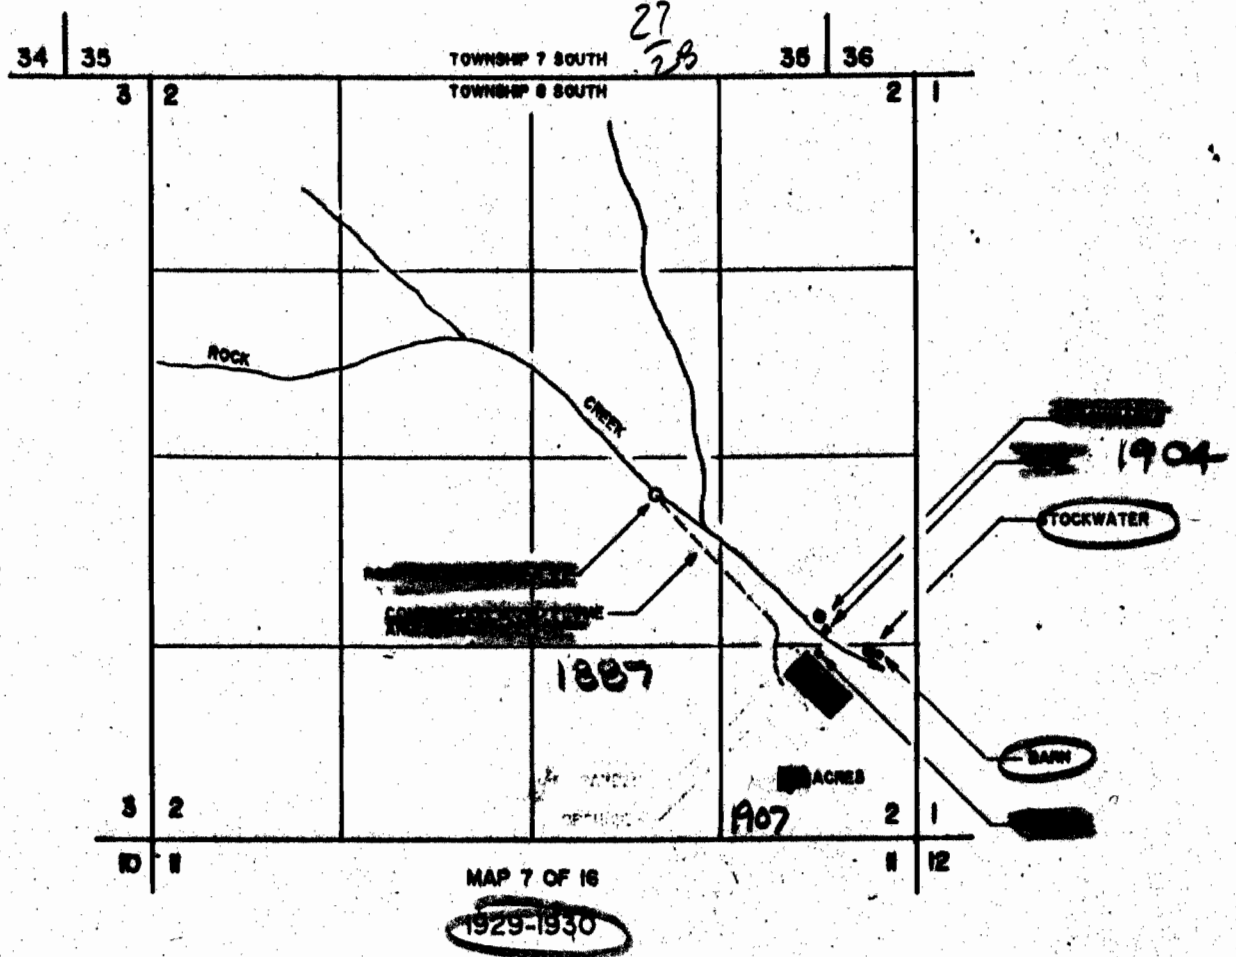

APPLICATION MAP


RECEIVED

IN THE NAME OF IVAN M. MATTHEWS
CLAIMING A RIGHT TO APPROPRIATE SURFACE WATER
SECTION 2, T28S, R8W, W. M.


JAN 02 1990

WATER RESOURCES DEPT
SALEM, OREGON

1 INCH = 1280 FEET

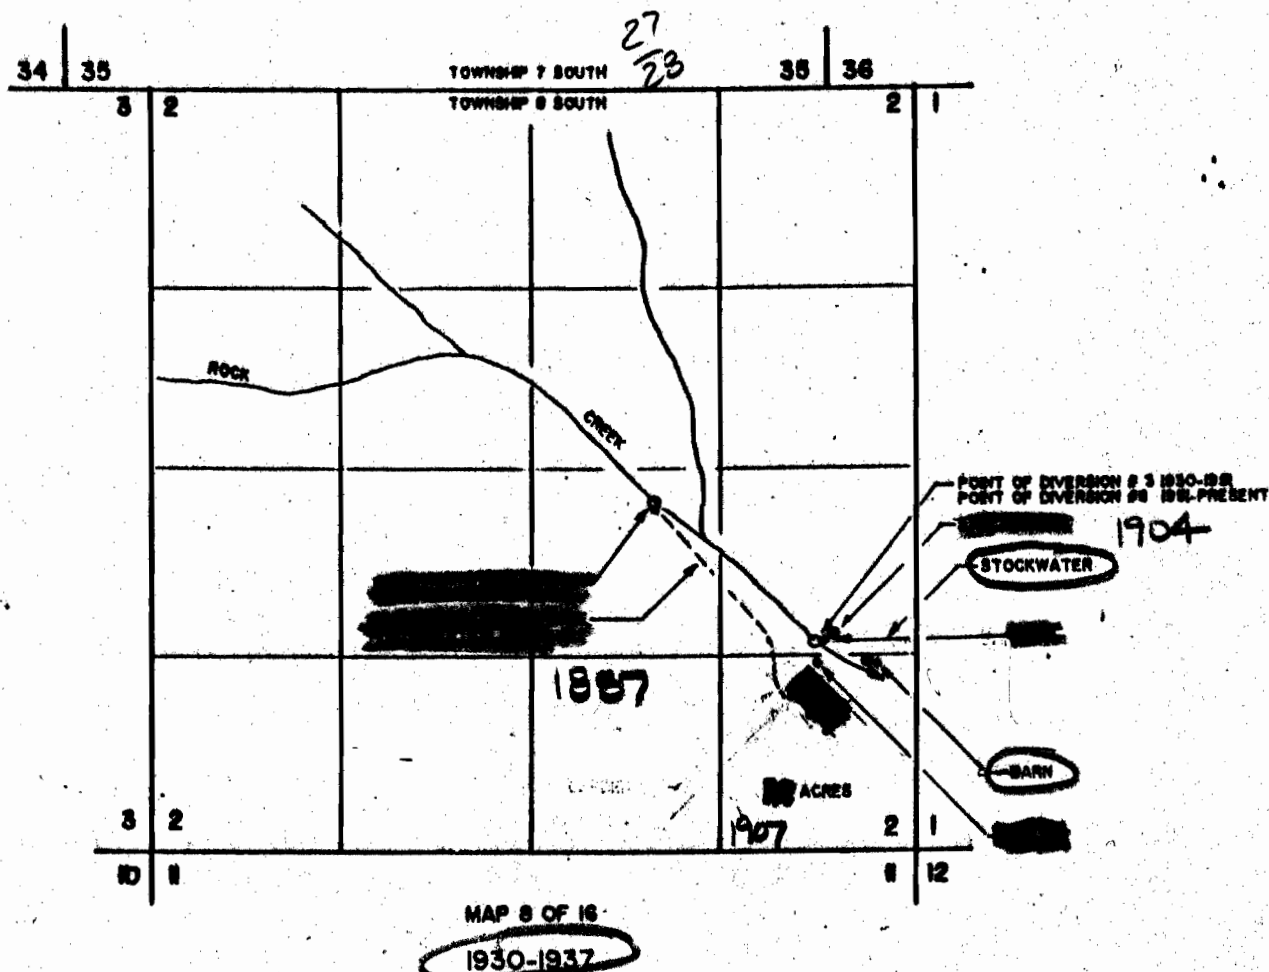

POINTS OF DIVERSION #3 AND #6 ARE LOCATED 1420 FEET NORTH
AND 700 FEET WEST FROM THE SOUTHEAST CORNER OF SECTION 2,
BEING WITHIN THE NORTHEAST 1/4 OF THE SOUTHEAST 1/4 OF
SECTION 2.

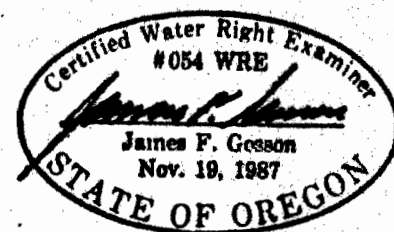

IN THE NAME OF IVAN M. MATTHEWS

RECEIVED


CLAIMING A RIGHT TO APPROPRIATE SURFACE WATER

JAN 02 1990

SECTION 2, T28S, R6W, W. M.


WATER RESOURCES DEPT
SALEM, OREGON

1 INCH = 1280 FEET

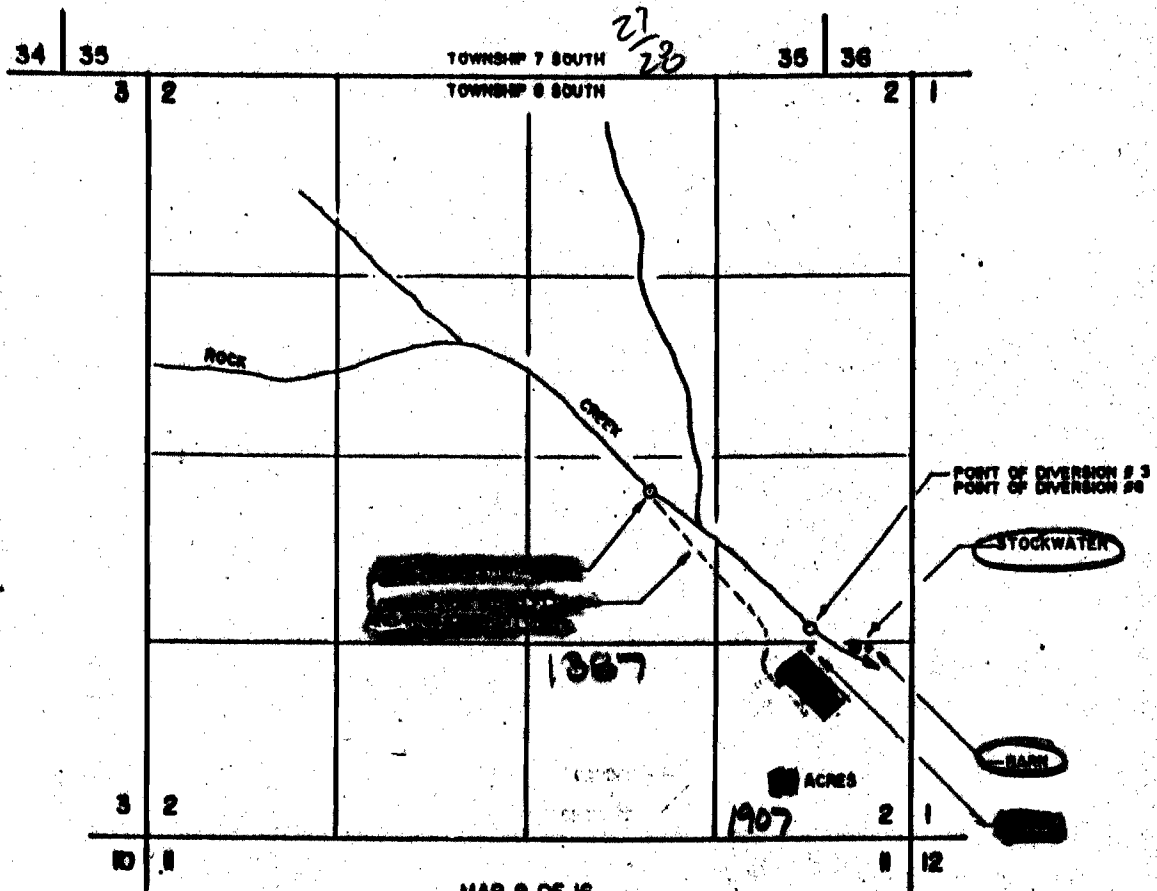

MAP 9 OF 16

1937-1938

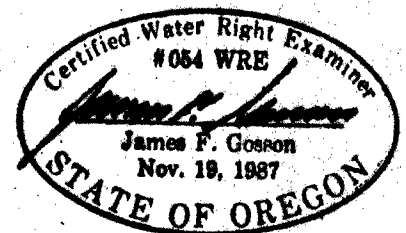

IN THE NAME OF IVAN M. MATTHEWS

CLAIMING A RIGHT TO APPROPRIATE SURFACE WATER


SECTION 2, T28S, R8W, W. M.

RECEIVED


JAN 02 1990

WATER RESOURCES DEPT.
SALEM, OREGON

1 INCH = 1520 FEET

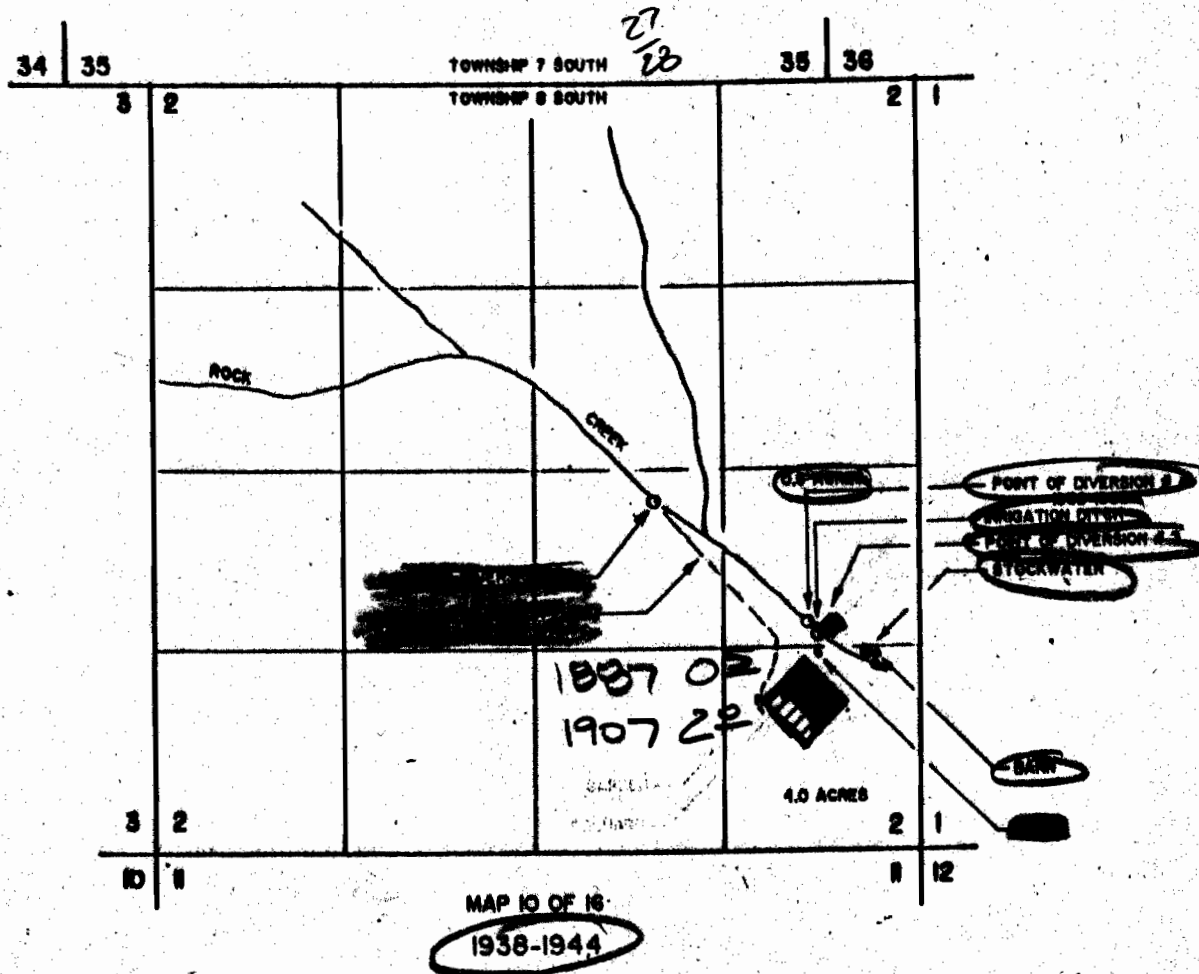

POINT OF DIVERSION #4 WAS LOCATED 1530 FEET NORTH AND
780 FEET WEST FROM THE SOUTHEAST CORNER OF SECTION 2,
BEING WITHIN THE NORTHEAST 1/4 OF THE SOUTHEAST 1/4 OF
SECTION 2.

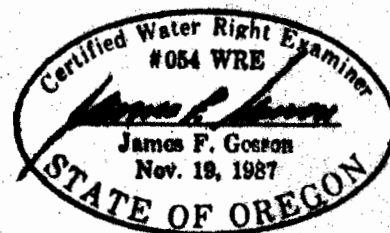


RECEIVED

JAN 02 1990

WATER RESOURCES DEPT.
SALEM, OREGON

POINT OF DIVERSION #5 WAS LOCATED 2480 FEET NORTH AND 1900 FEET WEST FROM THE SOUTHEAST CORNER OF SECTION 2, BEING WITHIN THE NORTHWEST 1/4 OF THE SOUTHEAST 1/4 OF SECTION 2.

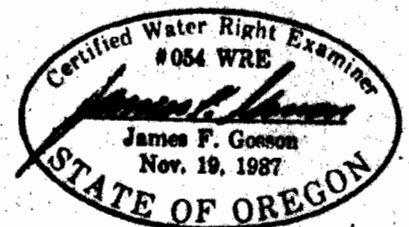

IN THE NAME OF IVAN M. MATTHEWS

CLAIMING A RIGHT TO APPROPRIATE SURFACE WATER


SECTION 2, T28S, R8W, W. M.

RECEIVED


JAN 02 1990

WATER RESOURCES DEPT
SALEM, OREGON

1 INCH = 1280 FEET

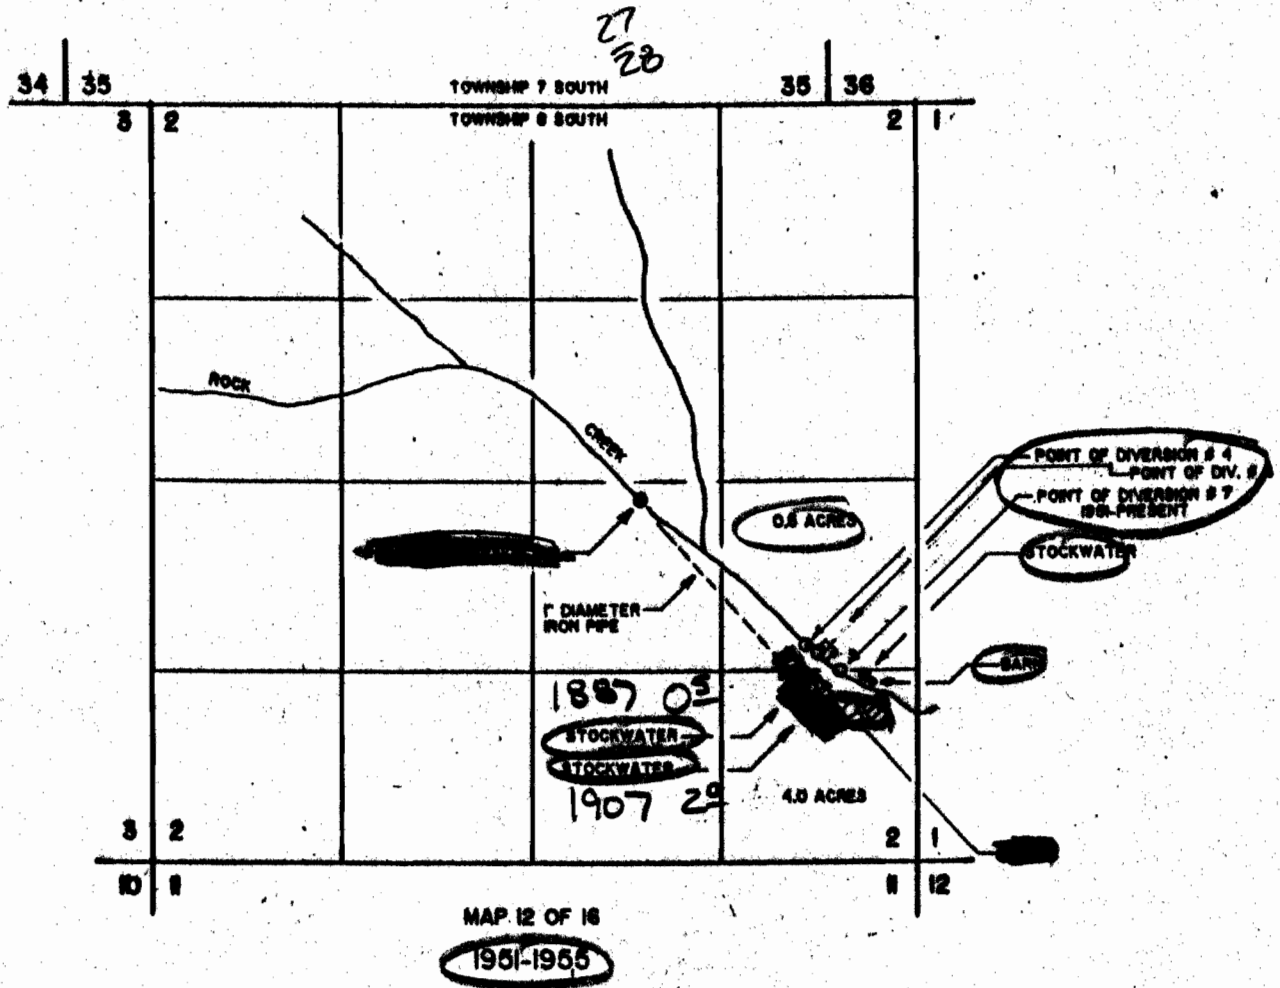

POINT OF DIVERSION #9 IS LOCATED 1300 FEET NORTH AND
820 FEET WEST FROM THE SOUTHEAST CORNER OF SECTION 2,
BEING WITHIN THE SOUTHEAST 1/4 OF THE SOUTHEAST 1/4 OF
SECTION 2.

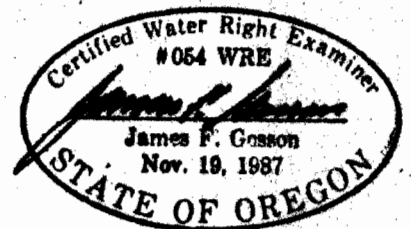

IN THE NAME OF IVAN M. MATTHEWS


CLAIMING A RIGHT TO APPROPRIATE SURFACE WATER

SECTION 2, T25S, R8W, W. M.

JAN 02 1990


WATER RESOURCES DEPT.
SALEM, OREGON

1 INCH = 1220 FEET

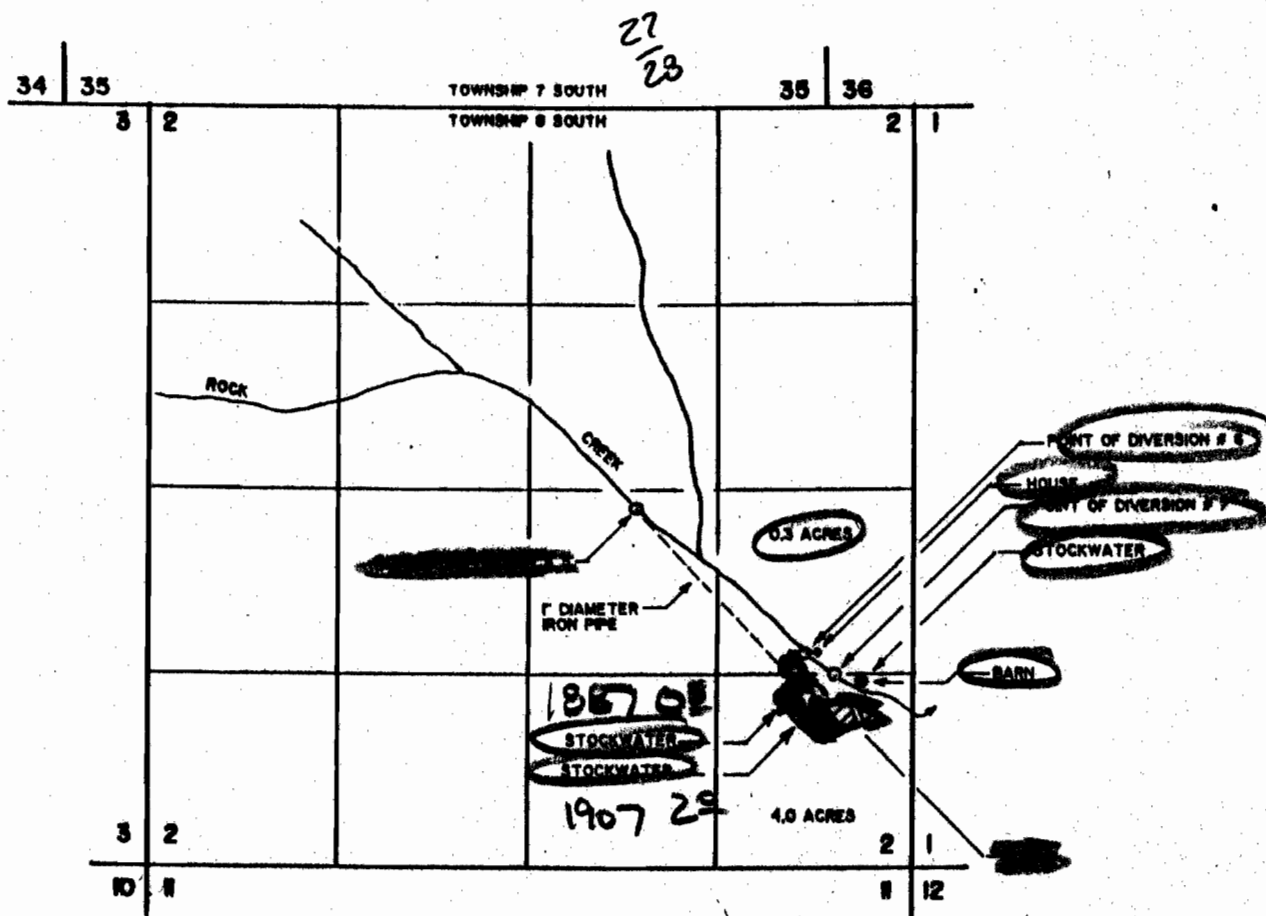

MAP 13 OF 16

1955-1971

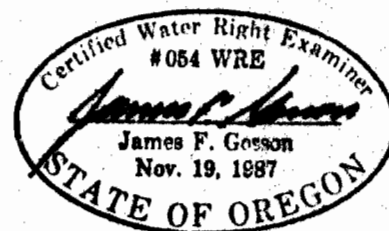


RECEIVED

JAN 02 1990


WATER RESOURCES DEPT.
SALEM, OREGON

IN THE NAME OF IVAN M. MATTHEWS
CLAIMING A RIGHT TO APPROPRIATE SURFACE WATER
SECTION 2, T29S, R8W, W. M.

1 INCH = 1320 FEET


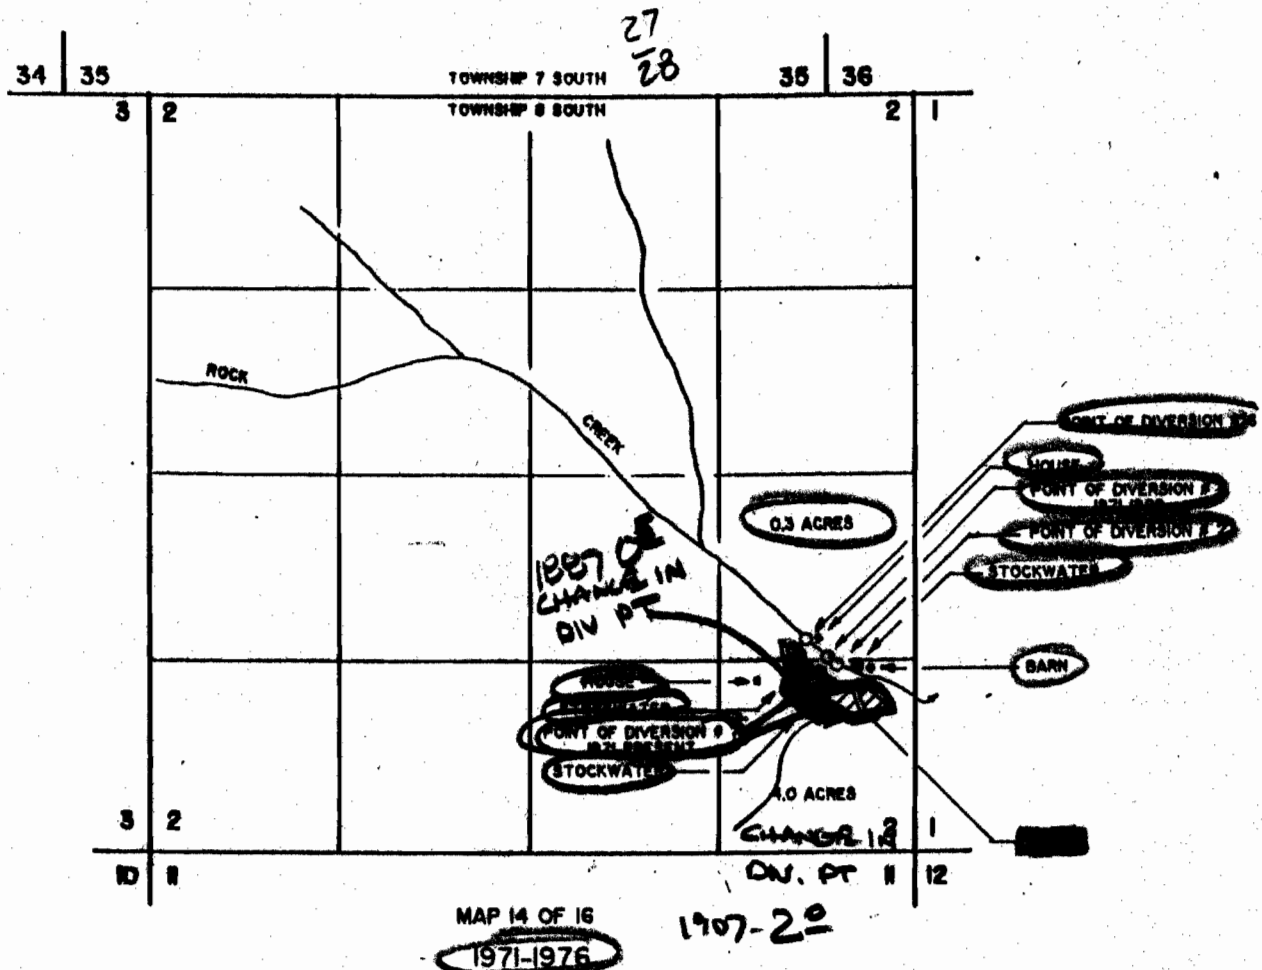


POINT OF DIVERSION #8 IS LOCATED 1380 FEET NORTH AND
600 FEET WEST FROM THE SOUTHEAST CORNER OF SECTION 2,
BEING WITHIN THE NORTHEAST 1/4 OF THE SOUTHEAST 1/4 OF
SECTION 2.


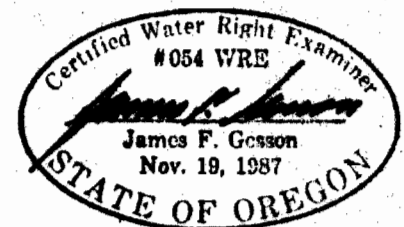


WATER RESOURCES DEPT.
SALEM, OREGON

1 INCH = 1320 FEET

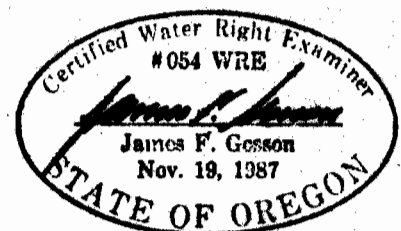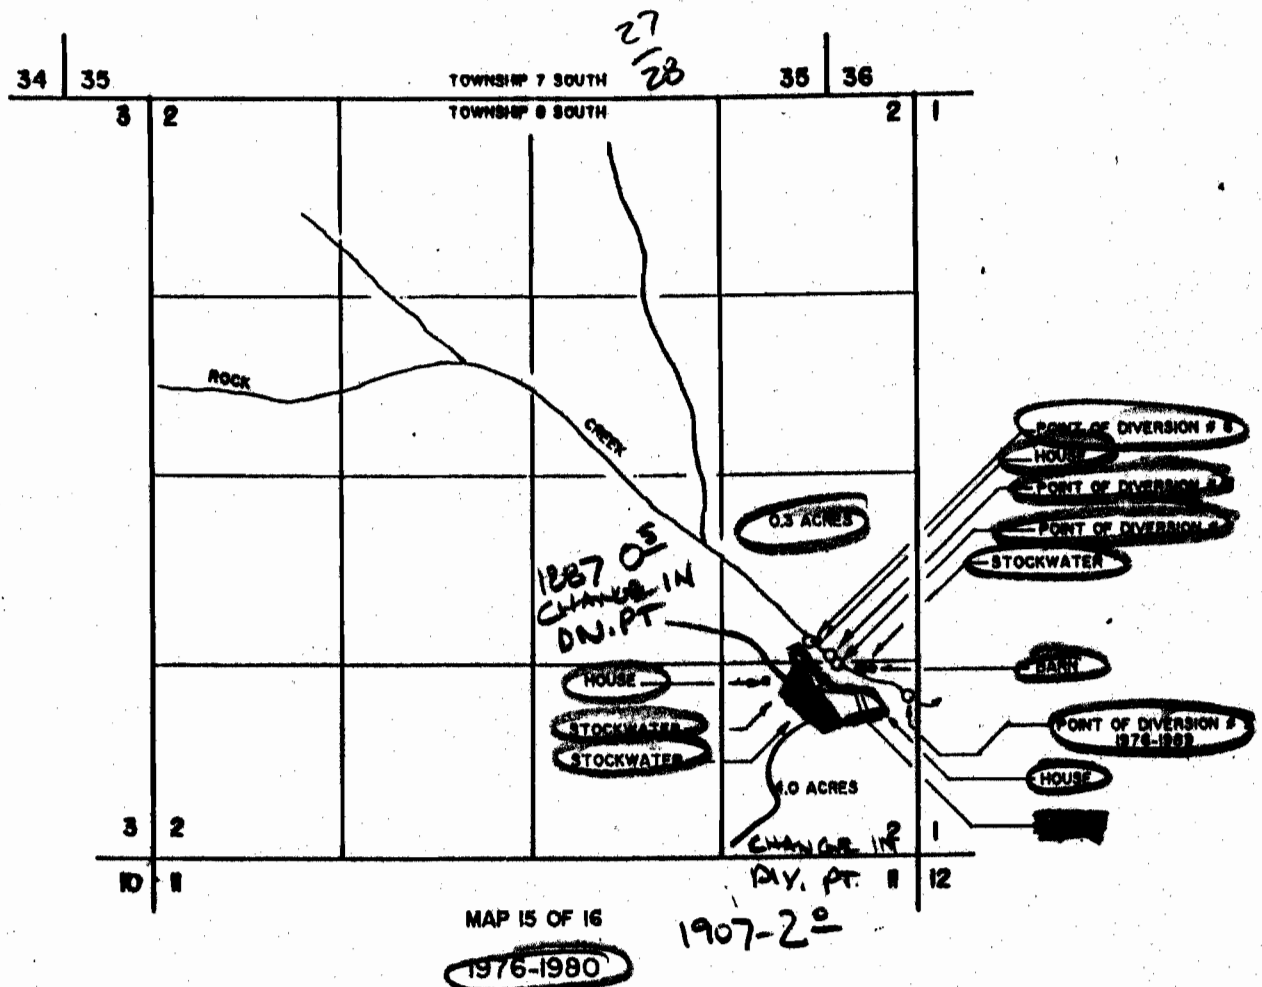

1 INCH = 1320 FEET

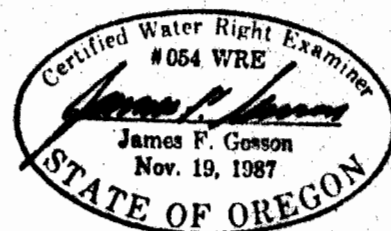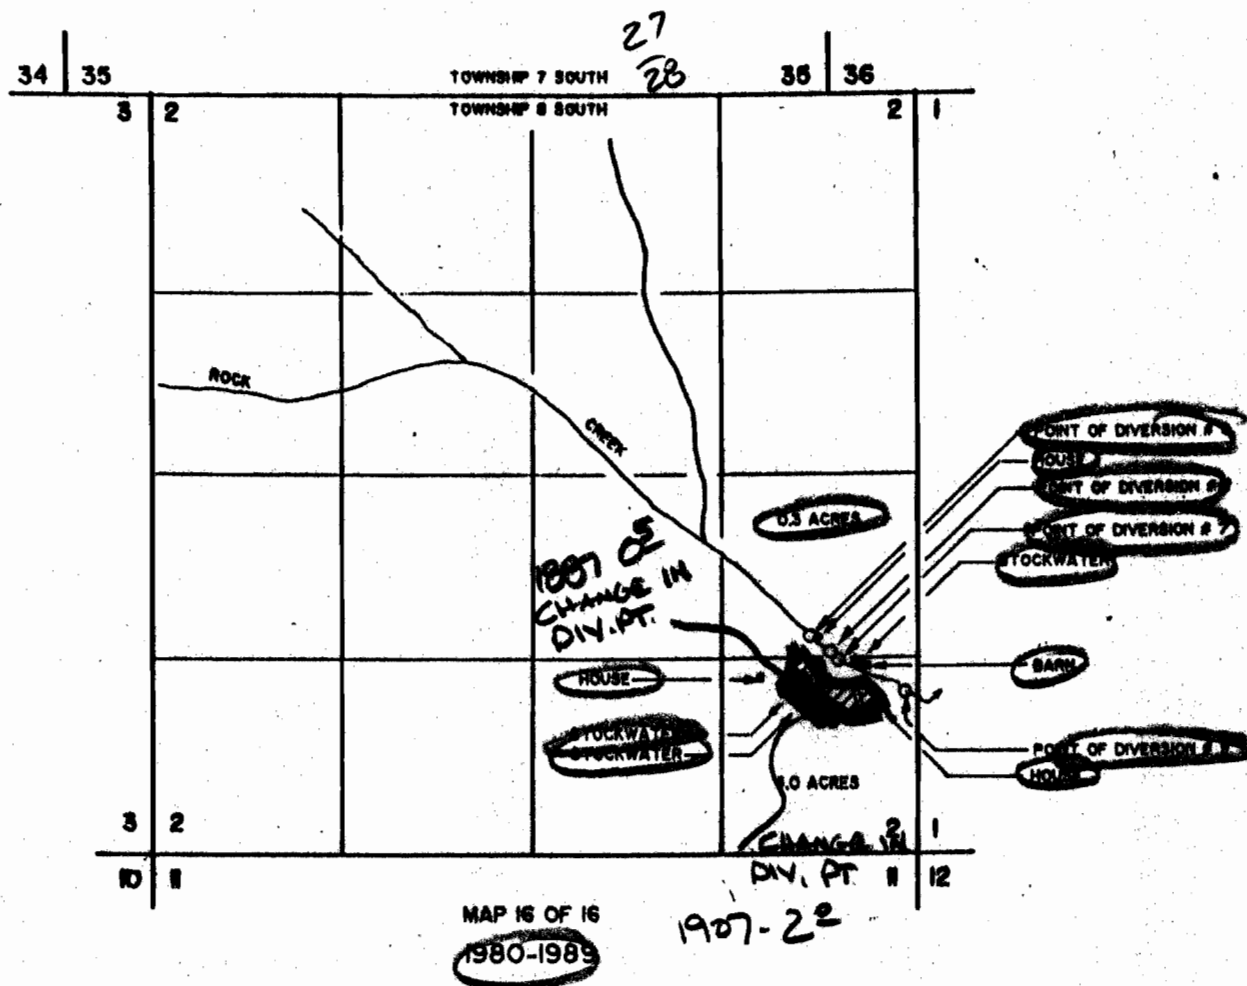



STATE OF OREGON

INTEROFFICE MEMO

TO: SWR #9 (Ivan Matthews) File

DATE: September 27, 1990

FROM: Don Knauer

SUBJECT: Registration Statement Review

Form: #3 What amount of water for domestic?
What amount for stock?
What amount for irrigation?

33% of 0.045 = 0.01485 = 0.015
25% of 0.045 = 0.01125 = 0.011
58% of 0.045 = 0.0261 = 0.026
42% of 0.0189 = 0.019
0.095

#4 Dates: 1870, for what?
1887, for what?

#6 Area intended 2.0
then

#7 Total 2.5 What is the deal?

~~#8 Fill it in.~~

Maps: 1870 = 2 ac irri = stockwater domestic?
1887 = 1/2 ac irri = stockwater = domestic?
1894 = sawmill
1904 = stockwater
1907 = 2 ac irri
1971 = change in div. pt. 1887 & 1907
1980 = change in house for domestic

OK
CHANGE IN PLACE & DIV. PT.

May have a claim to 1887 1/2 ac irri and domestic, and 1907 2 ac irri.

Done by Gosson, Roseburg.

Check areas on maps.

0658

SURFACE WATER REGISTRATION CHECKLIST

(Received Prior to July 18, 1990)

UNADJUDICATED DRAINAGE? YES

SWR # 9

RECEIPT # 60615

CHECK TO SEE IF ENCLOSURES ARE THERE 8-23-90 PER

ACKNOWLEDGEMENT LETTER ✓

ENTER ON STREAM INDEX ✓

CHECK BASIN MAP 8-23-90 PER

BASIN 16

CHECK QUADRANGLE MAP _____

GLO PLATS _____ (NOT IN OUR FILES!)

REVIEW FORM:

- ✓ Blanks filled out
- ✓ Signed
- ✓ Date received stamped
- PER Date received filled out

MAP:

- ✓ Location of diversion point to govt corner
- ✓ pipelines, canals, ditches, etc
- ✓ Place of use
- ✓ Scale
- ✓ Section, Township, Range
- ✓ North arrow
- ✓ CWRE Stamp

WATER RIGHT RECORD CHECK _____

A ?

ENTER ON PLAT CARDS ✓

RECEIVED

IN THE NAME OF IVAN M. MATTHEWS


JAN 02 1990

CLAIMING A RIGHT TO APPROPRIATE SURFACE WATER

SECTION 2, T28S, R8W, W. M.


WATER RESOURCES DEPT.
SALEM, OREGON

1 INCH = 1320 FEET

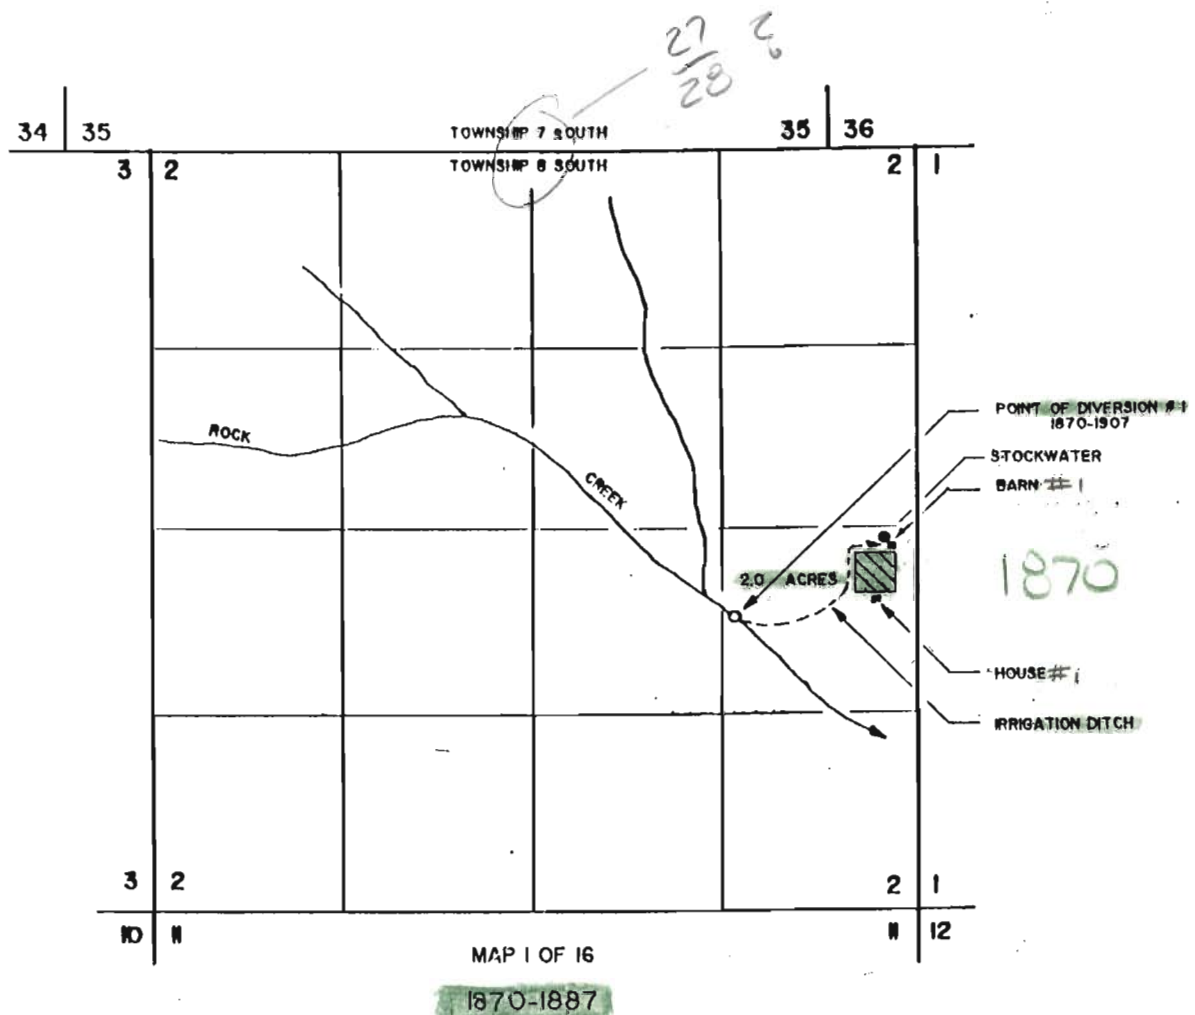

POINT OF DIVERSION #1 WAS LOCATED 1990 FEET NORTH AND 1240 FEET WEST FROM THE SOUTHEAST CORNER OF SECTION 2, BEING WITHIN THE NORTHEAST 1/4 OF THE SOUTHEAST 1/4 OF SECTION 2.

THE PURPOSE OF THESE MAPS ARE TO IDENTIFY THE LOCATION OF THE WATER RIGHT. THEY ARE NOT INTENDED TO PROVIDE INFORMATION RELATIVE TO THE LOCATION OF PROPERTY OWNERSHIP BOUNDARY LINES.

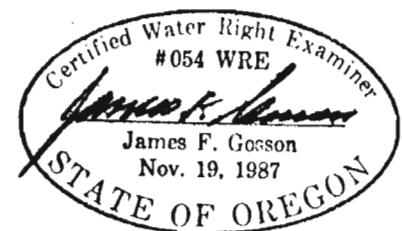

RECEIVED

JAN 02 1990

IN THE NAME OF IVAN M. MATTHEWS


CLAIMING A RIGHT TO APPROPRIATE SURFACE WATER

SECTION 2, T28S, R8W, W. M.

WATER RESOURCES DEPT.
SALEM, OREGON




1 INCH = 1320 FEET

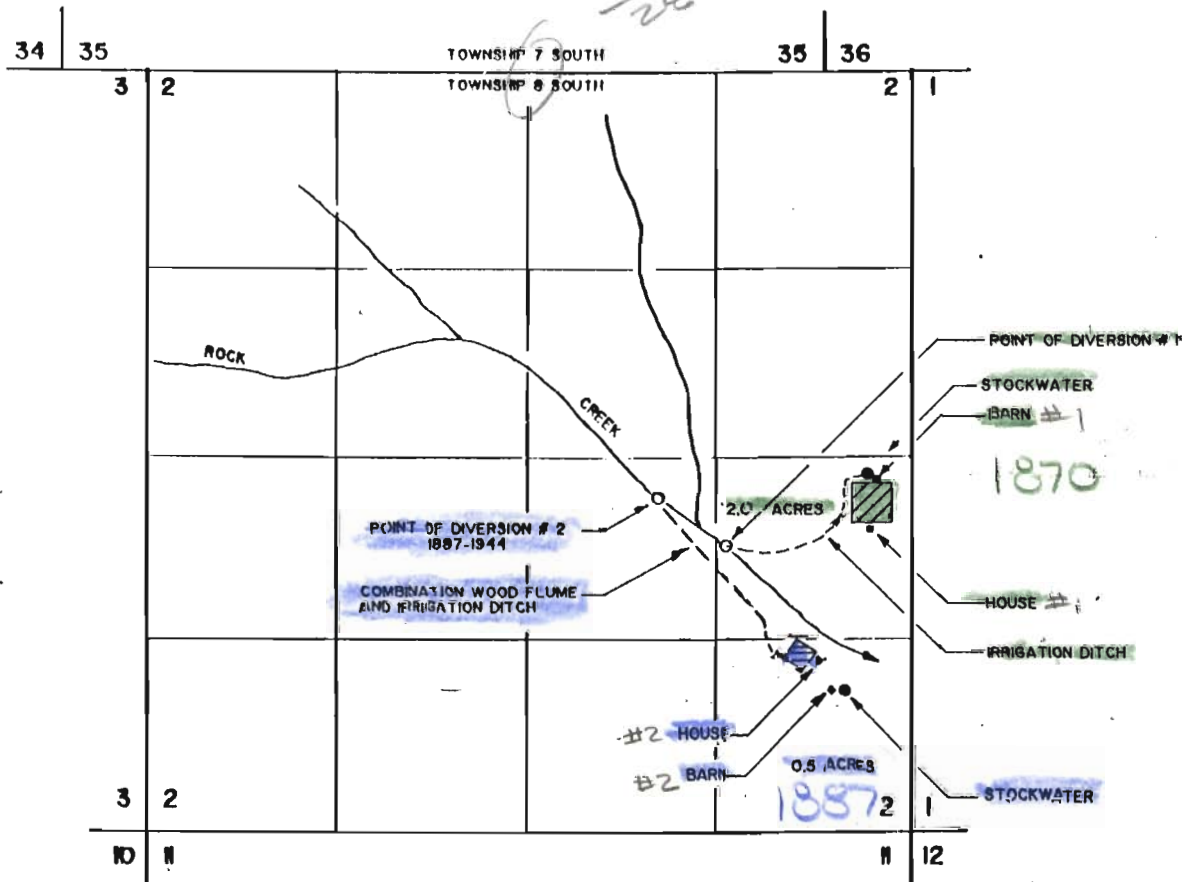

MAP 2 OF 16

1887-1894

POINT OF DIVERSION #2 WAS LOCATED 2360 FEET NORTH AND 1740 FEET WEST FROM THE SOUTHEAST CORNER OF SECTION 2, BEING WITHIN THE NORTHWEST 1/4 OF THE SOUTHEAST 1/4 OF SECTION 2.

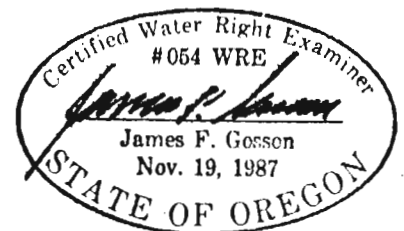

IN THE NAME OF IVAN M. MATTHEWS

CLAIMING A RIGHT TO APPROPRIATE SURFACE WATER

SECTION 2, T28S, R8W, W. M.



RECEIVED

JAN 02 1990

WATER RESOURCES DEPT.
SALEM, OREGON



1 INCH = 1320 FEET

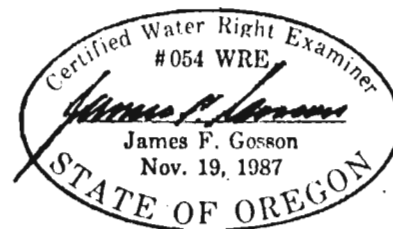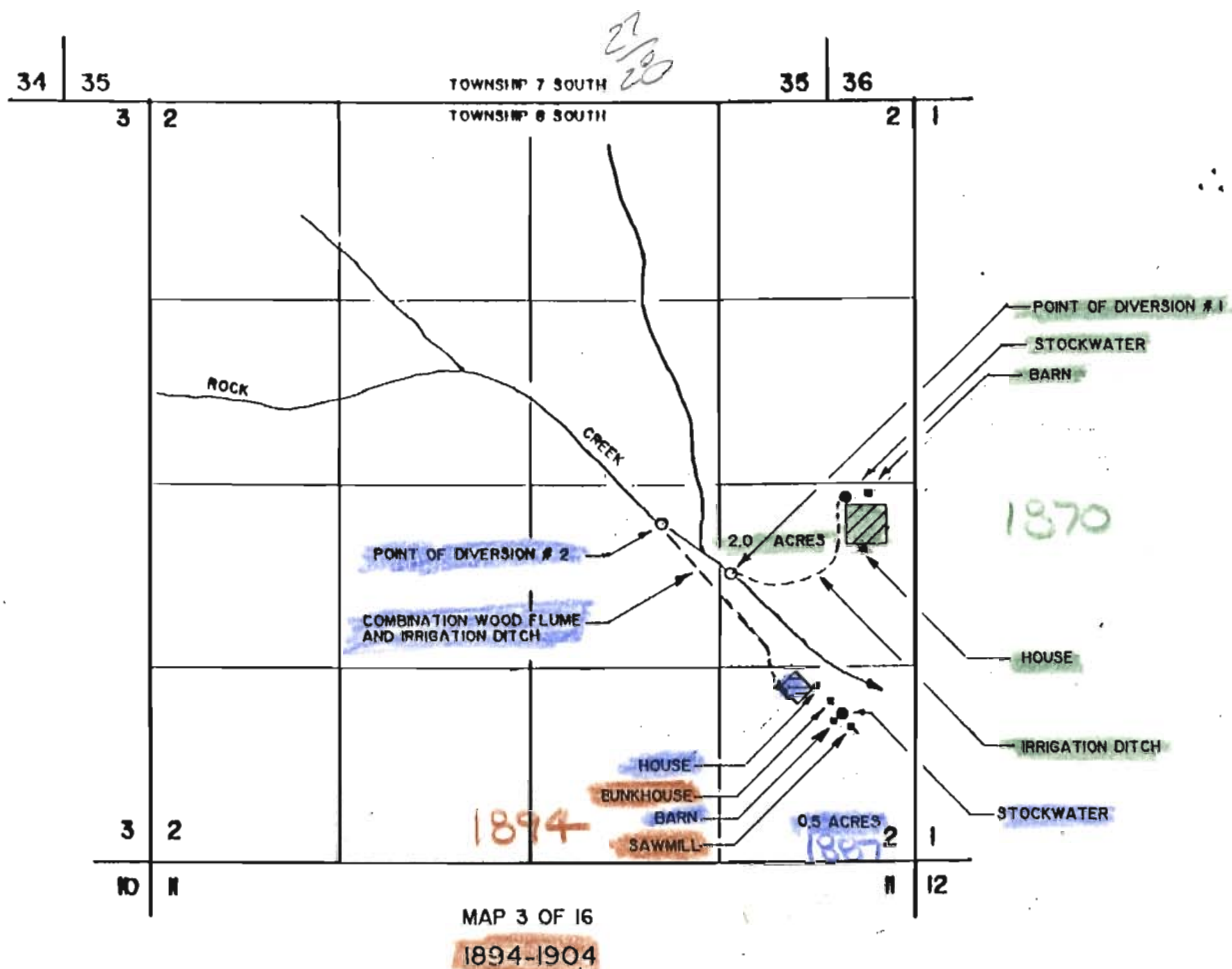

APPLICATION MAP

IN THE NAME OF IVAN M. MATTHEWS

CLAIMING A RIGHT TO APPROPRIATE SURFACE WATER



SECTION 2, T28S, R8W, W. M.

RECEIVED

JAN 02 1990

WATER RESOURCES DEPT.
SALEM, OREGON

1 INCH = 1320 FEET

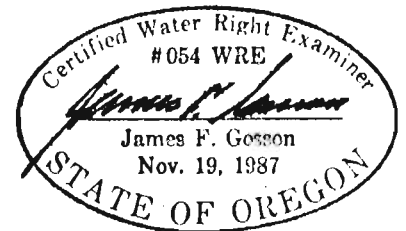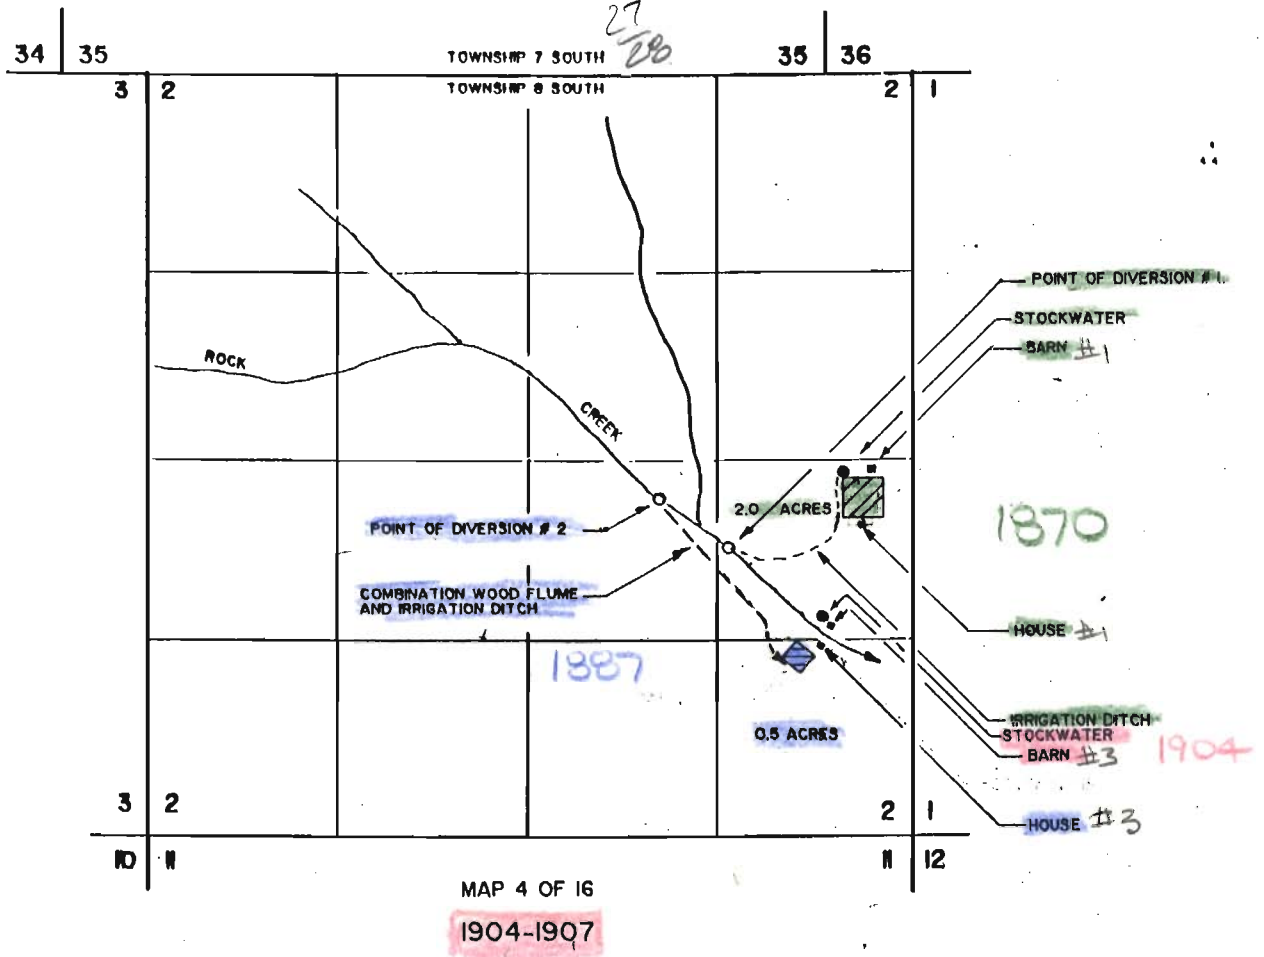

RECEIVED

JAN 02 1990

WATER RESOURCES DEPT.
SALEM, OREGON



IN THE NAME OF IVAN M. MATTHEWS

CLAIMING A RIGHT TO APPROPRIATE SURFACE WATER

SECTION 2, T28S, R8W, W. M.



1 INCH = 1320 FEET

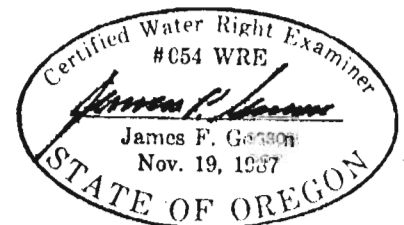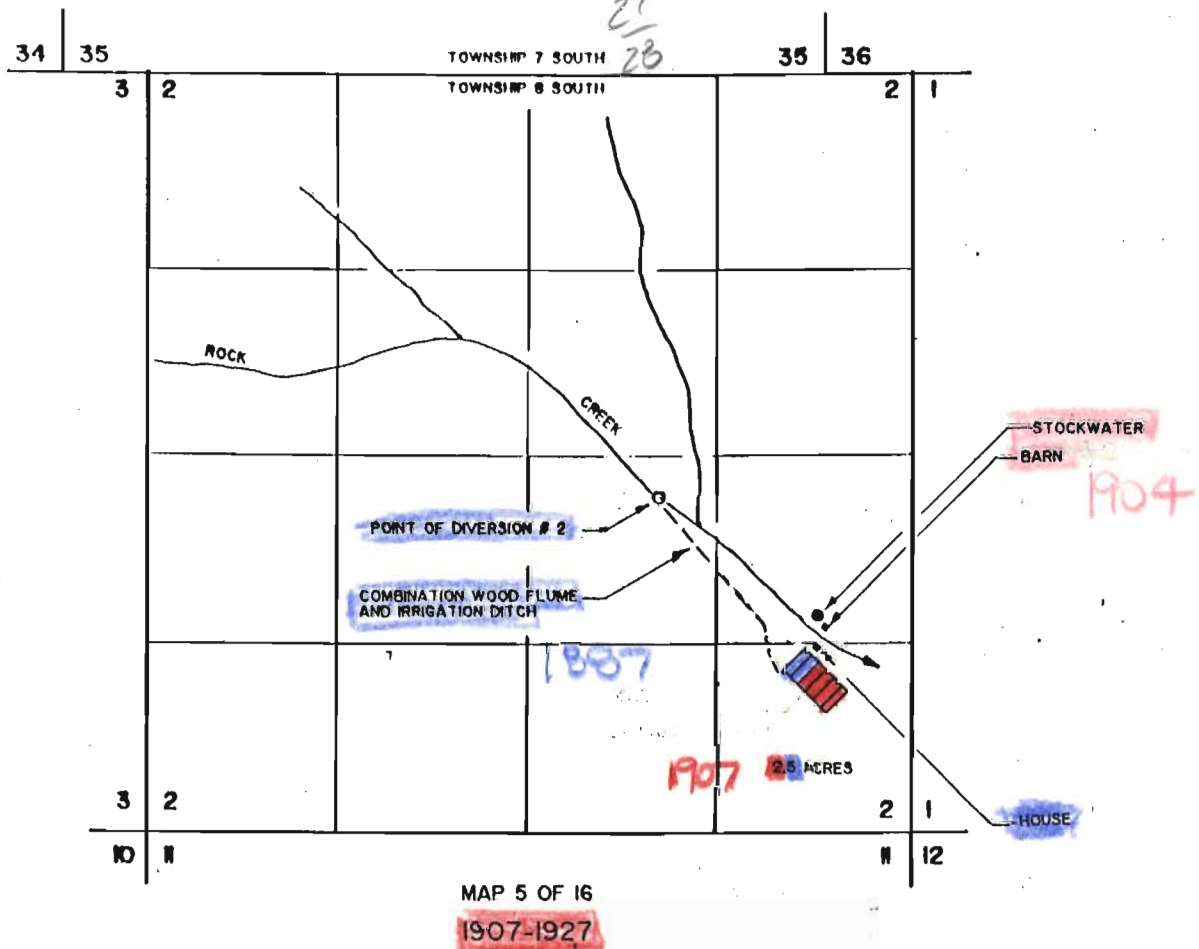

APPLICATION MAP

RECEIVED

IN THE NAME OF IVAN M. MATTHEWS



JAN 02 1990

CLAIMING A RIGHT TO APPROPRIATE SURFACE WATER

SECTION 2, T28S, R8W, W. M.

WATER RESOURCES DEPT
SALEM, OREGON

1 INCH = 1320 FEET

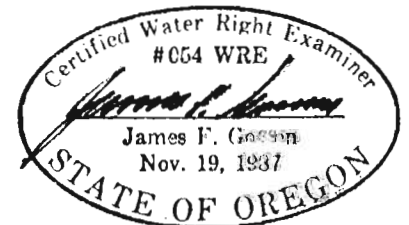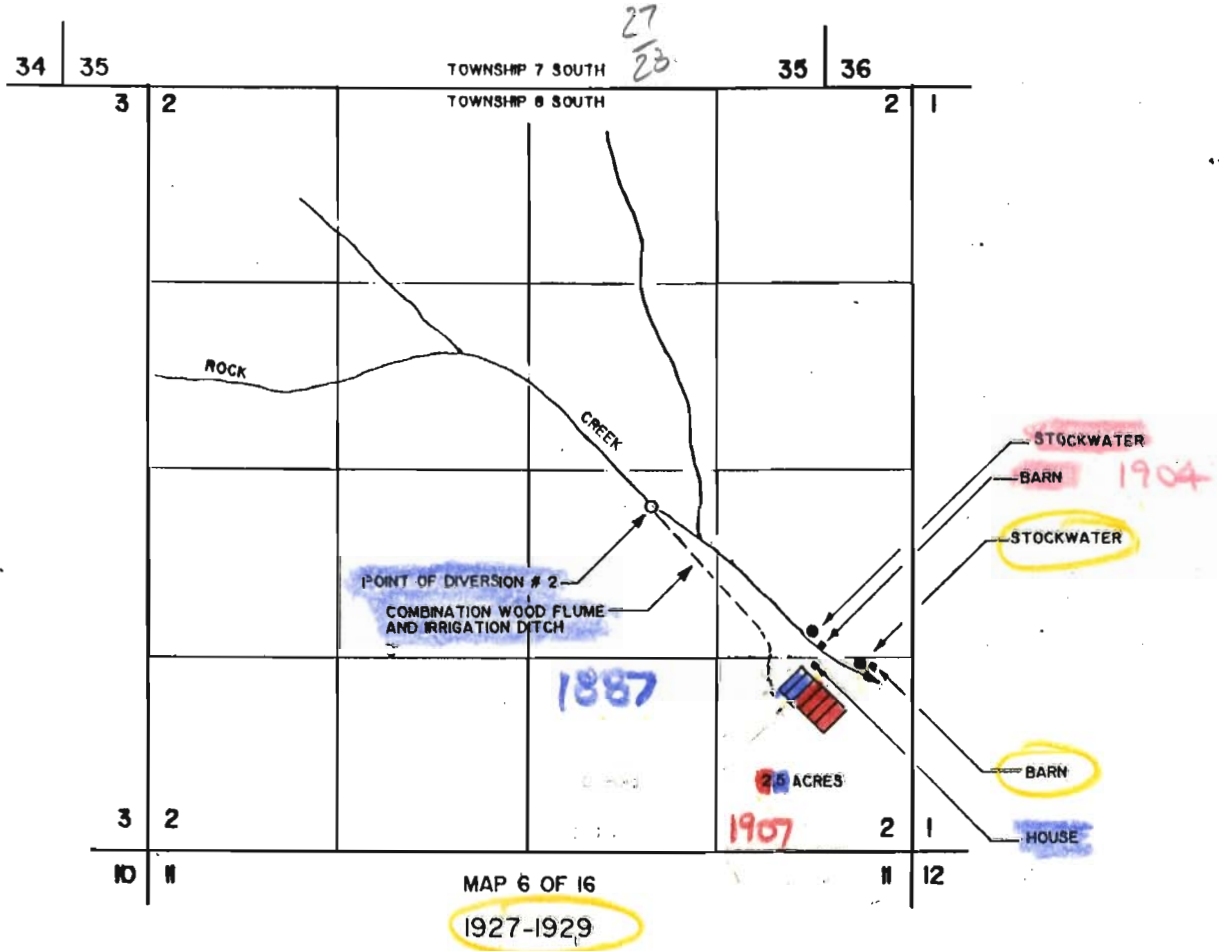

IN THE NAME OF IVAN M. MATTHEWS

CLAIMING A RIGHT TO APPROPRIATE SURFACE WATER



SECTION 2, T28S, R8W, W. M.

RECEIVED

JAN 02 1990

WATER RESOURCES DEPT.
SALEM, OREGON

1 INCH = 1320 FEET

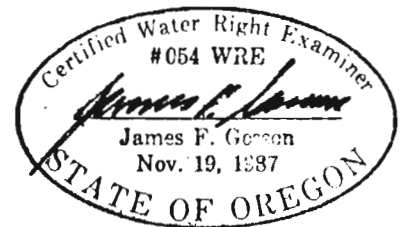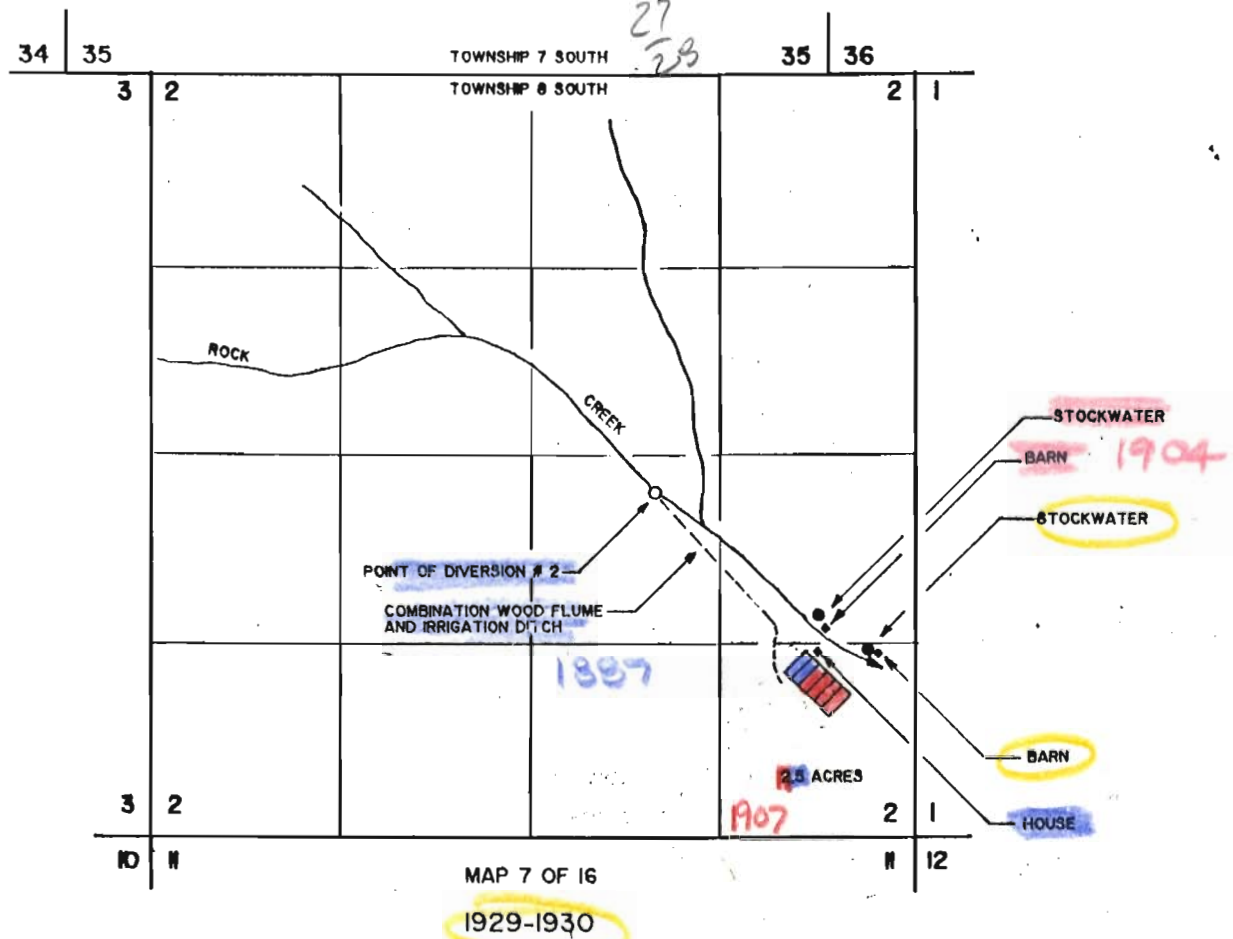

RECEIVED

IN THE NAME OF IVAN M. MATTHEWS


CLAIMING A RIGHT TO APPROPRIATE SURFACE WATER

SECTION 2, T28S, R8W, W. M.


JAN 02 1990

WATER RESOURCES DEPT
SALEM, OREGON

1 INCH = 1320 FEET

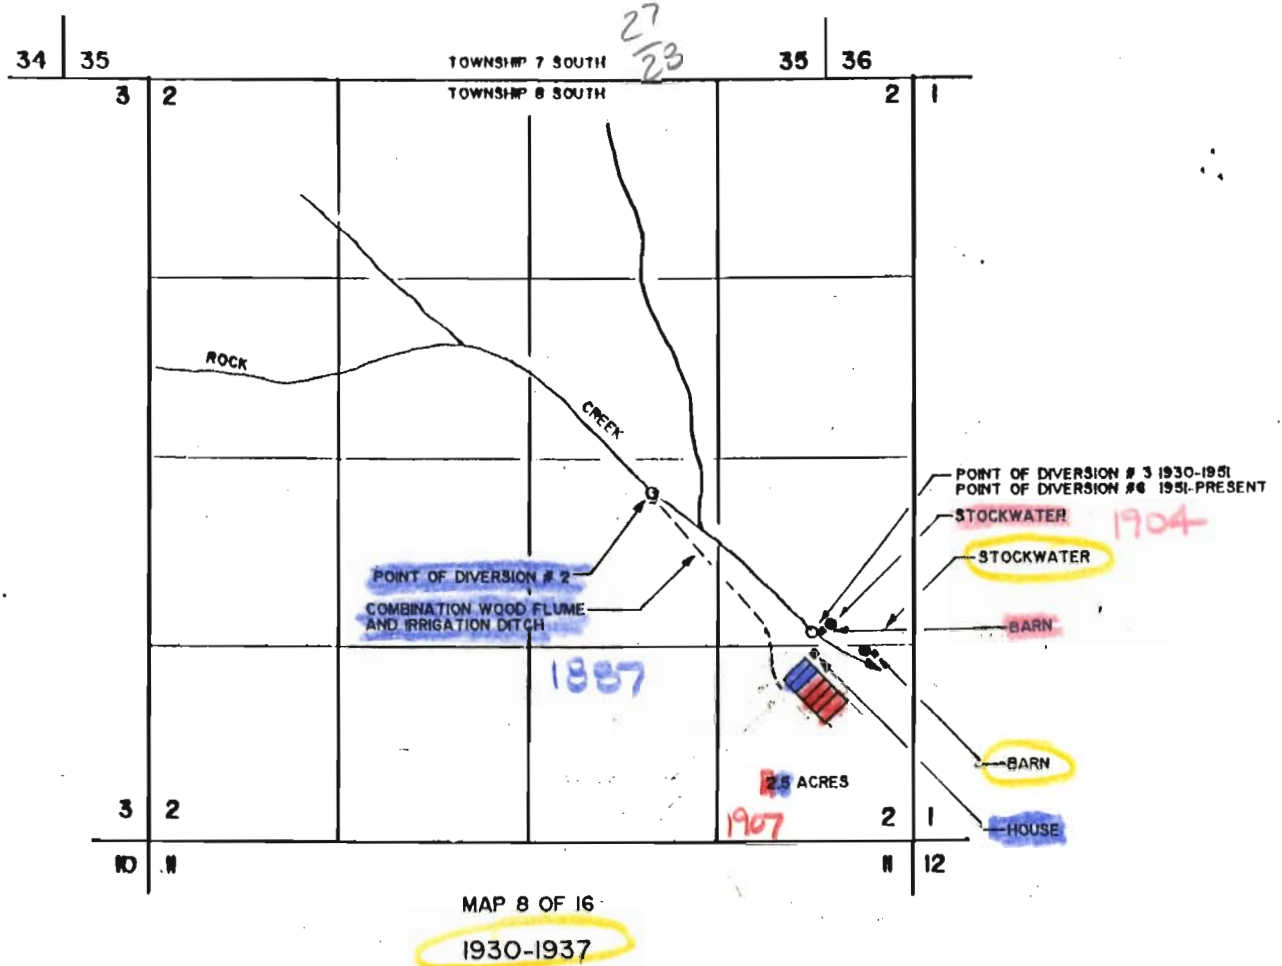

POINTS OF DIVERSION #3 AND #6 ARE LOCATED 1420 FEET NORTH
AND 700 FEET WEST FROM THE SOUTHEAST CORNER OF SECTION 2,
BEING WITHIN THE NORTHEAST 1/4 OF THE SOUTHEAST 1/4 OF
SECTION 2.

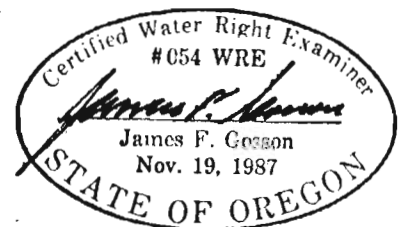

IN THE NAME OF IVAN M. MATTHEWS

CLAIMING A RIGHT TO APPROPRIATE SURFACE WATER


SECTION 2, T28S, R8W, W. M.



1 INCH = 1320 FEET


RECEIVED

JAN 02 1990

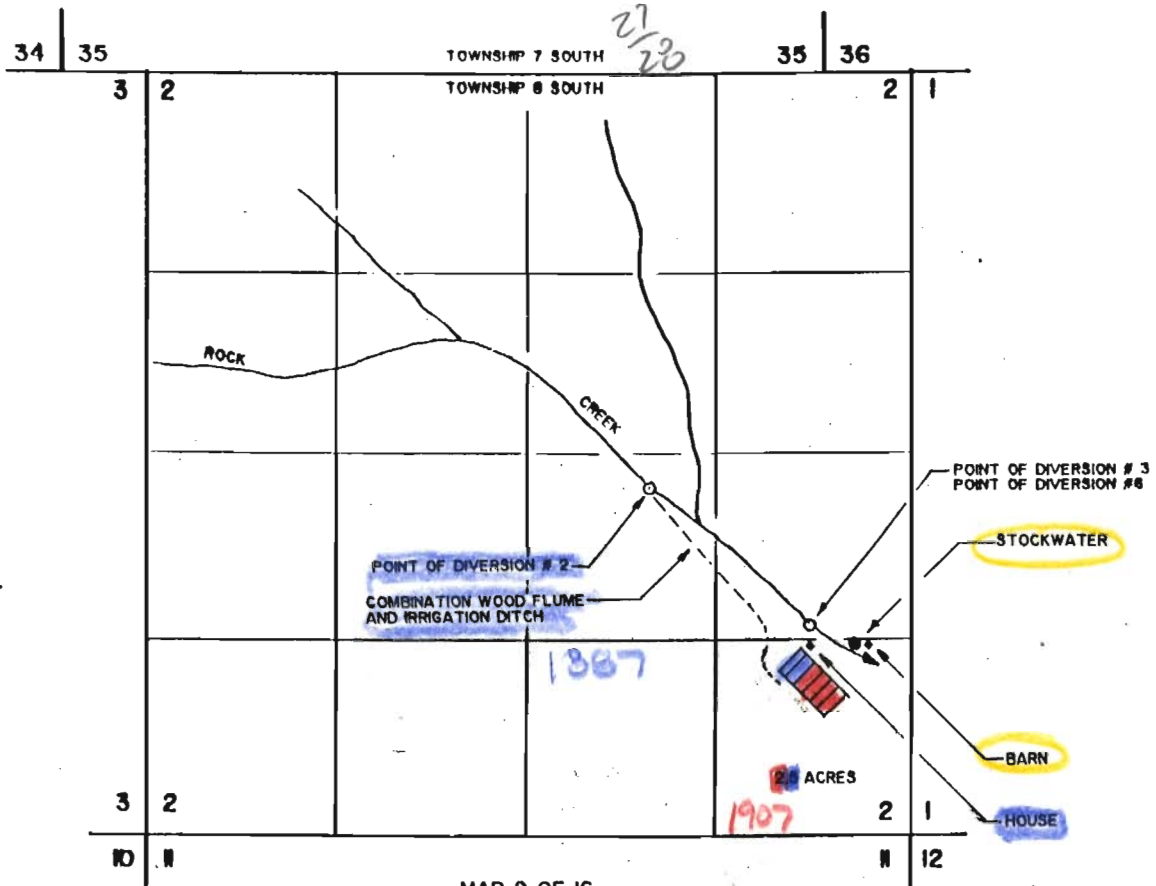WATER RESOURCES DEPT
SALEM, OREGON

MAP 9 OF 16

1937-1938

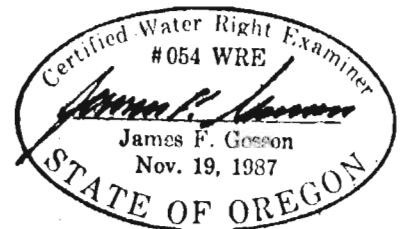

APPLICATION MAP

IN THE NAME OF IVAN M. MATTHEWS

CLAIMING A RIGHT TO APPROPRIATE SURFACE WATER

SECTION 2, T28S, R8W, W. M.


RECEIVED

JAN 02 1990


WATER RESOURCES DEPT.
SALEM, OREGON



1 INCH = 1320 FEET

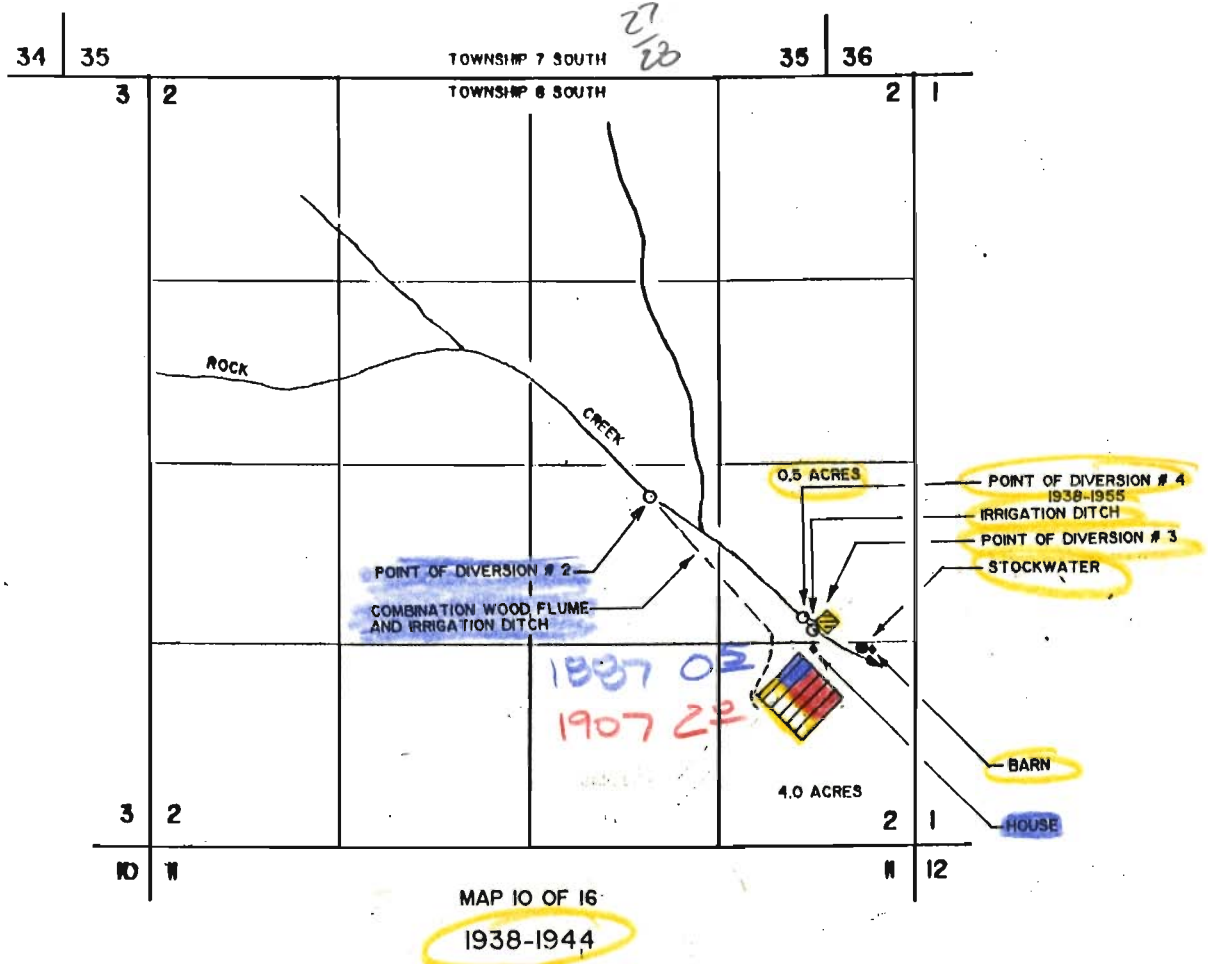

POINT OF DIVERSION #4 WAS LOCATED 1530 FEET NORTH AND 780 FEET WEST FROM THE SOUTHEAST CORNER OF SECTION 2, BEING WITHIN THE NORTHEAST 1/4 OF THE SOUTHEAST 1/4 OF SECTION 2.

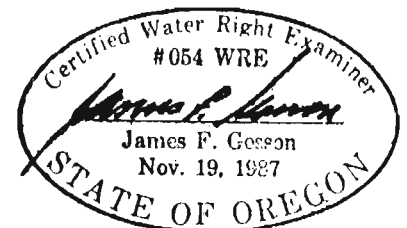

APPLICATION MAP

IN THE NAME OF IVAN M. MATTHEWS

CLAIMING A RIGHT TO APPROPRIATE SURFACE WATER


SECTION 2, T28S, R8W, W. M.

RECEIVED


JAN 02 1990

WATER RESOURCES DEPT.
SALEM, OREGON

1 INCH = 1320 FEET

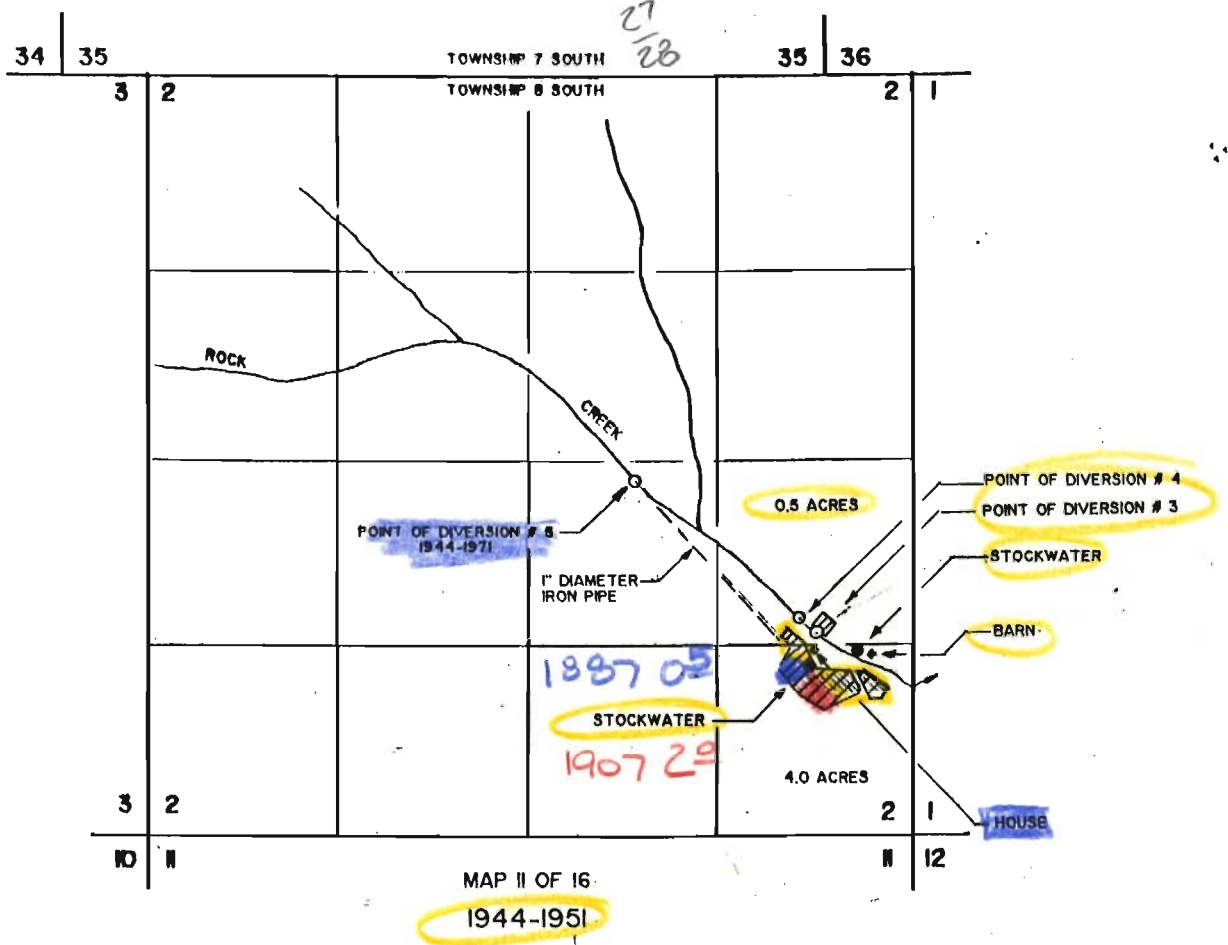

POINT OF DIVERSION #5 WAS LOCATED 2480 FEET NORTH AND 1900 FEET WEST FROM THE SOUTHEAST CORNER OF SECTION 2, BEING WITHIN THE NORTHWEST 1/4 OF THE SOUTHEAST 1/4 OF SECTION 2.

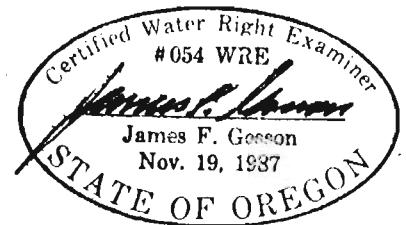

APPLICATION MAP

IN THE NAME OF IVAN M. MATTHEWS

CLAIMING A RIGHT TO APPROPRIATE SURFACE WATER


SECTION 2, T28S, R8W, W. M.

RECEIVED


JAN 02 1990

WATER RESOURCES DEPT
SALEM, OREGON

1 INCH = 1320 FEET

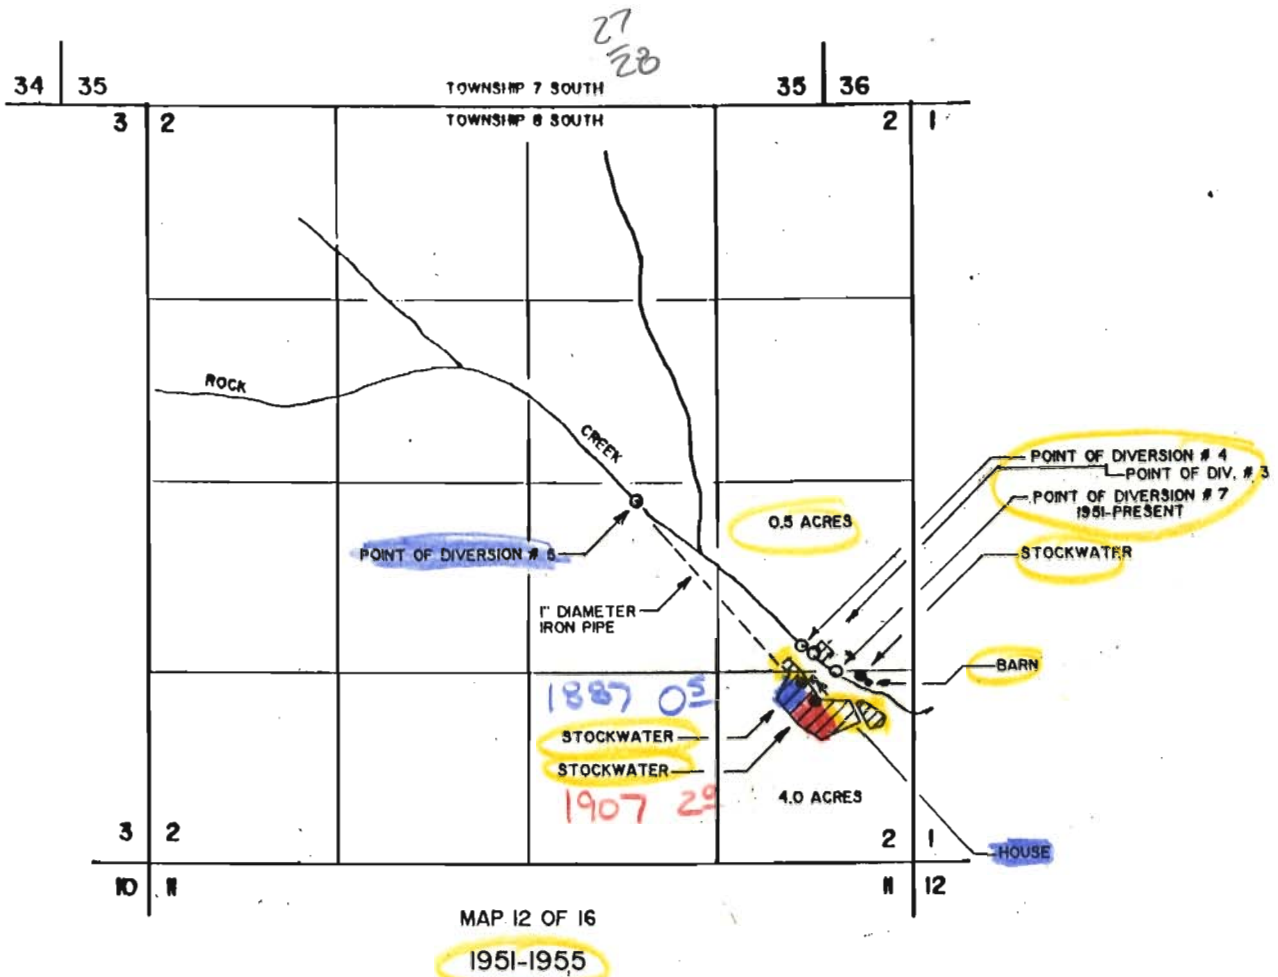

POINT OF DIVERSION #7 IS LOCATED 1300 FEET NORTH AND 520 FEET WEST FROM THE SOUTHEAST CORNER OF SECTION 2, BEING WITHIN THE SOUTHEAST 1/4 OF THE SOUTHEAST 1/4 OF SECTION 2.

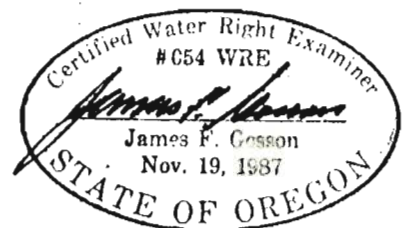

RECEIVED

JAN 02 1990

WATER RESOURCES DEPT.
SALEM, OREGON


IN THE NAME OF IVAN M. MATTHEWS

CLAIMING A RIGHT TO APPROPRIATE SURFACE WATER

SECTION 2, T28S, R8W, W. M.




1 INCH = 1320 FEET

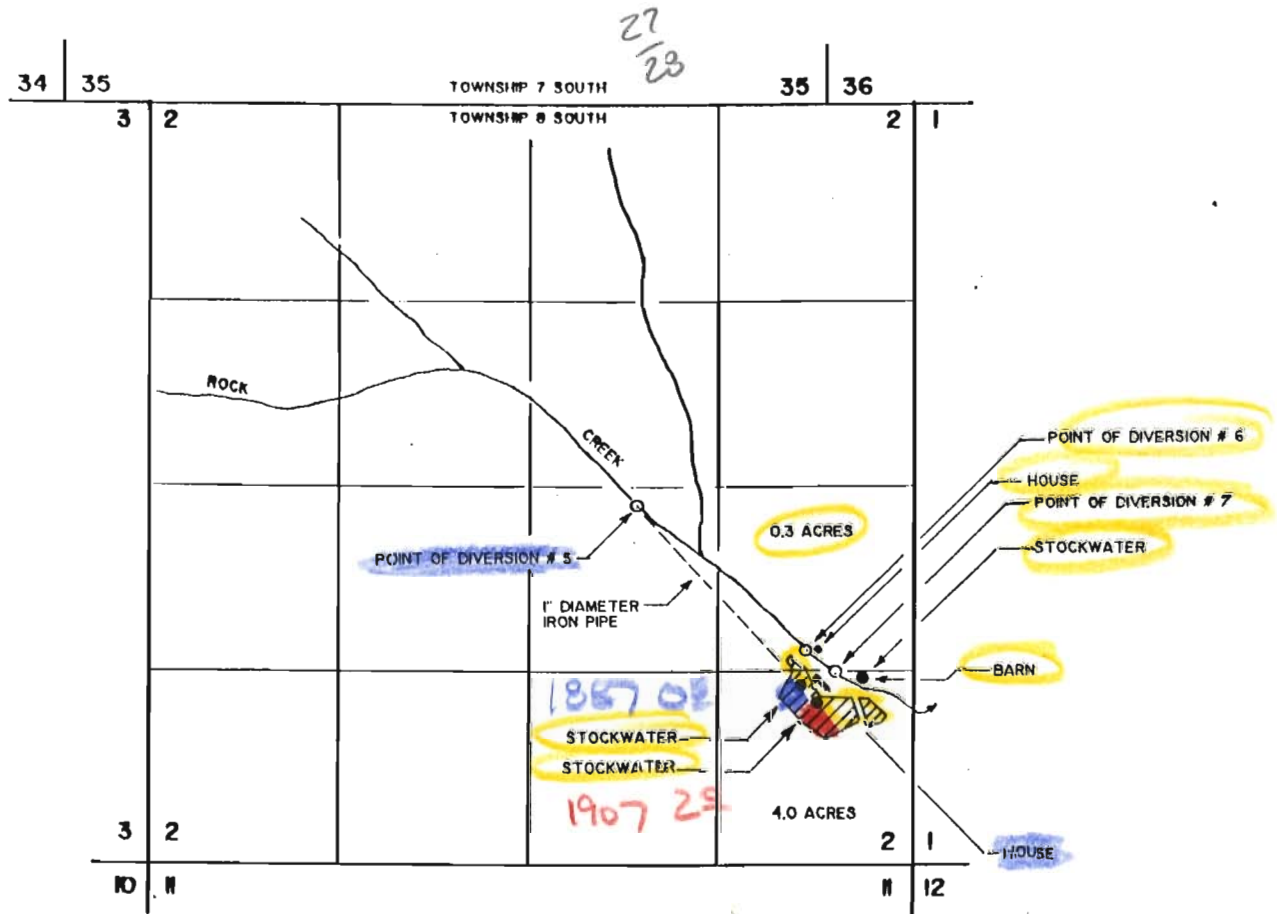

MAP 13 OF 16

1955-1971

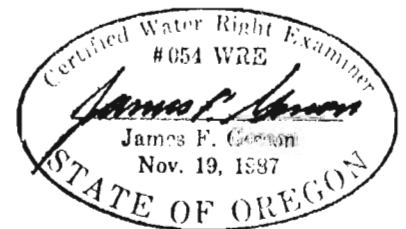

APPLICATION MAP

RECEIVED

JAN 02 1990


WATER RESOURCES DEPT.
SALEM, OREGON

IN THE NAME OF IVAN M. MATTHEWS
CLAIMING A RIGHT TO APPROPRIATE SURFACE WATER





1 INCH = 1320 FEET

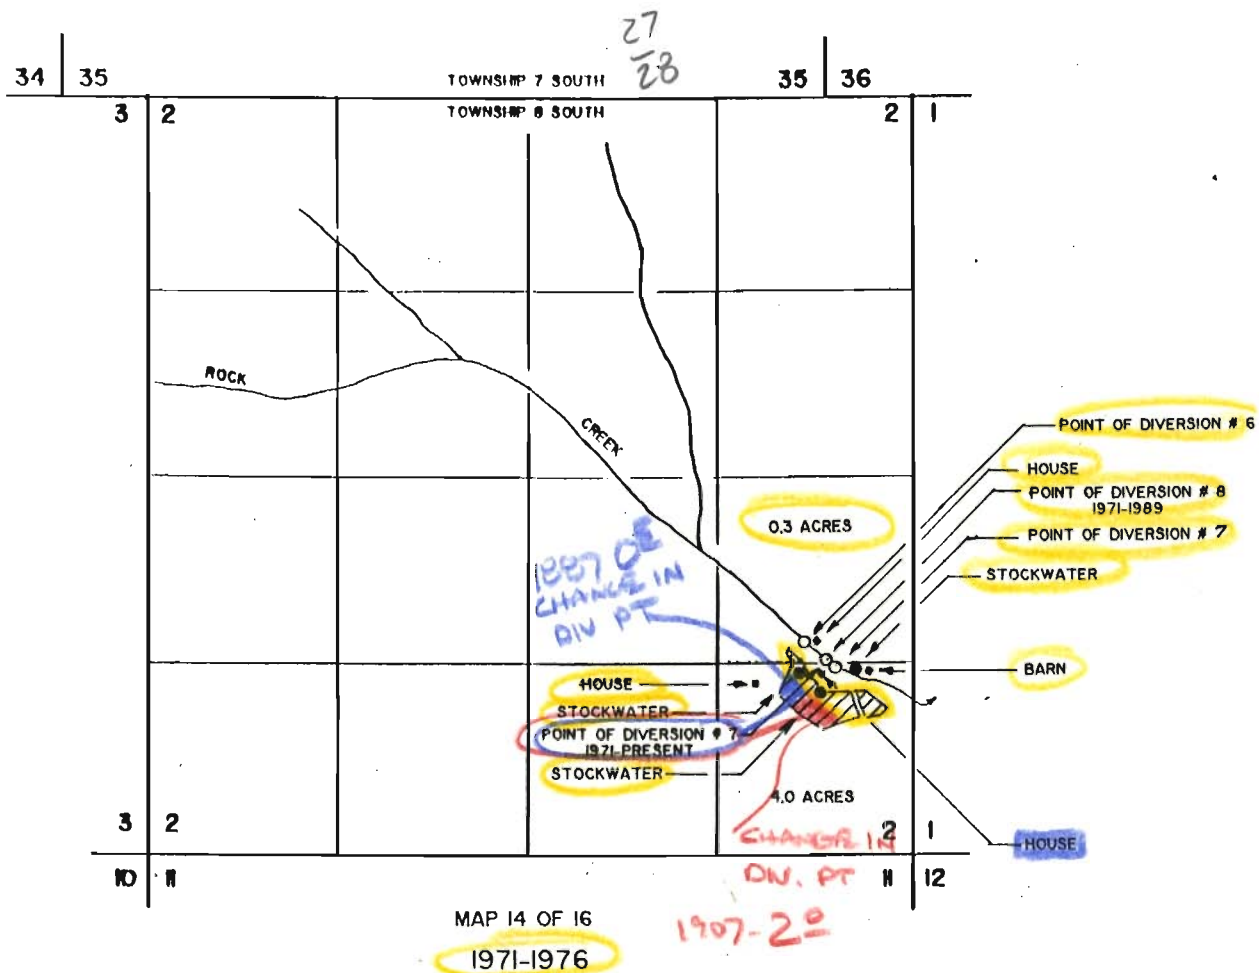

POINT OF DIVERSION #8 IS LOCATED 1380 FEET NORTH AND
600 FEET WEST FROM THE SOUTHEAST CORNER OF SECTION 2,
BEING WITHIN THE NORTHEAST 1/4 OF THE SOUTHEAST 1/4 OF
SECTION 2.

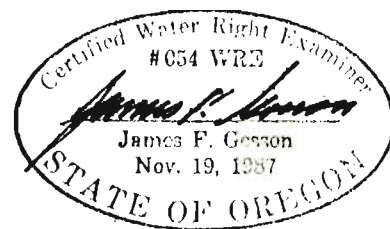

RECEIVED



IN THE NAME OF IVAN M. MATTHEWS
CLAIMING A RIGHT TO APPROPRIATE SURFACE WATER

JAN 02 1990

SECTION 2, T28S, R8W, W. M.

WATER RESOURCES DEPT.
SALEM, OREGON

1 INCH = 1320 FEET

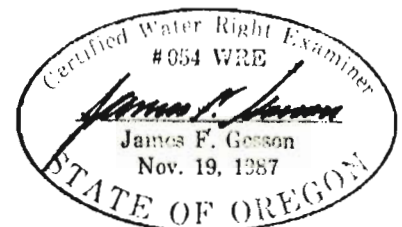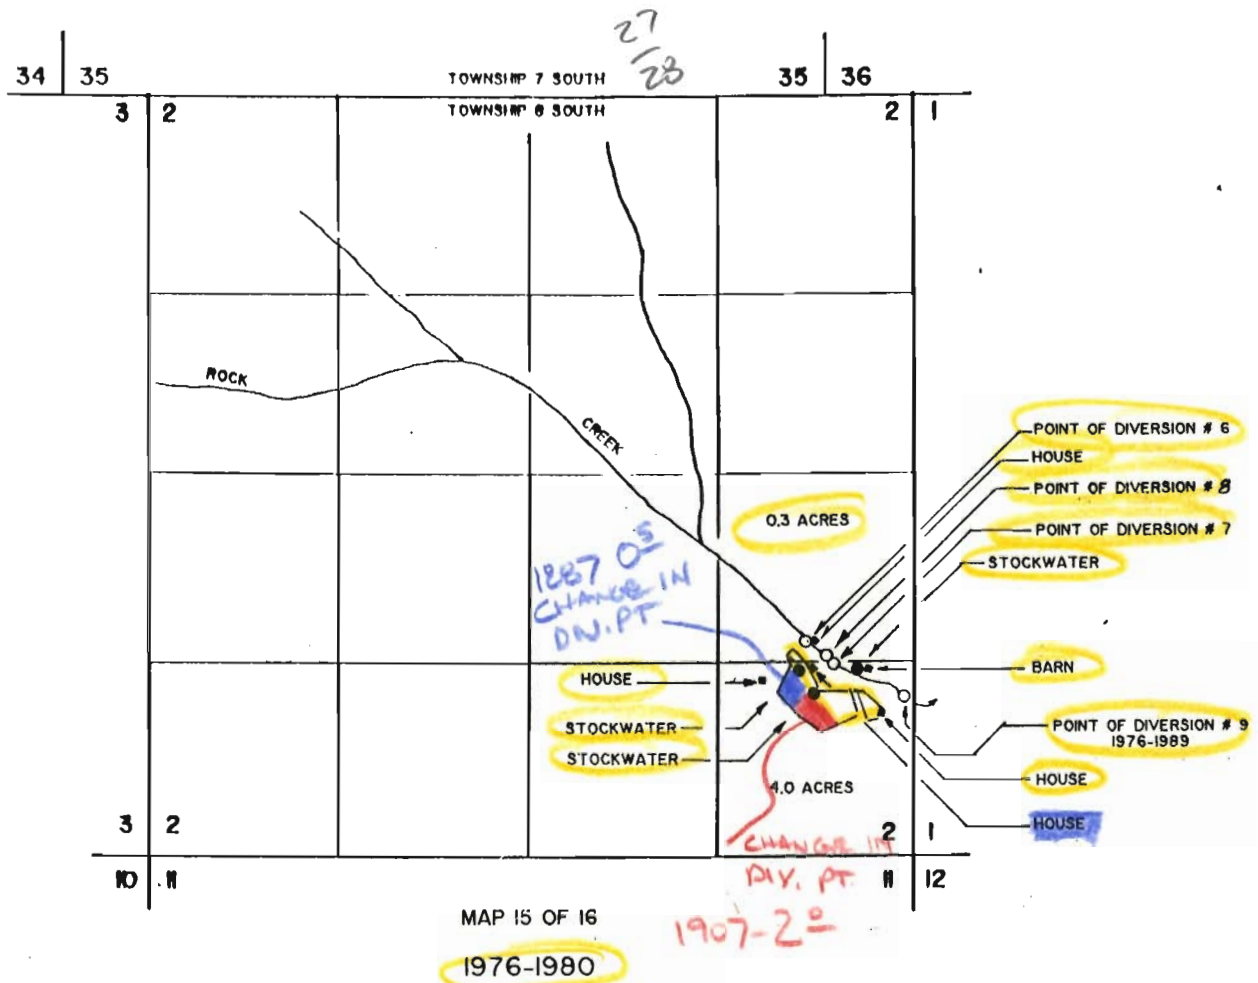

APPLICATION MAP

RECEIVED

IN THE NAME OF IVAN M. MATTHEWS
CLAIMING A RIGHT TO APPROPRIATE SURFACE WATER
SECTION 2, T28S, R8W, W. M.

JAN 02 1990

WATER RESOURCES DEPT.
SALEM, OREGON

1 INCH = 1320 FEET

