


# Revised map. App. G 17131

## SECTION PLAT

Section 2 Township 25s Range 32 1/2 E  
 County of Harney State of Oregon

NORTH

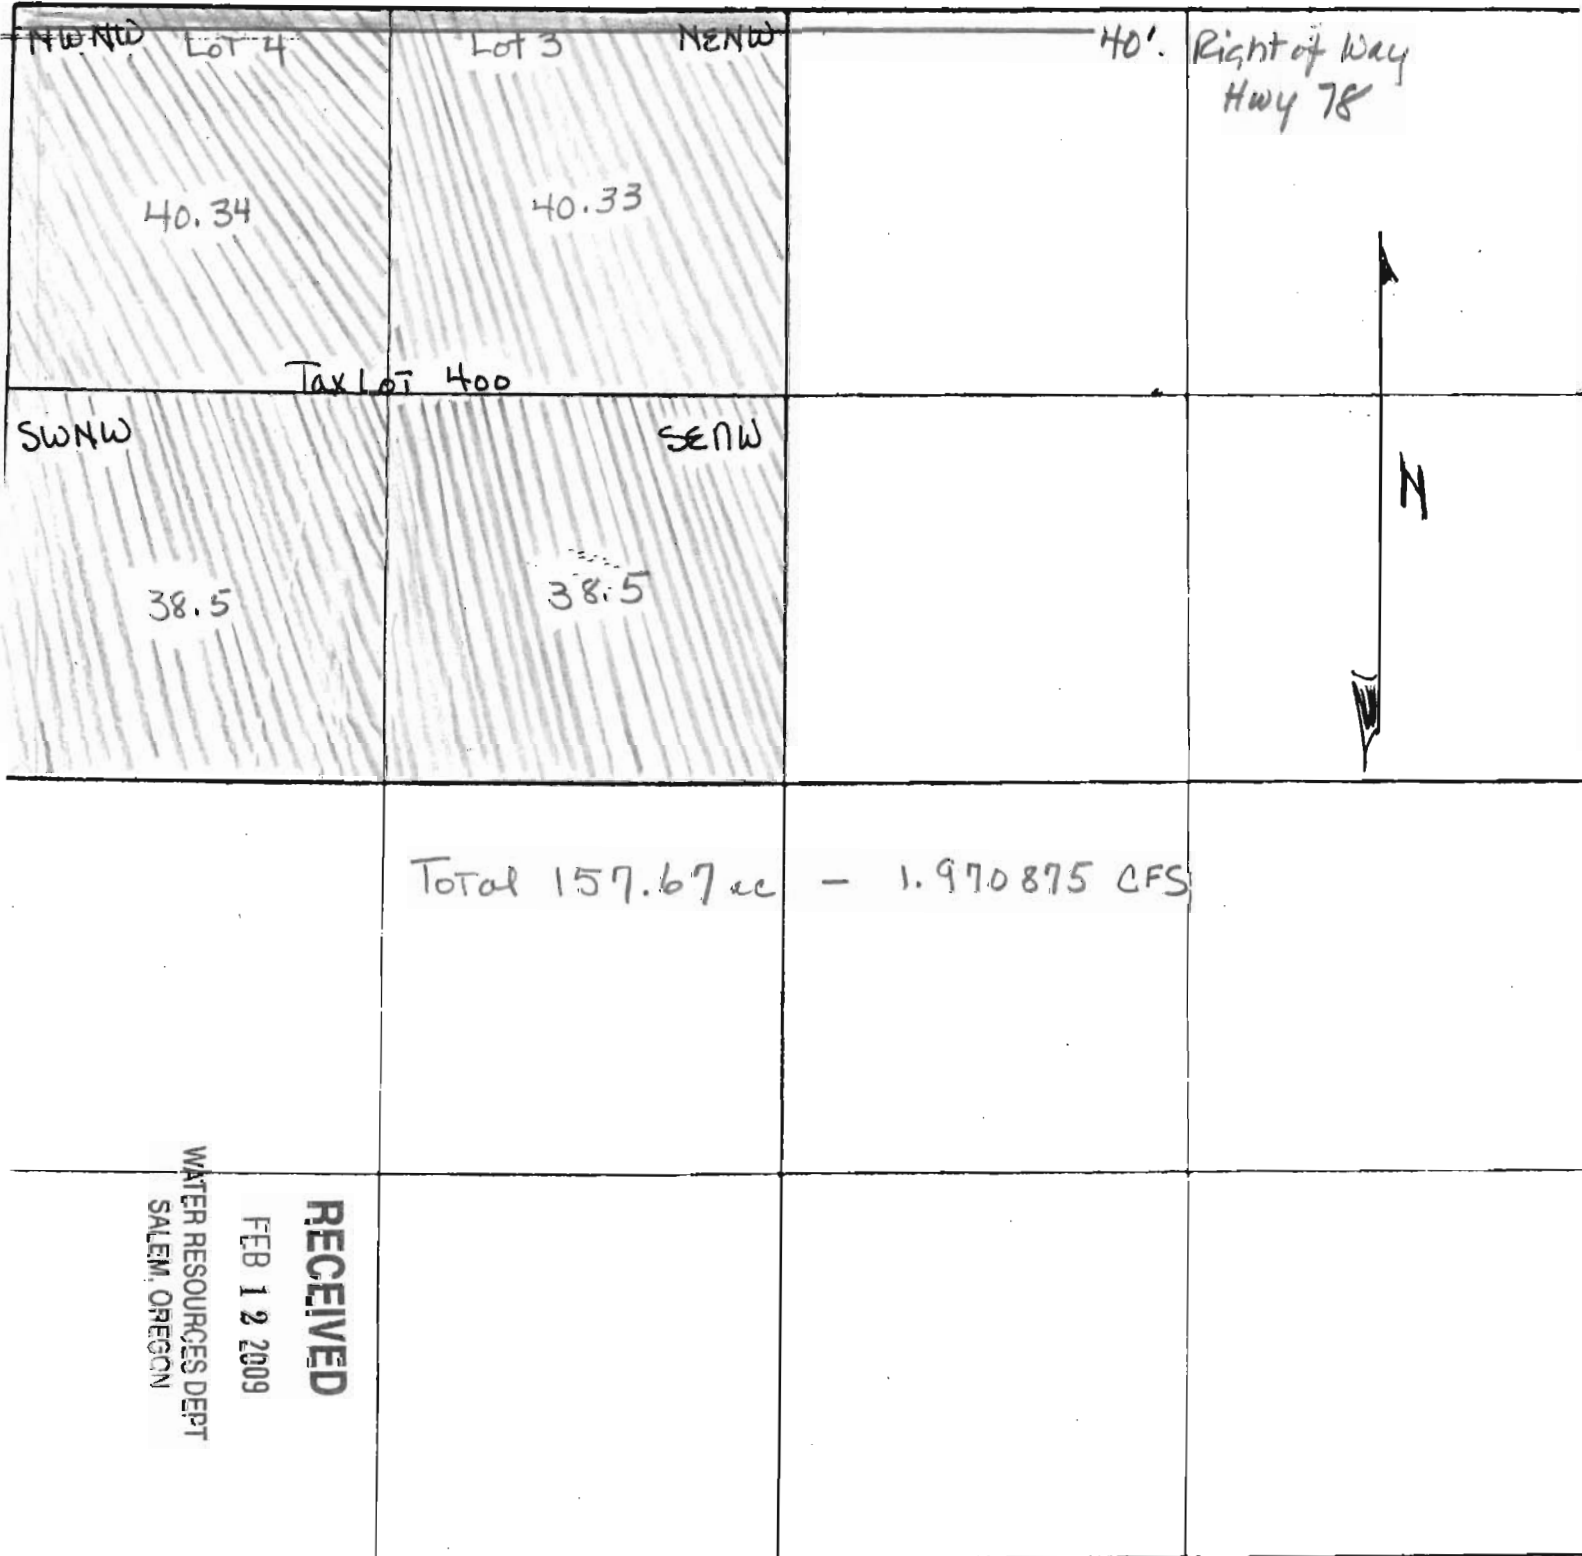

Dave Miller  
 58518 Hwy 78  
 Burns, OR 97720

8" = 1 mi

Application - G 17131

Feb. 10, 2009