


Scale: 1" = 500'

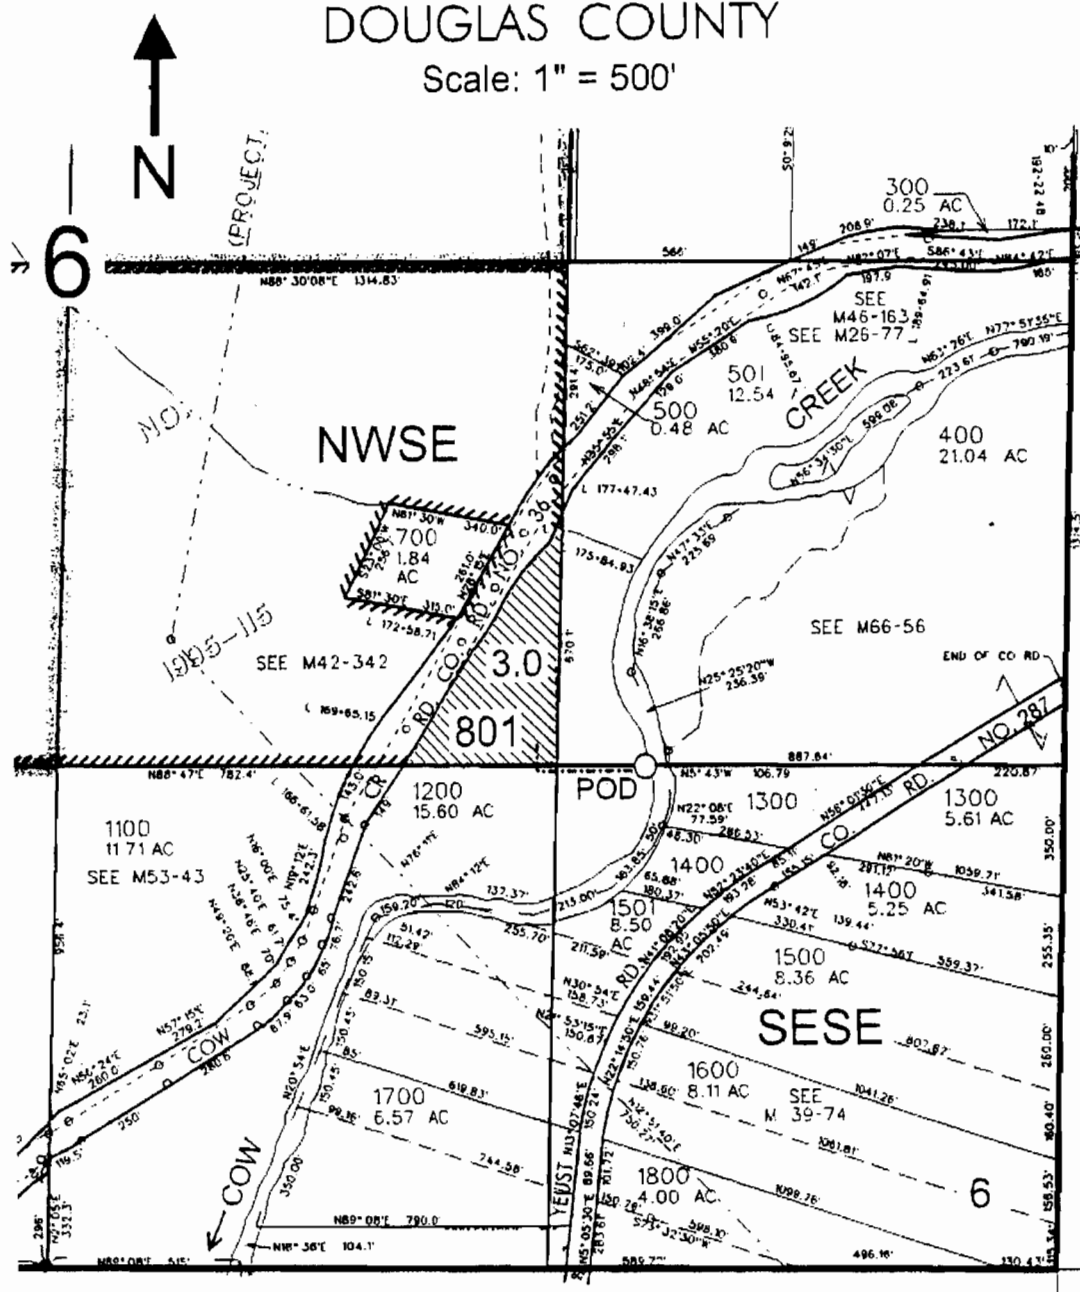

POD is located 1300 ft. N. and 1080 ft. W. from the SE corner of Sec. 6

RECEIVED

MAY 18 2009

WATER RESOURCES DEPT
SALEM, OREGON