


T. 6N., R. 36E., W.M.

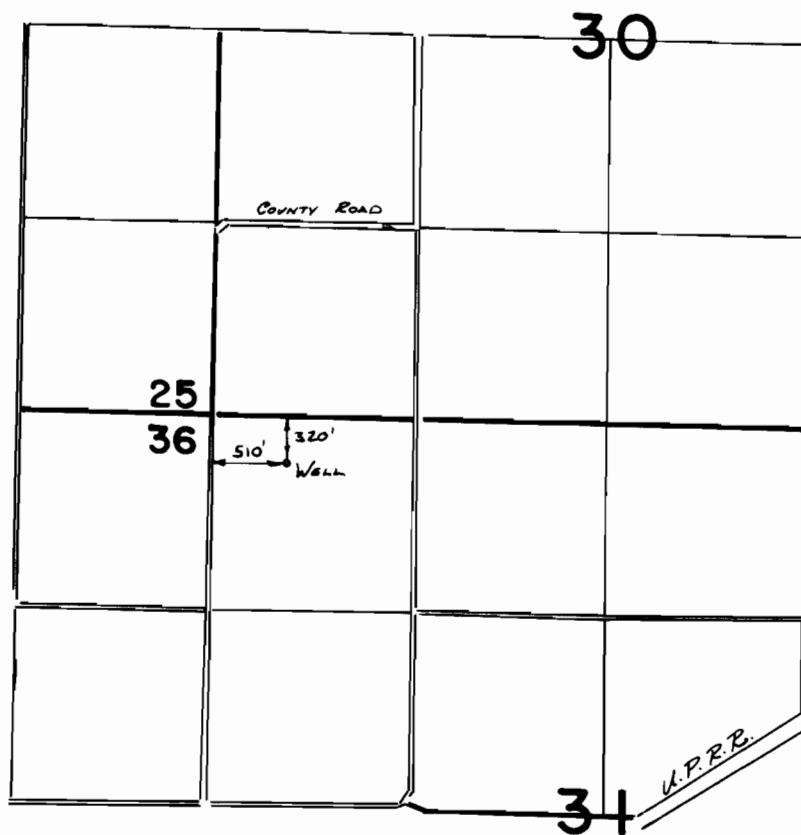

FINAL PROOF SURVEY
UNDER

TRANSFER 4500

IN NAME OF