


CLACKAMAS COUNTY

WORK
COPY

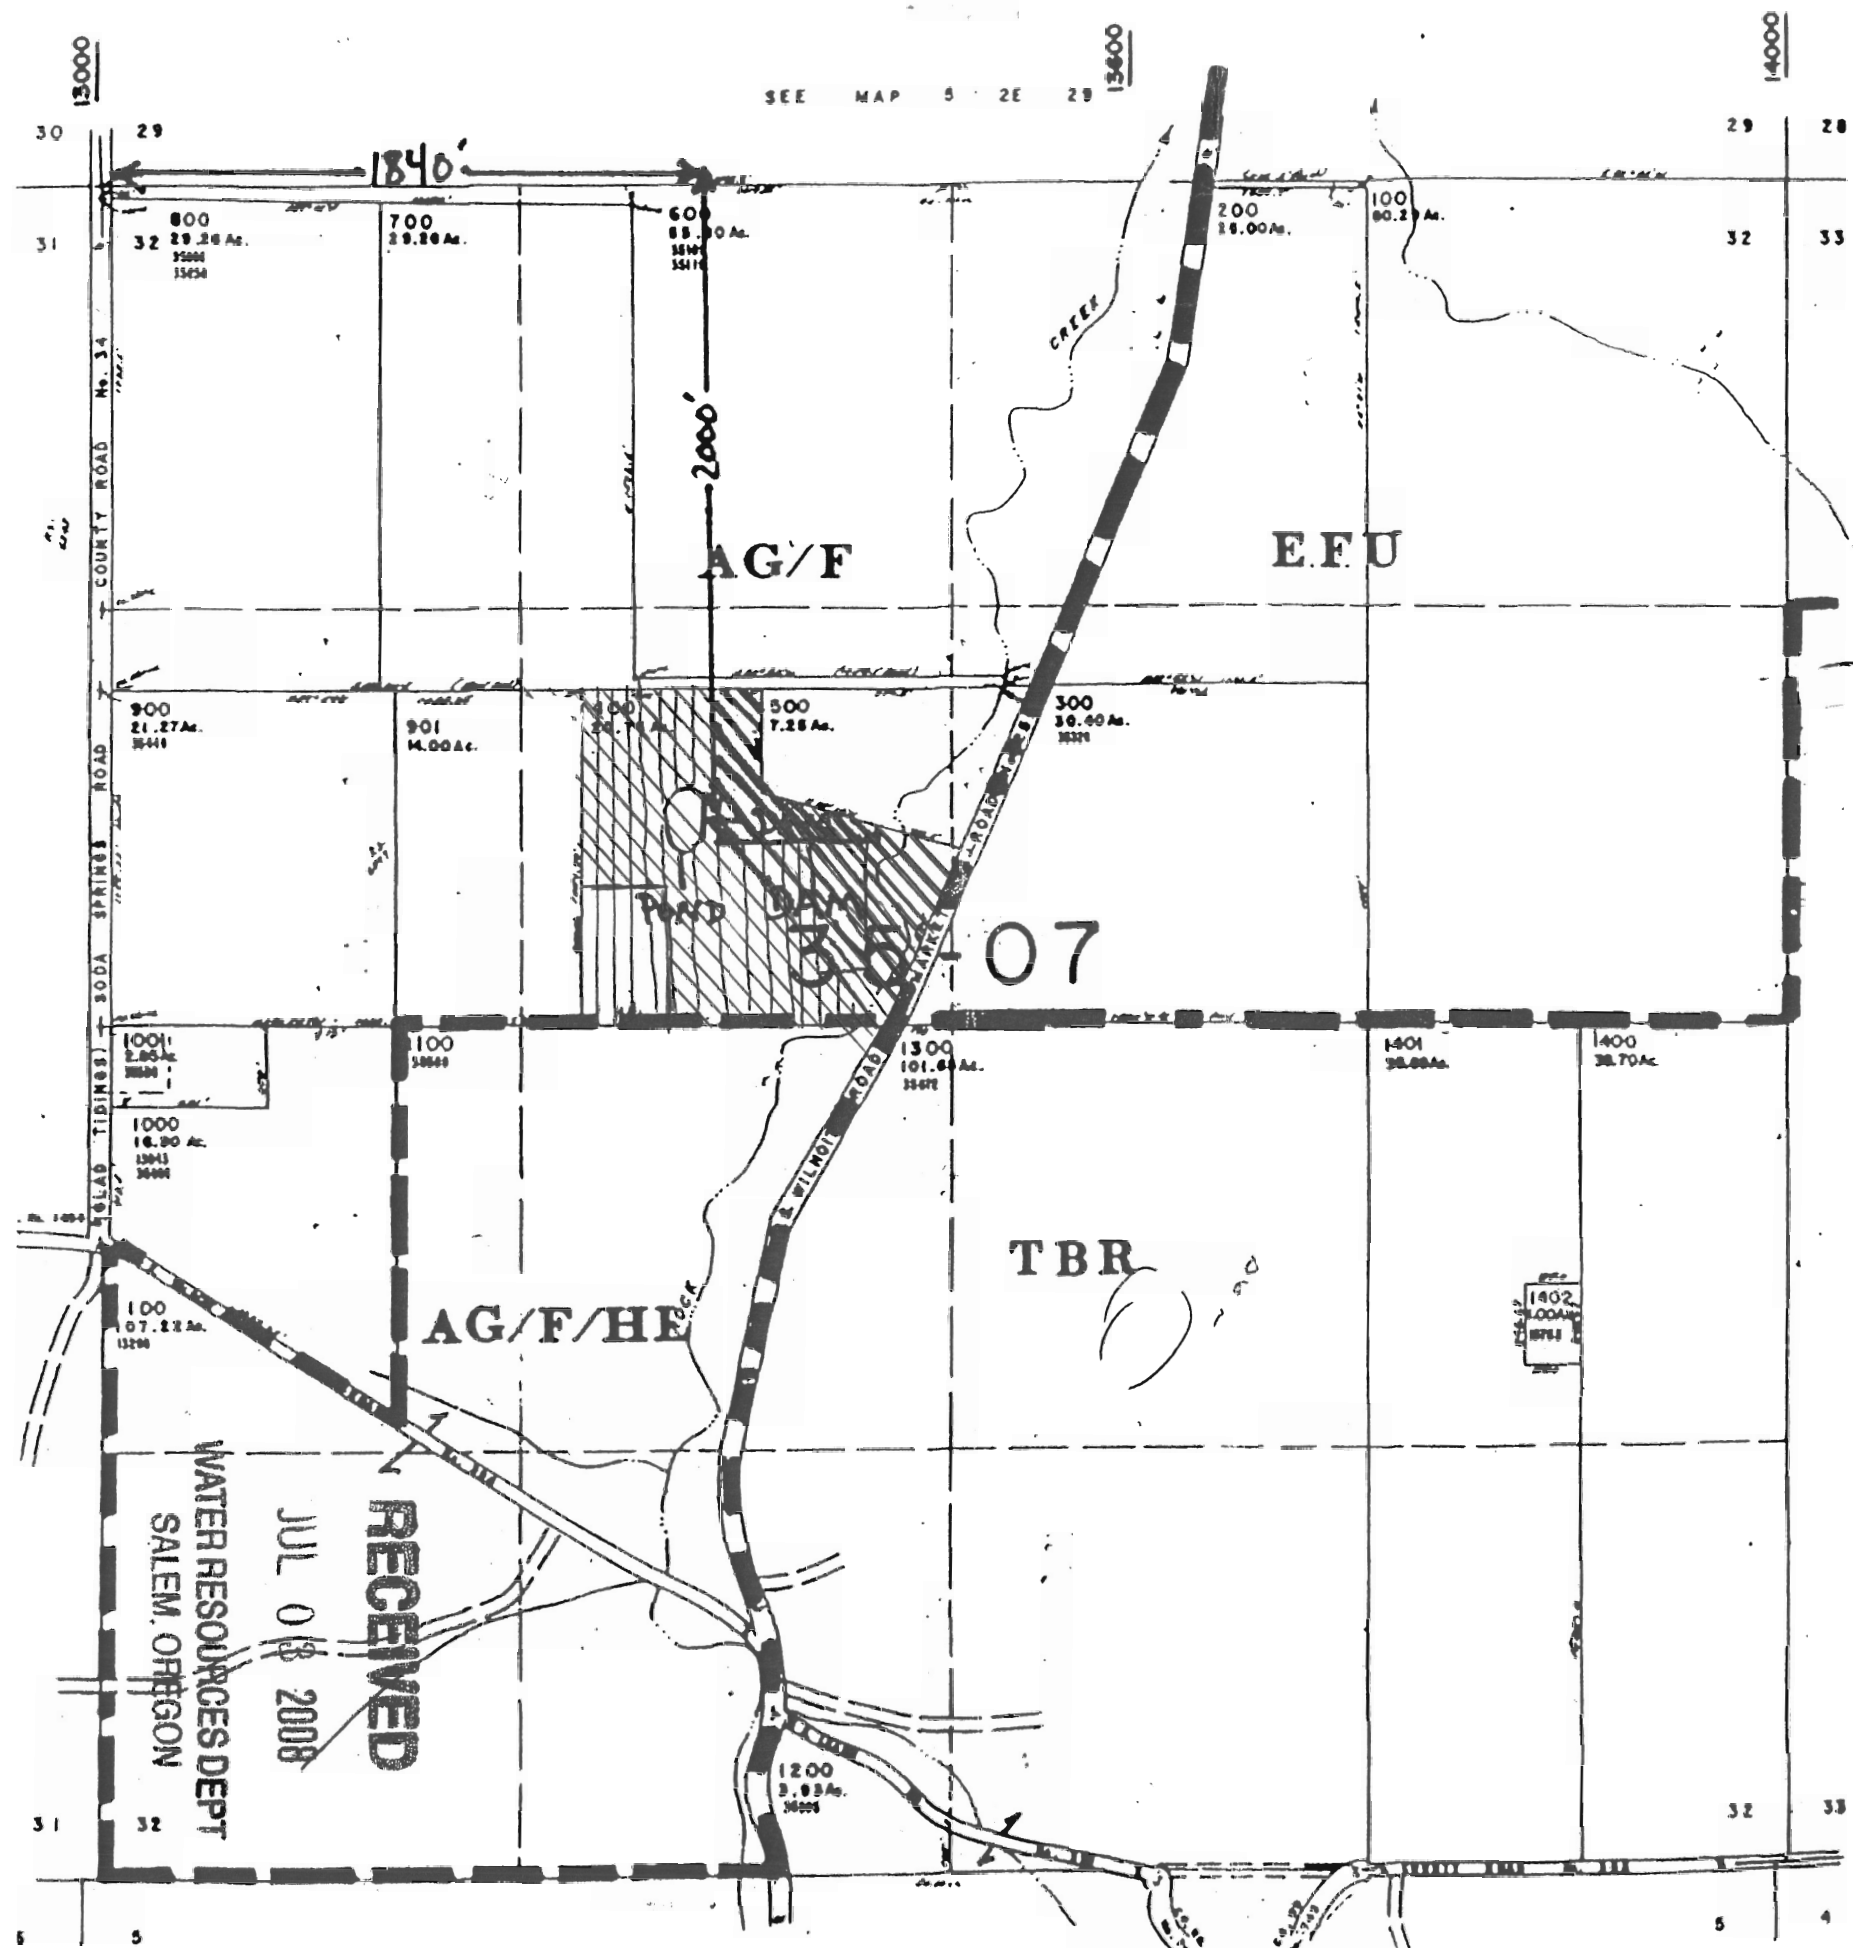

Applicant: Michael Thomas

POD Location: POND

1) 2000' South and 1840' East from the NW
Corner of Section 32, T. 5 S., R. 2 E.
Within SE1/4 NW1/4; Tax Lot 400

Irrigated Acres:   comm.

150

20 Acres Within SE1/4 NW1/4; Tax Lot 400

T. 5 S. R. 2 E. Section 32



RECEIVED

MAY 13 2008

REVISED ADJUSTED
APPROX. SCALE
1" = 600 FEET

5-13-09