



RECEIVED

G-17223

MAY 20 2009

Well Location 1/4 NW 1/4 NE Section 16 T4N R35E

WATER RESOURCES DEPT
SALEM, OREGON

RECEIVED

APR 20 2009

WATER RESOURCES DEPT
SALEM, OREGON

LAGOON AND
IRRIGATION SITE

IRRIGATION
BUILDING

WELL

JOHNSON ROAD

To Milton-Freewater

6" PRESSURE
MAIN

T.4N., R.35E., W.M.
17-2000

CITY LIMITS

WESTON

WASTEWATER
TREATMENT
PLANT

URBAN
GROWTH
BOUNDARY

ATHENA

BANISTER ROAD


REMARKS: Regarding City of Weston Permit Application # G17223

The new City Well is located 1400 feet west
and 25 feet south of the north east corner
of Section 16, Township 4N, Range 35E, W.M.
in Tax lot 13601.

WORK
COPY

[Signature] P.E.

CITY OF
WESTON

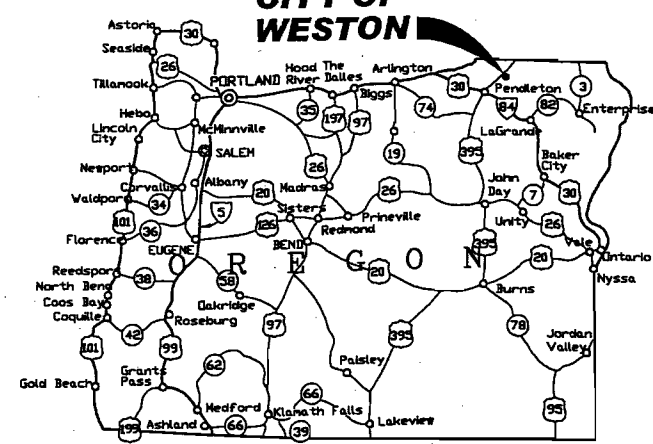

VICINITY MAP

anderson
perry
& associates, inc.

CITY OF
WESTON, OREGON
WASTEWATER FACILITIES IMPROVEMENTS
GROUNDWATER APPLICATION

LOCATION AND VICINITY MAPS

FIGURE

1