

Application No. 71072
Permit No.

CANBY UTILITY BOARD

WILLAMETTE RIVER INTAKE

WATER RIGHTS APPLICATION


RECEIVED

DEC 27 1990
WATER RESOURCES DEPT.
SALEM, OREGON

RECEIVED

DEC 24 1990
WATER RESOURCES DEPT.
SALEM, OREGON

*POD location
Superseded
3-31-2009*

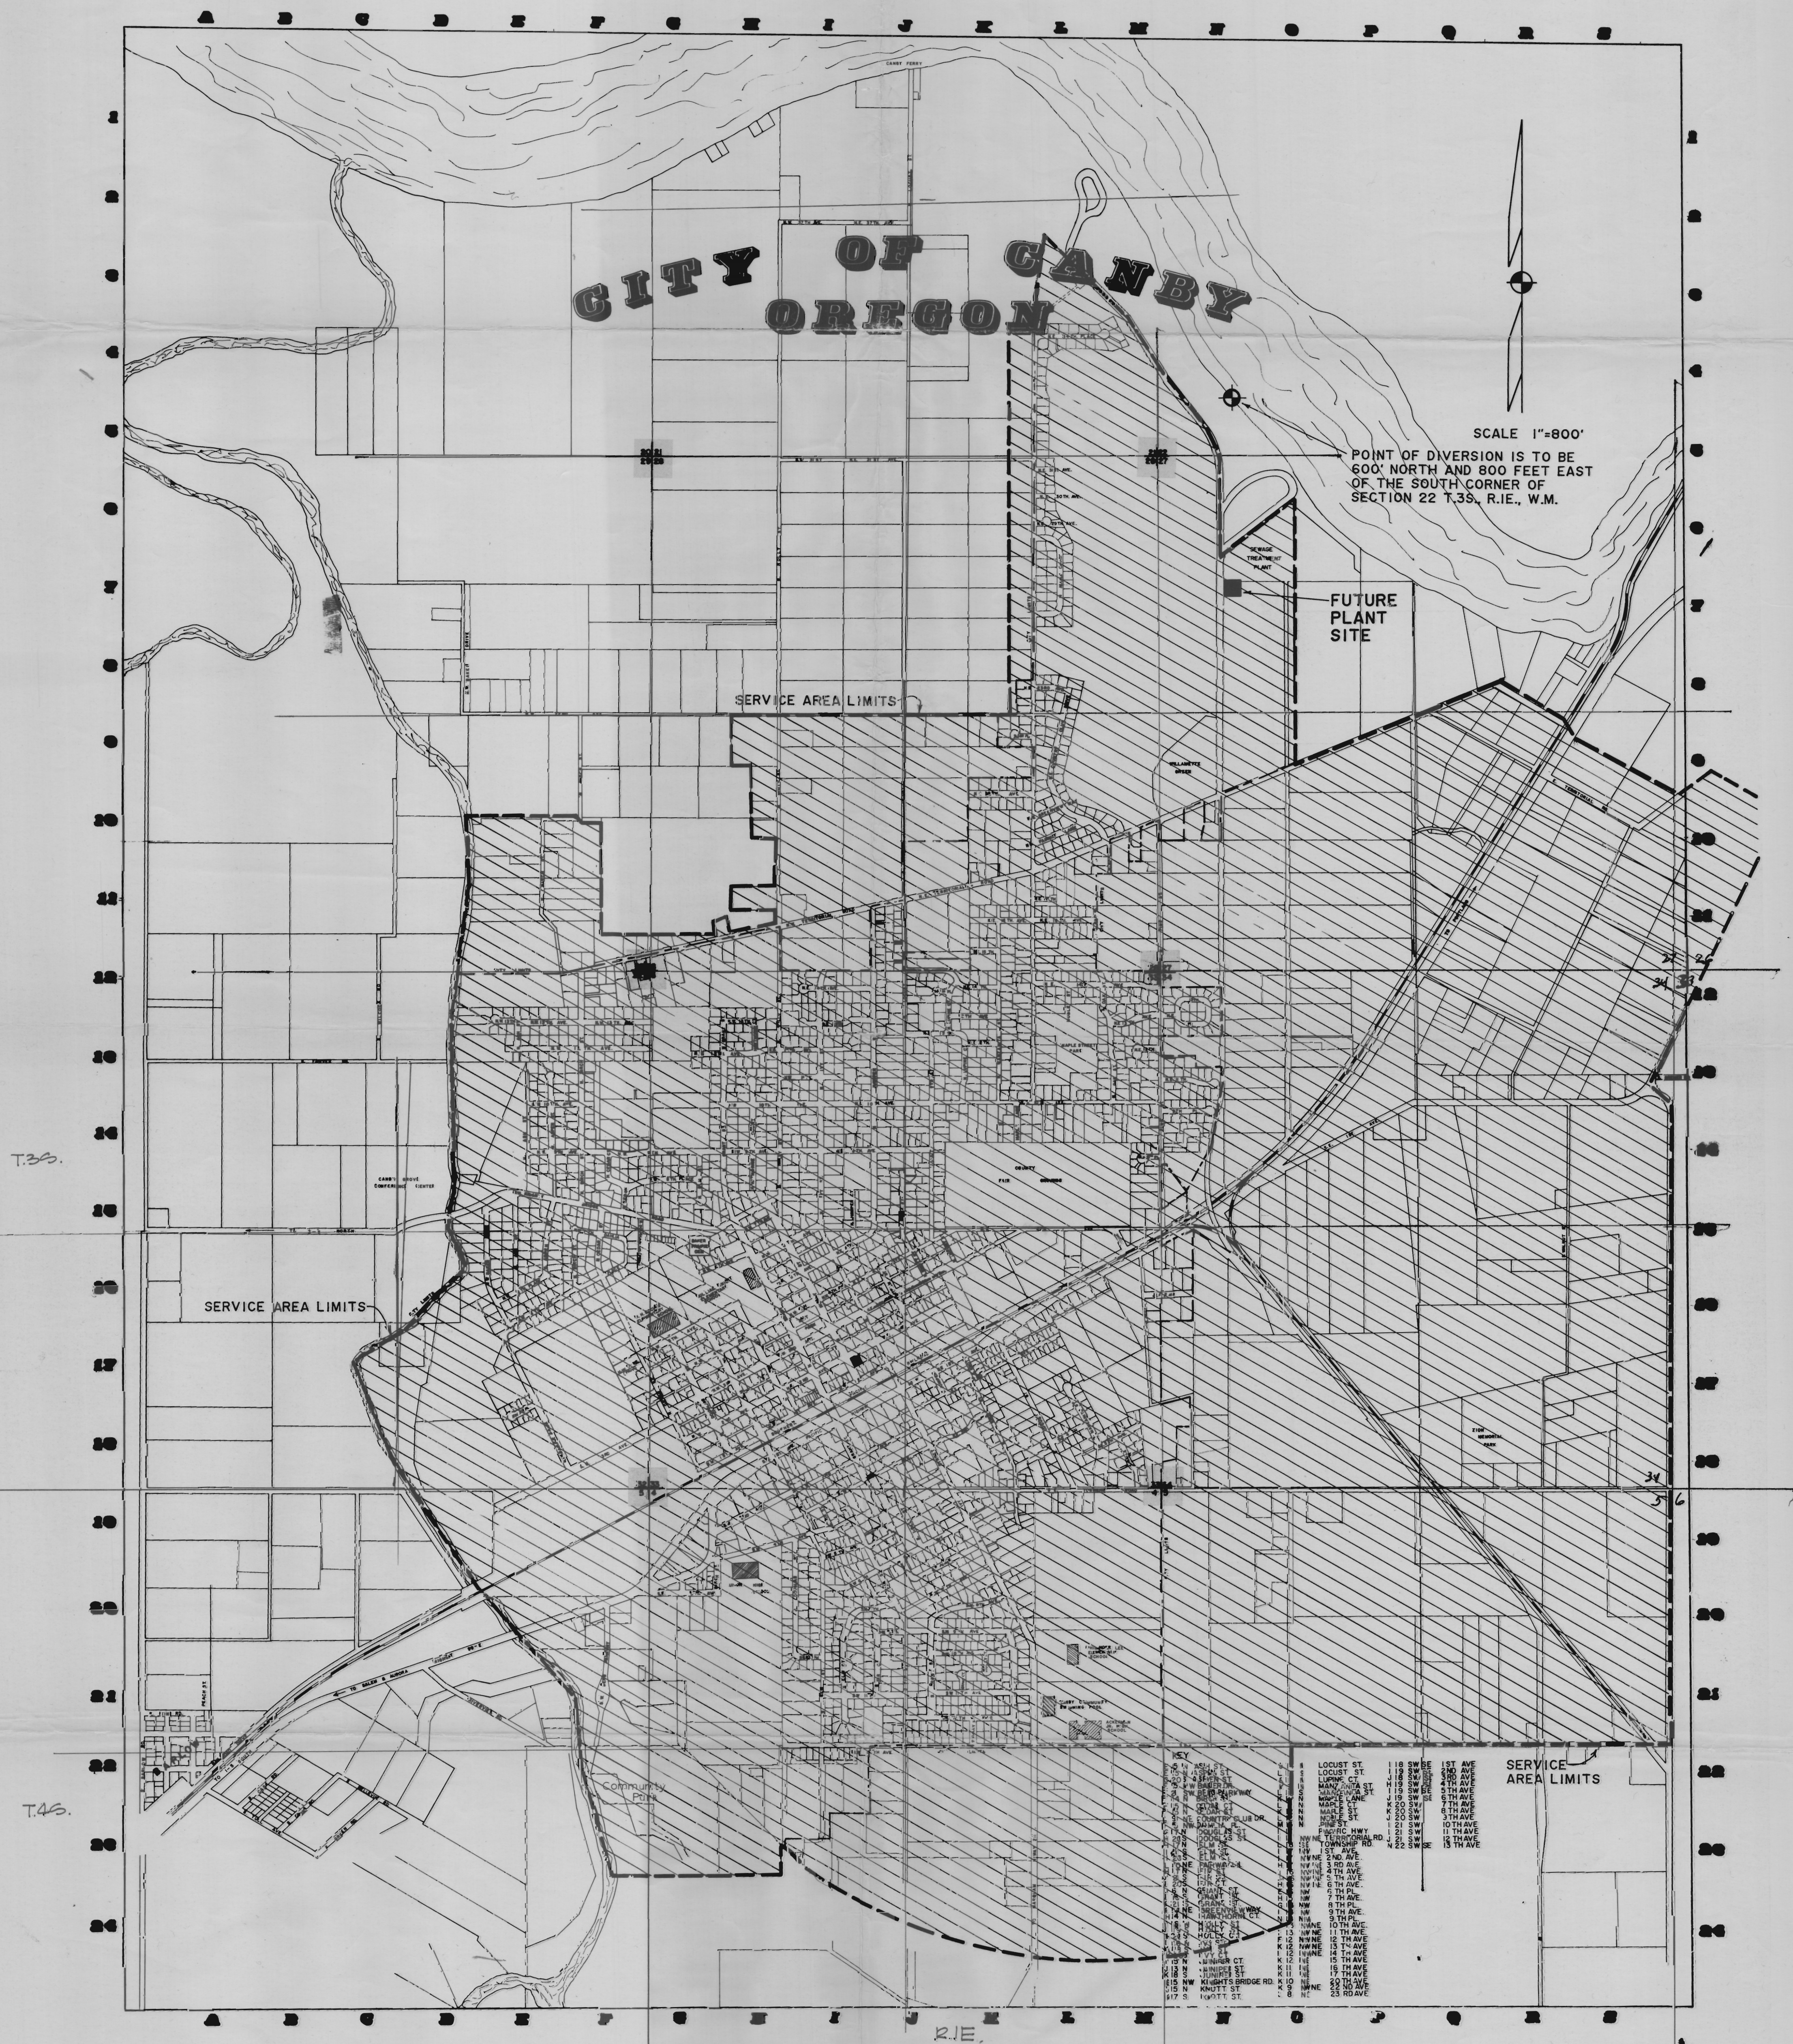

NOTE:
THE PURPOSE OF THIS MAP IS TO IDENTIFY THE
LOCATION OF THE WATER RIGHT. IT IS NOT INTENDED
TO PROVIDE INFORMATION RELATIVE TO THE LOCATION
OF THE PROPERTY OWNERSHIP BOUNDARY LINES.

NOVEMBER 1990



Curran-McLeod, Inc.
Consulting Engineers
7460 SW Hunziker Rd.
Portland, Oregon 97223