

Prepared by:
Bebe Hawk
Hssi. Wm Dist #10
4-28-09


Map A

G-17228

SECTION PLAT

Section 9 Township 33S Range 31E
County of Harney State of Oregon


NORTH Tax Lot 1100

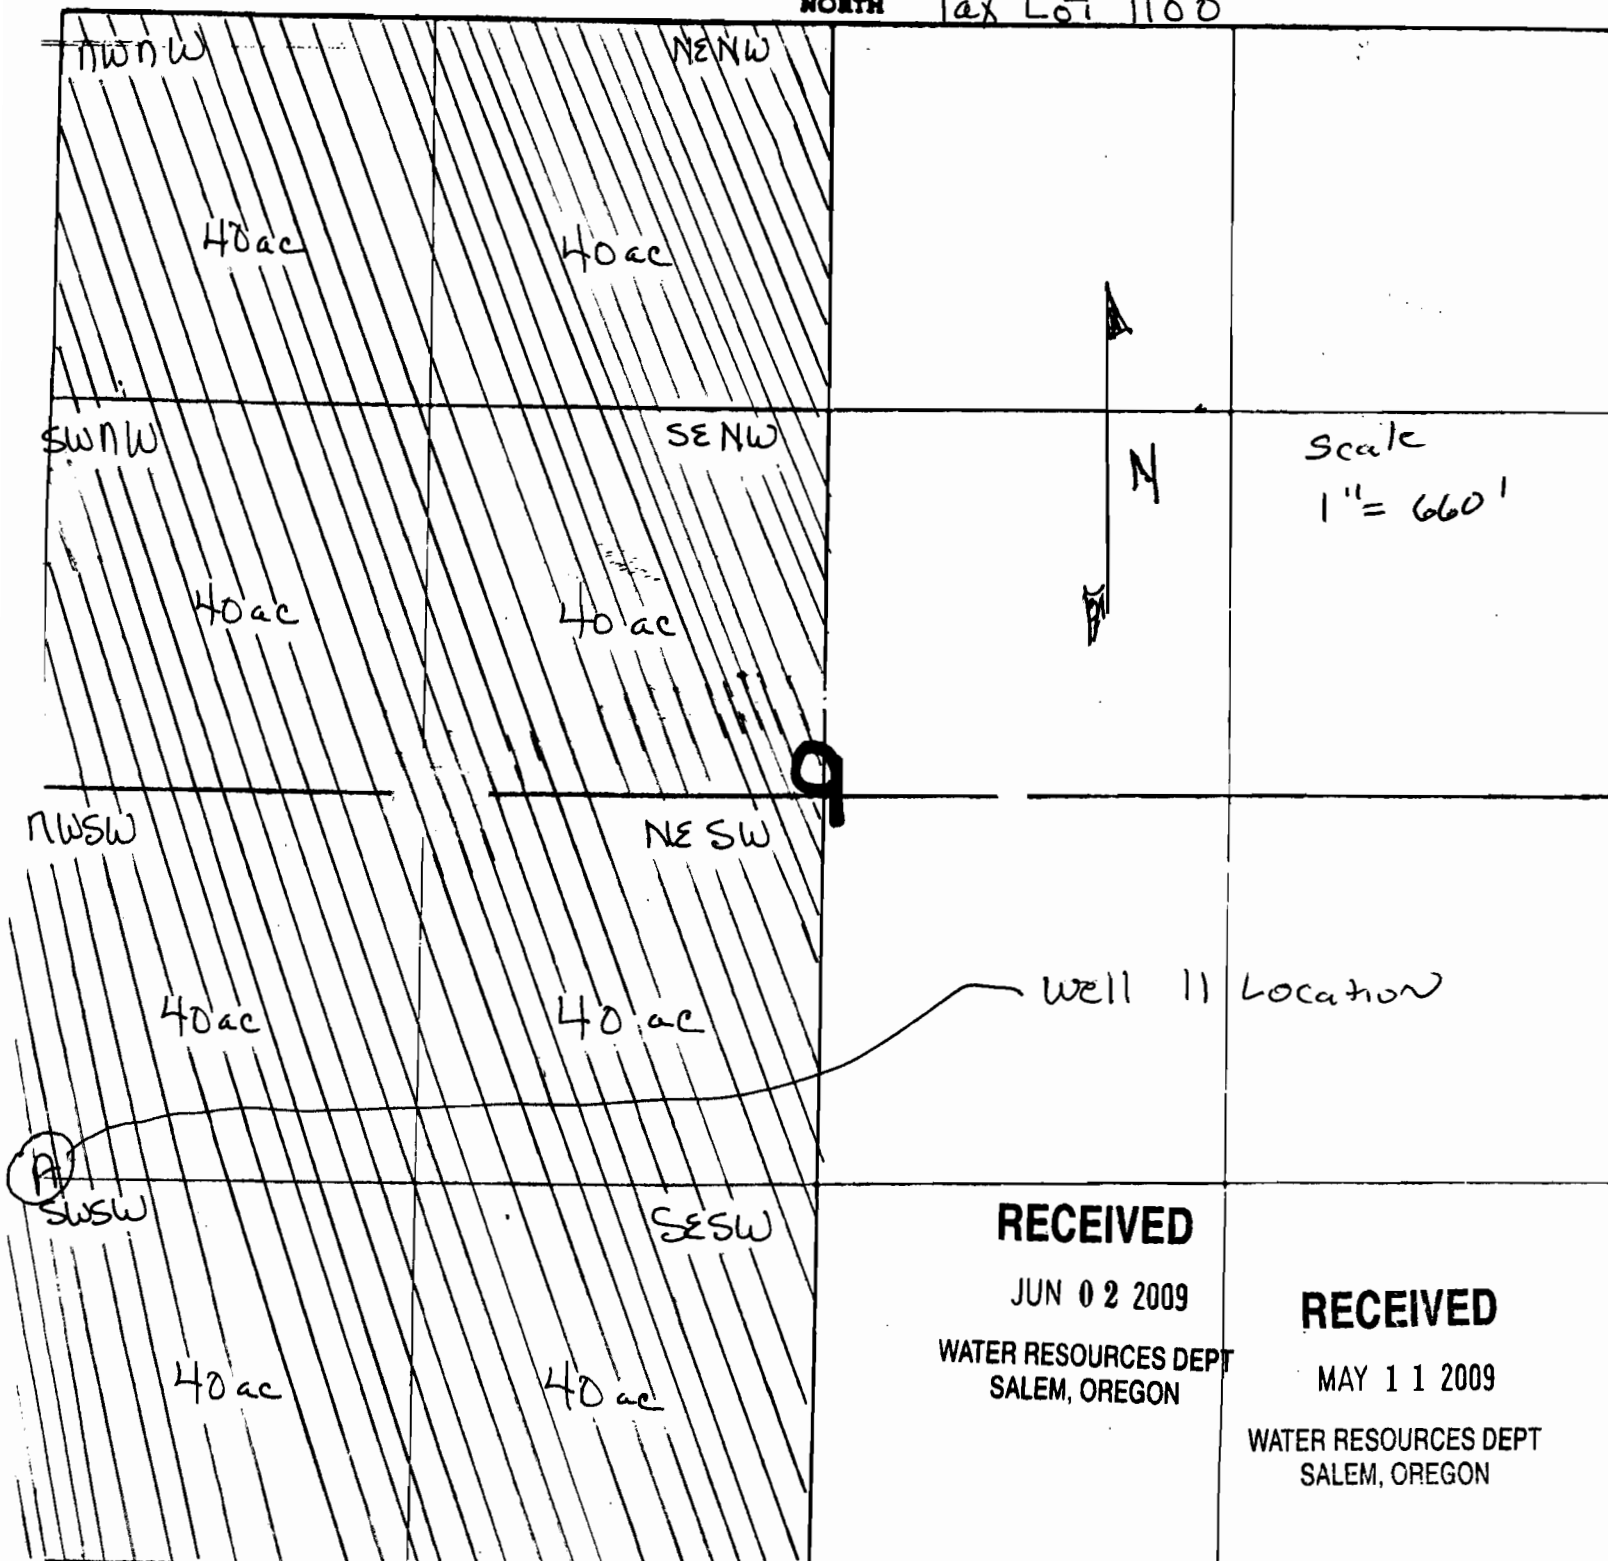

RECEIVED
JUN 02 2009
WATER RESOURCES DEPT
SALEM, OREGON

RECEIVED
MAY 11 2009
WATER RESOURCES DEPT
SALEM, OREGON

Holmgren Dairy LLC
36605 Rock Creek LN
Frenchglen, Oregon 97736

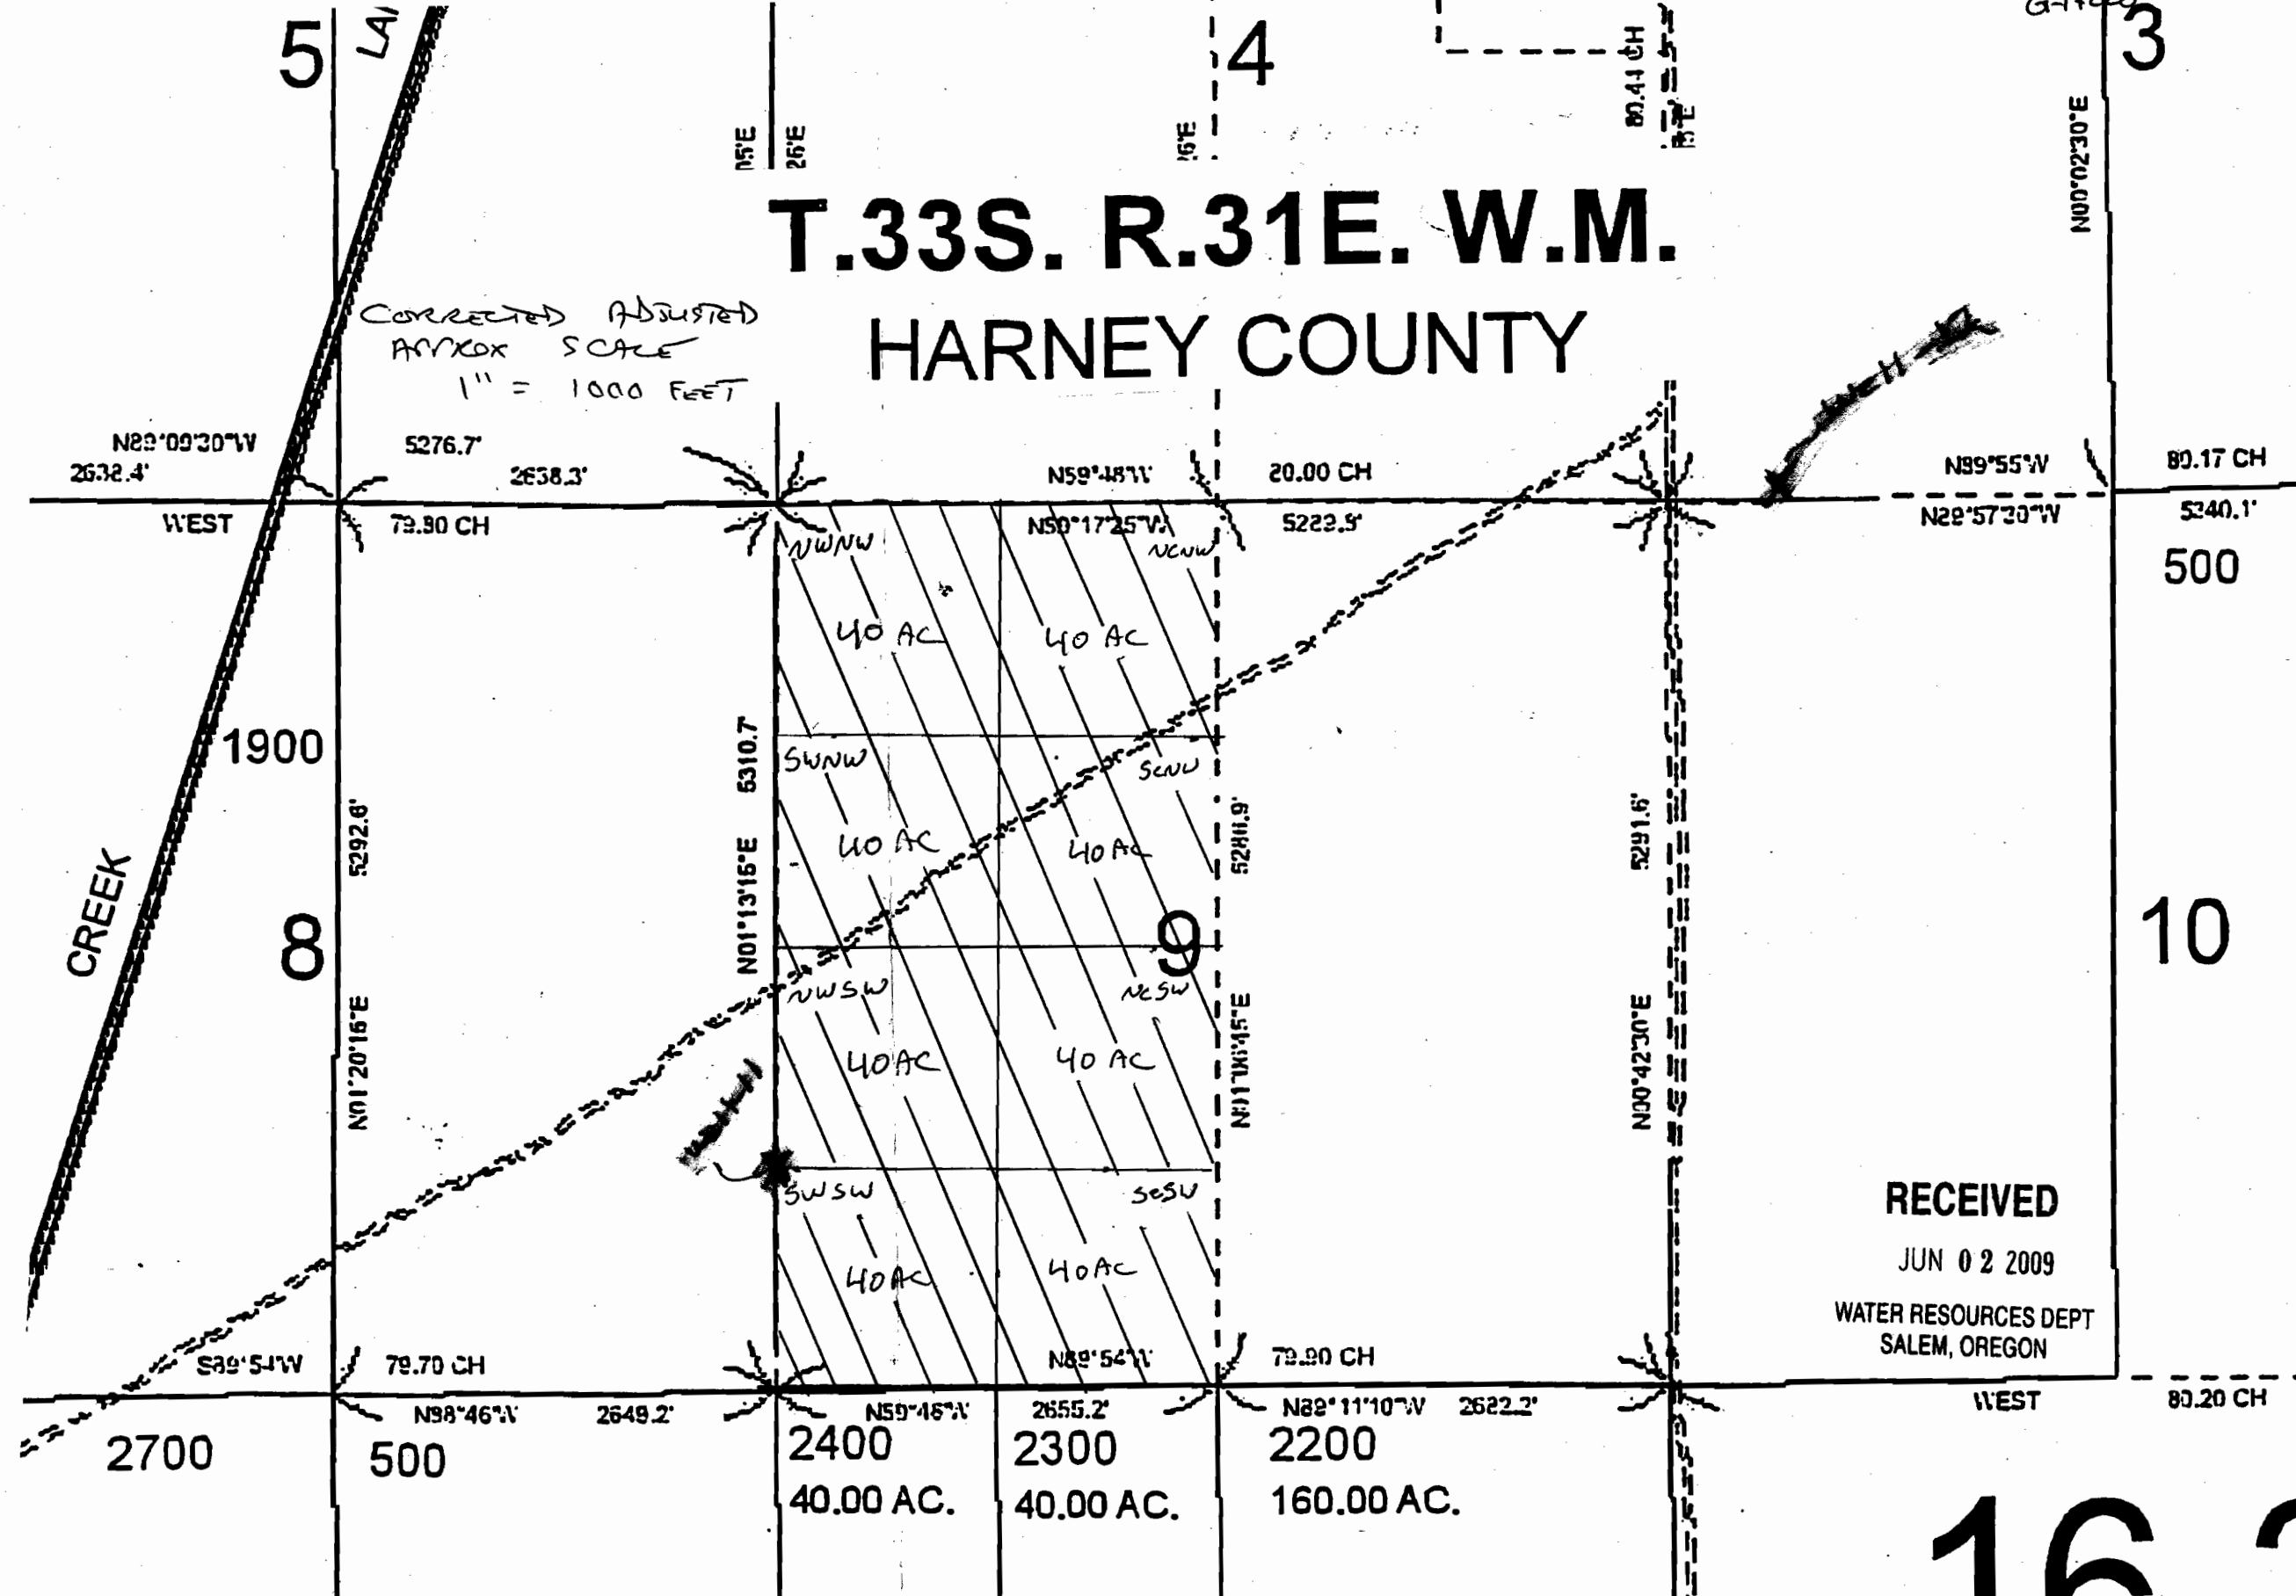

MAP C

