T. 26 S., R. 33 E., W.M.

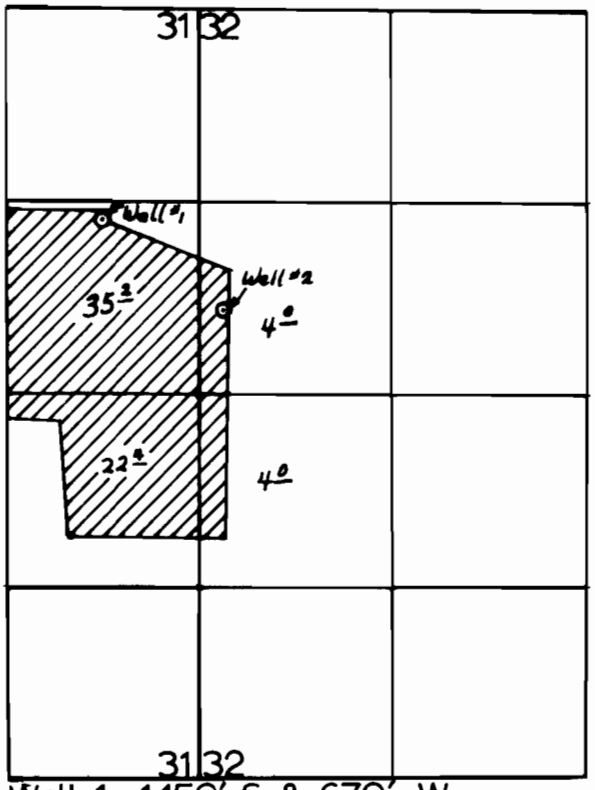

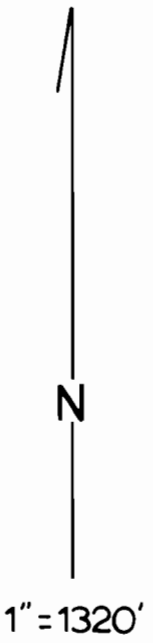

Well 1 - 1450' S. & 670' W.,
Well 2 - 2060' S. & 160' E., both
from the N.E. 1/4 Corner Sec. 31.

FINAL PROOF SURVEY

UNDER

Application No. G-9415 Permit No. G-8773
IN NAME OF

JOHN WOOSTER

Surveyed 10-31, 1990, by K. KEMP

Drafted 4-6-93 JM 41025-179-289-D