


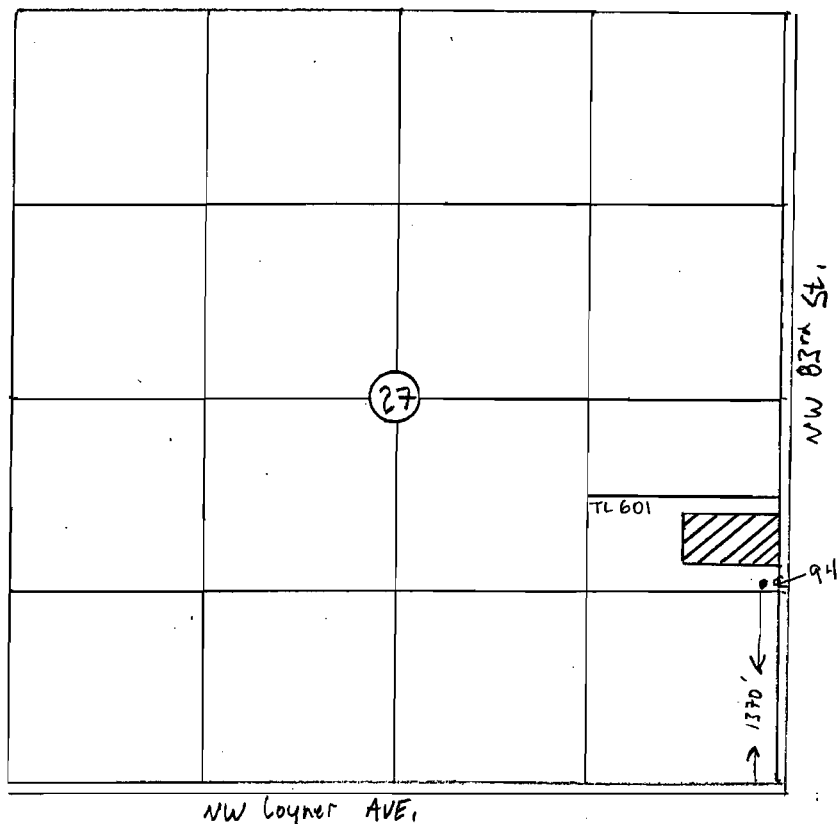

Scale
1"=1320'



RECEIVED

JUN 05 2009

WATER RESOURCES DEPT
SALEM, OREGON

Township 14 South Range 12 East
Section 27, W.M.

well location: 1370' North & 94' west From SE Corner Section 27, NESE
Township 14 South Range 12 East, W.M.

Application No. Permit No.
IN NAME OF

..... Ted Moore

Surveyed 19....., by