


SECTION 22
T17 S. R44 E. W.M.

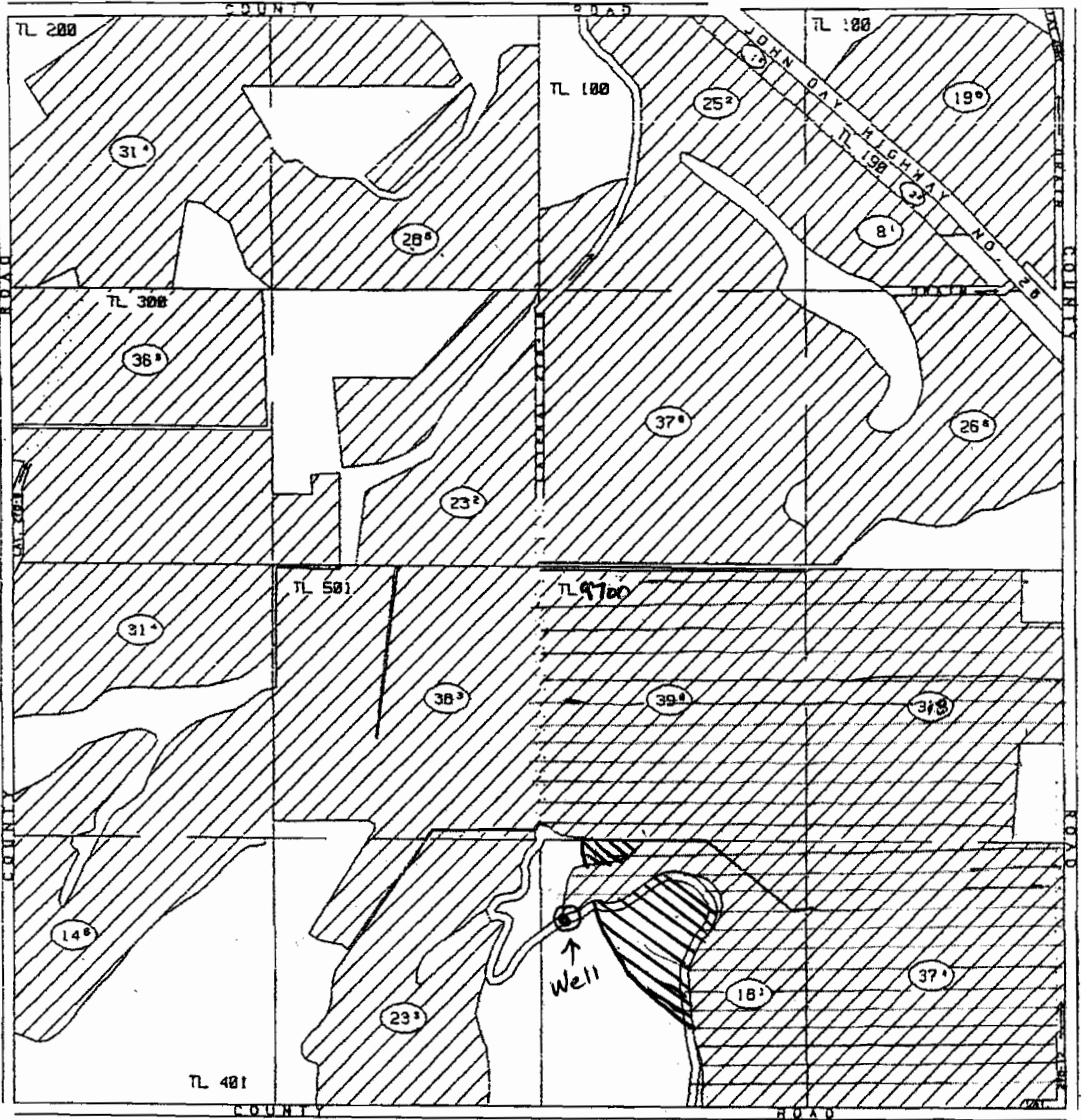

PROPERTY BOUNDARY

BURIED PIPE

BRIDGE


DIVERSION DAM



Vale Oregon
Irrigation
District

SCALE 1 INCH = 1320 FEET

HB 3111 Petition			
Page	of	Pages	
Digitized By	RJ & LHP	Approved	

 Primary 6.5

 Supplemental 126.3



NESE 31.8
NWSE 39.0
SWSE 18.1
SESE 37.4

Tax Lot 9700


RECEIVED

JUN 05 2009

WATER RESOURCES DEPT
SALEM, OREGON

SECTION 22
T17 S. R44 E. W.M.

G-17232

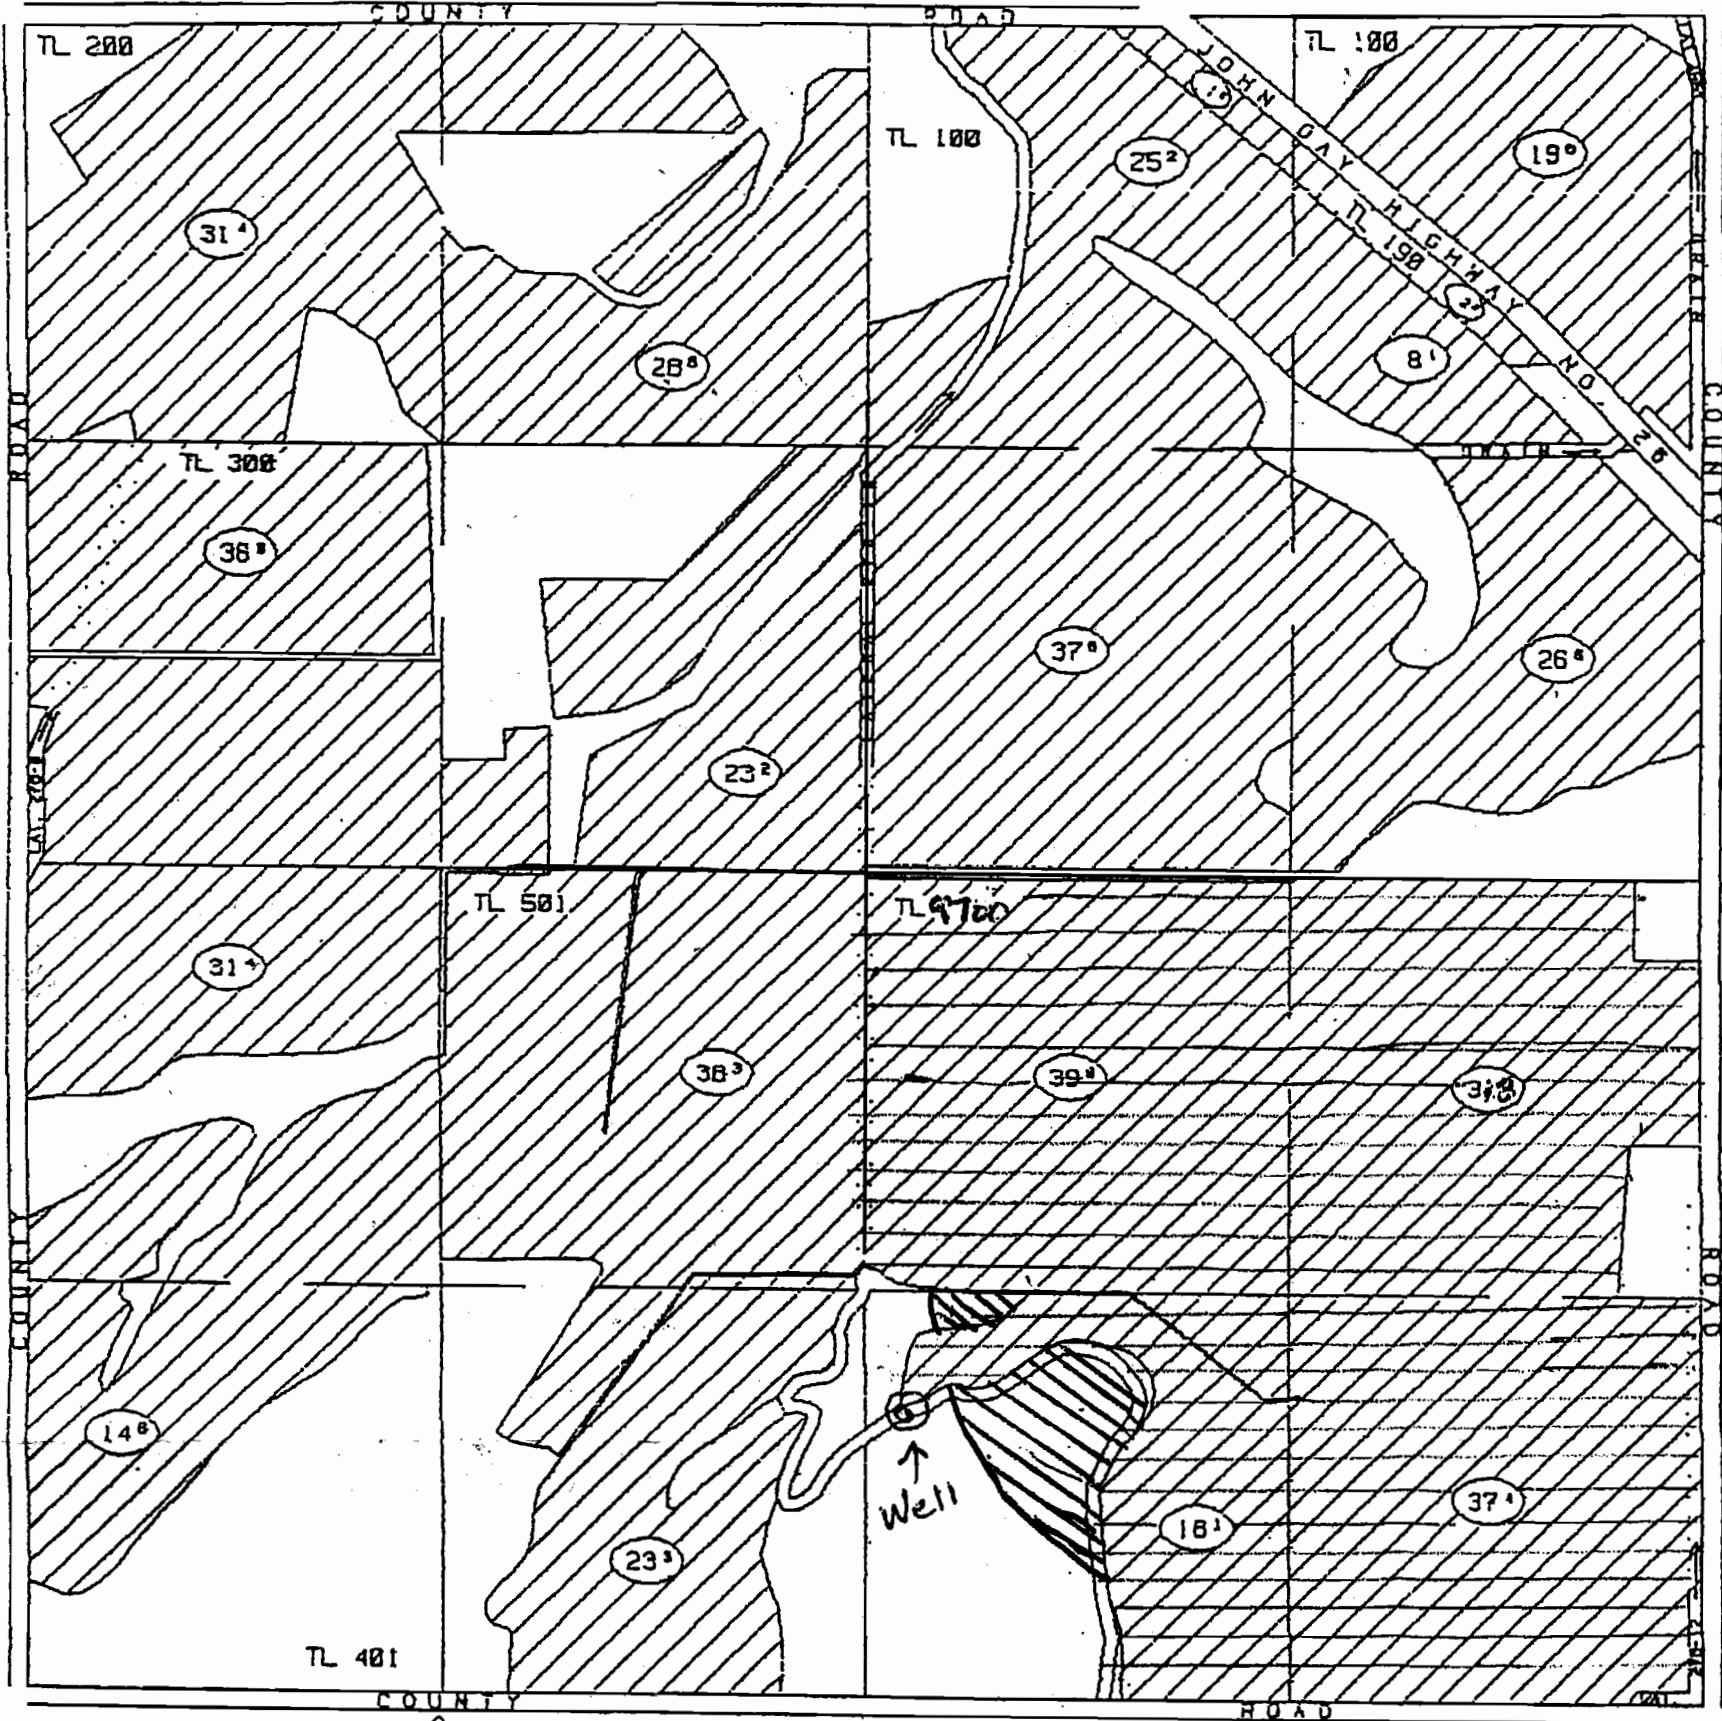

WELL LOCATED FROM CENTER SECTION 22
1690 FE SOUTH
110 FE EAST

COLLECTED APPROX. ADJUSTED SCALE 1" = 600 FT.


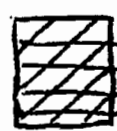
Vale Oregon
Irrigation
District

- PROPERTY BOUNDARY
- BURIED PIPE
- == BRIDGE
- DIVERSION DAM



SCALE 1 INCH = 1320 FEET

HB 3111 Petition			
Page		of	Pages
Digitized By	RJ & LHP	Approved	

 Primary 6.5
 Supplemental 126.3
Tax Lot 9700

NESE 31.8
NWSE 39.0
SWSE 18.1
SESE 37.4

RECEIVED
JUN 05 2009
WATER RESOURCES DE
SALEM, OREGON