


SEC. 14 RES. #1 (EXISTING)

UPPER CRANE CRK. RANCH

R-87466

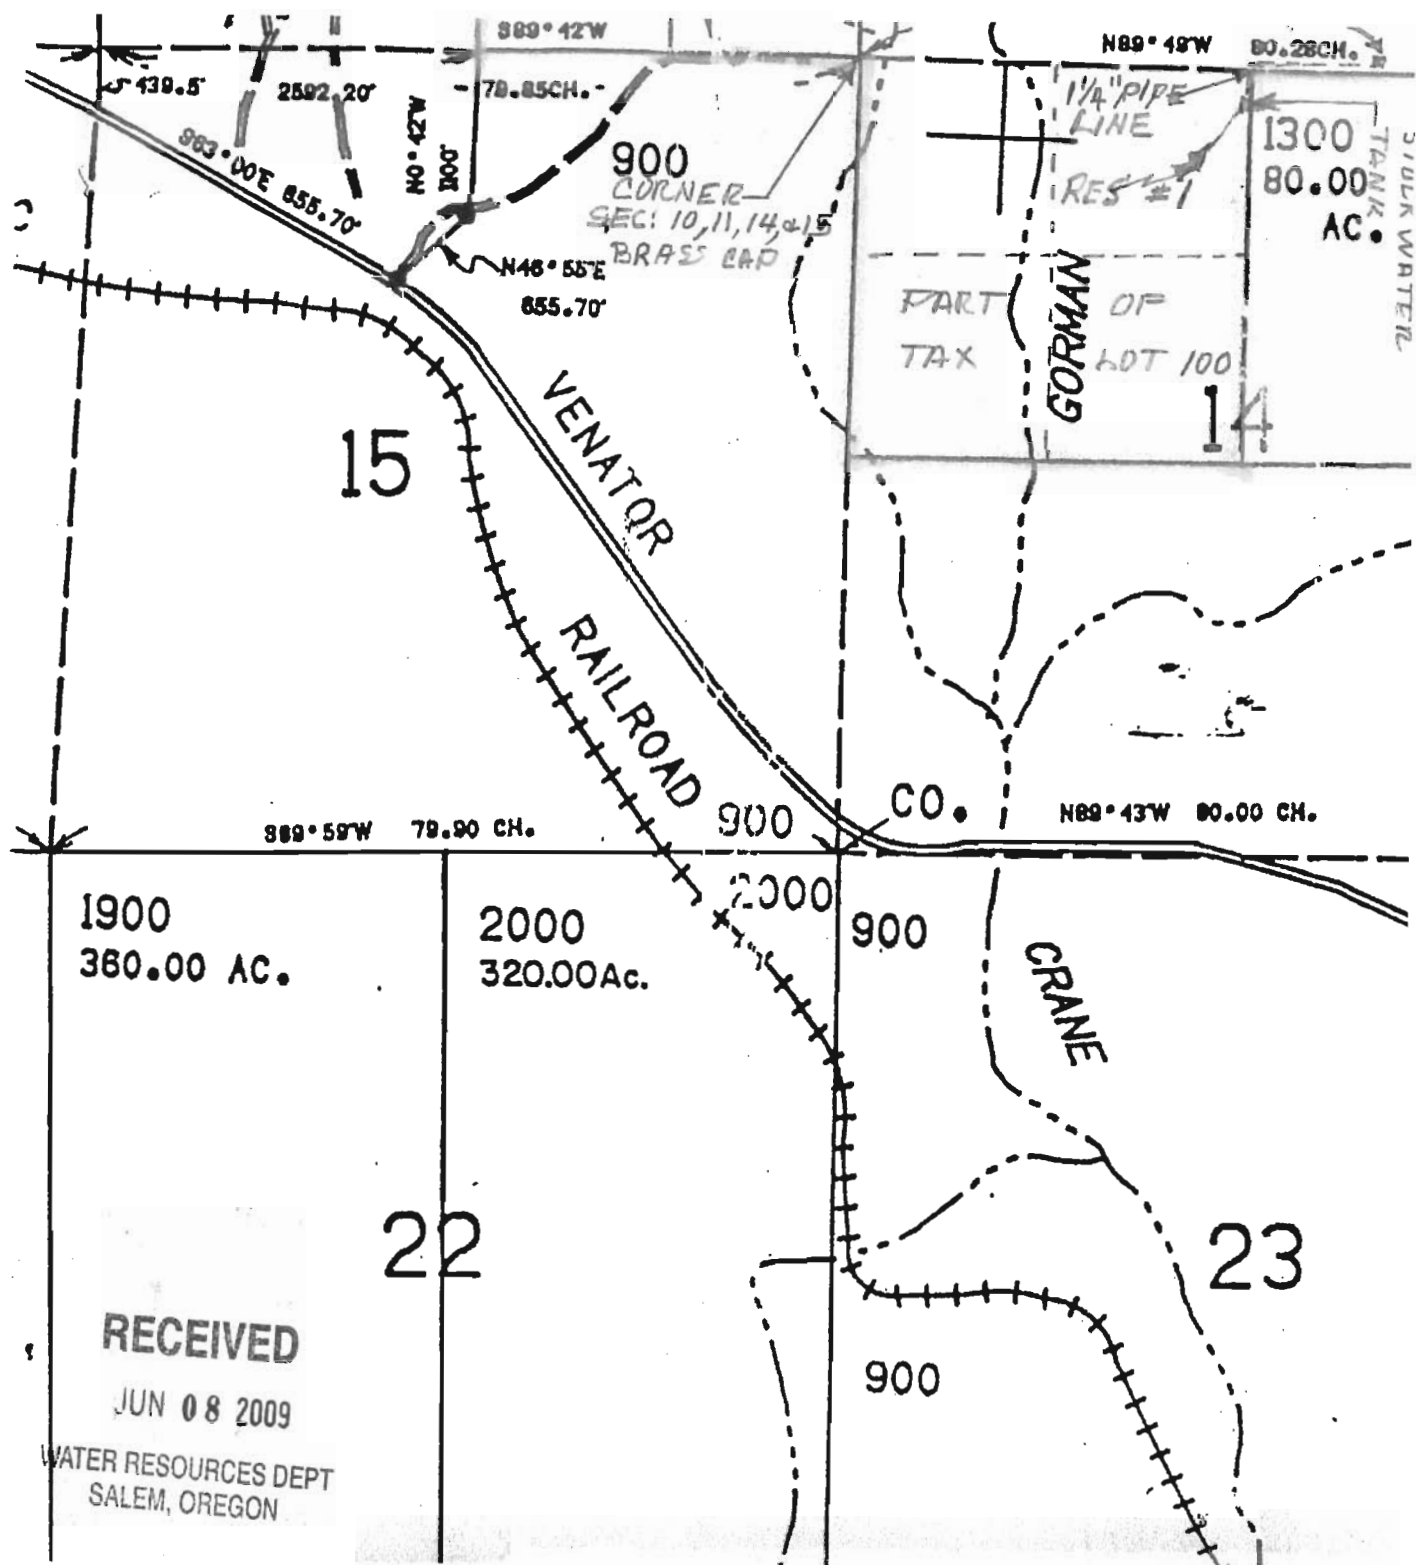

PROPERTY LINE

TAX LOT 100
TSP 25S R34E SEC 14
HARNEY COUNTY, OR.
NOTE: LOCATION: 2270' E &
580' S OF NW CORN
SEC. 14

SCALE: 1" = 1320'

DATE: 3-28-09

BY: TOM FENLL

RECEIVED

JUN 08 2009

WATER RESOURCES DEPT
SALEM, OREGON