
R-87468

RECEIVED

JUN 08 2009

WATER RESOURCES DEPT
SALEM, OREGON

LOWER GORMAN CRK. RES. #1 & #2
UPPER CRANE CREEK RANCH

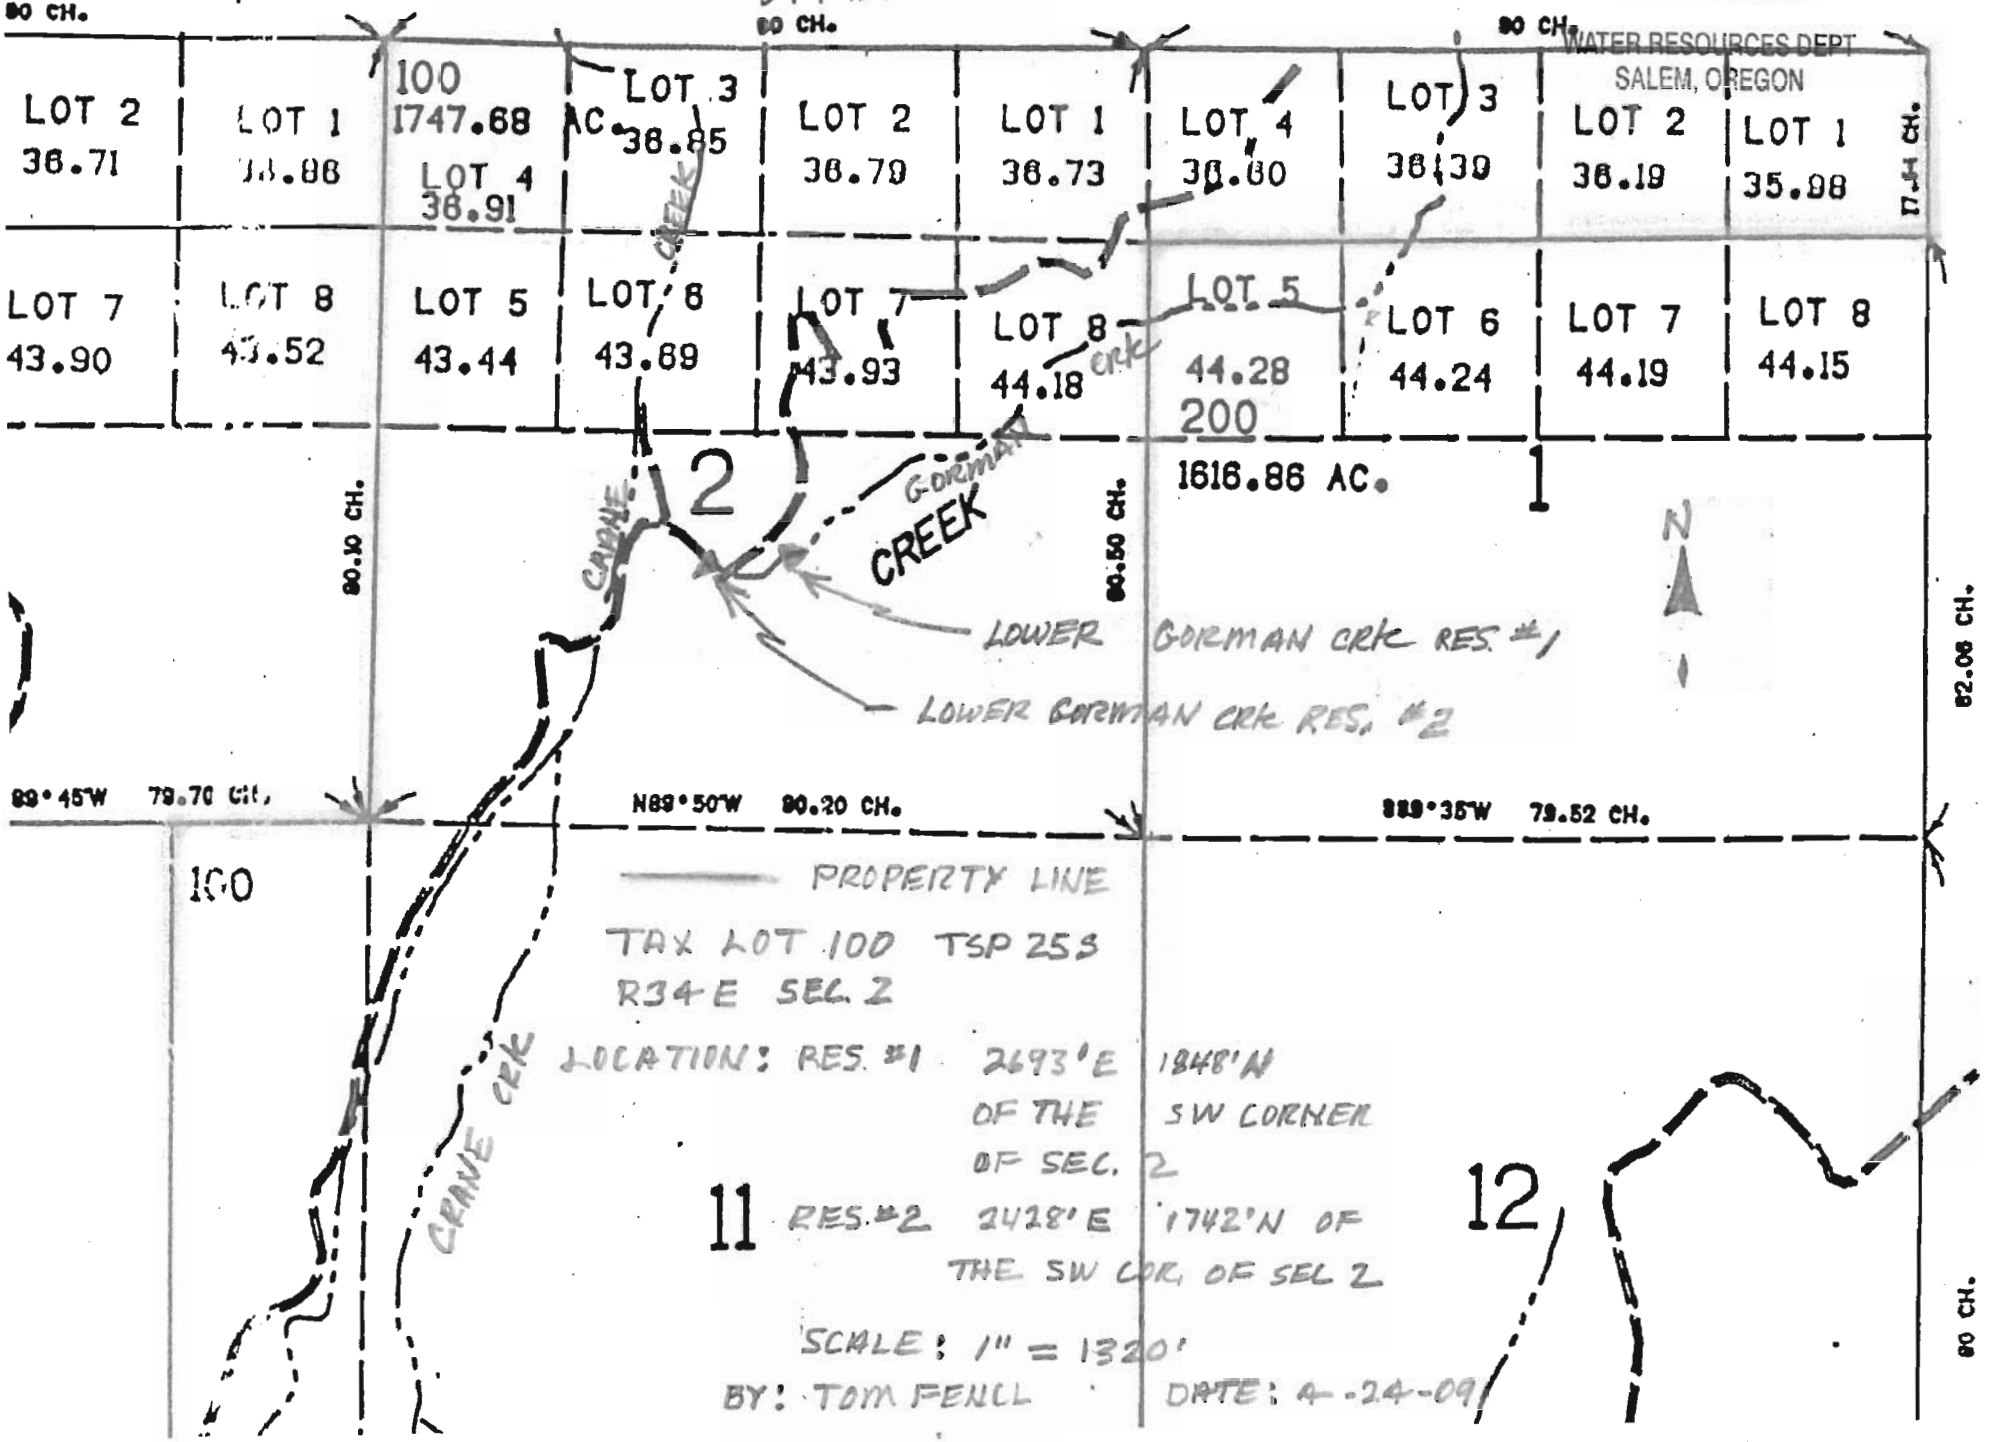

PROPERTY LINE

TAX LOT 100 T5S R34E SEC. 2

LOCATION: RES. #1 2693'E 1848'N OF THE SW CORNER OF SEC. 2

RES. #2 2428'E 1742'N OF THE SW COR. OF SEC 2

SCALE: 1" = 1320'

BY: TOM FENCL DATE: 4-24-09