

JN 1 Y


P-82469

RECEIVED

JUN 08 2009

WATER RESOURCES DEPT
SALEM, OREGON

LOWER GORMAN CRK RES #1 & #2
UPPER CRANE CREEK RANCH

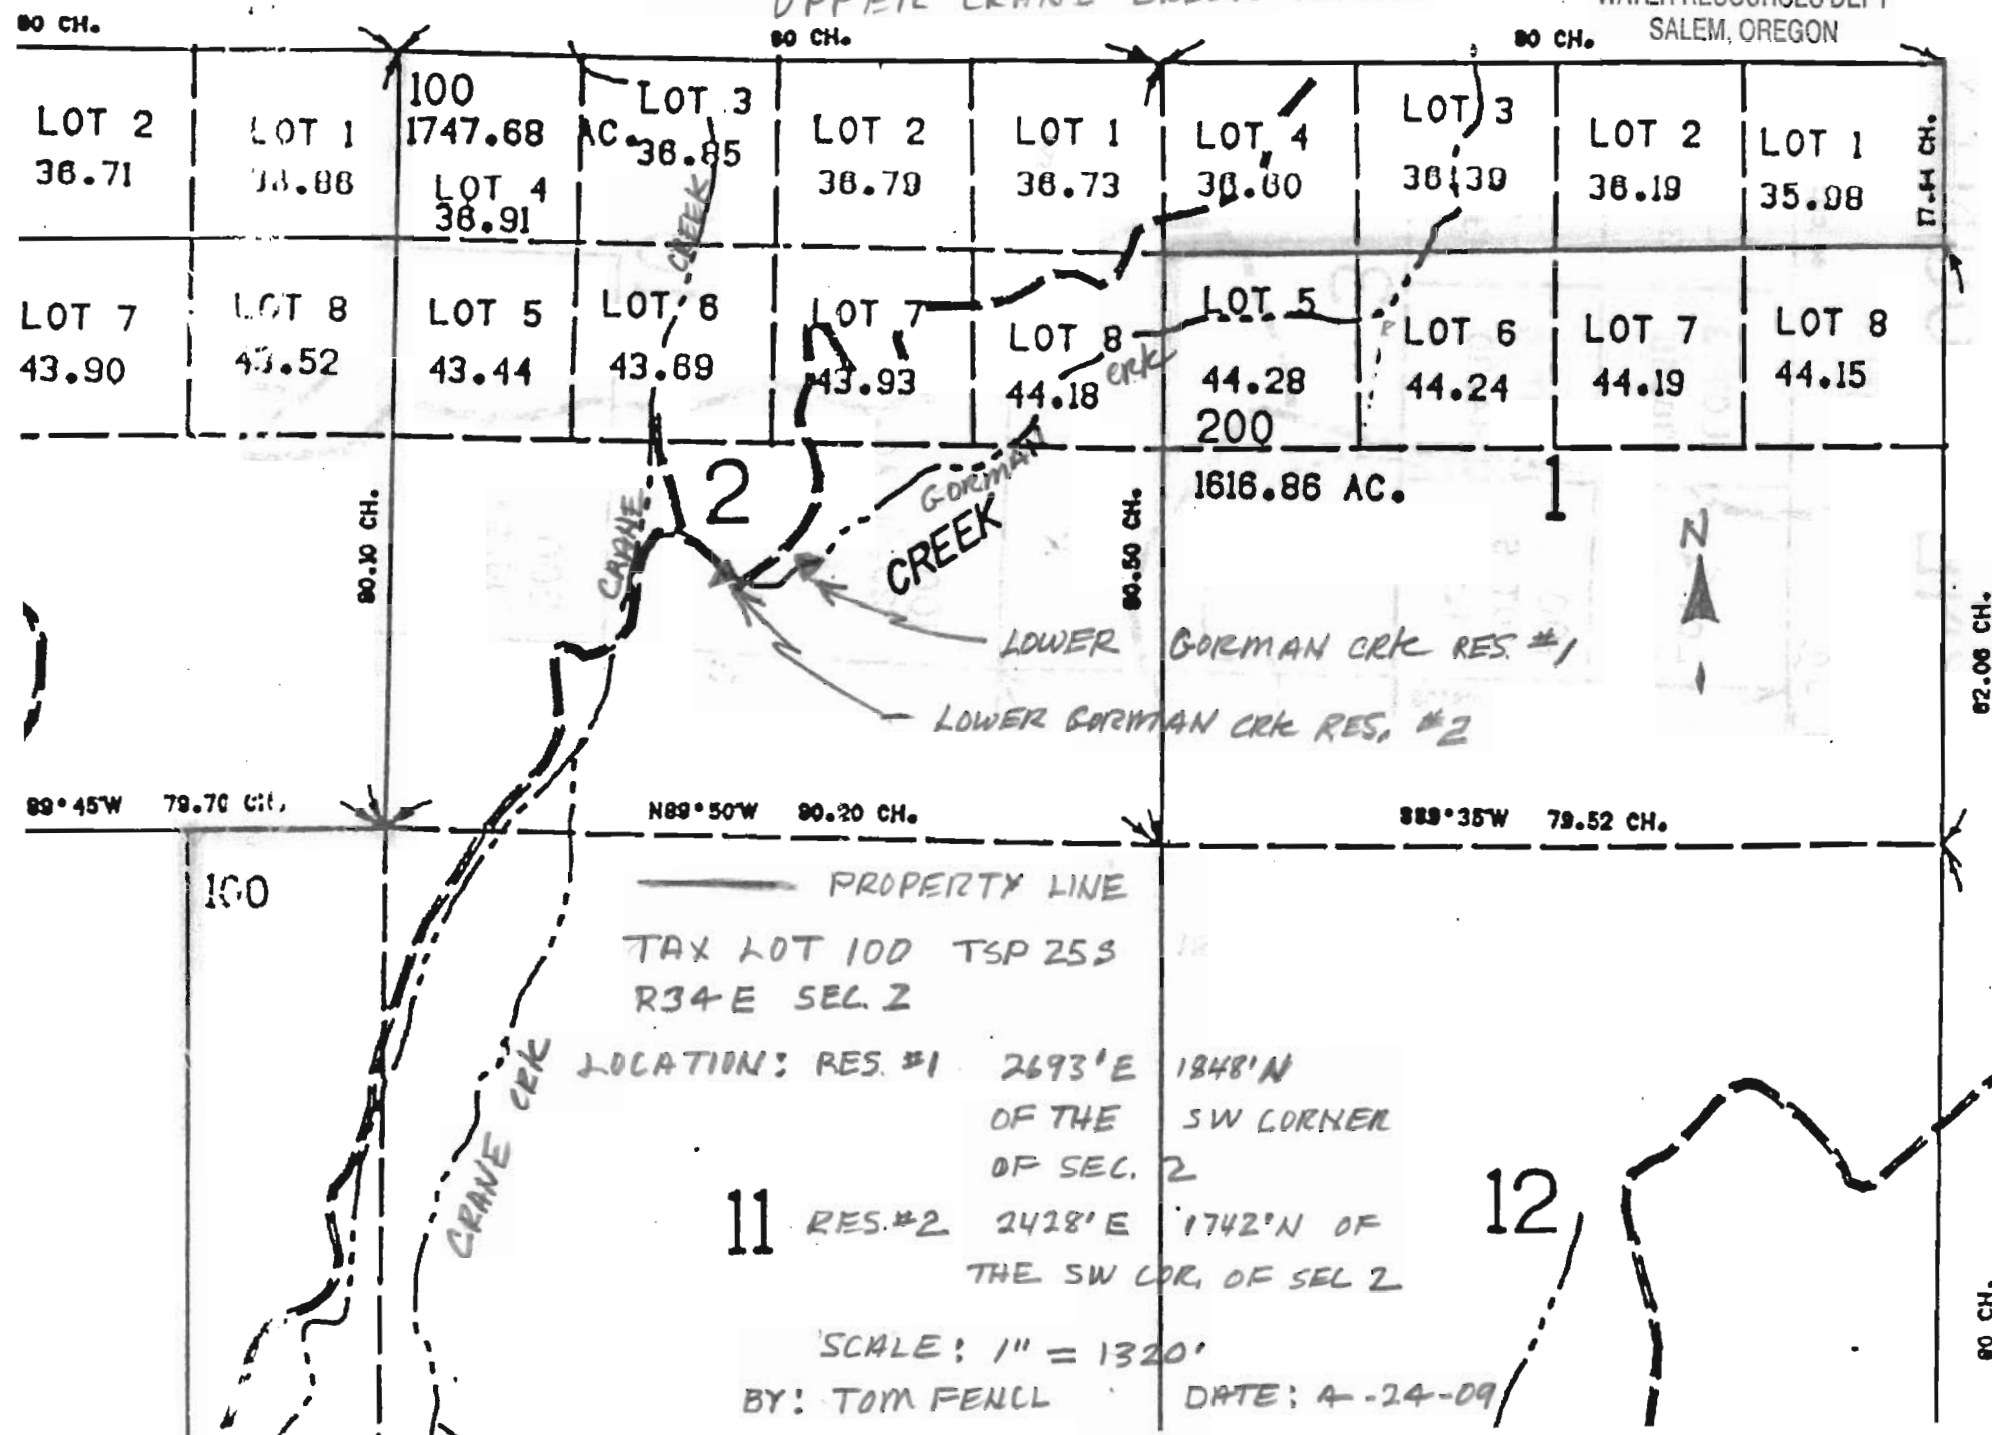

.889° 51W

78.76 CH.

ARNEY COUNTY

