

T.18S, R.8E, SECTION 32 X = NW corner, Section 32

BEND (U.S. 97) 32 MI.

S-8685D


7.5

1:62 500)

596

47'30" 597

598

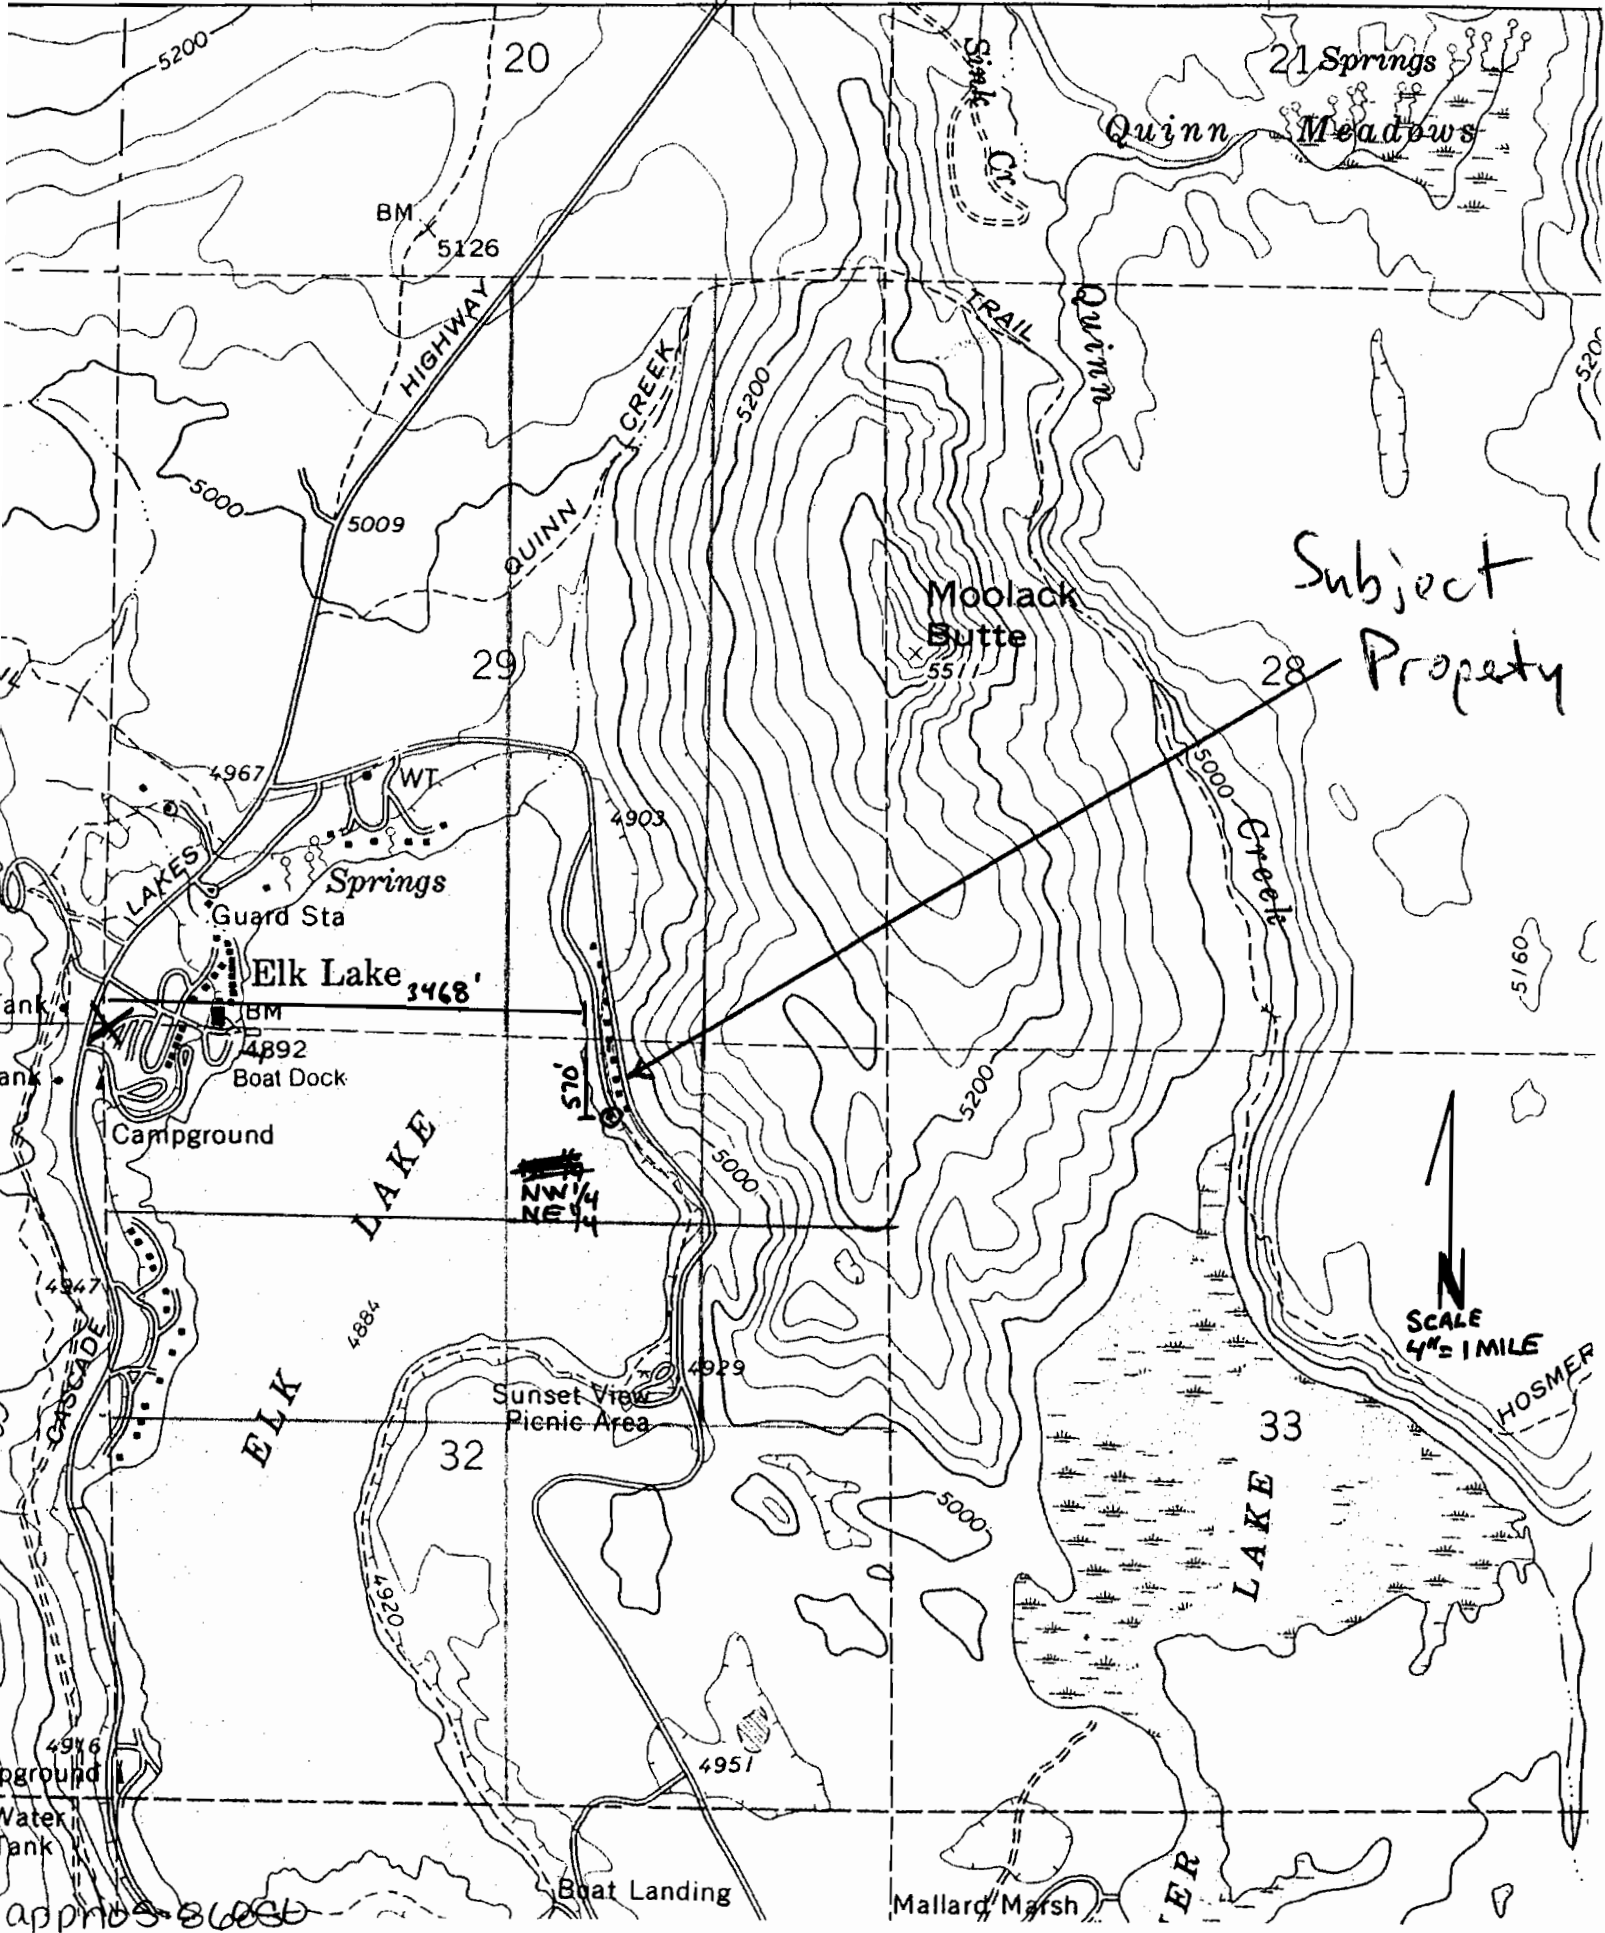

Subject Property

N
SCALE
4" = 1 MILE
HOSMER