


See Map 18 8

SUMMER HOMES

SEASONAL SPRING
SUBJECT OF THIS
APPLICATION

OLD FOREST SERVICE
PUMP HOUSE "

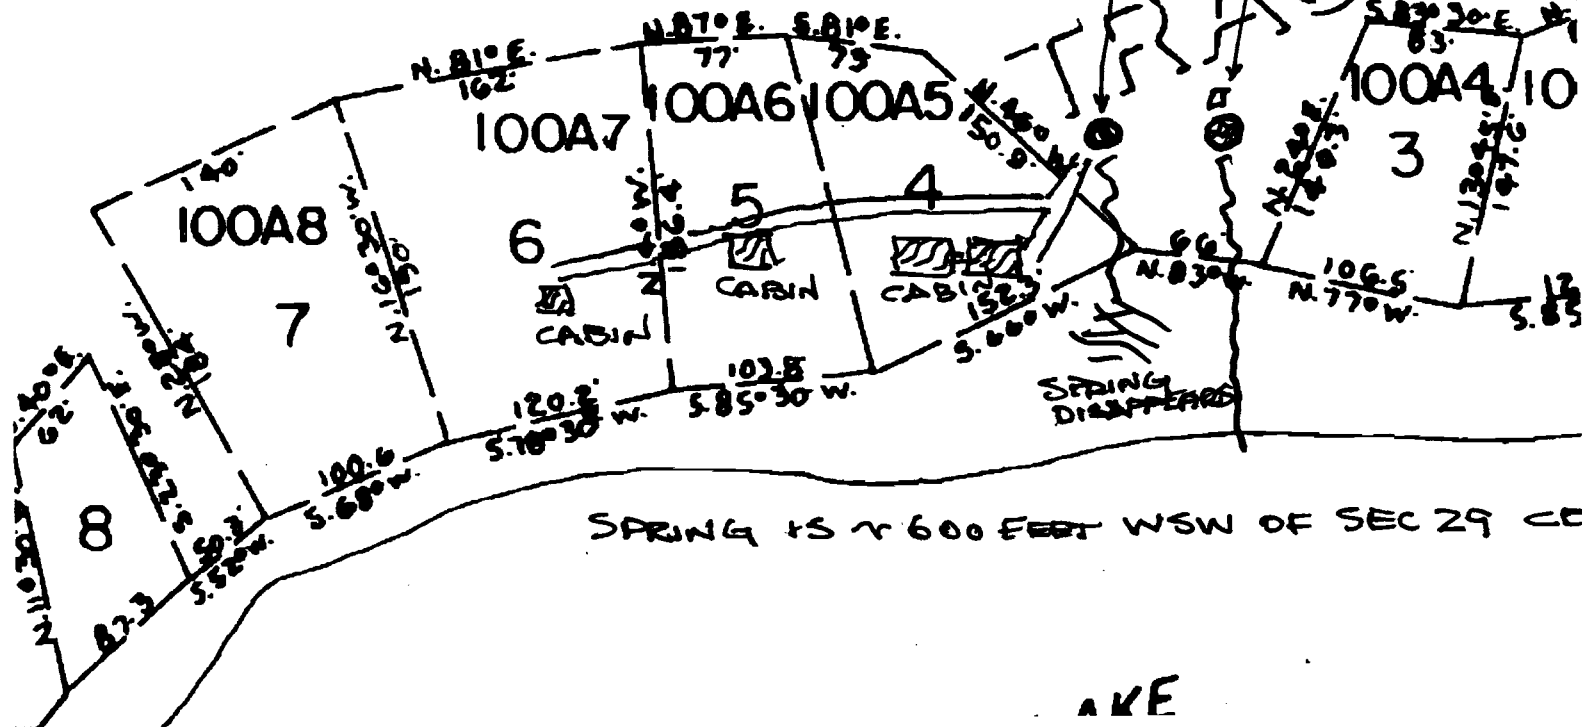

SPRING IS ~ 600 FEET WSW OF SEC 29 CENTER POINT

LAKE

PIPELINES
SOME BURIED
SOME ABOVE GROUND

1 IN. = 100 FT.

ELK LAKE

T18S R8E SEC29 NE1/4 SW1/4

USES TRACT 1 LOTS 4, 5, 6



RECEIVED

2007

appno 5-86956