

Mrs. James Hayes P.O. Box 989

mt. Ve pr Oregon 97865

HE-346

long.
119° 03' 35"

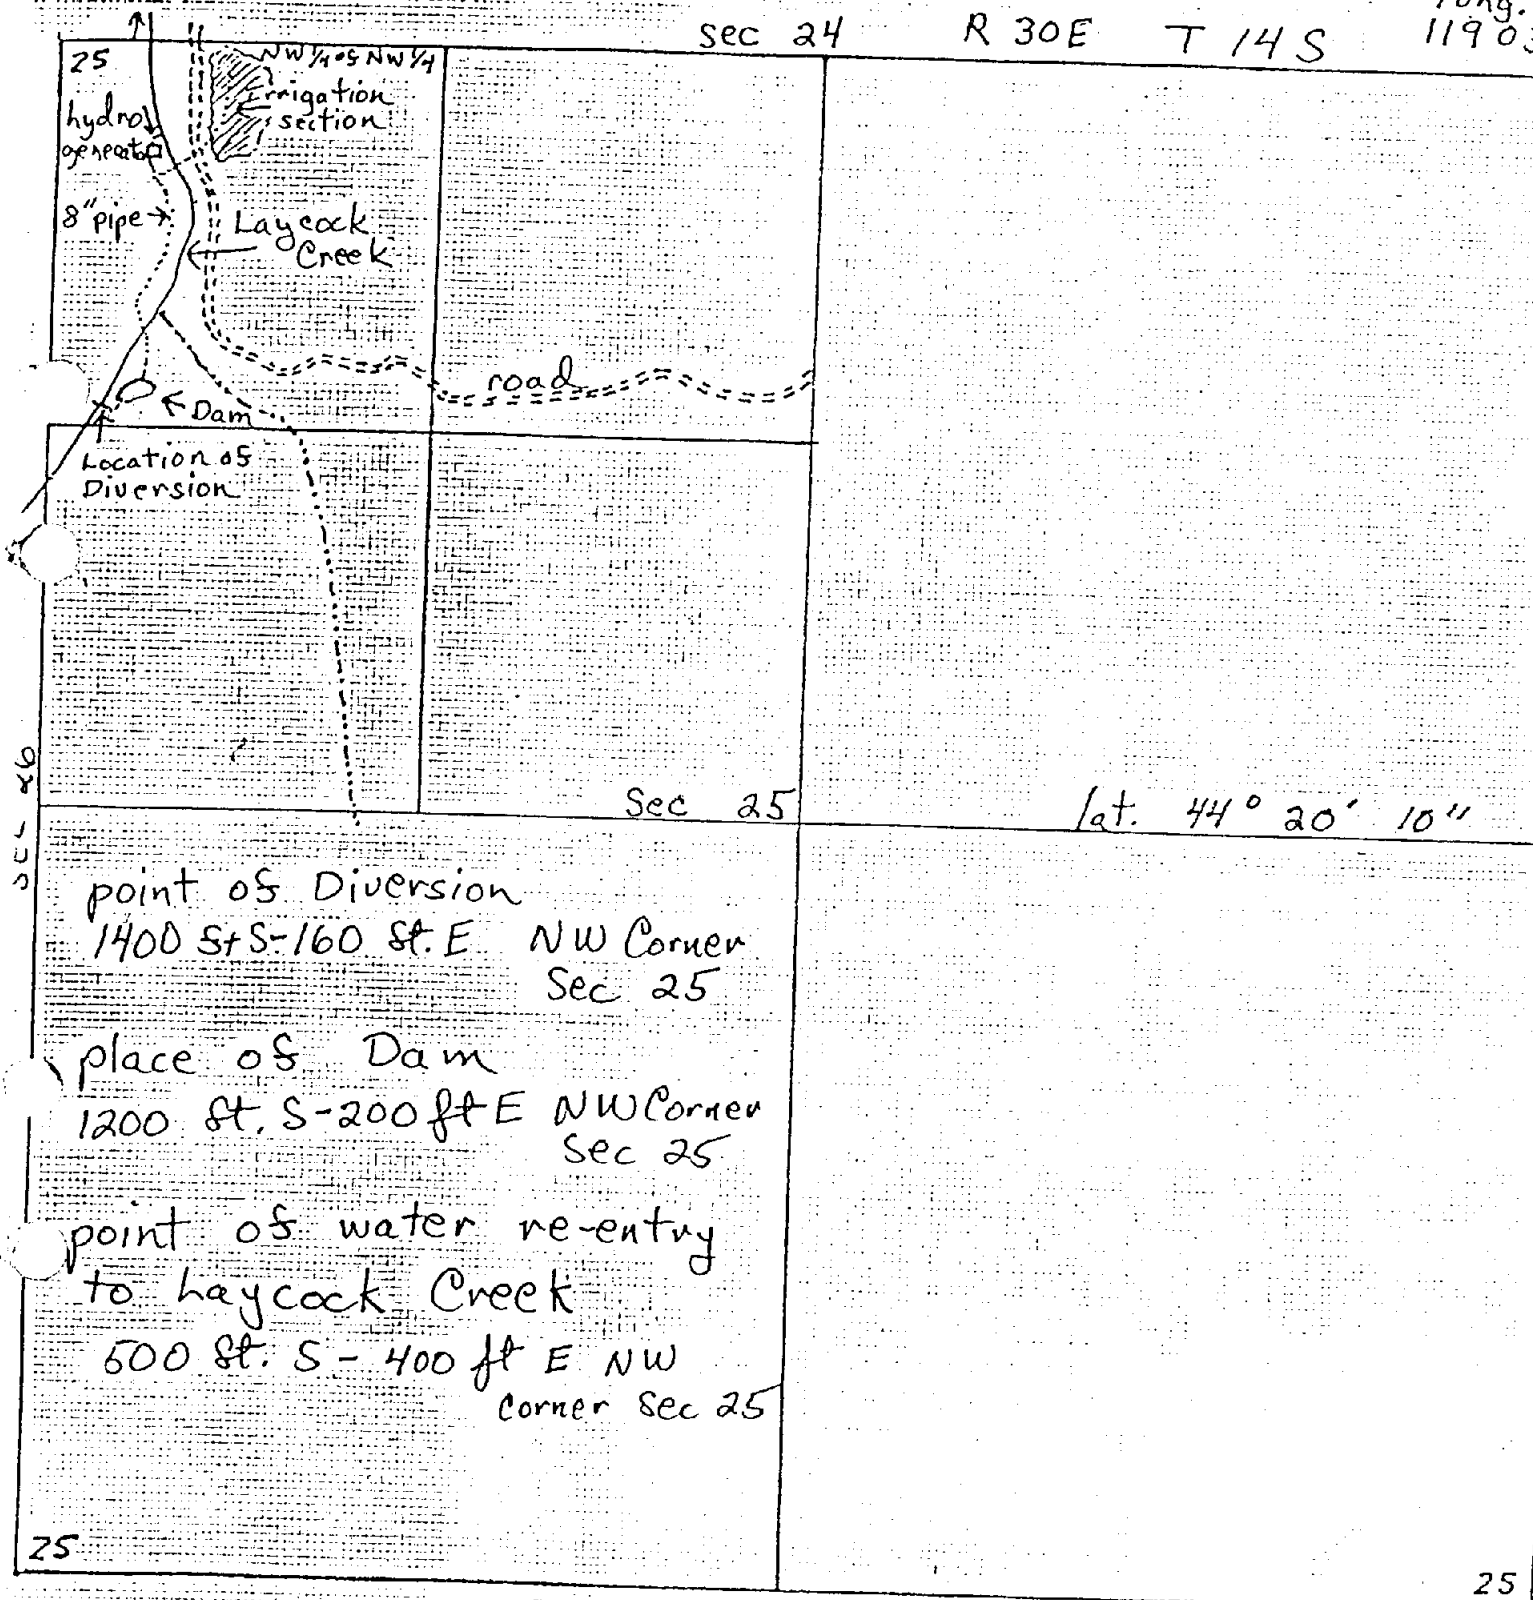


Exhibit A

long.
119° 03'

Sec 24

R 30E T 14S



Sec 36

8" To 1 mile