Attachment A - Groundwater Application Map

G-17238

Well Location

SW1/4 NW1/4 Sec. 31
T. 5N., R. 29E., W.M.;
520' N. & 440' E. from the
W 1/4 corner, Sec. 31
Umatilla Co. Basin 7

Acres

3.0 SWNW TL 1200

Key

POA = o (well #1)
POU = ///

N

NW1/4 SEC 31 T5N R29E WM
UMATILLA COUNTY

9/26/06

5N 29 31B

AERIAL PHOTO NO. 1P-101

~~SCALE 1"=200'~~

Scale: 1" = 400'

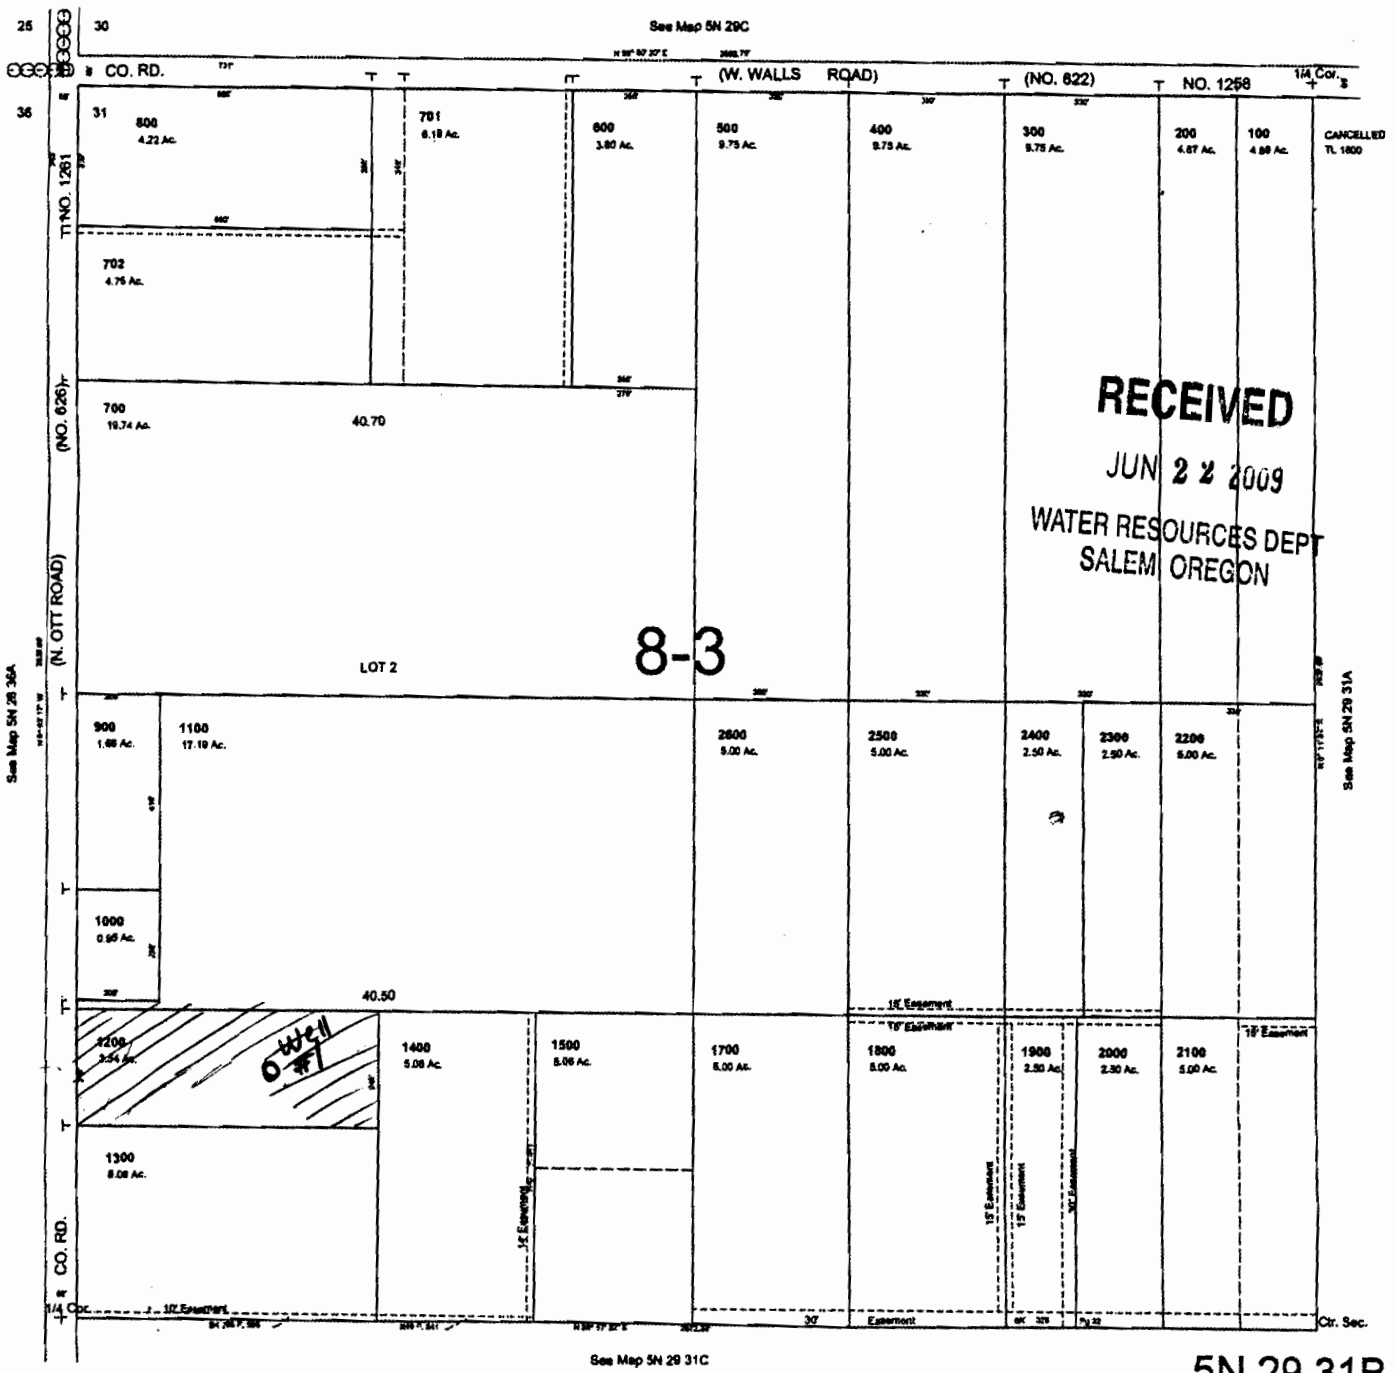

RECEIVED
JUN 22 2009
WATER RESOURCES DEPT
SALEM OREGON

5N 29 31B