

S-87480

RECEIVED


JUN 26 2009

WATER RESOURCES DEPT
SALEM, OREGON

2 SE 1888
SANDY

NW1/4 NW1/4 SECTION 18 T2S. R5E. W1M
CLACKAMAS COUNTY

FRANCIS REVENUES NO 37

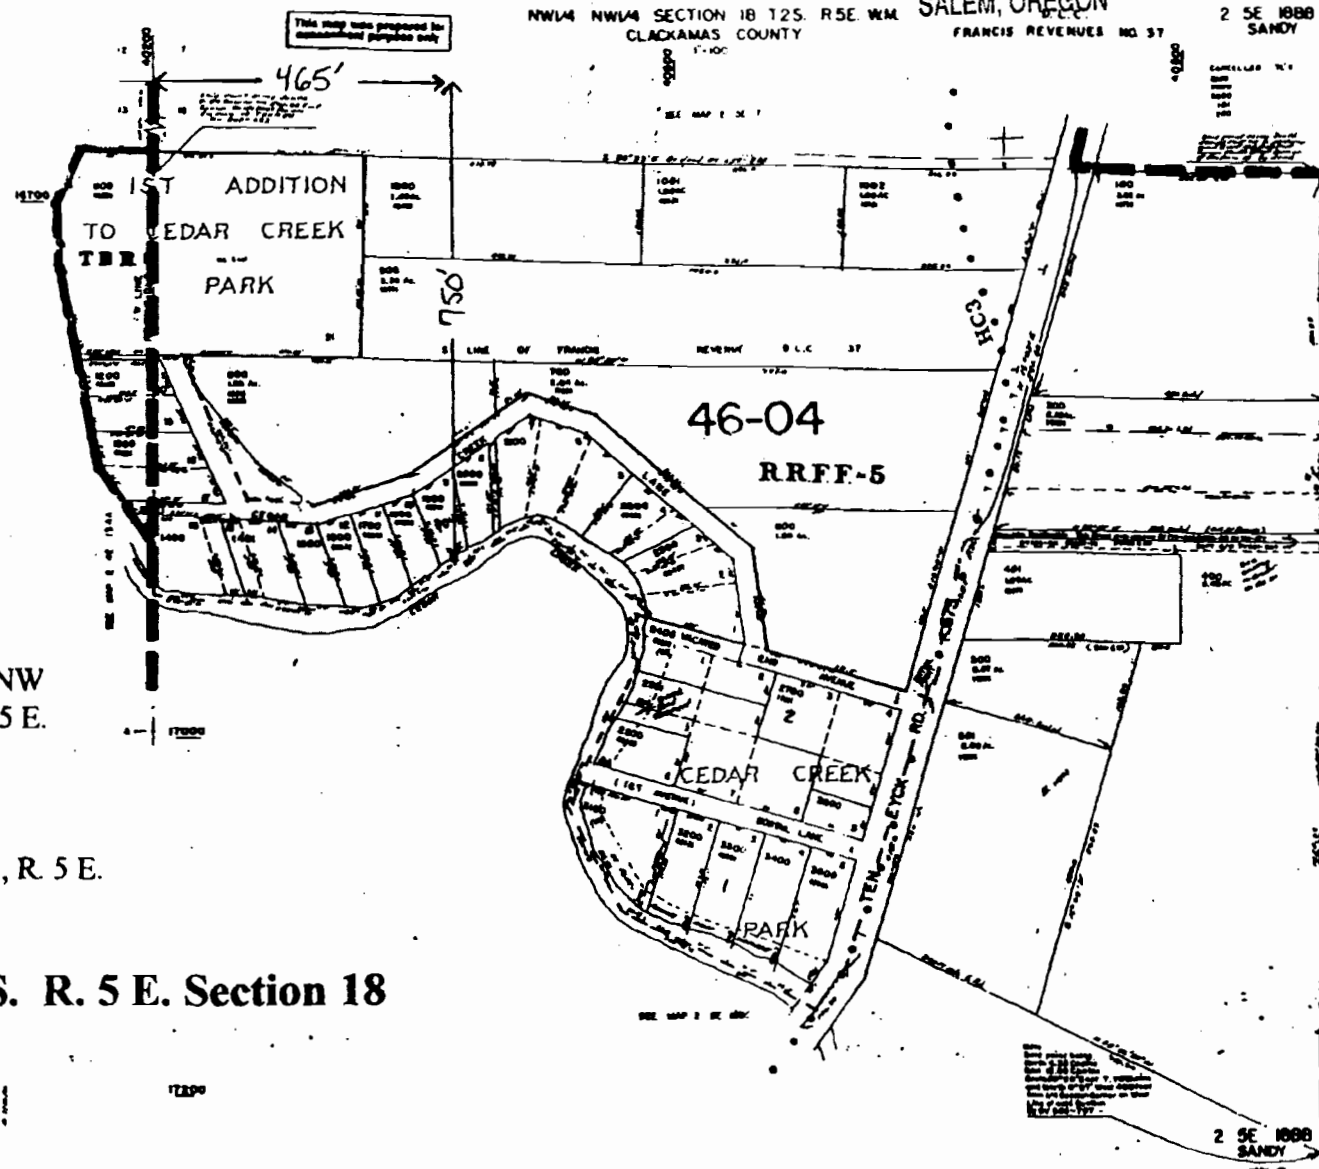

Applicant: Ernie Russell
LuAnn Russell

POD Location:

750' South and 465' East from the NW
Corner of Section 18, T. 2 S., R. 5 E.

POU Location:

NW1/4 NW1/4 Section 18, T. 2 S., R. 5 E.
Within Tax Lot 1900 (map 18BB)

NW 1/4, NW 1/4 T. 2 S. R. 5 E. Section 18



Scale: 1" = 300'

2 5E 18BB
SANDY