


TOWNSHIP 21 SOUTH, RANGE 3 WEST

FINAL PROOF SURVEY
FOR
ADDITIONAL POINT OF DIVERSION
TRANSFER 6861
EARL STEWART LIVING TRUST
PO BOX 10293
EUGENE, OR 97440

BY
FORD-NESS-FASSBENDER, INC.
PO BOX 22735
EUGENE, OR 97402
(503) 344-1852
SEPTEMBER 2, 1999

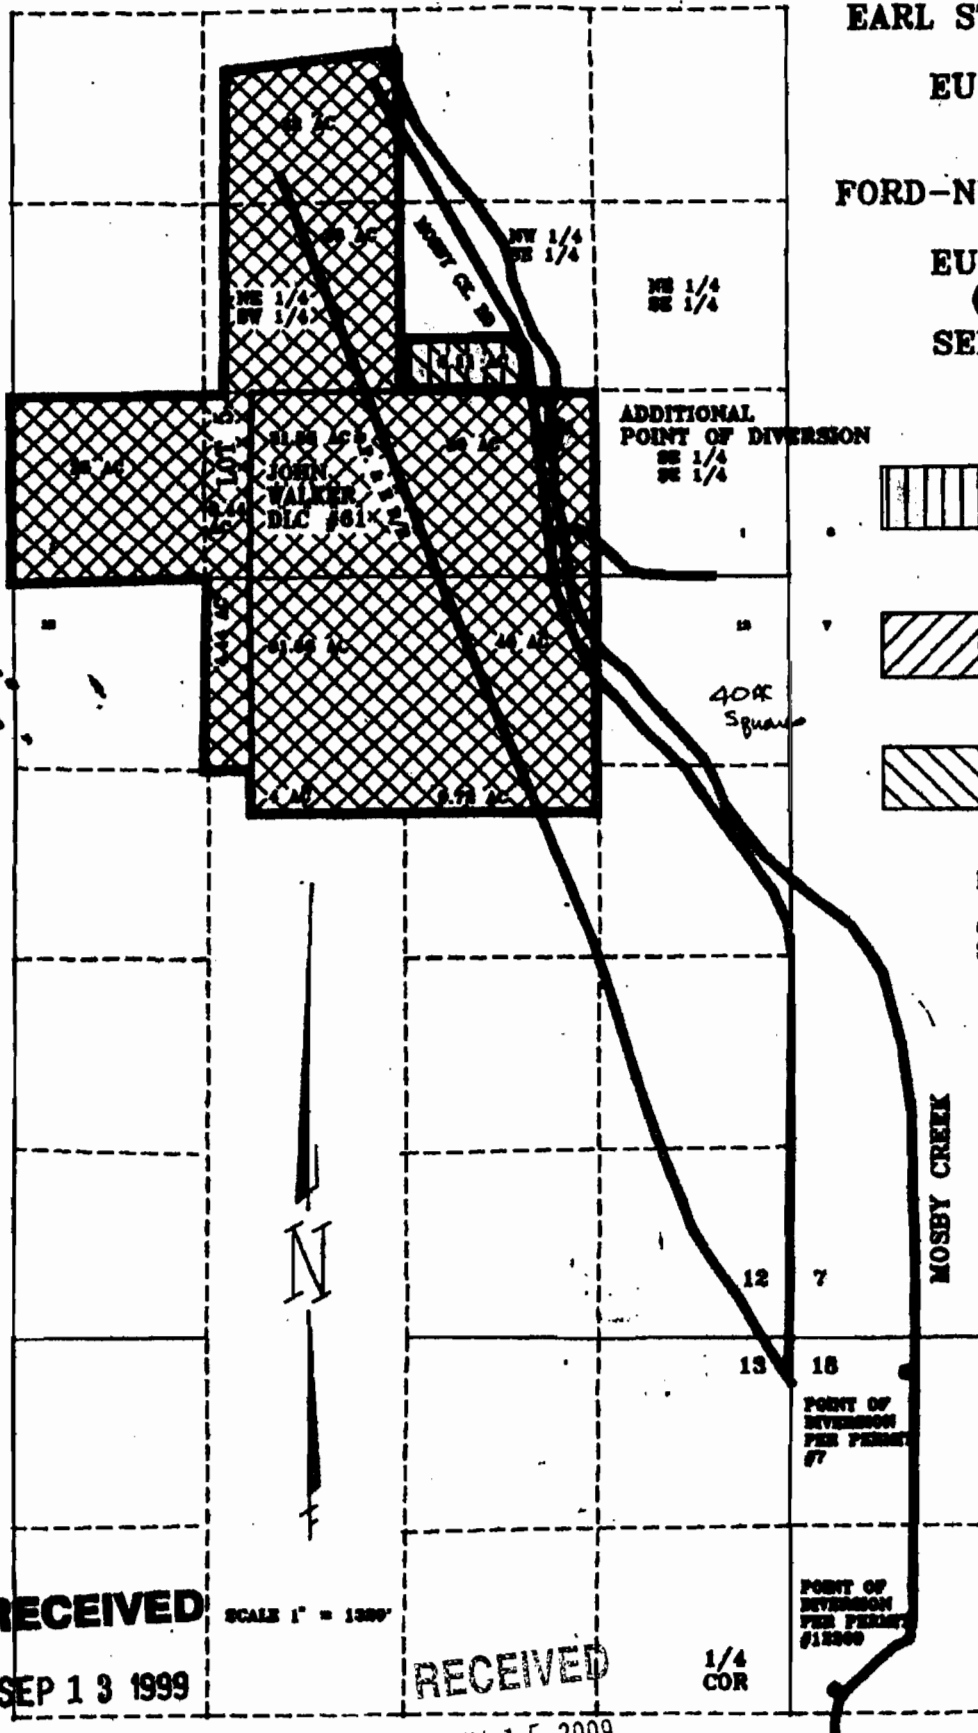

ADDITIONAL
POINT OF DIVERSION
SE 1/4
SE 1/4



RIGHT PER PERMIT #23365




RIGHT PER PERMIT #7 & 12269



AREA BENEFICIAL USE FROM ADDITION
POINT OF DIVERSION

DIVERSION LOCATION:
1016.12' NORTH & 1620.64' WEST
OF THE S.E. CORNER
SECTION 1.

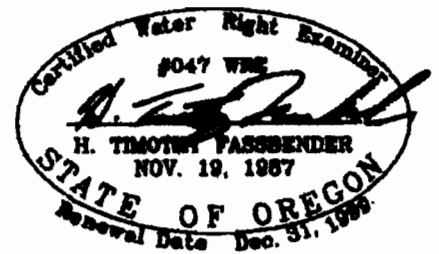

NOTE:
THIS MAP WAS PREPARED FOR THE
PURPOSE OF IDENTIFYING THE LOCATION
OF THE WATER RIGHT ONLY. IT IS
NOT INTENDED TO PROVIDE DIMENSIONS
OR LOCATION OF PROPERTY OWNERSHIP
LINES.

RECEIVED

SEP 13 1999

WATER RESOURCES DEPT.
SALEM, OREGON

RECEIVED

JUN 15 2009

WATER RESOURCES DEPT
SALEM, OREGON

1/4
COR

JOB NO. 8728
DWG NO. 167967