

J2 E Tree Farm

2-07495

RECEIVED

JUL 09 2009

WATER RESOURCES DEPT
SALEM, OREGON



29 28
32 33

David Ehlers
Vincent Creek Tract
T9S, R6W, Sections 29, 32 & 33
Map Scale: 1" = 700'


Dam from NE corner sect 32:

Highpoint: 3150' West
3850' South

North Toe: 3031' West
3675' South

South Toe: 3092' West
3940' South

Pond: T10S
R6W
S32
NE 1/4 SW 1/4
Tax lot #100

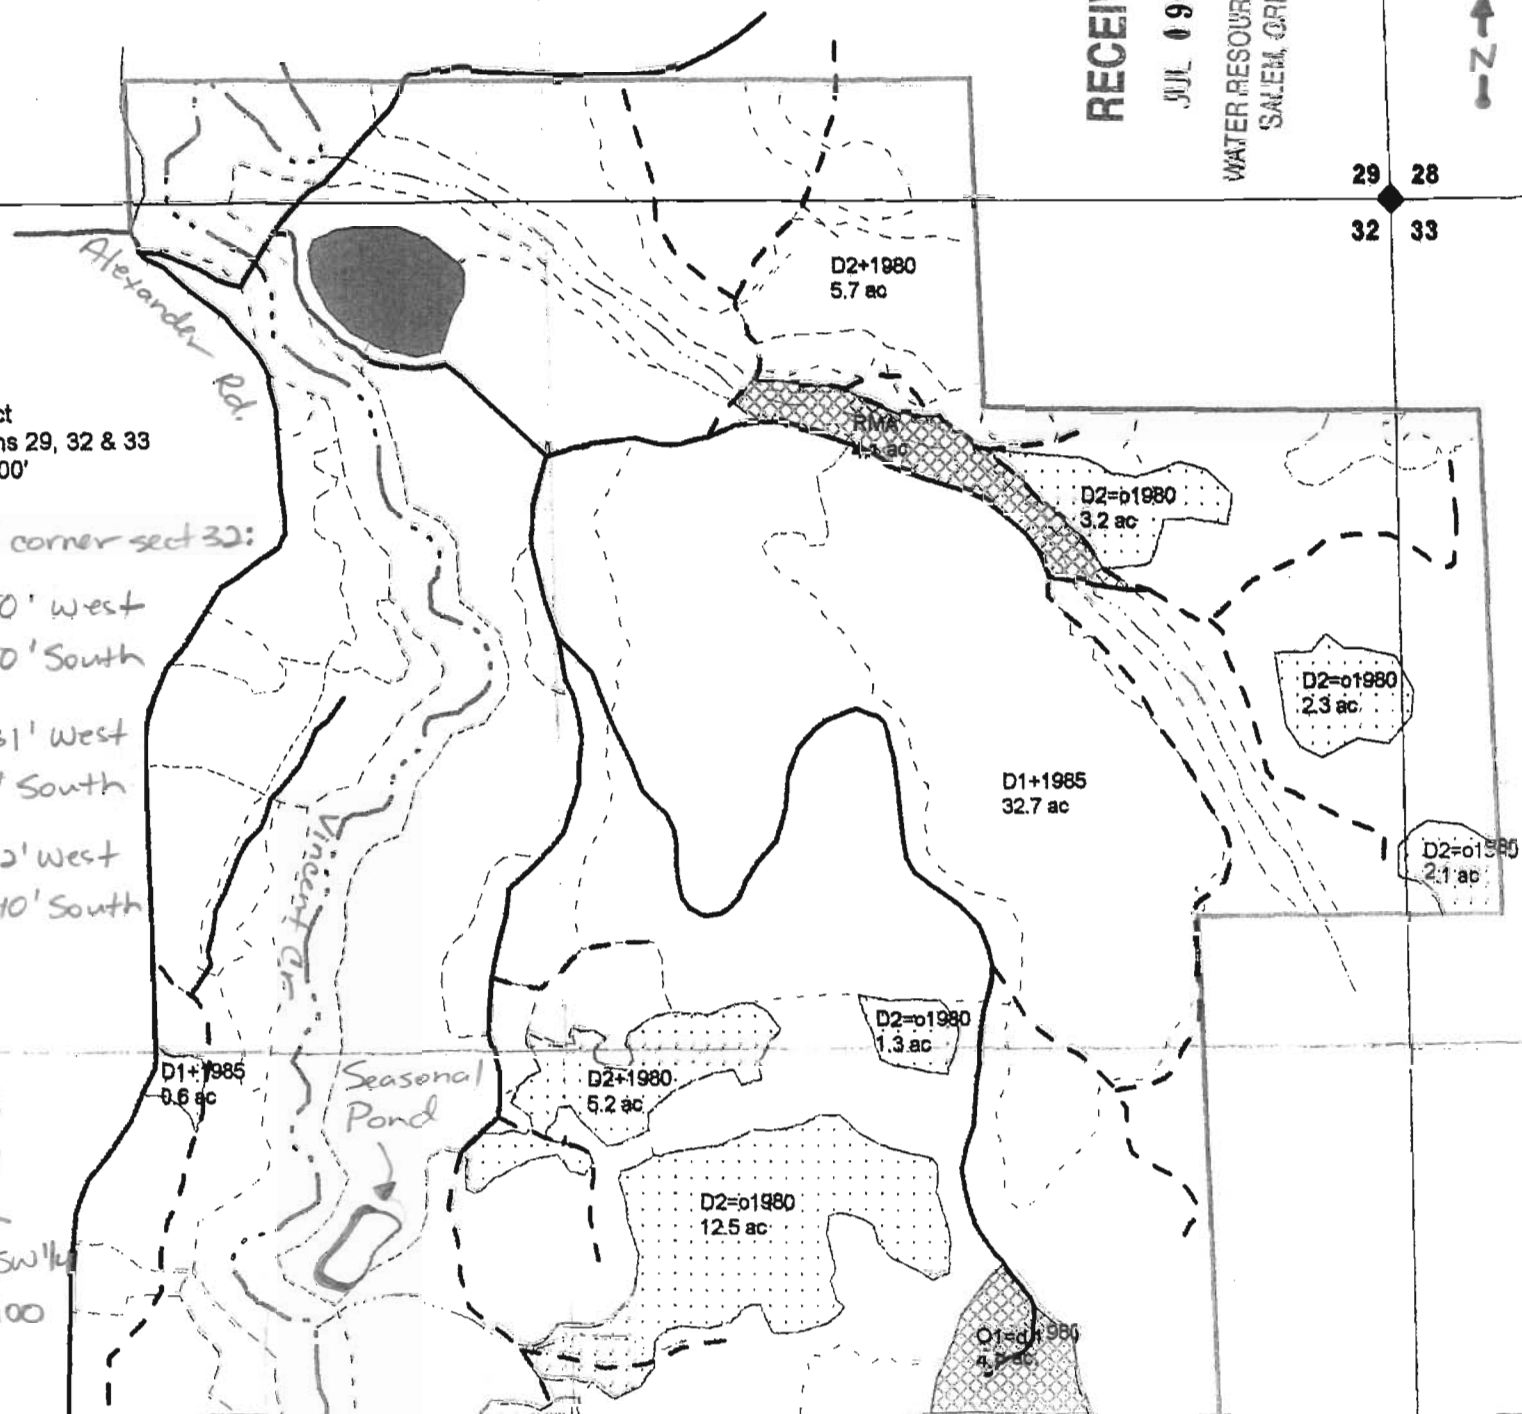

J2 E Tree Farm

RECEIVED

JUL 09 2009

WATER RESOURCES DEPT
SALEM, OREGON

R-87495

