

Pond Loc

70 feet North, 800' East from Center Section 20

LEGEND

LINE TYPES

- TAX LOT BOUNDARY OLD PROPERTY LINE
- ROAD RIGHT-OF-WAY VACATED RIGHT-OF-WAY
- RAILROAD RAILROAD RIGHT-OF-WAY
- STREAM, LAKE, ETC. STREAM, LAKE, ETC.
- TAX LOT BOUNDARY NON-BOUNDARY
- SUBDIVISION BOUNDARY PARTITION PLAT BOY.
- TAX CODE BOUNDARY EASEMENT

SYMBOL TYPES


- D.L.C.
- CONTROL POINTS
- SURVEY MONUMENTS
- G.L.O. CORNERS
- SECTION 1/4 SEC 1/16 SEC

NUMBERS

TAX CODE NO.
000 00 00 0

ACREAGE - ALL ACREAGES EXCLUDE ANY PORTION THAT MAY LIE WITHIN THE INDICATED PUBLIC RIGHT OF WAYS.

TICK MARKS - WHEN A TICK MARK IS INDICATED ON THE EXTENSION OF A LINE, THEN THE DIMENSION GOES TO THE TICK MARK. GENERALLY THIS IS USED WHEN DIMENSIONS GO INTO PUBLIC RIGHT OF WAYS.

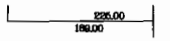


ARROWS ARE USED WITH DIMENSIONS IN AREAS OF GREATER COMPLEXITY.

NOTICE: This map was created for Assessor's Office use ONLY.

JM
08-04-09

SCALE 1" = 400'
or 1:4800
Plot file created: November 29, 2007
lastimage092w20 of wbatser

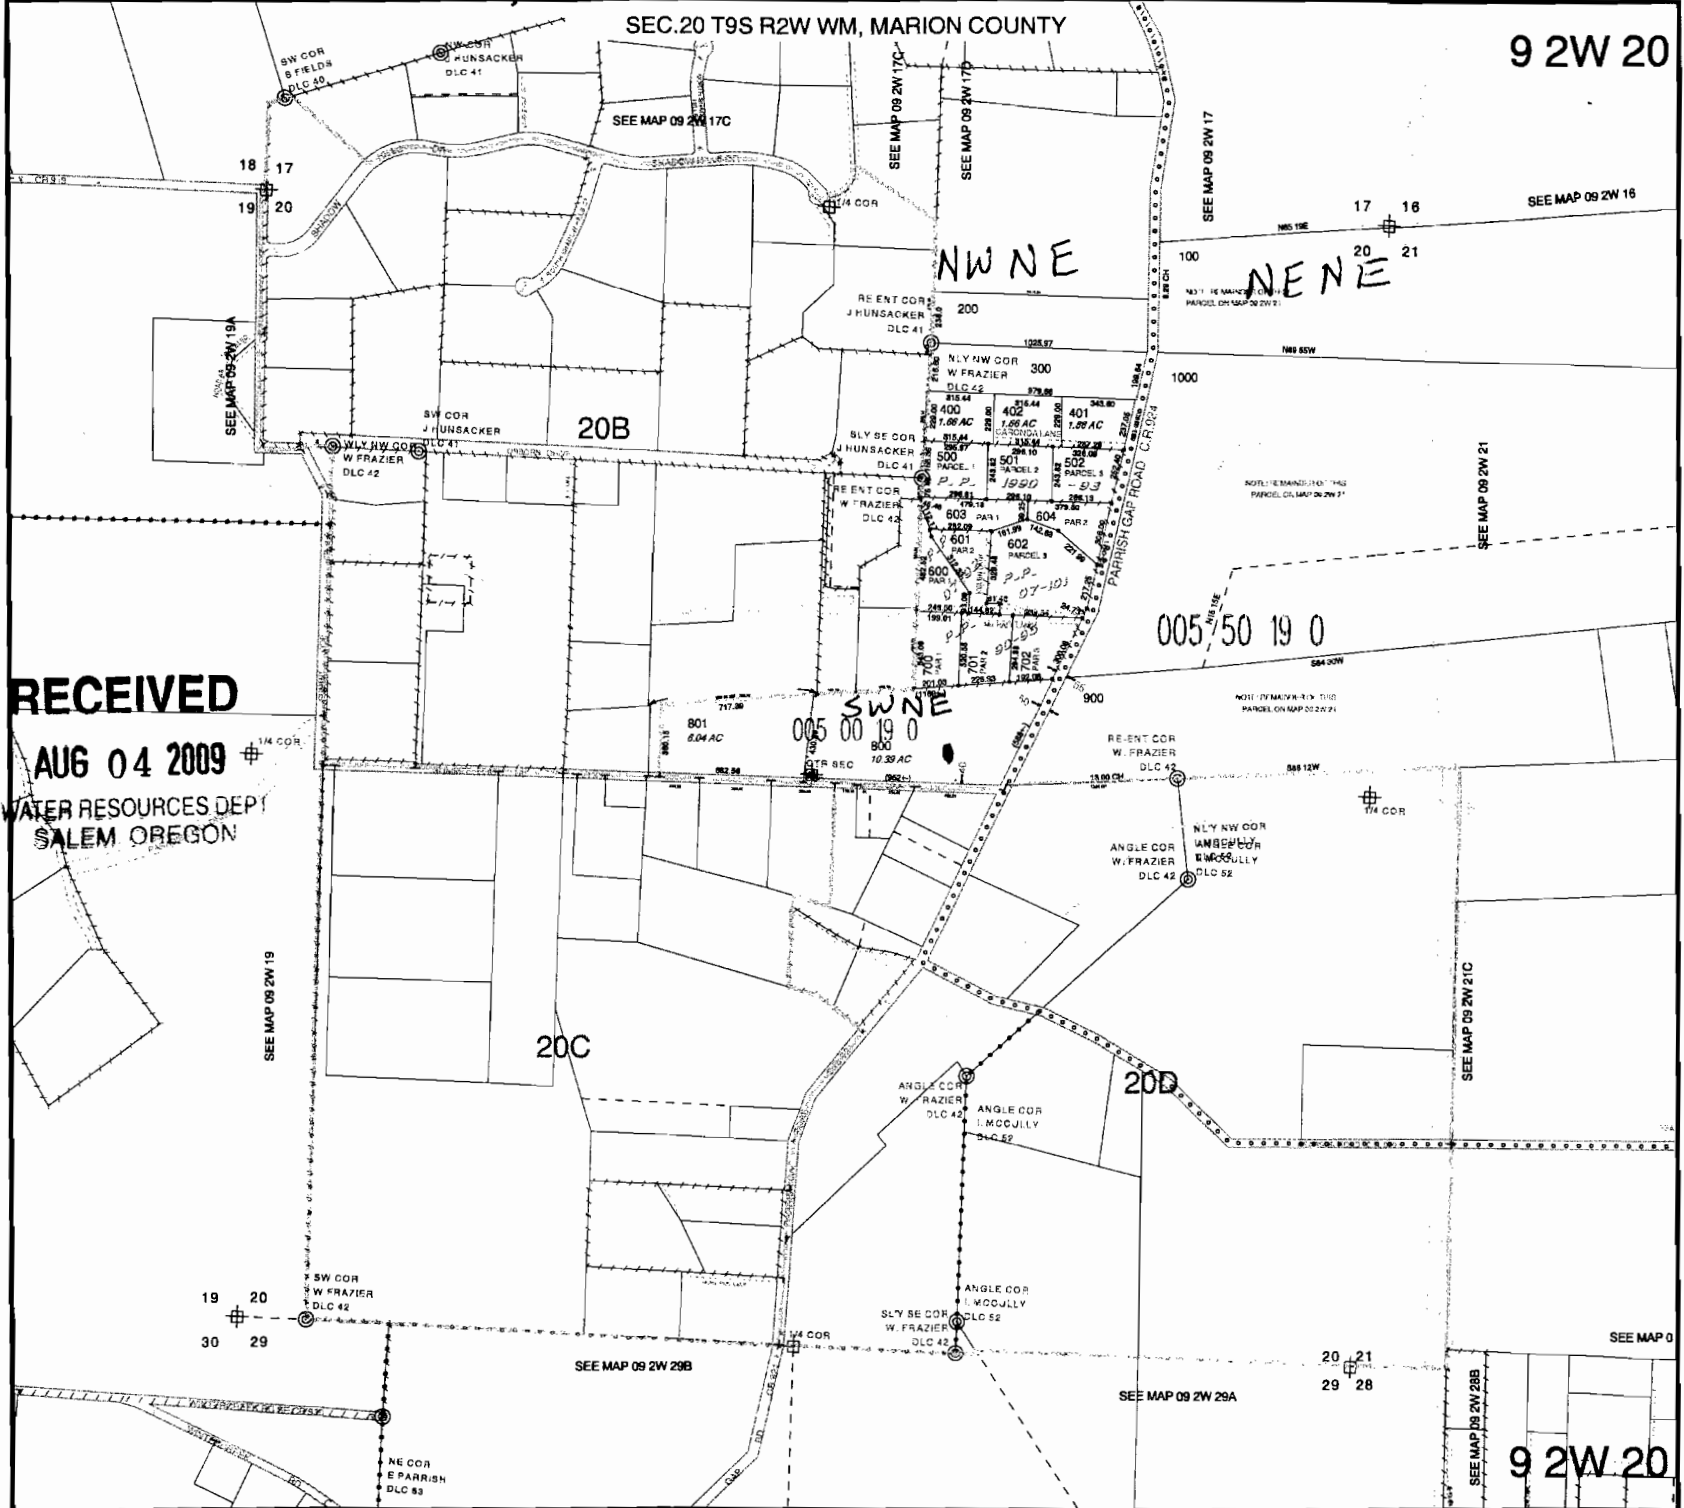

9 2W 20

9 2W 20